

STATE OF NORTH CAROLINA DEPARTMENT OF TRANSPORTATION

MICHAEL F. EASLEY
GOVERNOR

LYNDO TIPPETT
SECRETARY

February 19, 2004

United States Army Corps of Engineers 6508 Falls of the Neuse Road, Suite 120 Raleigh, NC 27615

Attn: Mr. Eric C. Alsmeyer

NCDOT Regulatory Coordinator

Dear Sir:

Subject: Application for Modification to Section 404 and Section 401 permits and Neuse Buffer Certificate for the Knightdale Bypass--US 64 from I-440 (Raleigh Beltline) to existing US 64 near SR 1003, I-440 from 0.83 mile south of US 64 to Poole Road and a portion of the East Wake Expressway from existing US 64 to the proposed US 64 Bypass in Wake County. State Project No. 8.142202, Federal Aid Project No. NHF-DPI-0199 (004), TIP No. R-2547 and R-2641, \$200.00 Debit Work Order 8.142202, WBS Element 34455.1.7. NCDENR-DWQ Water Quality Certification Project No. 011689 and USACE Action ID 200220819.

The North Carolina Department of Transportation (NCDOT) proposes to construct a new controlled-access six-lane, divided highway to be known as the Knightdale Bypass. The new location of the project consists of the Bypass (R-2547), which would extend from I-440 (Raleigh Beltline) to existing US 64 near SR 1003, and a portion of the Eastern Wake Expressway (R-2641) from existing US 64 to the proposed Bypass. The project also includes the widening of I-440 from 0.83 miles south of US 64 to Poole Road. The North Carolina Department of Environment and Natural Resources, Division of Water Quality (NCDENR-DWQ) issued a Section 401 Water Quality Certificate and a certification under the Neuse River Buffer Rules on April 10, 2002. The United States Army Corps of Engineers (USACE) issued a Section 404 permit on April 25, 2002. The project has been let and construction has begun.

The purpose of this submittal is to request a modification to the Section 404 permit, Section 401 Water Quality Certificate and the Neuse Buffer Certification, specifically for section BB, C, and CC. Please note that many of the permit sites have been completed or are under construction and this submittal serves in these instances as an after the fact

WEBSITE: WWW.NCDOT.ORG

LOCATION:

modification request. This document addresses two separate issues: (1) the discrepancies between current construction plans and permit drawings of record or construction plans which were submitted and approved as part of the original permit application, and (2) the permit violations associated with the construction of Site 4 (Poplar Branch) and Site 10 (Mark's Creek) in Section C.

The revised design does not compromise NCDOT's compliance with the existing permit conditions. The new impact sites have been evaluated for compliance with the avoidance/minimization criteria and are in compliance with all previous permit issues, including the following:

- Protected Species
- Aquatic Life passage
- FEMA compliance
- Cultural Resources

Summary of Impact Changes:

A summary of the revised impact quantities is included as Table 1. This table presents impacts from the original NCDOT permit application and impacts based on the revised design. Overall changes in impacts are summarized below.

Quantities due to necessary design changes:

- Fill and mechanized clearing in wetlands have been reduced by 0.28 acres.
- Buffer zone 1 impacts have been reduced by 0.88 acres.
- Buffer zone 2 impacts have been reduced by 0.60 acres.
- Jurisdictional stream impacts have increased by 59 feet.

Quantities due to permit violations at Site 4 and Site 10 of Section C¹:

- Temporary fill in wetlands has been increased by 0.71 acres.
- Buffer zone 1 impacts have been increased by 0.53 acres.
- Buffer zone 2 impacts have been increased by 0.56 acres.

¹Please note that a portion of these impacts in the riparian buffer (i.e. hand clearing) was previously permitted by the NCDENR-DWQ (NCDENR-DWQ permit modification dated March 21, 2003).

| Lable 1 | Table 1. Comparison | - | mpacts be | of Impacts between Original Design and Revised Design | riginal D | esign and | Revised | Design | | | | |
|---|---------------------|---------------------|---------------------|---|------------|----------------|-----------------------|---------------------|-----------------|-----------------|----------------|-----------|
| | | WETL | ETLAND IMPACTS | S | | SURFACE V | SURFACE WATER IMPACTS | ACTS | | | BUFFER IMPACTS | MPACTS |
| PROJECT SECTION | Fill In | Temp. | Excavation | Mechanized Clearing | Fill In SW | Fill In SW | Temp. Fill | Existing Channel | Relocated | Enclosed | Zone | Zone |
| | Wetlands (ac) | In Wetlands (ac) | In Wetlands (ac) | (Method III) (ac) | | (Pond) (ac) | In SW (ac) | Impacted (ft) | Channel (ft) | Channel (ft) | 1 (ac) | 2 (ac) |
| | | | | | | | | | | | | |
| | | | | | | | | | | | | |
| R-2547 TOTAL IMPACTS FROM ORIGINAL | | | | | | | | | | | | |
| APPLICATION | | | | | | | | | | | | |
| SECTION BB | 2.62 | 0.00 | 00'0 | 0.22 | 20.0 | 7.61 | 0.10 | 1037 | 0 | 482 | 3.61 | 1.95 |
| SECTION C | 5.15 | 0.00 | 0.05 | 0.72 | 0.20 | 2.43 | 00.00 | 3212 | 719 | 2057 | 7.24 | 4.41 |
| SECTION CC | 0.33 | 0.00 | 00.00 | 0:30 | 1.07 | 00.0 | 00.00 | 3635 | 919 | 2448 | 4.78 | 3.28 |
| TOTAL | 8.10 | 00.0 | 90'0 | 1.24 | 1.34 | 10.04 | 0.10 | 7884 | 1637 | 4987 | 15.63 | 9.64 |
| | | | | | | | | | | | | |
| | | | | | | | | | | | | |
| R-2547 TOTAL IMPACTS BASED ON REVISED | | | | | | | | | | | | |
| DESIGN | | | | | | | | | | | | |
| SECTION BB | 2.62 | 0.00 | 00'0 | 0.22 | 0.07 | 7.61 | 00.0 | 1037 | 0 | 482 | 3.62 | 1.95 |
| SECTION C | 5.14 | 0.71 | 90'0 | 0.72 | 0.20 | 2.43 | 00.0 | 3212 | 719 | 2057 | 7.15 | 4.55 |
| SECTION CC | 0.29 | 00.0 | 00'0 | 20'0 | 1.13 | 00.00 | 00.0 | 3694 | 948 | 2231 | 4.51 | 3.10 |
| TOTAL | 8.05 | 0.71 | 0.05 | 1.01 | 1.40 | 10.04 | 00.0 | 7943 | 1667 | 4770 | 15.28 | 9.60 |
| | | | | | | | | | | | | |
| DIFFERENCE IN TOTALS: acre/feet | -0.05 | + 0.71 | 00.0 | -0.23 | 90:0 + | 00.00 | -0.10 | + 59 | 06 + | -217 | -0.35 | -0.04 |
| (-) INDICATES A REDUCTION IN IMPACTS | | | | | | | | | | | | |

Summary of Mitigation:

Every effort throughout the design process has been made to avoid and minimize the impacts to jurisdictional waters of the United States and riparian buffer zones. Detailed descriptions of these actions are presented elsewhere in this modification.

The new impact totals resulting from the discrepancies between current construction plans and permit drawings or construction plans submitted and approved as part of the original permit application and the violations at Sites 4 and 10 on Section C necessitate a reevaluation of compensatory mitigation. The new impact quantities, which affect mitigation, can be summarized as follows:

- Fill and mechanized clearing in wetlands has been reduced by 0.28 acres.
- Jurisdictional stream impacts increased by 59 feet. These impacts at the rate of \$125 per linear foot result in \$7,375 in additional costs.
- Buffer impacts have decreased in Zone 1 by 0.35 acres and in Zone 2 by 0.04 acres. This reduction is presented below:

Table 2. Summary of Neuse Buffer Impacts and Mitigation

| | Table 2. St | ummary of Meuse | L | unci impaci | s and minigat | IUII | |
|-------------|-------------|-----------------|----------|-------------|---------------|-------|-------------|
| Section | Zone 1 | Zone 2 | | Zone 1 | Zone 2 | Total | Cost |
| | Impact | Impact | | Mitigation | Mitigation | | Reduction |
| | Reduction | Reduction | | Reduction* | Reduction* | | |
| | (ac) | (ac) | | | | | |
| | | | | 3:1 | 1.5:1 | | |
| R-2547BB | - 0.01 | 0 | | - 0.03 | 0 | -0.03 | -1,248.75 |
| R-2547C & D | 0.09 | -0.14 | | 0.27 | -0.21 | 0.06 | 2,497.5 |
| | | | | | | | |
| R-2547CC | 0.27 | 0.18 | | 0.81 | 0.27 | 1.08 | 44,955.00 |
| | | | | | | | |
| TOTAL | 0.35 | 0.04 | | 1.05 | 0.06 | 1.11 | \$46,203.75 |
| | | | | | | | |

^{*} Figures reflect total AFTER using multipliers (\$41,625 per acre)

Construction of the project based on the revised design has resulted in an increase to stream impacts and a reduction to riparian buffer impacts. The NCDOT has previously made payment to the Wetland Restoration Program to offset construction impacts associated with this project. The NCDOT respectfully submits that the mitigation costs associated with the increased stream impacts is offset by the reduction in riparian buffer impacts. The cost reduction due to the revised impacts is \$38,828.75. Therefore, the NCDOT does not propose to provide additional mitigation for the issues addressed in this submittal.

On October 14, 2003, NCDENR-DWQ personnel conducted an on-site inspection of this project. This agency was subsequently supplied with a preliminary list of potential discrepancies between the construction plans and the permit drawings. On October 20, 2003 personnel from the USACE conducted an on-site inspection of this project. The

NCDENR-DWQ issued a Notice of Violation (NOV) to the NCDOT on October 22, 2003. The NOV noted that there appeared to be significant alterations at a number of permitted sites. The NCDOT provided a final list of potential discrepancies on November 12, 2003 to the NCDENR-DWQ in our response to the NOV (see Appendix A).

Following is a list of those issues and others that have been identified since that time between the construction plans and permit drawings of record or construction plans submitted and approved as part of the original permit application with resolutions proposed for each issue. The construction status of each site is also provided. Each issue is referenced in bold and underlined by permit site number, project section designation (BB, C, or CC), most recent permit drawing sheet number and date in parenthesis, and the corresponding current construction plan sheet number.

Site 1 Section BB (Permit Drawing 5 of 30 dated 3/18/2002) and Construction Plan Sheet 4

Issue: The permit drawing does not depict any of the roadway drainage systems shown on the construction plans that are required for the project.

Status: Not constructed.

Resolution: The drainage has been added to the permit drawing and preformed scour holes, sized per NCDENR-DWQ current recommendations, have been added at the outlets to provide diffuse flow outside of the riparian buffer.

Regulatory Issue: Riparian buffer rule

No additional impacts occur at this site.

Site 1 Section BB (Permit Drawing 6 of 30 dated 3/18/2002) and Construction Plan Sheet 5

Issue: The permit drawing does not depict any of the roadway drainage systems. The ditch between the roadway and the railroad is depicted differently on the construction plans.

Status: Not constructed.

Resolution: The drainage has been added to the permit drawing and directed to a preformed scour hole, sized per NCDENR-DWQ current recommendations, to provide diffuse flow outside of the riparian buffer. The v-ditch between the railroad and roadway is now shown with contours and construction limits in lieu of flow arrows shown in the permit drawing. This ditch conveys stormwater from only the fill slope and not from impervious surfaces, since shoulder berm gutter is specified. The presence, location, and intent of the v-ditch remain unchanged.

Regulatory Issue: Riparian buffer rule

No additional impacts occur at this site.

Site 1 Section BB (Permit Drawing 5 of 30 and 6 of 30 dated 3/18/2002 and 8 of 30 and 9 of 30 dated 6/22/01) and Construction Plan Sheets 4 and 5

Issue: Construction work bridge locations have been modified resulting in less buffer and stream disturbance and removing the requirement for temporary fill in wetlands. **Status:** The work-bridge was placed and is partially removed; only the section that crosses the Crabtree Creek remains at this time.

Resolution: Temporary fill in surface waters has been reduced by 0.040 hectares (0.10 acres) due to the reconfigured work bridges (see revised permit drawings 8 of 30 and 9 of 30 dated 12/11/03). Also, the magnitude of buffer and stream bank disturbance has been reduced due to the reconfigured work bridges. However, the buffer area quantities in the impact summary have not been reduced since the permanent buffer impacts from the proposed bridges have not changed.

Regulatory Issue: Riparian buffer rule, Section 404 permit, Section 401 certificate

Temporary fill in surface waters has been reduced by 0.040 hectares (0.10 acres).

<u>Site 2 Section BB (Permit Drawing 12 of 30 dated 6/22/01) and Construction Plan Sheet 5</u>

Issue: The permit drawing depicts a lateral ditch that terminates at Zone 2 of the riparian buffer. Construction plan sheet 5 (submitted and approved as part of the original permit application) indicates that the lateral ditch flows through the buffer directly to the pond. **Status:** Not constructed.

Resolution: The ditch has been removed and replaced with a preformed scour hole, sized per NCDENR-DWQ current recommendations, to provide diffuse flow outside of the riparian buffer.

Regulatory Issue: Riparian buffer rule

No additional impacts occur at this site.

<u>Site 3 Section BB (Permit Drawing 13 of 30 dated 4/1/02) and Construction Plan Sheet 7</u>

Issue: The drainage structure located in the median at Station 41+70 on the permit drawing has been shifted to Station 41+40 on the construction plans.

Status: Not constructed.

Resolution: The proposed bridge has been lengthened, thus moving the embankment farther from the riparian buffer. The median drainage structure has been moved due to the bridge lengthening and conflicts caused by the revision of guardrail attenuators. The drainage area served has not changed. The buffer impacts were not decreased even though the bridge was lengthened due to the impacts from the future greenway path to be constructed at a later time by others. (See permit drawing 15 of 30 for Section BB)

Regulatory Issue: Riparian buffer rule

No additional impacts occur at this site.

Site 3 Section BB (Permit Drawing 14 of 30 dated 4/1/02 and Construction Plan Sheets 7 and 8

Issue: Construction work bridge locations have been modified resulting in less buffer and stream disturbance.

Status: The work-bridge was placed and is partially removed; only the mainline sections remain in place at this time.

Resolution: The magnitude of buffer and stream bank disturbance has been reduced due to the reconfigured work bridges. However, the buffer area quantities in the impact summary have not been reduced since the permanent buffer impacts from the proposed bridges have not changed.

Regulatory Issue: Riparian buffer rule, Section 404 permit, Section 401 certificate

No additional impacts occur at this site.

Site 3 Section BB (Permit Drawing 17 of 30 dated 3/18/02 and Construction Plan Sheet 8

Issue: There is a discrepancy between the permit drawing and the construction plans in the location of a 600 mm outlet pipe that drains the Type-A Basin and the associated PFSH near Station 45+50 Rt.

Status: A-basin is constructed; the PFSH is currently ON HOLD, per NCDOT direction. **Resolution:** The outlet configuration shown in the permit drawing dated 3/18/2002 would not function due to field conditions. The elevation of the bottom of the basin (necessary to provide the required sediment storage volume) would have required an outlet ditch to be cut through the buffer to daylight. In the revised layout, the buffer impacts are avoided.

Regulatory Issue: Riparian buffer rule

No additional impacts occur at this site.

Site 6 Section BB (Permit Drawing 20 of 30 dated 6/22/01) and Construction Plan Sheets 11B and 11D

Issue: Current construction plan sheet 11D indicates an undercut of alluvial soils at the toe of fill slope that extends outside of the cut/fill limits near Y 10 Station 11+75 left. This activity is not depicted on the permit drawing or the construction plans submitted and approved as part of the original permit application.

Status: Constructed.

Resolution: The removal of the soils was required for slope stability concerns. The area has been regraded to natural ground and will be revegetated appropriately. The additional impacts have been added to the impact summary and result in an additional Zone 1 buffer impact of 0.006 hectares (0.015 acres).

Regulatory Issue: Riparian buffer rule

Issue: There is a discrepancy between the permit drawing and construction plan (submitted and approved as part of the original permit application) in reference to the actual cut/fill slope at Station 60+60 left.

Status: Constructed.

Resolution: The cut/fill slope changed slightly in this area due to field conditions. At this site, the pond is to be drained and retained as a permanent A-basin. The entire pond and buffers have been mitigated; therefore no additional impacts occur as a result. **Regulatory Issue:** Riparian buffer rule, Section 404 permit, Section 401 certificate

An additional Zone 1 buffer impact of 0.006 hectares (0.015 acres) has been added to the impact summary.

Site 7 Section BB (Permit Drawing 22 of 30 dated 6/22/01) and Construction Plan Sheet 14A

Issue: The permit drawing depicts a lateral ditch at Station 71+00 right that terminates at the outlet of a 400 mm drainage structure. Construction plan sheet 14 (submitted and approved as part of the original permit application) depicts this lateral ditch extending beyond the 400mm pipe outlet to Zone 2 of the riparian buffer, due to system invert grades required to establish positive flow.

Status: Drainage has been constructed; the ditch from 71+00 to 71+15 right and the proposed reforestation are ON HOLD.

Resolution: The lateral ditch extends to Zone 2 of the riparian buffer. The pond has been mitigated for and will be permanently drained. The new buffer zones will be 15 meters (50 feet) from the new channel banks (at the outlet of the 1500 mm structure), which results in the proposed ditch outlet being approximately 35 meters from the new buffer zone. No additional impact to the buffer occurs. Reforestation conducted near the outlet of the 1500 mm structure is pending based on a future meeting for R-2641.

Regulatory Issue: Riparian buffer rule

No additional impacts occur at this site. It should be noted that the 1500mm RCP at this site has been sized according to NCDOT guidelines and is the same size as shown on the original approved plans.

<u>Site 8 Section BB (Permit Drawing 23 of 30 dated 6/6/00) and Construction Plan Sheet 14C</u>

Issue: The special ditch located left of Station 75+30 in the construction plans submitted and approved as part of the original permit application has been shifted approximately 5 feet from the location shown on the current construction plans.

Status: Constructed.

Resolution: The 900mm pipes were shifted to better align with the existing channel and consequently the special ditch was shifted. This revision caused no additional impact, since this is in the area of the proposed interchange for I-540 and the entire area was considered a total take of the jurisdictional resources.

Regulatory Issue: Riparian buffer rule

Issue: The cut ditch limits left of station 75+00 on the construction plans submitted and approved as part of the original permit application do not match those on the current construction plans.

Status: Constructed.

Resolution: The limits of the ramp construction necessary to tie to the proposed I-540 (R-2641) were not shown correctly in the plan. The limits are now shown correctly and

therefore the cut ditch limits have changed. Riprap was added as a temporary measure to provide stability where the ditch ends until the proposed interchange is completed. This revision caused no additional impact, since this entire area was considered a total take of the jurisdictional resources.

Regulatory Issue: Riparian buffer rule

Issue: The two 900mm cross pipes are shown in a slightly different location on the construction plans submitted and approved as part of the original permit application than in the current construction plans.

Status: Constructed.

Resolution: The two cross pipes were moved to better align with the existing channel based on field surveys. This revision caused no additional impact as the pipes were not lengthened and this is in the area of the proposed I-540 interchange where the entire area was considered a total take of the jurisdictional resources.

Regulatory Issue: Section 404 permit, Section 401 certificate

No additional impacts occur at this site. Additional drainage changes will be included in a permit modification for R-2641 to be submitted at a later date.

Site 8 Section BB (Permit Drawing 24 of 30 dated 10/19/2001) and Construction Plan Sheet 14C

Issue: The two 900mm cross pipes are shown in a slightly different location on the construction plans submitted and approved as part of the original permit application than in the current construction plans.

Status: Constructed.

Resolution: The two cross pipes were moved to better align with the existing channel based on field surveys. This revision caused no additional impact as the pipes were not lengthened and this is in the area of the proposed I-540 interchange where the entire area was considered a total take of the jurisdictional resources.

Regulatory Issue: Section 404 permit, Section 401 certificate

No additional impacts occur at this site.

Site 9 Section BB (Permit Drawing 25 of 30 dated 3/18/02) and Construction Plan Sheet 15

Issue: The permit shows a 'rock vane' right of station 79+10. This rock vane is not depicted on construction plan sheet 15.

Status: Not constructed.

Resolution: The 'rock vane' was inadvertently left off the construction plans and will be added to match the approved permit. Accordingly, a revised permit drawing was not required.

Regulatory Issue: Section 404 permit, Section 401 certificate

No additional impacts occur at this site.

Site 3 Section C (Permit Drawing 11 of 34 dated 6/27/01) and Construction Plan Sheet 7

Issue: The 375mm median drainage pipe at Station 98+50 on the current construction plans is not shown on the permit drawing or the construction plan submitted and approved as part of the original permit application.

Status: Not constructed.

Resolution: An additional drainage inlet (structure #31A) was needed in the median due to a sump that was created from modifications to the guardrail placement. A portion of the drainage that was previously collected by structure #31 is now collected by the new structure. The added pipe conveys the stormwater between the structures. No additional drainage area or discharge is directed toward the PFSH. Therefore, no additional impacts have occurred. The impervious area draining to structure #31A is 0.25 acres, therefore 25 feet of grass swale is needed for treatment. There is 164 feet of grass swale available at this inlet. The impervious area draining to structure #31 is 0.32 acres, therefore 32 feet of grass swale is needed for treatment. There is 236 feet of grass swale available at this inlet.

Regulatory Issue: Riparian buffer rule

Issue: Dimensions for the PFSH at Station 98+80 right on current construction plan sheet 7 are not consistent with the permit drawing or the construction plan submitted and approved as part of the original permit application. The level spreader associated with the PFSH at Station 98+80 right shown on the permit drawing and the construction plan submitted and approved as part of the original permit application is absent from the current construction plan sheet.

Status: Not constructed.

Resolution: The dimensions for PFSH's were revised to match NCDENR-DWQ current recommendations for size. The original NCDOT PFSH detail was called "preformed scour hole with level spreader". In conjunction with DWQ and NCDOT, this detail was revised to remove the "with level spreader" label to reduce confusion. The confusion arose that this should be two separate structures; a PFSH and a level spreader, when the intent was for this to be one structure; a PFSH 'with' a level spreader apron. This was the intent in the original drainage design; therefore the labels on the plans were revised to match the current DWQ requirements and NCDOT approved detail. The design is consistent with the original intent. There is no change in impacts.

Regulatory Issue: Riparian buffer rule

No additional impacts occur at this site.

<u>Site 4 Section C (Permit Drawing 12 of 34 dated 3/22/02) and Construction Plan Sheets 8 and 9</u>

Issue: The dimensions shown on the construction plans for the PFSH at Station 103+30 left are not consistent with the permit drawing. The level spreader associated with the PFSH at Station 103+30 left shown on the permit drawing is absent from the construction plans.

Status: Not constructed.

Resolution: The dimensions for PFSH's were revised to match NCDENR-DWQ current recommendations for size. The original NCDOT PFSH detail was called "preformed scour hole with level spreader". In conjunction with DWQ and NCDOT, this detail was revised to remove the "with level spreader" label to reduce confusion. The confusion arose that this should be two separate structures; a PFSH and a level spreader, when the intent was for this to be one structure; a PFSH 'with' a level spreader apron. This was the intent in the original drainage design; therefore the labels on the plans were revised to match the current DWQ requirements and NCDOT approved detail. The design is consistent with the original intent. There is no change in impacts.

Regulatory Issue: Riparian buffer rule

Issue: The NCDOT permit application dated October 19, 2001 did not address impacts to jurisdictional sites associated with the construction of the bridge over Poplar Branch. The NCDOT submitted a permit modification to the NCDENR-DWQ on February 24, 2003 which quantified hand clearing only and temporary road/work bridge impacts for access at Poplar Branch. Please note that the temporary roads were to be constructed of timber crane mats. No mechanized clearing was to take place in the riparian buffer and there was to be no temporary or permanent placement of any fill in wetlands from this activity. A site inspection on October 9, 2003 revealed that grading, earthen fill and the construction of an earthen fill causeway road had occurred at this site. These activities were not authorized in the original Section 404 permit or in the modified Section 401 Water Quality Certificate and Neuse Buffer Authorization. In addition, the construction activities extended beyond the footprint authorized by the modified Section 401 Water Ouality Certificate and Neuse Buffer Authorization. The actual construction impacts associated with this site include 0.0698 hectares (0.172 acres) in Zone 1, 0.0672 hectares (0.166 acres) in Zone 2 and 0.0121 hectares (0.030 acres) of temporary fill in wetlands. (See Appendix B)

Status: Constructed.

Resolution: The impacts that have occurred at the site will be restored to its preexisting condition. The restoration will require the Contractor to remove any unauthorized material that has been placed in jurisdictional areas. The sites will then be ripped to a depth sufficient to ensure that compaction from previous activities do not inhibit the function of the wetland and buffer zone. The areas will be seeded and mulched using riparian seed mixtures. The sites will then be reestablished where practical with wetland tree species. The Department proposes to use visual monitoring protocols for these areas beginning at the completion of the project and continuing for three years after the project is complete. An annual report will be provided to the NCDENR-DWQ and USACE. **Regulatory Issue:** Riparian buffer rule, Section 404 permit, Section 401 certificate

The additional impacts for this site include 0.0698 hectares (0.172 acres) in Zone 1, 0.0672 hectares (0.166 acres) in Zone 2 and 0.0121 hectares (0.030 acres) of temporary fill in wetlands.

Site 5A Section C (Permit Drawing 15 of 34 dated 9/11/01) and Construction Plan Sheets 10, 10A and 10B

Issue: The current construction plans show the length of structure at Station -RPCY16-2+90 to be approximately 2 to 3 meters longer than shown on the permit drawing or the construction plan submitted and approved as part of the original permit application.

Status: Constructed.

Resolution: The pipe length was revised to match field conditions. No additional impacts have occurred since the buffers were mitigated through the entire interchange. The stream was denoted as a non-perennial stream on the permit drawing (see permit drawing 16 of 34 dated 6/29/01) and was not mitigated. It is a non-jurisdictional stream according to the summary sheet on permit drawing 34 of 34 dated 3/22/02. During a site visit on 11/10/03, Steve Mitchell (NCDENR-DWQ) removed the buffer designation for the portions of this drainage way outside of the project construction limits.

Regulatory Issue: Riparian buffer rule

Issue: The toe limits in the gore area between 109+40 –L- right and -RPCY16- shown on the current construction plans do not match those shown on the permit drawing or the construction plan submitted and approved as part of the original permit application.

Status: Constructed.

Resolution: The actual toe limits were revised to match field conditions and to include guardrail revisions necessary for safety concerns. During a site visit on 11/10/03, Steve Mitchell (NCDENR-DWQ) removed the buffer designation for the portions of this drainage way outside of the project construction limits. This revision did not increase the impacts since the buffers were originally mitigated through the entire interchange. The permit drawing has been revised to show the buffers only under the areas that have already been filled; since it was our understanding that the buffers could not be removed for areas that were already under fill. The buffer area not under the fill has also been removed from the summary sheet.

Regulatory Issue: Riparian buffer rule

Issue: The toe limits in the area between –L- and -RPCY16- shown on the current construction plans do not match those on the permit drawing or the construction plan submitted and approved as part of the original permit application.

Status: Constructed.

Resolution: The actual toe limits are shown on the construction plans to depict the excavation for the detention basin. The slope stake lines in the permit drawings did not show this excavation. During a site visit on 11/10/03, Steve Mitchell (NCDENR-DWQ) removed the buffer designation for the portions of this drainage way outside of the project construction limits. The construction plan revision did not increase the impacts since the buffers were originally mitigated through the entire interchange. The permit drawing and summary have been revised to show the buffers only under the areas that have already been filled, since it was our understanding that the buffers could not be removed for areas that were already under fill.

Issue: A special cut base ditch and toe protection have been specified at station 3+00 – RPCY16- left on the current construction plans, which are not shown on the permit drawing or the construction plan submitted and approved as part of the original permit application.

Status: Constructed.

Resolution: The special base ditch was added to convey the stormwater after it crests the berm from the detention basin. This revision did not increase the impacts since the buffers were mitigated through the entire interchange. During a site visit on 11/10/03, Steve Mitchell (NCDENR-DWQ) removed the buffer designation for the portions of this drainage way outside of the project construction limits.

Regulatory Issue: Riparian buffer rule

The removal of the buffer designation at this site reduced the Zone 1 impacts by 0.143 hectares (0.353 acres) and Zone 2 impacts by 0.092 hectares (0.227 acres).

<u>Site 5A Section C (Permit Drawing 16 of 34 dated 6/29/01) and Construction Plan Sheet 10A & 10C</u>

Issue: The pipe along the left shoulder (Station 112+00 to 113+00) on current construction plan sheet 10C is not depicted on the permit drawing or the construction plan submitted and approved as part of the original permit application. Also, the associated drainage system on the current construction plans has been reconfigured with an additional PFSH shown left of station 112+50.

Status: Not constructed.

Resolution: This pipe was previously routed along the median, but was moved to the shoulder to avoid a conflict with an added attenuator (guardrail). The associated drainage system had to be reconfigured so the pipe could be moved to the shoulder. An additional 20 meters (60 LF) of shoulder berm gutter has been added and an additional PFSH was added outside of the riparian buffer to better provide diffuse flow. Both PFSH's have been sized according to current DWQ requirements. During a site visit on 11/10/03, Steve Mitchell (NCDENR-DWQ) removed the buffer designation for the portions of this drainage way outside of the project construction limits. No additional impacts occur as a result of this change.

Regulatory Issue: Riparian buffer rule

Issue: The toe limits on the current construction plans do not match at the southwest bridge approach on the permit drawing or the construction plan submitted and approved as part of the original permit application.

Status: Constructed.

Resolution: The toe limits have been revised to correctly show the excavation for the detention basin. The roadway fill slope will extend continuously into the cut slope for the detention basin (see permit drawing 17 of 34 dated 6/29/01). No additional impacts occur as a result of this change.

Issue: The dimensions for the PFSH's on the current construction plans at stations 113+00 –L- left, 3+50 –RPAY 16- left, and 3+00 –RPAY 16- right are not consistent with the permit drawing or the construction plan submitted and approved as part of the original permit application. The level spreaders associated with the PFSH's at stations 3+50 -RPAY 16- left and 3+00 –RPAY 16- right on the permit drawing and the construction plan submitted and approved as part of the original permit application are absent from the current construction plan sheet.

Status: Not constructed.

Resolution: The dimensions for PFSH's were revised to match NCDENR-DWQ current recommendations for size. The original NCDOT PFSH detail was called "preformed scour hole with level spreader". In conjunction with DWQ and NCDOT, this detail was revised to remove the "with level spreader" label to reduce confusion. The confusion arose that this should be two separate structures; a PFSH and a level spreader, when the intent was for this to be one structure; a PFSH 'with' a level spreader apron. This was the intent in the original drainage design; therefore the labels on the plans were revised to match the current DWQ requirements and NCDOT approved detail. The design is consistent with the original intent.

Regulatory Issue: Riparian buffer rule

The removal of the buffer designation at this site reduced the Zone 1 impacts by 0.112 hectares (0.277 acres) and Zone 2 impacts by 0.076 hectares (0.188 acres).

<u>Site 6 Section C (Permit Drawing 18 of 34 dated 3/22/02) and Construction Plan Sheet 11 & 11A</u>

Issue: There is a discrepancy in toe limits between the permit drawing and construction plan sheet 11 at Station 117+90 right. At Station 117+90, a 400mm CSP and a PFSH with level spreader apron are shown on the permit drawing but not on construction plan sheet 11. Drainage structures and a PFSH are depicted on construction plan sheet 11 at Station 117+40. These structures and the PFSH are not depicted on the permit drawing. **Status:** Constructed, except PFSH.

Resolution: The fill slopes were revised from 4:1 slopes to 2:1 slopes. The 2:1 slopes required the addition of shoulder berm gutter and two drainage inlets. The drainage system was shifted so as to outlet outside of the riparian buffer to an appropriately sized PFSH. No additional impacts occur as a result of these changes. The buffers have been removed per Mr. John Hennessy (DWQ) from the drainage way crossing at station 117+60. A lateral base ditch at the outlet of the pipe has been added that conveys off-site drainage through the buffers. The fill slopes have been reduced due to the change in fill slopes, but the construction limits remain the same due to the addition of the lateral ditch. **Regulatory Issue:** Riparian buffer rule

Issue: The dimensions on the construction plan for the PFSH at station 118+80 –L- left are not consistent with the permit drawing.

Status: Not constructed.

Resolution: The dimensions for the PFSH were revised to match NCDENR-DWQ

current recommendations for size. No additional impacts result.

Issue: There is a discrepancy in toe limits between the permit drawing and construction plan sheet 11A at Station 119+30 left.

Status: Constructed.

Resolution: The existing field conditions dictated the change in the fill limits. This slight change will reduce the wetland impacts from mechanized clearing by 0.001 hectares (0.003 acres). The buffer impacts for Zone 1 are reduced by 0.004 hectares (0.010 acres) and Zone 2 are reduced by 0.006 hectares (0.015 acres).

Regulatory Issue: Riparian buffer rule, Section 404 permit, Section 401 certificate

Wetland impacts from mechanized clearing were reduced by 0.001 hectares (0.003 acres). The buffer impacts for Zone 1 were reduced by 0.004 hectares (0.010 acres) and Zone 2 were reduced by 0.006 hectares (0.015 acres).

Site 7 Section C (Permit Drawings 19 & 20 of 34 dated 6/27/01) and Construction Plan Sheets 14 & 2G

Issue: The underdrain at Station 131+10 left on current construction plan sheet 14 that flows into the relocated channel is not shown on the permit drawing or the construction plan submitted and approved as part of the original permit application.

Status: Constructed.

Resolution: The area necessary to install the underdrain has been added to the impact summary sheet. The installation impacted an additional 0.007 hectares (0.017 acres) of Zone 1 and 0.003 hectares (0.007 acres) of Zone 2. This additional area has been added to the impact summary and the area outside of the grading limits will be planted to reestablish the buffer.

Regulatory Issue: Riparian buffer rule

Issue: There is a discrepancy in depiction of limits of relocated channel between current construction plan sheet 14 and the permit drawing and construction plan submitted and approved as part of the original permit application at Station 131+40 to 132+00 left.

Status: Not constructed.

Resolution: The natural stream design details have been modified to better match the morphological measurements for a B5 channel. Also, three cross vane structures have been specified as grade control and to provide a step-pool system. The root wads and low stage check dams have been removed from the details.

Regulatory Issue: Riparian buffer rule, Section 404 permit, Section 401 certificate

Issue: The stream relocation located at Station 131+40 to 132+00 left calls for low stage check dams in the channel detail on construction plan sheet 2F submitted and approved as part of the original permit application. The low stage check dams are not shown on the permit drawing.

Status: Not constructed.

Resolution: The stream design details have been modified to better match the morphological measurements for a B5 channel. Also, three cross vane structures have been specified as grade control and to provide a step-pool system. The root wads and low stage check dams have been removed from the details.

Regulatory Issue: Section 404 permit, Section 401 certificate

Issue: There is a discrepancy in the toe limits between current construction plan sheet 14 and the permit drawing and construction plan submitted and approved as part of the original permit application at Station 132+50 right.

Status: Not fully constructed.

Resolution: The cut/fill lines shown on the current construction plans do not account for the construction of the future Eagle Rock and Taylor Road (-Y101-) interchange. The cut/fill lines shown in the construction plan submitted and approved as part of the original permit application are representative of the future interchange, which will not be constructed under this contract. The impacts have been reduced as a result of this interim stage without the future interchange. However, no impact reduction is claimed due to anticipated future interchange impacts.

Regulatory Issue: Riparian buffer rule

An additional 0.007 hectares (0.017 acres) of Zone 1 and 0.003 hectares (0.007 acres) of Zone 2 buffer impacts have been added to the impact summary.

Site 8 Section C (Permit Drawings 22 & 23 of 34 dated 6/27/01) and Construction Plan Sheets 15

Issue: The dimensions on the current construction plans for the PFSH's at stations 134+20 left, 135+40 left, and 135+06 right are not consistent with the permit drawing or the construction plan submitted and approved as part of the original permit application. The level spreader associated with the PFSH at station 135+06 right on the permit drawing and the construction plan submitted and approved as part of the original permit application is absent from the current construction plan sheet.

Status: Not constructed.

Resolution: The dimensions for PFSH's were revised to match NCDENR-DWQ current recommendations for size. The original NCDOT PFSH detail was called "preformed scour hole with level spreader". In conjunction with DWQ and NCDOT, this detail was revised to remove the "with level spreader" label to reduce confusion. The confusion arose that this should be two separate structures; a PFSH and a level spreader, when the intent was for this to be one structure; a PFSH 'with' a level spreader apron. This was the intent in the original drainage design; therefore the labels on the plans were revised to match the current DWQ requirements and NCDOT approved detail. The design is consistent with the original intent. There is no change in impacts.

Regulatory Issue: Riparian buffer rule

Issue: The drainage structure (#117A) located at Station 133+80 right on current construction plan sheet 15 is not present on the permit drawing or the construction plan submitted and approved as part of the original permit application.

Status: Constructed.

Resolution: Additional shoulder berm gutter was required due to additional guardrail necessary for safety concerns, making the drainage structure necessary. The additional discharge is directed toward a PFSH, sized per current NCDENR-DWQ recommendations, located outside of the riparian buffer to provide diffuse flow.

In addition, a Natural Rock Energy Dissipator Basin has been designed by NCDOT at the outlet of structure #123 (1500mm RCP) to dissipate energy and provide stability to the existing channel as a part of the mitigation site located downstream (see permit drawing 22A of 34 dated 1/30/04). The dissipater is not located within a jurisdictional stream, is not located within buffers, and is not located within wetlands.

Regulatory Issue: Riparian buffer rule, Section 404 permit, Section 401 certificate

No additional impacts occur at this site.

Site 9 Section C (Permit Drawings 26 of 34 dated 6/27/01, 27 of 34 dated 3/22/02, 28 of 34 dated 7/13/01) and Construction Plan Sheets 16A, 23 and 2F

Issue: The special ditch and the lateral ditch along the southern fill slope on construction plan sheet 16A at Station 141+00 to 141+60 are not depicted on the permit drawing 27 of 34. Also, the cut/fill slopes shown on the construction plans do not match those depicted on the permit drawings or the current construction plans submitted and approved as part of the original permit application.

Status: Not constructed (PFSH); slopes have been constructed.

Resolution: The permit drawings and construction plans submitted and approved as part of the original permit application depict drainage and cut/fill slopes at the completion of the future Eagle Rock and Taylor Road (-Y101-) interchange. The drainage on the current construction plans is an interim situation until the completion of the future interchange, which will not be constructed under this contract. The drainage shown on the plans will not have any additional impacts, since the impacts for the entire future interchange were included in the previous impact summary. This site has been included in the modification request only as an interim condition. It should be noted that although NCDENR-DWQ may require a permit modification when the future interchange is constructed, the impacts for this area have already been mitigated. The impacts have been reduced as a result of this interim stage without the future interchange. However, no impact reduction is claimed due to anticipated future interchange impacts.

Regulatory Issue: Riparian buffer rule, Section 404 permit, Section 401 certificate

Issue: Drainage structures #134A and #134B and the PFSH at Station 142+20 left on the current construction plans are not shown on permit drawing 27 of 34.

Status: Constructed, except PFSH.

Resolution: The fill slopes were changed from 4:1 to 2:1. This required the addition of shoulder berm gutter and the associated drainage system. The concentrated flow has been directed to a PFSH, sized per current NCDENR-DWQ recommendations, located outside of the riparian buffer to provide diffuse flow. The impacts have been reduced as a result of this interim stage without the future interchange. However, no impact reduction is claimed due to anticipated future interchange impacts.

Issue: Drainage structure #134C at Station 142+60 right on the construction plans is not shown on permit drawing 27 of 34.

Status: Constructed, except PFSH.

Resolution: The fill slopes were changed from 4:1 to 2:1. The addition of shoulder berm gutter was required which made the associated drainage system necessary. The concentrated flow has been directed to a PFSH, sized per current NCDENR-DWQ recommendations, located outside of the riparian buffers to provide diffuse flow. No additional impacts occur as a result of this change.

Regulatory Issue: Riparian buffer rule

Issue: The lateral ditch cross-section depicted on permit drawing 28 of 34 and construction plan sheet 2F do not match.

Status: Not constructed.

Resolution: The detail for the lateral ditch on plan sheet 2F will be revised to match the

permit drawing.

Regulatory Issue: Section 404 permit, Section 401 certificate

No additional impacts occur at this site.

Site 10 Section C (Permit Drawing 29 of 34 dated 3/22/02 and 30 of 34 dated 3/22/02) Site 1 and Site 2 Section CC (Permit Drawing 4 of 24 dated 3/22/02 and 5 of 24 dated 3/22/02) and Construction Plan Sheets 4 and 5 of Section CC

Issue: The permit drawing indicates a PFSH is located at Station 145+40 left. The construction plans indicate that this device has been shifted to Station 145+22 left.

Status: Not constructed.

Resolution: The bridge was revised to span the buffers in the permit drawing. The drainage shown in that permit drawing was not adjusted to match the revised length of bridge. The drainage system has been shifted back away from the buffers, but is the same basic configuration. No additional impacts have occurred as a result of this change.

Regulatory Issue: Riparian buffer rule

Issue: The construction plans depict an additional structure (#9A) and two additional pipes that originate from the end bents of each bridge that are not shown on the permit drawing.

Status: Not constructed.

Resolution: Due to the increased length of the Marks Creek bridges necessary to span the buffers, a drainage system was required on each bridge, but was not included in the permit. The pipes shown tie the bridge system so the roadway drainage can be directed to a PFSH, sized per current NCDENR-DWQ recommendations.

Regulatory Issue: Riparian buffer rule

Issue: The dimensions on the construction plan for the PFSH's at stations 145+22 left and 147+00 left are not consistent with the permit drawing. The level spreader associated with the PFSH at station 147+00 left on the permit drawing is absent from the construction plan sheet.

Status: Not constructed.

Resolution: The dimensions for PFSH's were revised to match NCDENR-DWQ current recommendations for size. The original NCDOT PFSH detail was called "preformed scour hole with level spreader". In conjunction with DWQ and NCDOT, this detail was revised to remove the "with level spreader" label to reduce confusion. The confusion arose that this should be two separate structures; a PFSH and a level spreader, when the intent was for this to be one structure; a PFSH 'with' a level spreader apron. This was the intent in the original drainage design; therefore the labels on the plans were revised to match the current DWQ requirements and NCDOT approved detail. The design is consistent with the original intent. There is no change in impacts.

Regulatory Issue: Riparian buffer rule

Issue: The permit drawing indicates a 1350 mm pipe that conveys a stream with the outlet of this pipe located outside of the wetland boundary. The construction plans indicate that the outlet of this pipe has been shifted and is now located inside the wetland boundary.

Status: Constructed.

Resolution: The location of the pipe outlet shown in the permit drawing was shown outside of the wetlands, but due to field conditions the pipe outlet was adjusted. The outlet location shown in the permit drawings was not suitable since the natural ground sloped from right to left on an eight percent grade. An additional wetland impact of 0.002 hectares (0.005 acres) has occurred as a result of this change. Mr. Eric Alsmeyer (USACE) reviewed the site on January 8th, 2004 and concurred that the pipe outlet is best situated inside of the wetland, which allows for conveyance of water into the jurisdictional system.

Regulatory Issue: Section 404 permit, Section 401 certificate

Issue: The construction plans indicate that a headwall is located at the inlet of the 1350 mm pipe. The permit drawing depicts the structure without a headwall.

Status: Constructed.

Resolution: The headwall does not impact any additional area.

Regulatory Issue: Not applicable

Issue: The construction plans depict an additional structure (#12A) in the median and a PFSH at station 147+60 right. These devices are not depicted on the permit drawing.

Status: Not constructed.

Resolution: The drainage structure was required due to revisions to the guardrail design that caused a false sump to be formed in the median ditch. The concentrated flow has been directed to a PFSH, sized per current NCDENR-DWQ recommendations, which is outside of the wetlands and riparian buffers. No additional impacts resulted.

Regulatory Issue: Riparian buffer rule

Issue: The permit drawings depict a PFSH at station 146+40 right. This device is not depicted on the construction plans.

Status: Deleted.

Resolution: The drainage structure was no longer required since the road slopes away (toward the median) from the inlet. Since the concentrated flow was removed, the drainage system and PFSH were no longer needed.

Regulatory Issue: Riparian buffer rule

Issue: The NCDOT permit application dated October 19, 2001 did not address impacts to jurisdictional sites associated with the construction of the bridge over Mark's Creek. The NCDOT submitted a permit modification to the NCDENR-DWO on February 24, 2003, which quantified hand clearing only and temporary road/work bridge impacts for access at Mark's Creek. Please note that the temporary roads were to be constructed of timber crane mats. No mechanized clearing was to take place in the riparian buffer and there was to be no temporary or permanent placement of any fill in wetlands from this activity. A site inspection on October 9, 2003 revealed that grading, earthen fill and the construction of an earthen fill causeway road had occurred at this site. These activities were not authorized in the original Section 404 permit or in the modified Section 401 Water Quality Certificate and Neuse Buffer Authorization. In addition, the construction activities extended beyond the footprint authorized by the modified Section 401 Water Quality Certificate and Neuse Buffer Authorization. The actual construction impacts associated with this site include 0.144 hectares (0.356 acres) in Zone 1, 0.159 hectares (0.393 acres) in Zone 2, and 0.274 hectares (0.676 acres) of temporary fill in wetlands. (See Appendix C)

Status: Constructed.

Resolution: The impacts that have occurred at the site will be restored to its preexisting condition. The restoration will require the Contractor to remove any unauthorized material that has been placed in jurisdictional areas. The sites will then be ripped to a depth sufficient to ensure that compaction from previous activities do not inhibit the function of the wetland and buffer zone. The areas will be seeded and mulched using riparian seed mixtures. The sites will then be reestablished where practical with wetland tree species. The Department proposes to use visual monitoring protocols for these areas beginning at the completion of the project and continuing for three years after the project is complete. An annual report will be provided to the NCDENR-DWQ and USACE. **Regulatory Issue:** Riparian buffer rule, Section 404 permit, Section 401 certificate

Issue: Slope stakes for the entire site on the construction plans are slightly different than those shown on the permits.

Status: Constructed.

Resolution: Minor slope stake revisions were required due to field conditions. These revisions resulted in a reduction to fill in wetlands of 0.004 hectares, but also resulted in an increase of 0.004 hectares (0.010 acres) of Zone 1 impacts and 0.003 hectares (0.007 acres) of Zone 2 impacts.

Regulatory Issue: Riparian buffer rule, Section 404 permit, Section 401 certificate

For the entire Site 10, 'Fill in Wetlands' has been reduced by 0.002 hectares (0.005 acres. Zone 1 buffer impact has been increased by 0.148 hectares (0.366 acres). Zone 2 buffer impact has been increased by 0.162 hectares (0.400 acres). Temporary fill in wetlands has increased by 0.274 hectares (0.676 acres).

<u>Site 3 Section CC (Permit Drawings 6 of 24 dated 3/22/02 and 7 of 24 dated 4/8/02)</u> and Construction Plan Sheet 5 and 6

Issue: The permit drawings indicate an 1800mm cross pipe without a headwall at inlet. The construction plan indicates this pipe has a headwall at the inlet.

Status: Constructed.

Resolution: The headwall does not impact any additional area. NCDOT has requested additional riprap to be placed on the banks at the inlet of the pipe for stabilization. This will impact an additional 4 meters (13 feet) of stream and has been added to the impact summary.

Regulatory Issue: Riparian buffer rule, Section 404 permit, Section 401 certificate

Issue: The permit drawing indicates a level spreader on the east side of the roadway that is straight. The construction plan indicates a level spreader in this location that is rounded.

Status: Constructed.

Resolution: The rectangular level spreaders shown on the permit drawing are for illustrative purposes only and will be constructed along the contour of the existing land. No additional impacts occur.

Regulatory Issue: Riparian buffer rule

Issue: The cut/fill limits on the construction plans do not match those on the permit drawing at station 150+00 right.

Status: Constructed.

Resolution: As shown on the construction plans, the fill slopes tie to the headwall. Zone 1 impacts are reduced by 0.041 hectares (0.101 acres). Zone 2 impacts are reduced by 0.034 hectares (0.084 acres).

Regulatory Issue: Riparian buffer rule

Issue: The permit drawing shows a 450mm pipe from the median to the PFSH. The construction plans show a 600mm pipe.

Status: Not constructed.

Resolution: The increase in pipe size can be attributed due to the flat slope of the pipe. The PFSH has been sized appropriately to provide diffuse flow. No additional impacts resulted from the pipe size revision.

Regulatory Issue: Riparian buffer rule

Issue: The construction plan show a 'bridge toe drain' left of station 150+20 that is not shown on the permit drawings.

Status: Constructed.

Resolution: The under drain is added based on field conditions and is subsurface drainage. No additional impacts have resulted.

Regulatory Issue: Not Applicable

An additional 4 meters (13 feet) of 'Existing Channel Impacted' and 0.002 hectares (0.005 acres) of 'Fill in Surface Water' have been added to the impact summary.

Zone 1 impacts are reduced by 0.041 hectares (0.101 acres). Zone 2 impacts are reduced by 0.034 hectares (0.084 acres).

<u>Site 4 and 5 Section CC (Permit Drawings 8 of 24 dated 1/7/03 and 9 of 24 dated 1/7/03)</u> and Construction Plan Sheet 7

Issue: The permit drawings indicate a 1.5m (5 ft) base ditch that outfalls to a drainage pipe that is connected to the box culvert. The construction plans indicate toe protection along the eastern fill slope and a PFSH located approximately 30m away from the riparian buffer.

Status: Constructed.

Resolution: In the original drainage design, two low areas existed that would not drain properly. Two cross pipes were added to drain the low areas and collect off-site drainage. This revision was addressed in a previous modification with drawings referenced above. The ditch shown in the permit drawings would not work as shown. By adding the pipes, a ditch was no longer needed and toe protection could be used instead. The PFSH, sized per current NCDENR-DWQ recommendations, was added to provide diffuse flow for the drainage system from the roadway. This does not cause any additional impacts.

Regulatory Issue: Riparian buffer rule

Issue: The roadway drainage systems on the construction plan do not match those shown on the permit drawings.

Status: Not constructed.

Resolution: Drainage has been revised. Structures #31 and #27 have been shifted to reduce pipe lengths that were determined to be unnecessary. The drainage systems associated with these structures still collect stormwater from the same drainage area as in the previous design, so no additional area has been directed toward the level spreader or PFSH. No additional impacts have occurred.

Regulatory Issue: Riparian buffer rule

No additional impacts occur at this site.

Site 6 Section CC (Permit Drawings 12 of 24 dated 3/22/02 and 13 of 24 dated 4/8/02) and Construction Plan Sheet 8

Issue: The construction plan indicates placement of riprap for bank stabilization at the outlet of the box culvert. This riprap is not indicated on the permit drawings.

Status: Not constructed.

Resolution: The riprap was inadvertently omitted from the permit drawings and is necessary for bank stabilization. An additional 4 meters (13 feet) of stream impacts have occurred as a result of this change and have been added to the impact summary.

Regulatory Issue: Riparian buffer rule, Section 404 permit, Section 401 certificate

Issue: The permit drawing depicts a lateral base ditch that originates at the railroad and terminates at the creek on the west side of the roadway. The construction plans indicate this lateral ditch has been removed and replaced with toe protection.

Status: Ditch is constructed, protection has not been placed.

Resolution: The 2GI that was located at station 159+30 left was found to be excessive and removed. The stormwater is collected by the 2GI located at station 158+60 left and directed to the level spreader. The ditch was found to be excessive and removed in lieu of toe protection. The same drainage area is directed toward the level spreader as from the previous design. No additional impacts have occurred.

Regulatory Issue: Riparian buffer rule

Issue: The level spreader shown on the permit drawing left of station 158+40 is located within the buffer zone and adjacent to the stream bank.

Status: Not constructed.

Resolution: During the site visit on 11/10/03 with Steve Mitchell (NCDENR-DWQ), it was determined that this level spreader should be moved back outside of the buffer zone and the ditch eliminated within the buffers. This has been depicted in the permit drawing and plans to match accordingly. This revision has reduced the buffer impacts to Zone 1 by 0.025 hectares (0.062 acres) and to Zone 2 by 0.007 hectares (0.017 acres).

Regulatory Issue: Riparian buffer rule

Issue: The permit drawing depicts a lateral base ditch that terminates at the creek on the eastern side of the roadway. The construction plan depicts a reconfigured lateral ditch that terminates at the edge of the riparian buffer at the level spreader. Toe protection is depicted along the fill slope within the riparian buffer.

Status: Ditch is constructed, protection has not been placed.

Resolution: The level spreader depicted on the permit drawing is ineffective. This area was redesigned to direct the ditch flow into the level spreader so that diffuse flow could be provided before the buffer. The ditch was eliminated in the buffers and replaced with toe protection. This revision reduced the buffer impacts to Zone 1 by 0.042 hectares (0.104 acres) and to Zone 2 by 0.034 hectares (0.084 acres).

Regulatory Issue: Riparian buffer rule

Issue: The structure at Station 159+40 right shown on the permit drawings has been removed from the construction plan. Structure #43 has been added to the construction plans in the median. This structure was not shown in the permit drawings.

Status: Not constructed.

Resolution: The structure located at 159+40 right was no longer needed and eliminated from the construction plans. Structure #43 was added due to revisions in the guardrail configuration that caused a false sump in the median. The same discharge is still directed toward the level spreader. No additional impacts have occurred as a result of this change.

Regulatory Issue: Riparian buffer rule

'Existing Channel Impacted' increased by 4 meters (13 feet). Zone 1 buffer impacts decreased by 0.067 hectares (0.166 acres) and Zone 2 impacts decreased by 0.041 hectares (0.101 acres).

Site 7 and 8 Section CC (Permit Drawings 14 of 24 dated 4/8/02 and 15 of 24 dated 4/8/02) and Construction Plan Sheets 10A and 10D

Issue: Construction plan sheet 10A and 10D indicates that the structures located at station 16+20 –RPBDY1- and station 13+95 –RPCY1- are 900 mm pipes. The permit drawing indicates that these structures are 1500 mm pipes.

Status: Constructed.

Resolution: The 1500 mm pipes were found to be excessive and were redesigned

according to NCDOT guidelines to 900 mm pipes.

Regulatory Issue: Section 404 permit, Section 401 certificate

Issue: The permit drawings indicate a headwall at the inlet of a 1500mm pipe that captures a stream. Construction plan sheet 10A indicates a junction box and additional 750 mm and 400 mm pipes that flows into the junction box.

Status: Constructed.

Resolution: The stream at the inlet of the pipe is shown on the permit drawings as being filled by construction of –L-. A diversion was detected from the drainage design shown on the permit. To correct the diversion, it was necessary to add a cross pipe under –L-. Also, it was determined that there was not sufficient room between the fill slopes to have an open channel as shown on the permit drawing, so an open throat catch basin was specified to join the two pipes. The fill in the gore area between -Ramp BDY1- and -L-would have completely covered both ends of the pipes. No additional impacts occur, as this entire area was included in the original impact summary.

Regulatory Issue: Riparian buffer rule, Section 404 permit, Section 401 certificate

Issue: Construction plan sheet 10A indicates toe protection along the eastern fill slope of the –L- line that is within the riparian buffer. This toe protection is not depicted on the permit drawing.

Status: Not constructed.

Resolution: Toe protection for Section CC will impact 0.6 meters (2 feet) outside of the fill slope. In this area, toe protection does not impact any additional area since the entire area was included in the original impact summary.

Regulatory Issue: Riparian buffer rule

Issue: The permit drawing indicates that a PFSH is located along –Ramp BDY1- at Station 16+00 left. The construction plan show the PFSH located at station 15+80 right. **Status:** PFSH not constructed, pipes and structures are in place.

Resolution: Upon reviewing the permit drawing, it was determined that the PFSH was located in the gore area on the side of a 2:1 slope where the fill slopes from –Ramp BDY1- and –L- converge. This PFSH was moved to the opposite side of -Ramp BDY1- to a level area so that it can function appropriately.

Regulatory Issue: Riparian buffer rule

Issue: Between –Ramp BDY1- and –Ramp CY1-, the permit drawings indicates that two pipes are separated with approximately 2 meters of stream located between the pipes. Construction plan sheet 10D indicates the two pipes are joined by a junction box.

Status: Constructed.

Resolution: The drainage on the permit drawings will not function as shown because the fill slopes from the ramps converge to cover both pipe ends as shown in the permits. The open channel could not be maintained and this area was revised to add an open throat catch basin where the fill slopes converge. No additional impacts have occurred, as this entire area was included in the original impact summary.

Regulatory Issue: Riparian buffer rule, Section 404 permit, Section 401 certificate

Issue: The permit drawing indicates that a PFSH is located along –Ramp CY1- at Station 14+30 right. This PFSH has been eliminated from the construction plans.

Status: Deleted.

Resolution: The drainage structure associated with this PFSH was found to be excessive and removed. The runoff that was collected by this structure is treated in a properly sized PFSH located at station 15+30 –Ramp CY1- right. No additional impacts occur.

Regulatory Issue: Riparian buffer rule

Issue: Construction plan sheet 10D indicates toe protection within the riparian buffer along both sides of the stream. The permit drawings depict toe protection within the buffer only south of the stream.

Status: Not constructed.

Resolution: Toe protection for Section CC will impact 0.6 meters (2 feet) outside of the fill slope. In this area, toe protection does not impact any additional area since the entire area was included in the original impact summary.

Regulatory Issue: Riparian buffer rule

No additional impacts occur at this site.

Site 9 and Site 10 Section CC (Permit Drawing 16 of 24 dated 4/8/02 and 17 of 24 dated 4/8/02) and Plan Sheets 10D and 11C

Issue: Construction plan sheet 10D indicates that riprap will be placed at the outlet of the 1350mm pipe where bank excavation has been conducted. The permit drawings do not depict the riprap and instead depict a cross vane at the outlet.

Status: Not constructed.

Resolution: The cross vane was inadvertently left off the drainage plans and will be added to the construction plans. The riprap on the channel banks should remain for stability. The riprap at the pipe outlet will not cause any additional impacts since it will be installed in the portion of channel required to tie to the existing stream.

Regulatory Issue: Section 404 permit, Section 401 certificate

Issue: Construction plan sheet 10D indicates toe protection within the buffer along the southern fill slope of –Ramp CY1-. This toe protection is not depicted on the permit drawings.

Status: Constructed.

Resolution: Toe protection for Section CC will impact 0.6 meters (2 feet) outside of the fill slope. In this area, toe protection does not impact any additional area since the fill slopes in this area were revised to 1.5:1 slopes, which reduced the buffer impacts. Impacts to Zone 1 have decreased by 0.003 hectares (0.007 acres).

Regulatory Issue: Riparian buffer rule

Issue: Construction plan sheet 10D depicts a PFSH at station 15+35 –Ramp CY1- right, outside of the riparian buffer. The permit drawings depict a 3-meter level spreader in this area. Additionally, drainage structures have been moved in this area within the riparian buffer.

Status: PFSH not constructed, drainage line is in place.

Resolution: Due to the contour of the existing land, a PFSH would function better in this area. Also, drainage structure #66 was moved from Station 14+60 to Station 15+00 - Ramp CY1- to eliminate an excessive length of pipe. The PFSH was sized per current NCDENR-DWQ guidelines to provide diffuse flow outside the riparian buffer. No additional impacts occur.

Regulatory Issue: Riparian buffer rule

Issue: Construction plan sheet 10D depicts a lateral base ditch along the northern slope of –Ramp CY1- in the buffer. The permit drawings do not depict this ditch.

Status: Constructed.

Resolution: An off-site drainage area was unaddressed in the previous permit drawing right of station 16+75—Ramp CY1-. The drainage area required a cross pipe to be added to drain this area. With the addition of this pipe, a lateral ditch was required at the outlet to convey the discharge adequately. The drainage area that the ditch carries is too large to implement a level spreader or PFSH at the buffer limits. Almost all of the drainage is from off site. The small percentage of on-site runoff from impervious surfaces is entirely sheet-flow and travels through a minimum of fifty feet of grassed area before entering the ditch. The ditch is rock lined to address the design velocities and prevent erosion. It will not impact any additional buffers since this entire area was included in the original impact summary.

Regulatory Issue: Riparian buffer rule

Issue: Construction plan sheet 11C depicts toe protection within the riparian buffer along the northern and southern fill slopes of –Ramp BDY1- and –Ramp CY1-. The toe protection is not depicted on the permit drawings.

Status: Not constructed.

Resolution: The northern fill slope for –Ramp CY1- was revised to 2:1 and reduced the buffer impacts. Although toe protection for Section CC will impact 0.6 meters (2 feet) outside of the fill slope, the buffer impacts have been reduced by the revision to the fill slope. However, no impact reduction has been shown in the revised impact summary since the entire area was included in the original impact summary.

Issue: The permit drawing depicts a level spreader located at Station 18+60 -Ramp

BDY1- left. This level spreader is not shown on the construction plans.

Status: Construction not required.

Resolution: This level spreader was located at the outlet of a system that has been removed. The concentrated flow no longer exists, thus the level spreader was no longer necessary.

Regulatory Issue: Riparian buffer rule

Issue: The permit drawings indicate that the structure under –Ramp BDY1- is a 1350 mm pipe. Construction plan sheet 11C depicts the structure is a 1200 mm pipe.

Status: Constructed.

Resolution: The 1350 mm pipe was found to be excessive and was redesigned according

to NCDOT guidelines to a 1200 mm pipe.

Regulatory Issue: Section 404 permit, Section 401 certificate

Issue: The permit drawing depicts the inlet of the structure under –Ramp BDY1-originating directly outside of the fill slope and not connecting to an existing pipe underneath existing US 64. Construction plan sheet 11C depicts the inlet of the structure directly connected by a junction box to the existing pipe under fill.

Status: Constructed.

Resolution: The fill slopes on the permit drawing have been revised to show the actual bridge approach fill, which covers this area completely. This change will impact an additional 10 meters (33 feet) of stream and has been added to the impact summary. Also, impacts to buffer Zone 1 increased by 0.003 hectares (0.007 acres) and to Zone 2 by 0.002 hectares (0.005 acres).

Regulatory Issue: Riparian buffer rule, Section 404 permit, Section 401 certificate

Issue: The permit drawing depicts drainage structures that flow to a level spreader at Station 17+60 –Ramp BDY1- right. These devices are not depicted on construction plan sheet 11C.

Status: Deleted.

Resolution: Several drainage structures were found to be excessive on –Ramp BDY1-. These devices were removed and the drainage system has been revised to a single inlet that directs the discharge to the opposite side of the ramp outside of the riparian buffers to a PFSH, sized per current NCDENR-DWQ recommendations. No additional impacts occur as a result of this change.

Regulatory Issue: Riparian buffer rule

Issue: The outlet of the 1200 mm pipe under –Ramp BDY1- (Structure #101) is perched approximately 0.6 meters (2 feet). The pipe was installed to the correct grade in the bed of the channel; the channel bed has degraded since the installation.

Status: Pipe has been constructed. Cross vanes have not been constructed.

Resolution: It is proposed to add two cross vanes between the two ramps to provide grade control and stabilize the channel from further degradation. The channel will be regraded so that the upstream pipe will be buried 20 percent. These revisions will not cause any additional impacts as this entire area had been previously mitigated. **Regulatory Issue:** Section 404 permit, Section 401 certificate

In addition, permit drawings 16 and 17 contradict each other and show two separate layouts for drainage. Permit drawing 16 shows several pipes that outlet directly into the stream.

At Site 9, an additional 10 meters (33 feet) of 'Existing Channel Impacted' and 0.001 hectares (0.003 acres) of 'Fill in Surface Waters' have occurred. Also, impacts to buffer Zone 1 increased by 0.003 hectares (0.007 acres) and to Zone 2 by 0.002 hectares (0.005 acres).

At Site 10, impacts to Zone 1 have decreased by 0.003 hectares (0.007 acres).

Site 11 and Site 12 Section CC (Permit drawing 18 of 22 dated 3/22/02) and Construction Plan Sheets 14 and 15

Issue: Construction plan sheet 15 depicts a PFSH inside the wetland limits located at the outlet of a pipe and an additional drainage inlet at Station 186+05 right. These features are not depicted on the permit drawing.

Status: PFSH not constructed, drainage pipe is in place.

Resolution: Shoulder berm gutter was added due to the addition of guardrail in this area. This required a drainage inlet to be added. A PFSH, sized per current NCDENR-DWQ recommendations, was added to diffuse the flow from the outlet pipe. The PFSH will impact an additional 0.002 hectares (0.006 acres) of wetlands.

Regulatory Issue: Riparian buffer rule, Section 404 permit, Section 401 certificate

Overall at these sites, the impacts have been reduced by better delineation of the cut/fill slopes than were shown in the permit drawings. At Site 11, 'Fill in Wetlands' impact was reduced by 0.009 hectares (0.022 acres) and 'Mechanized Clearing' was reduced by 0.017 hectares (0.042 acres). At Site 12, 'Fill in Wetlands' was reduced by 0.008 hectares (0.020 acres) and 'Mechanized Clearing' was reduced by 0.074 hectares (0.183 acres).

Site 13 Section CC (Permit drawing 19 of 24 dated 3/22/02 and 20 of 24 dated 4/8/02) and Construction Plan Sheet 20

Issue: The permit drawings depict a lateral ditch that flows to a level spreader on the south side of -Y3. The construction plan depict a reconfigured lateral ditch that conveys additional drainage from the north side of -Y3.

Status: Constructed.

Resolution: The ditch on the south side of -Y3- was reconfigured based on existing field conditions and causes no additional impacts to the level spreader design. No additional drainage area has been added to the lateral ditch from the permit.

Issue: The permit drawings depict a drainage pipe with a PFSH located at Station 12+20 RT -Y3-. The construction plan depicts the PFSH and drainage system located at Station 11+80 RT -Y3-

Status: Not constructed.

Resolution: Additional shoulder berm gutter was added which betters protects the buffers as runoff that previously flowed directly into the buffers is now collected and directed to a PFSH, sized per current NCDENR-DWQ recommendations, outside of the riparian buffer. No additional impacts occur as a result of this change.

Regulatory Issue: Riparian buffer rule

Issue: The construction plans depict a lateral ditch, toe protection, and an additional inlet (structure #202) on the north side of –Y3-. These features are not depicted on the permit drawing.

Status: Constructed.

Resolution: These revisions do not impact the buffer zones or jurisdictional streams

since both do not begin until the south side of -Y3-.

Regulatory Issue: Riparian buffer rule

No additional impacts occur at this site.

Site 14 Section CC (Permit Drawing 21 of 24 dated 2/7/01 and 22 of 24 dated 2/7/01) and Construction Plan Sheet 13

Issue: The permit drawings depict fill in surface water at station 180+60 right, but do not depict a relocated channel for this fill. The construction plan submitted and approved as part of the original permit application depict the stream relocation as a riprap lined channel (including riprap in the bottom of the channel).

Status: Constructed.

Resolution: The stream relocation detail has been revised to show riprap only on the banks of the channel. No additional stream impacts have occurred as a result of this revision as the portion of the channel and the buffer impacts were accounted for in the original impact summary.

Regulatory Issue: Section 404 permit, Section 401 certificate

Issue: The construction plan submitted and approved as part of the original permit application depicts a lateral ditch and several structures along the southern fill slope of the roadway right of Station 180+00. This lateral ditch is not depicted on the permit drawings.

Status: Constructed.

Resolution: A lateral base ditch was retained and revised on the southern fill slope to convey off-site drainage. The design was further revised to make use of the existing 750mm pipe that runs laterally along the right side of the roadway that was originally believed to not be in place.

Regulatory Issue: Riparian buffer rule, Section 404 permit, Section 401 certificate

Issue: The current construction plan depicts additional inlets (structures #205 and #206) right of stations 180+00 and 180+40. These inlets are not shown on the permit drawings or the construction plan submitted and approved as part of the original permit application. **Status:** Constructed, except PFSH.

Resolution: Shoulder berm gutter was required due to the addition of guardrail, which required the additional inlets to provide adequate roadway surface drainage. The additional inlets will be directed to a PFSH, sized per current NCDENR-DWQ recommendations.

Regulatory Issue: Riparian buffer rule

Issue: The current construction plan depict an additional pipe (structure #145) right of station 180+40. This pipe is not shown on the permit drawings or the construction plan submitted and approved as part of the original permit application.

Status: Constructed.

Resolution: NCC encountered an existing pipe during construction that was not shown in the design. The pipe was extended as required and does not cause any additional impacts.

Regulatory Issue: Riparian buffer rule, Section 404 permit, Section 401 certificate

Issue: The current construction plan depicts a lateral ditch along the northern fill slope of the roadway left of –L- from 180+30 to 181+00. This ditch is not depicted on the permit drawings or the construction plan submitted and approved as part of the original permit application.

Status: Constructed.

Resolution: The jurisdictional stream and buffers do not begin until the southern side of the roadway right of –L-. Therefore, the ditch is not in a buffer zone and does not cause any impact. The ditch is necessary to convey off-site stormwater to the existing cross pipe. This ditch only replaces the existing ditch.

Regulatory Issue: Riparian buffer rule

No additional impacts occur at this site. The quantity included in the original impact summary under 'Enclosed Channel' was removed since there was an existing pipe under US 64 and no existing channel was enclosed.

REGULATORY APPROVALS

Application is hereby made for the modification of the Department of Army Individual 404 Permit as required for the above-described activities. We are also hereby requesting a modification of the 401 Water Quality Certification and Neuse Buffer Certification from the NCDENR-DWQ. R-2547 BB, C, and CC has been designed to comply with the Riparian Buffer Mitigation Program (15A NCAC 2B .0242) and the Neuse River Basin Riparian Buffer Rules (15A NCAC 2B .0233). Therefore, as part of the Modification request, we respectfully request that the NCDENR-DWQ issue an Authorization Certificate pursuant to 15A NCAC 2B .0233 for the proposed use. In compliance with Section 143-215.3D(e) of the NCAA we have provided a method of debiting \$200, as noted in the subject line of this application, as payment for processing

the Section 401 Water Quality Certification modification application. We are providing seven copies of this application to NCDENR-DWQ, for their use.

This modification application contains revised permit application sheets 5, 6, 8, 9, 12, 13, 14, 15, 17, 20, 22, 23, 24, and 29 of 30 and new sheet 20A for Section BB; sheets 9, 11, 12, 14, 15, 16, 18, 19, 20, 21, 22, 23, 26, 27, 29, 30, 31, and 34 of 34 and new sheets 20A, 20B, 20C and 22A for Section C; sheets 6, 7, 8, 9, 12, 13, 14, 15, 16, 16A, 17, 18, 19, 20, 21, 22, and 23 of 24 for Section CC.

If you have any questions or need additional information, please call Ms. Alice N. Gordon at (919) 715-1421 or 715-1500.

Sincerely,

Gregory V. Thorpe, Ph.D., Manager
Project Development and Environmental Analysis Branch

cc: w/attachment

David Franklin, USACE, Wilmington Field Office

Travis Wilson, NCWRC

Garland Pardue, USFWS, Raleigh

John Sullivan III, P.E., FHWA

John Hennessy, NCDENR-DWQ

John G. Nance, P.E., Division 5 Engineer

Chris Murray, Division 5 DEO

Tracy Parrot, P.E., Division 5 Construction Engineer

Steve Leonard, Division 5 Resident Engineer

Paul Newman, North Carolina Constructors

Ing. Martijn Bolster, North Carolina Constructors

Alice N. Gordon, NCDOT Environmental Supervisor

w/out attachment

Calvin Leggett, P.E. Program Development Branch

Art McMillan, P.E., Highway Design Branch


David Chang, P.E., Hydraulics Unit


Greg Perfetti, P.E., Structure Design Unit


Jay Bennett, P.E., Roadway Design Unit


Steve Dewitt, P.E., Director of Construction


Ellis Powell, P.E., State Construction Engineer

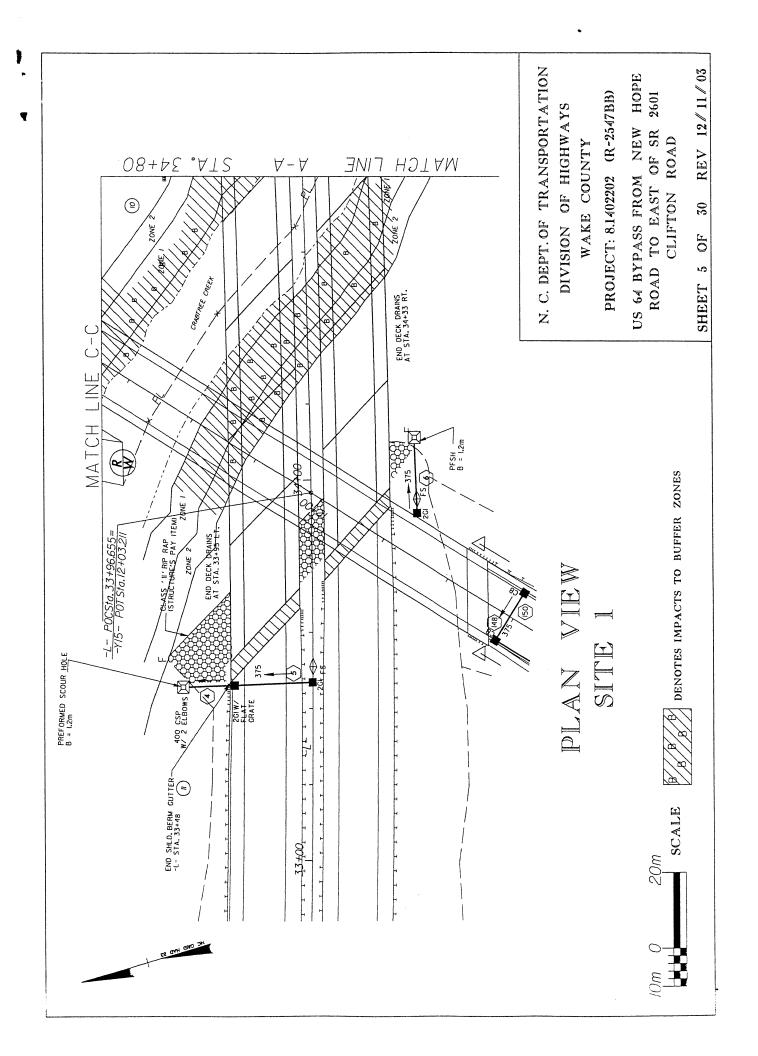


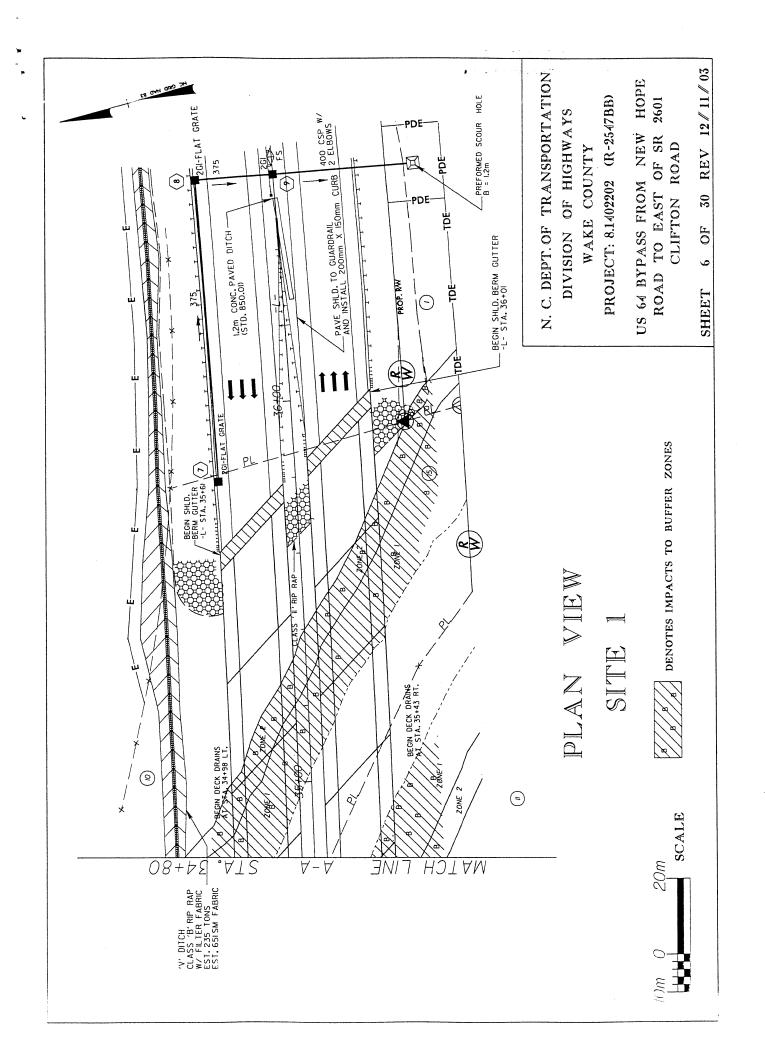


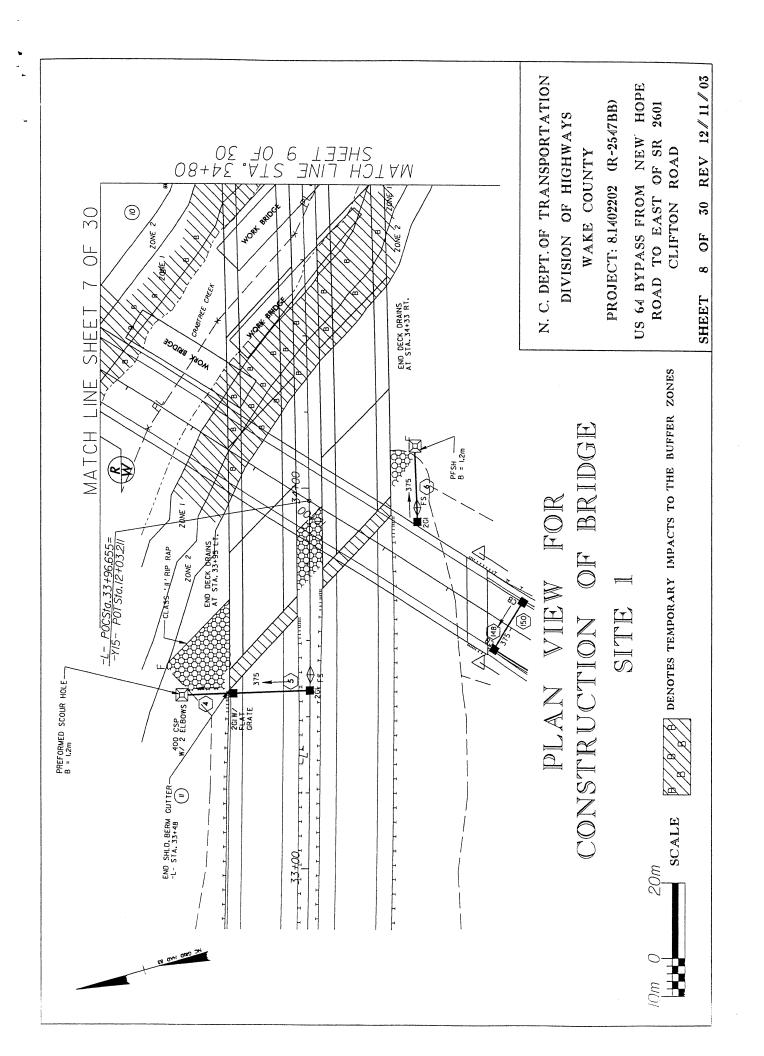


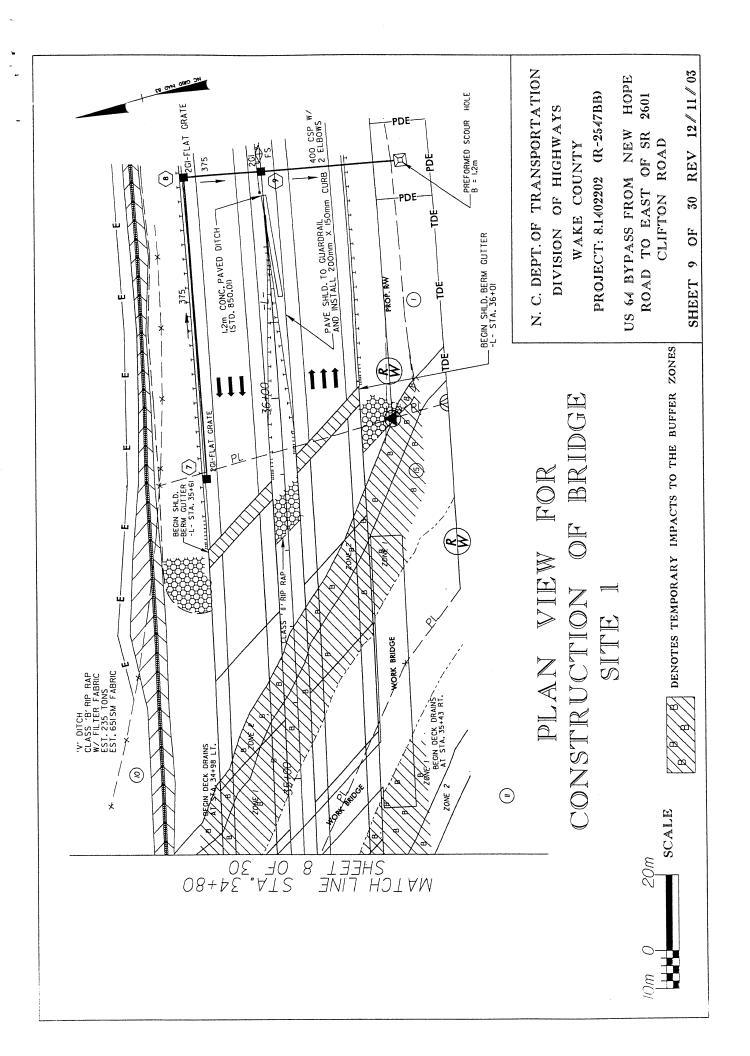


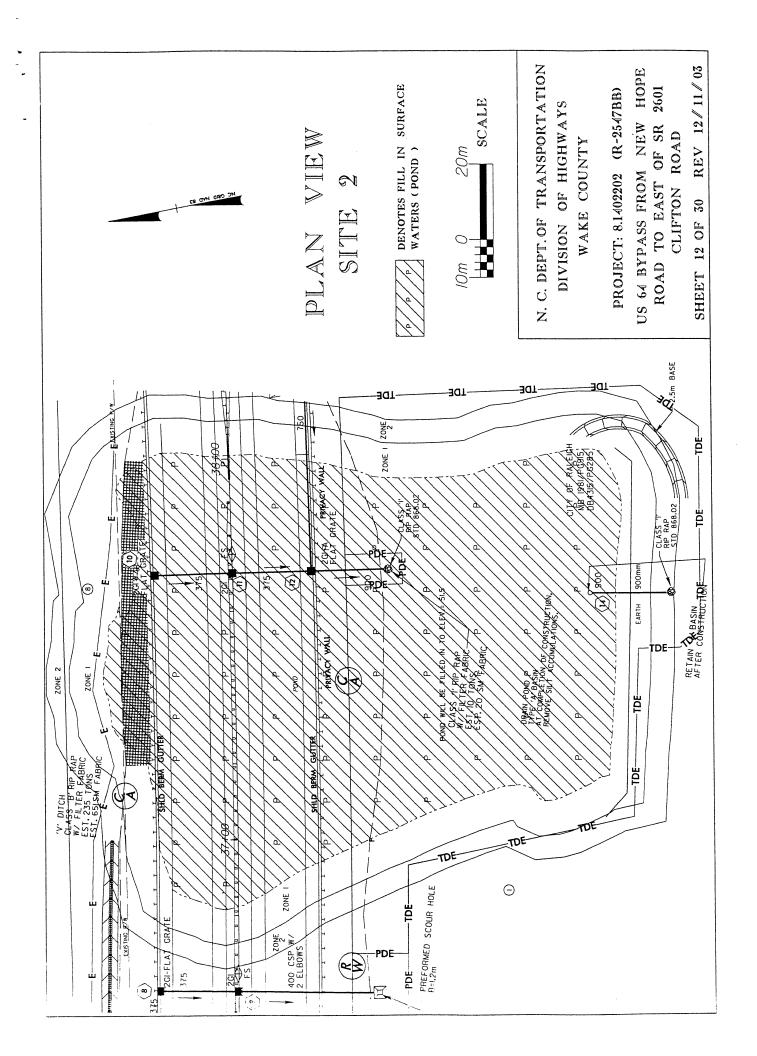


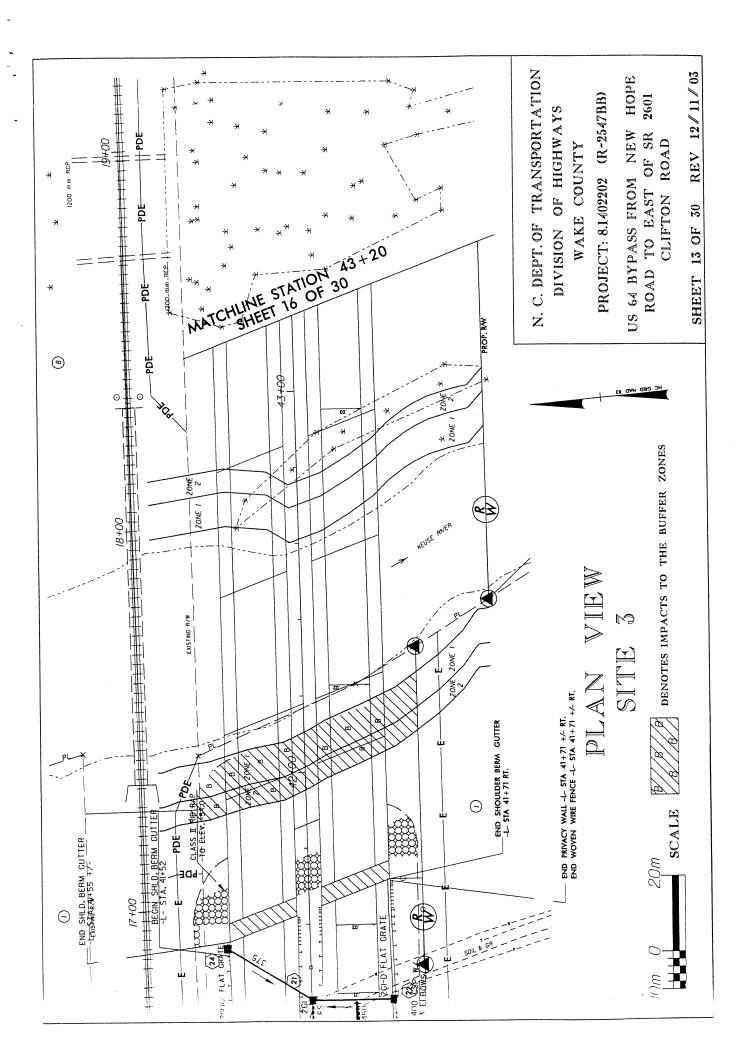


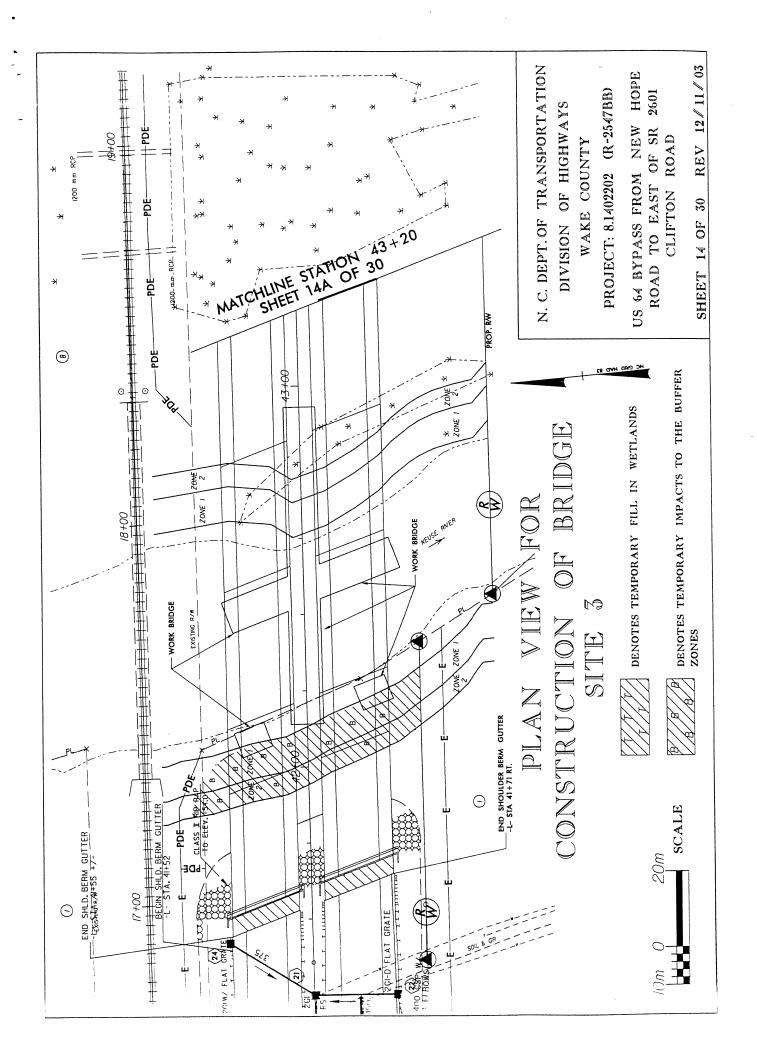


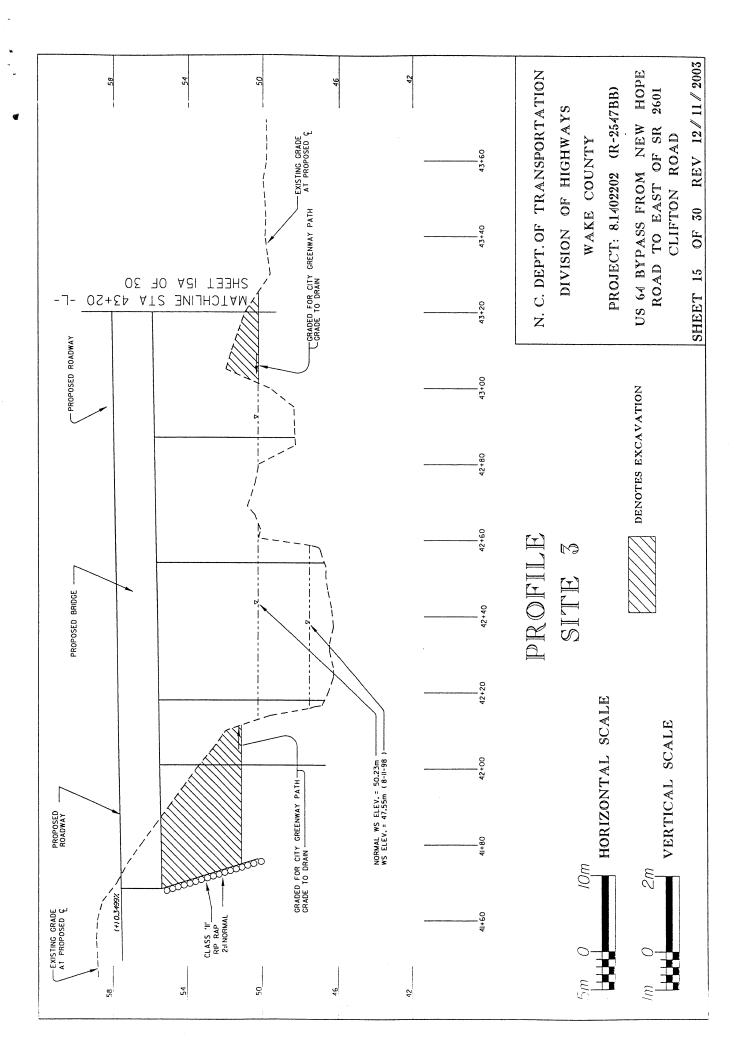


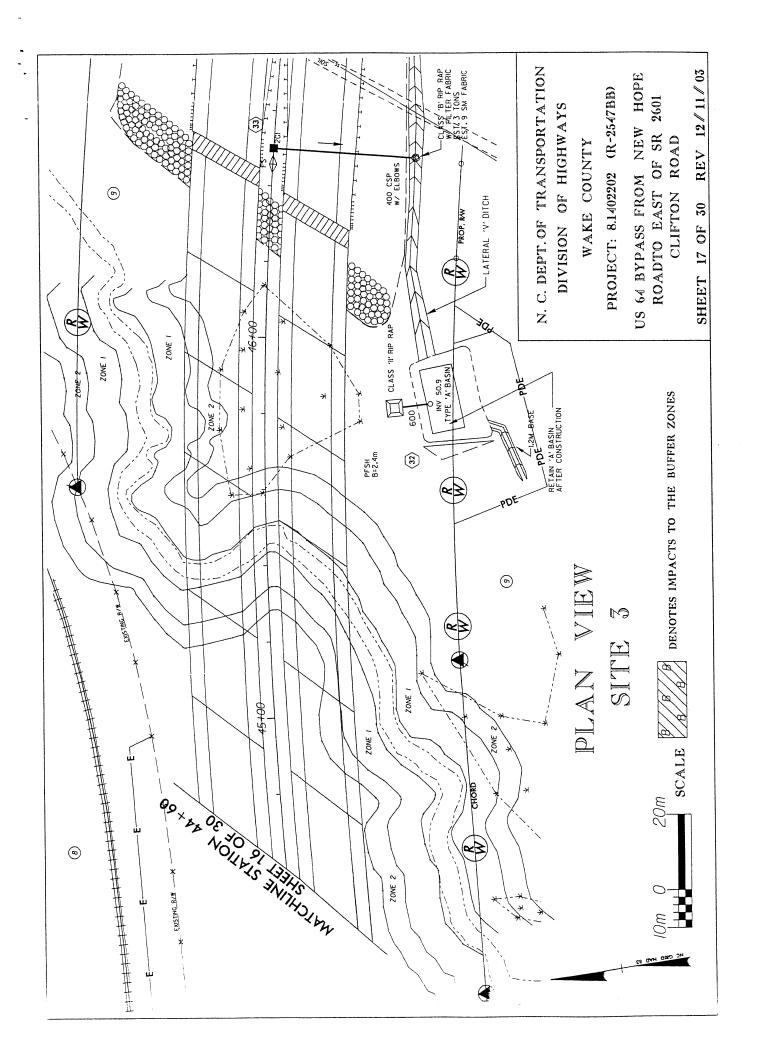


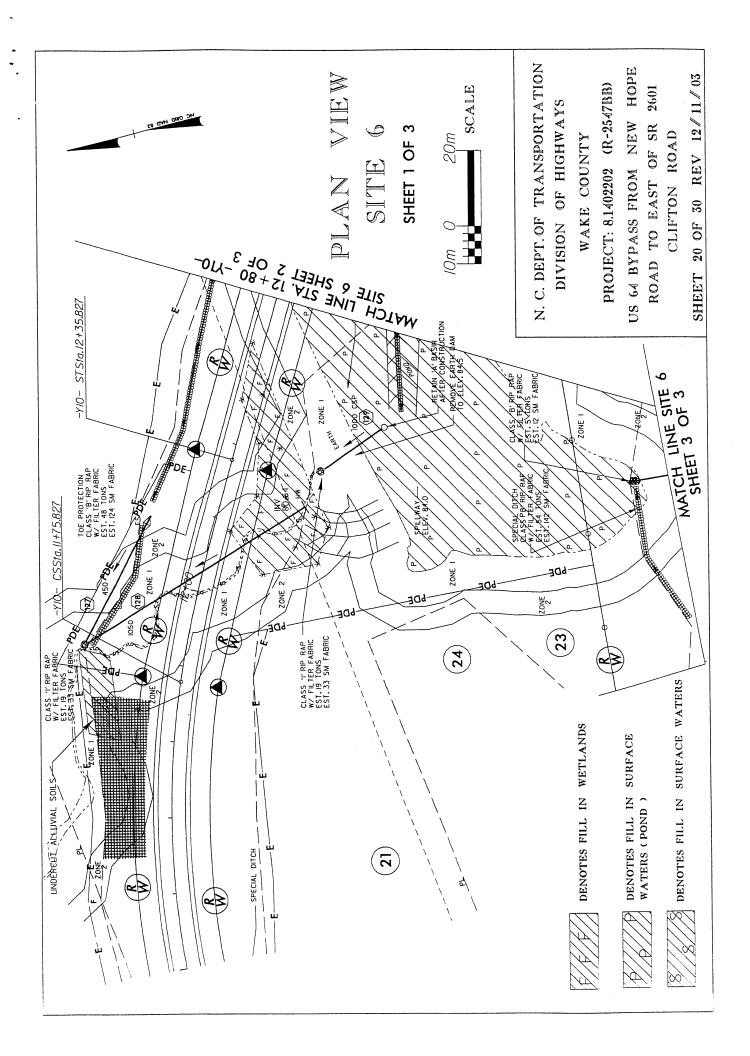

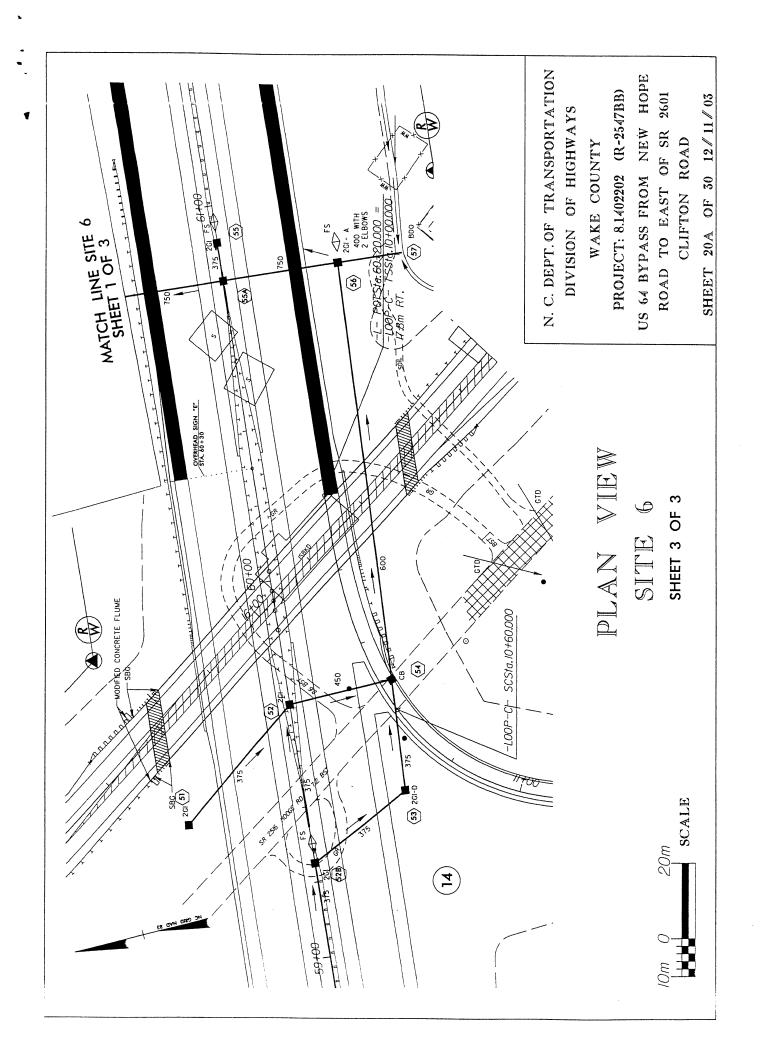


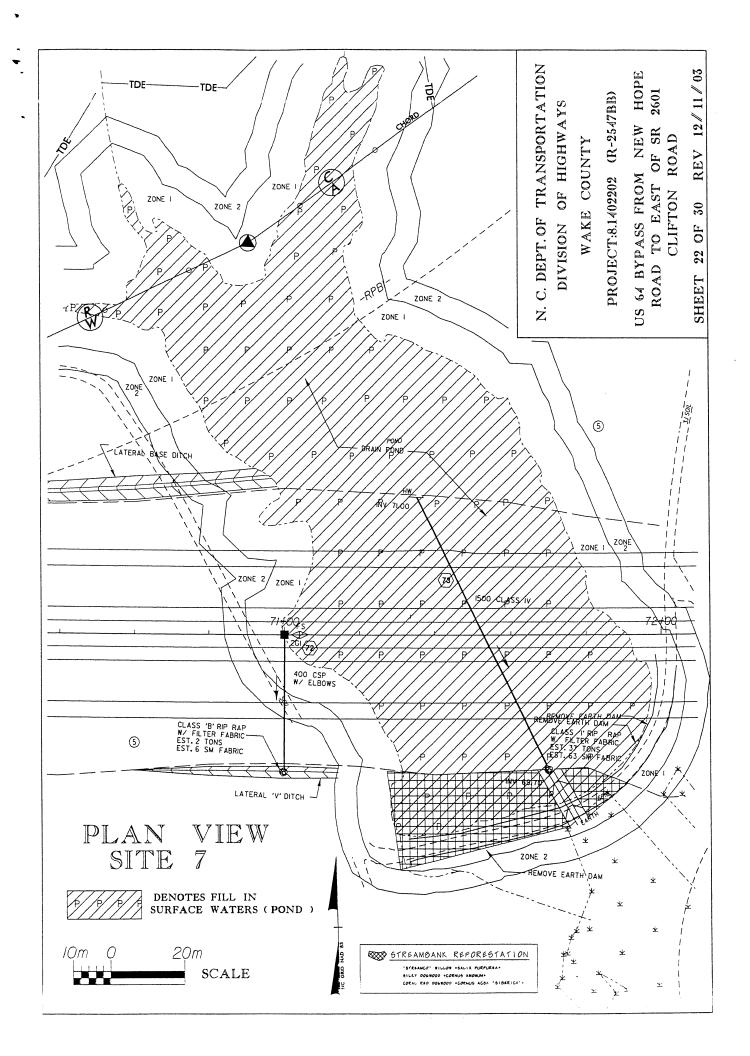


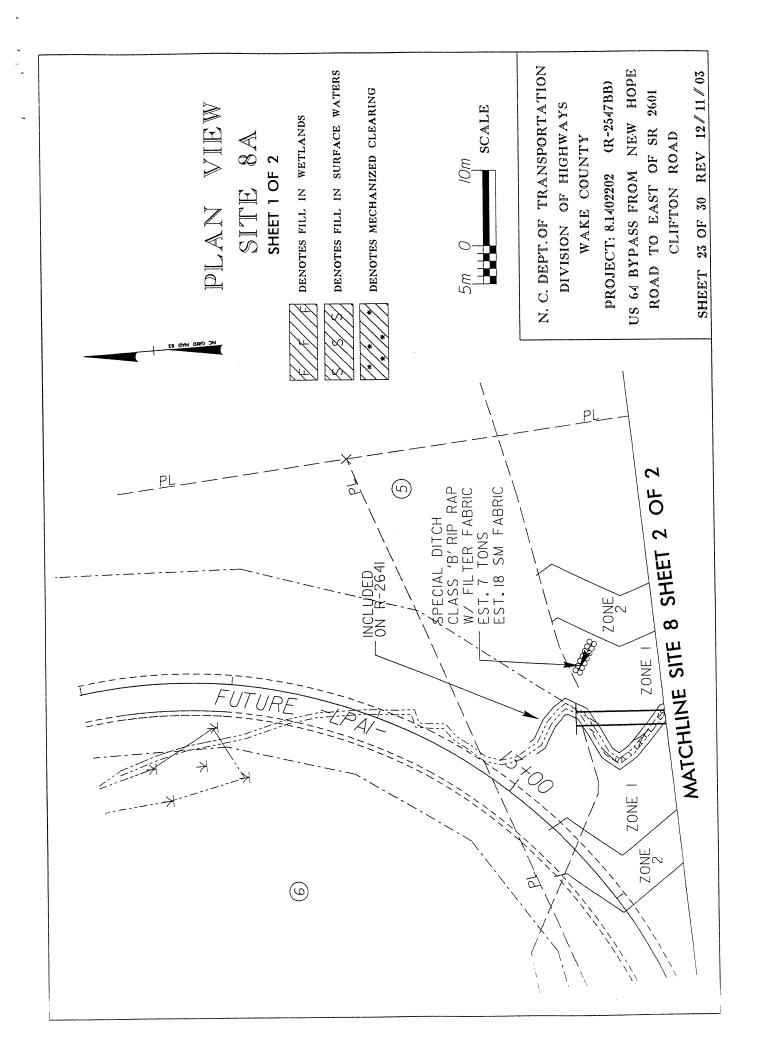


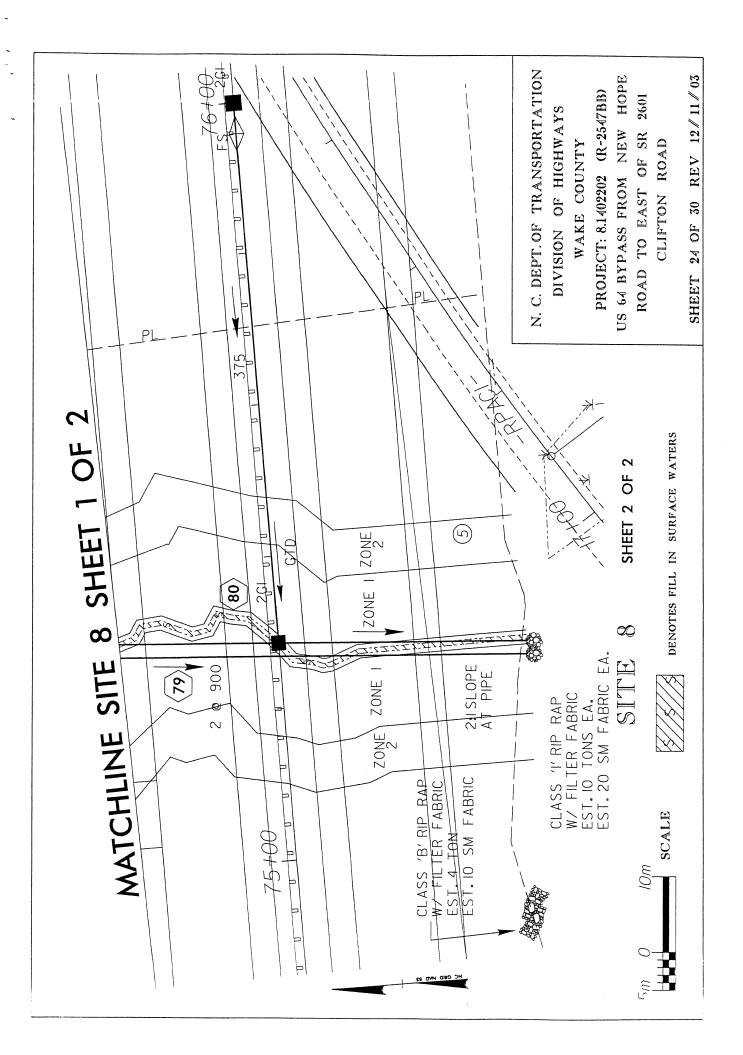



| HEFFR | מון הו | Zone 2 (ha) | 0.002 | | | 0.085 | | 0.035 | | | | 0.23 | 0.153 | 0.07 | | | 0.217 | | | 0.79 | 1.96 | | | | 12/11/2003 |
|-----------------|-----------------------|----------------------------------|-----------|------------------|------------|-------------|---|------------------|----------------|------------------|---|--------------------|------------|-------|---------------------|------------------|----------------------|------|------------|--------|----------------------|--|--------|------------------|------------|
| FILL IN BLIFFFR | ן וויר | Zone 1 (ha) | 0.241 | | 0.0005 | 0.157 | | 0.043 | | | | 0.349 | 0.239 | 0.107 | | | 0.327 | | | 1.46 | 3.62 | | | | REVISED |
| | | Enclosed Channel (m) | | | | | | | | | | | | 63 | | | 84 | | | 147.00 | 482 | | | R-2547BB | |
| | | Relocated Channel (m) | | | | | | | | | | | | | | | | | | 0.00 | 0 | ORTATION | | | |
| OT C | Existing | Channel Impacted (m) | | | | | | | | | | 93 | | 136 | | | 87 | | | 316.00 | 1037 | N.C. DEPT. OF TRANSPORTATION DIVISION OF HIGHWAYS | COUNTY | PROJEC 8.1402202 | |
| ATED IMDA | SURFACE WAIER IMPACIS | Temp. Fill In SW | 0 0 | | 0.02 | | | | | | | | | | | | | | | 0.04 | 0.10 | N.C. DEPT. DIVIS | WAKE | PROJEC | i i |
| 104701 | SURFACE V | Fill In SW (Pond) | 721 | | | 1.276 | | | | | | 1.096 | 0.71 | | | | | | | 3.08 | 7.62 | | | | |
| | | Fill In SW (Natural) | | | | | | | | | | 0.005 | | 200 | | | 0.017 | | | 0.03 | 90.0 | <u> </u> | | | |
| ARY | | Mechanized Clearing (Method III) | (IIIa) | | | | | | | | | | | 000 | 200.0 | | 0.047 | 0.00 | | 80.0 | 0.22 | | | | |
| SUMMARY | WETLAND IMPACTS | noi | (a) | | | | | | | | | | | | | | | | | | 0.00 | | | | |
| IMPACT | WETLA | ≡. | (FIII) | | | | | | | | | | | | | | | | | | 00.0 | | | | |
| | | sp | (na) | | | | | | | | | 0.073 | | 1000 | COOOD. | | 0.565 | 6,0 | 24.0 | 4 00 | 2.62 | | | | |
| | | Structure Size | L | פאוטפב | BRIDGE | | | BRIDGE | DELETEDBRIDGED | DELETEDPART OF 3 | | 1050 | 1500 RCP | | | 2 @ 900 RCP | 1 @ 2.7m X 1.8m RCBC | | | | na/meters ac/feet | | | | |
| | | Station | (From/To) | 33+80-35+80 L | 12+70 -Y15 | 36+80-38+00 | | 41+80-43+20 L | 43+20-43+80 | 44+60-46+40 | 7 | 11+80-14+40 Y10 | 71+0072+00 | | 12+60-13+00 LPA1 | 75+20-75+40 L | 79+20-79+60 |) (F | 11+60 LDC1 | | | | | | |
| | | Site No. | T | - | | 2 | 1 | ю | 4 | Ľ | | 9 | 7 | | ω | | 6 | | 10 | | TOTALS: | | | | |

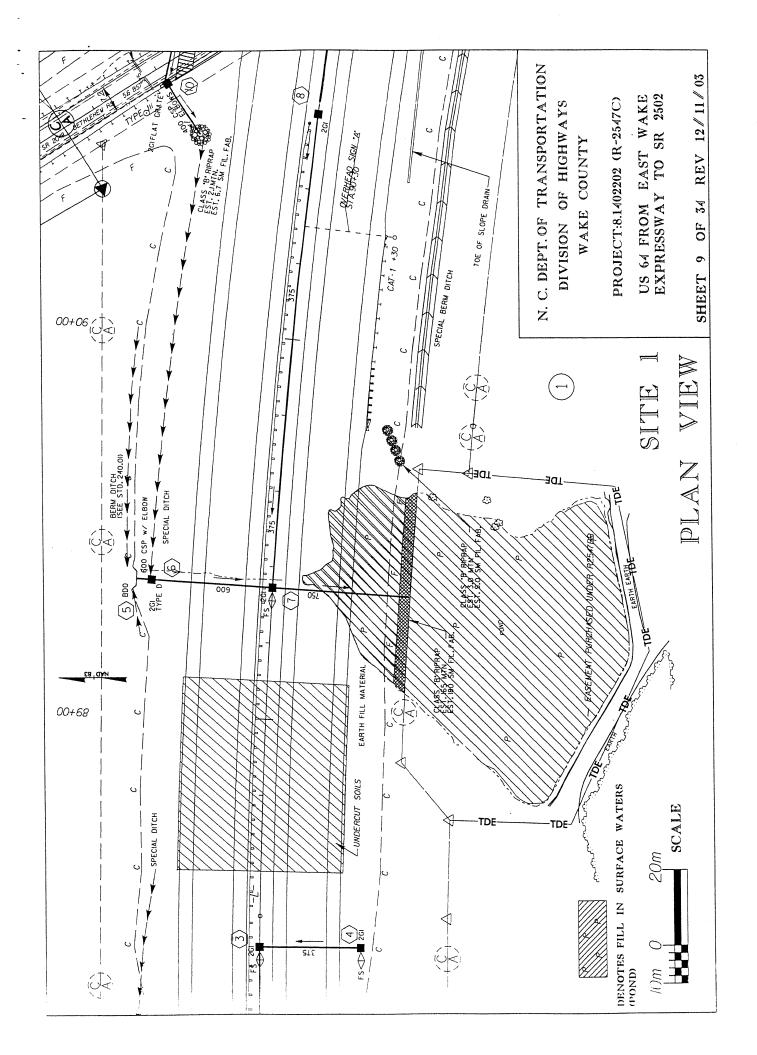


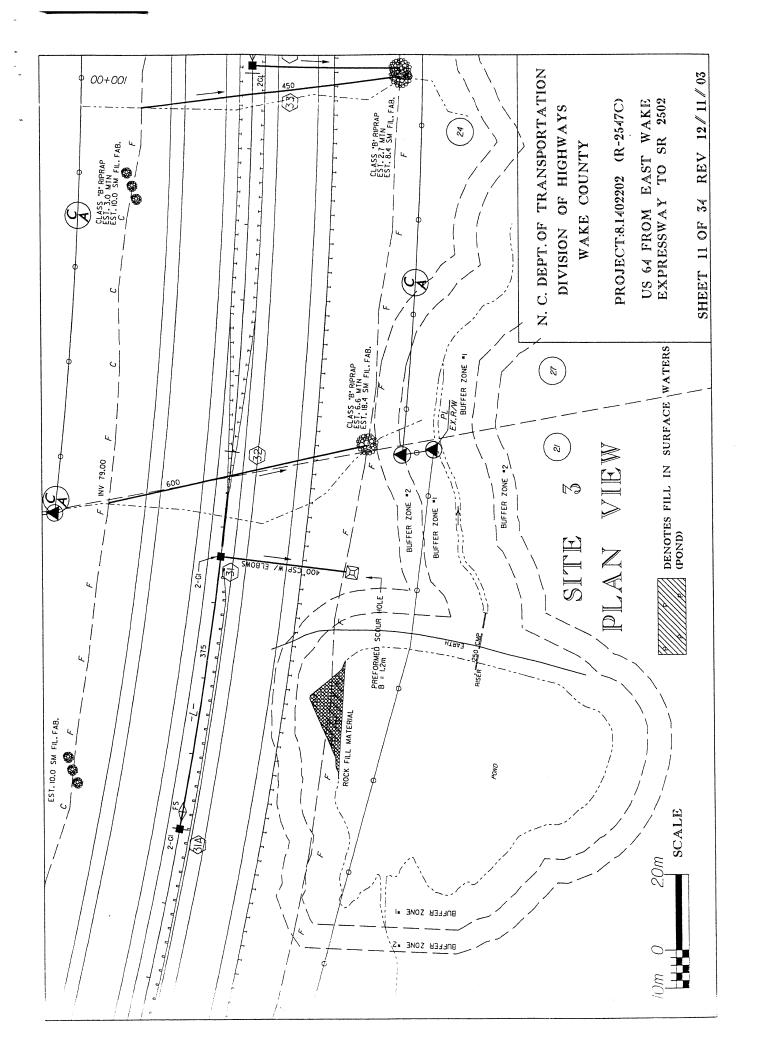


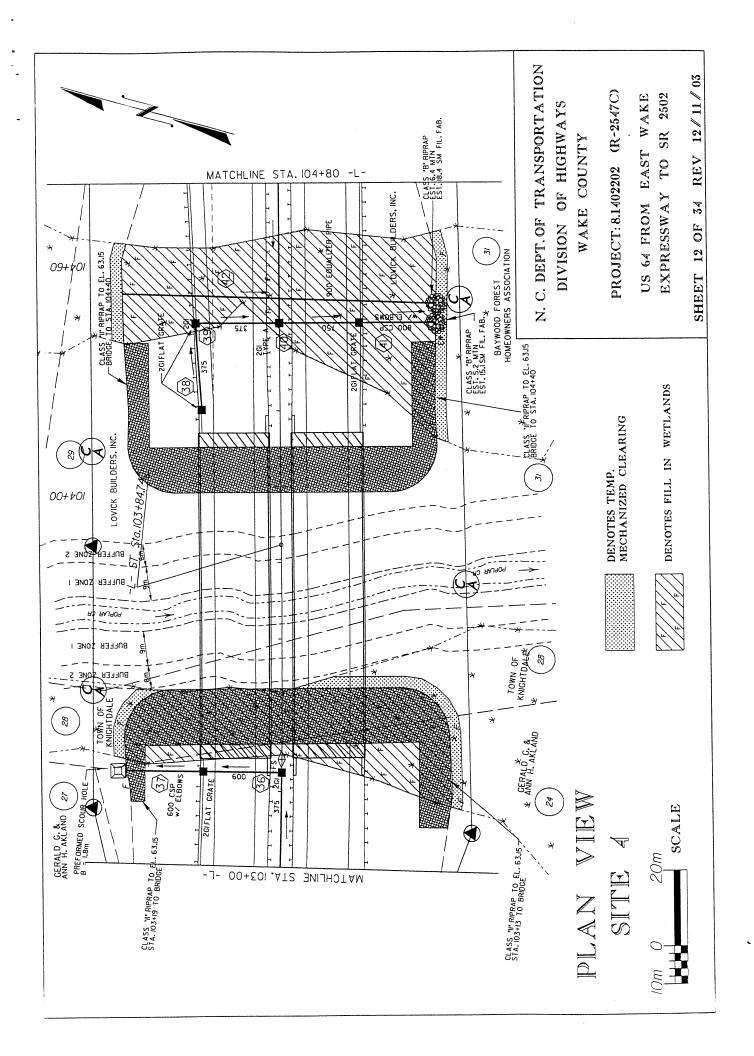


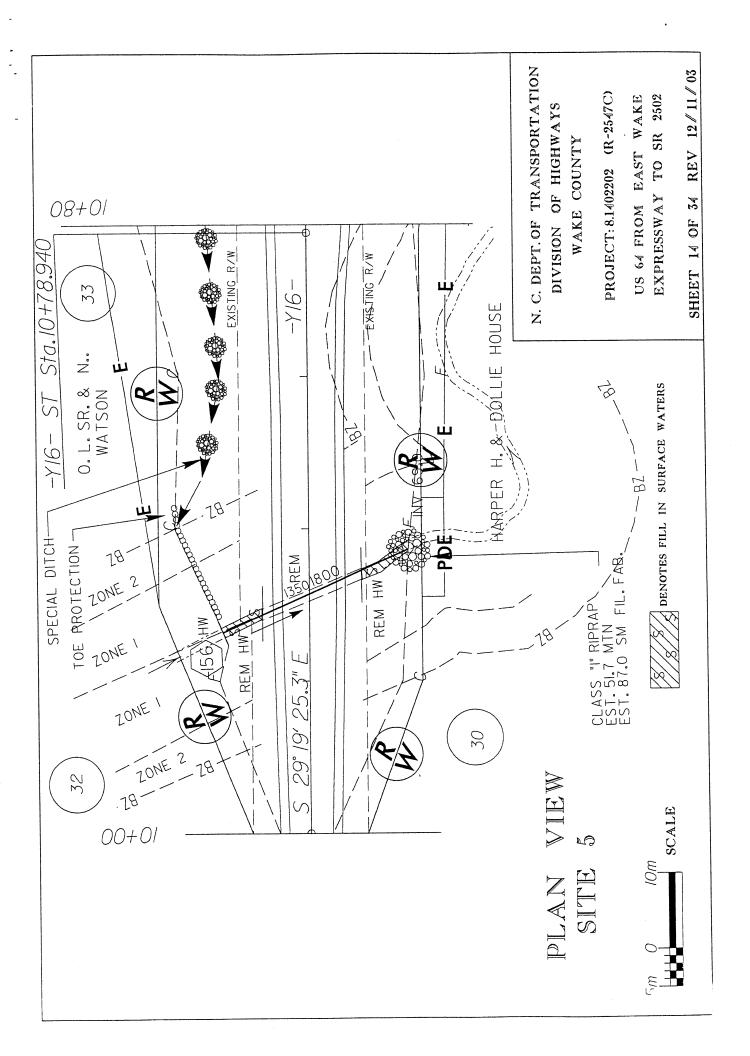


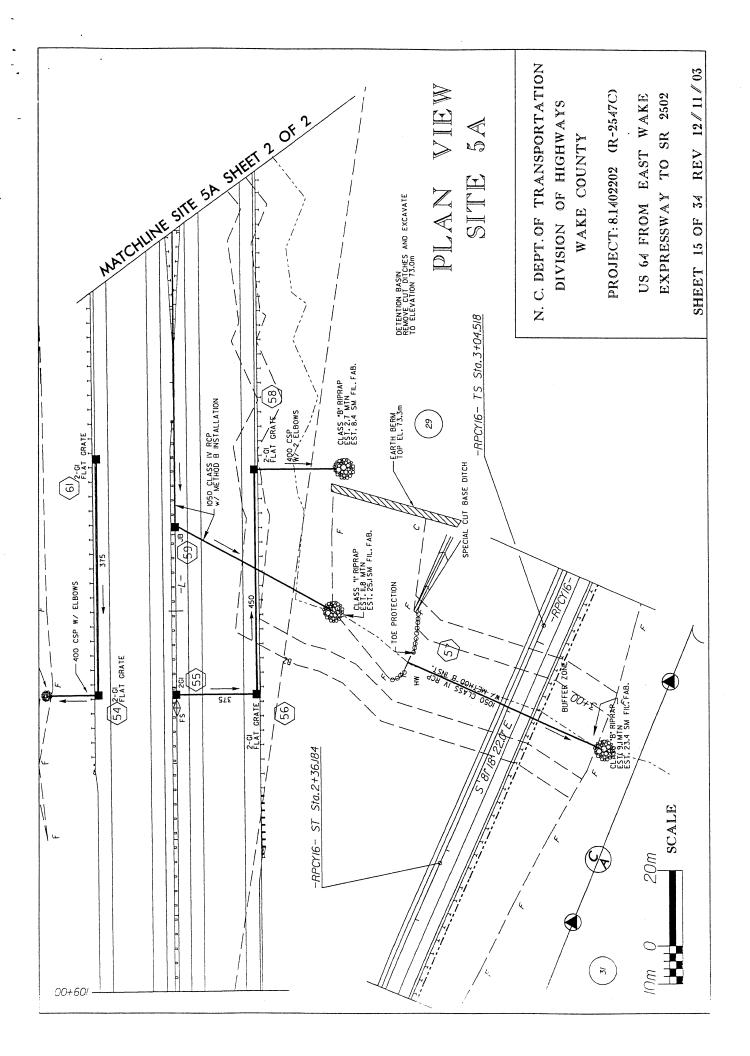

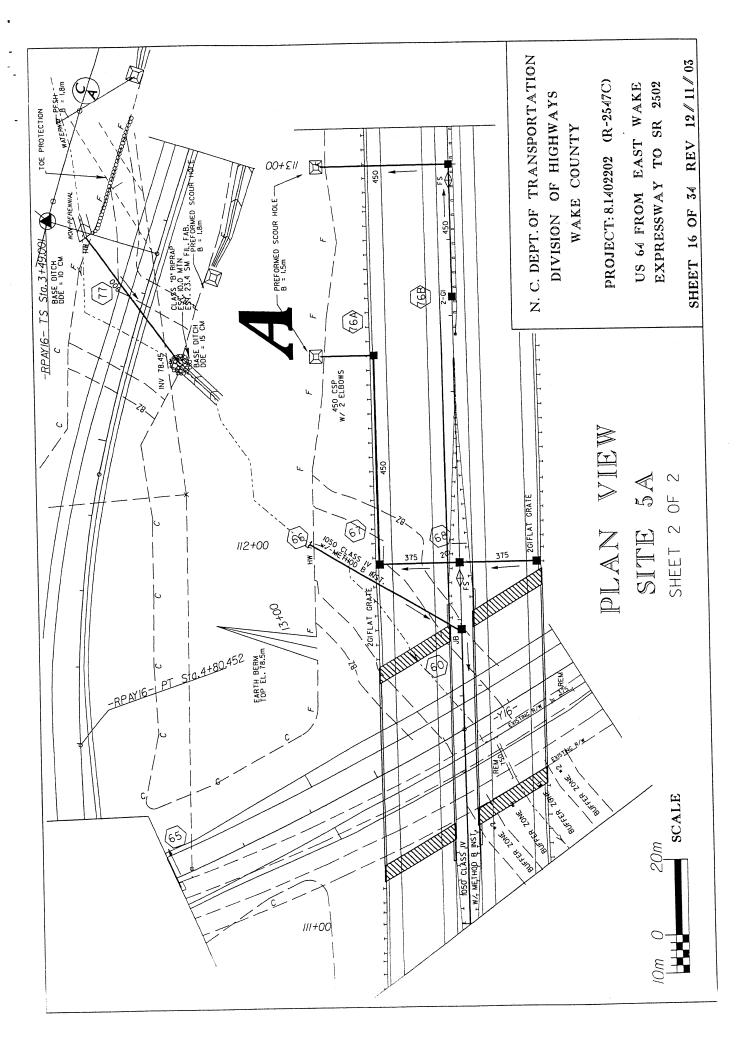


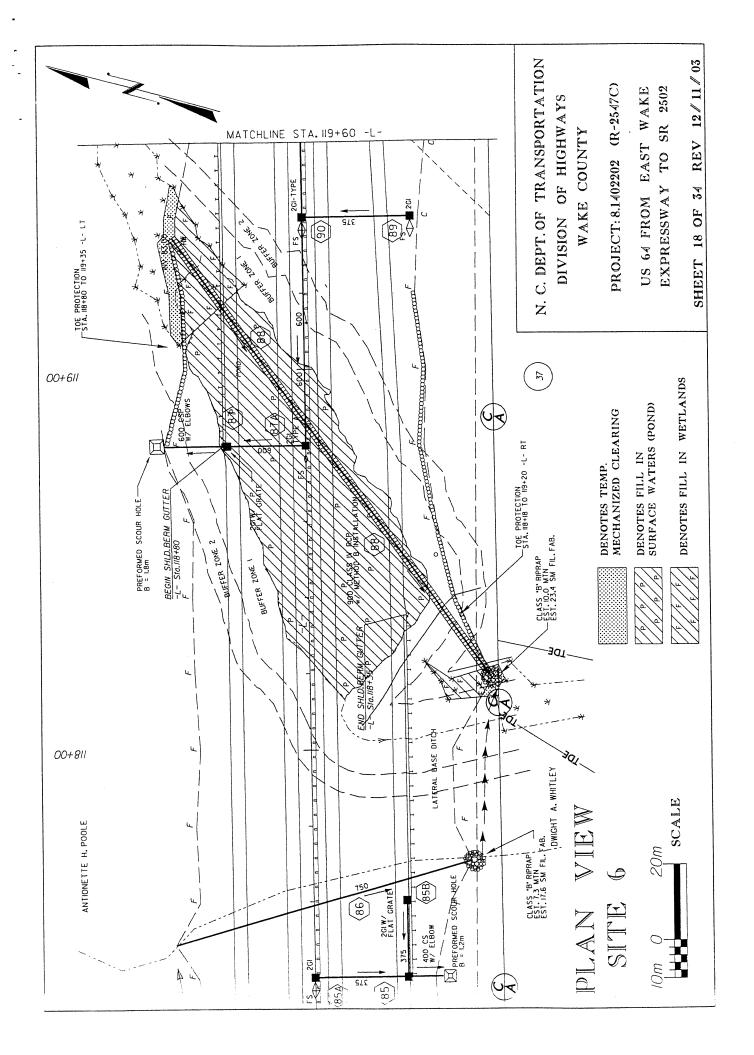

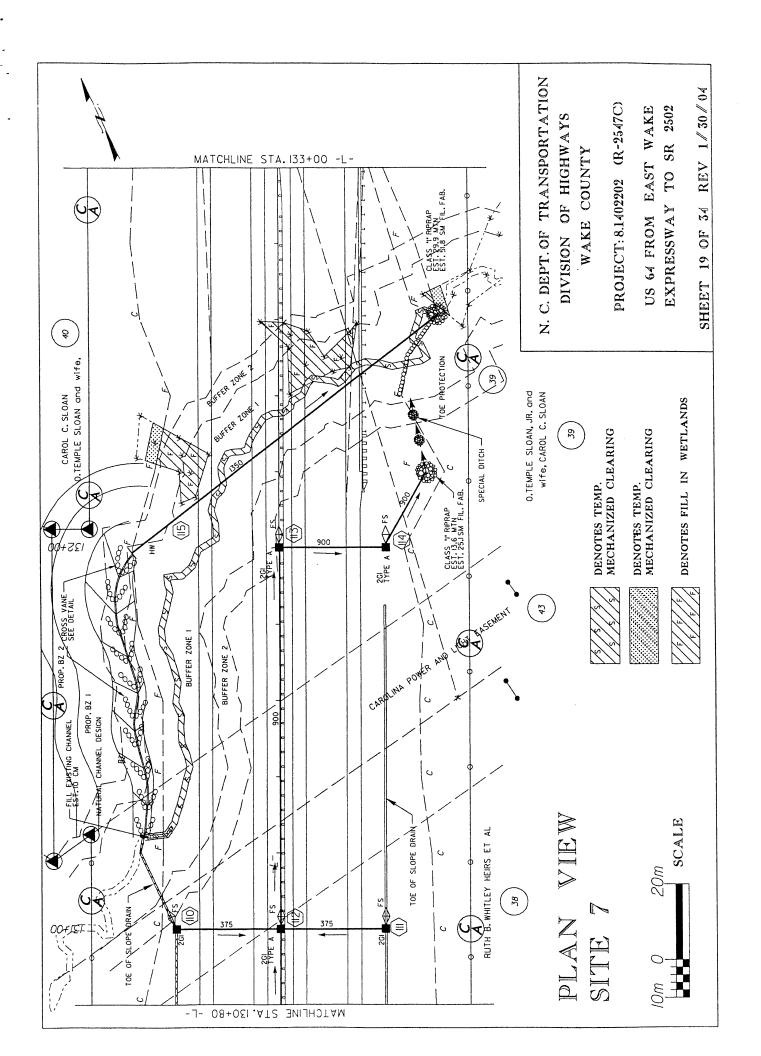


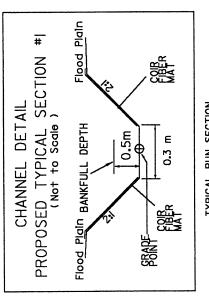

TYPICAL RUN SECTION

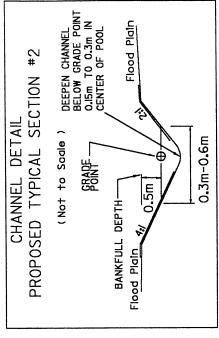

TYPICAL POOL SECTION

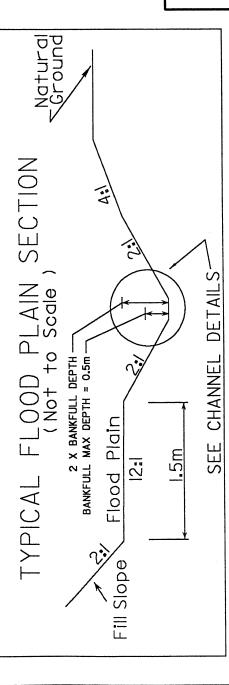


NATURAL CHANNEL DESIGN TYPICALS STATION 131+60 -L- LT. SITE 7

N. C. DEPT. OF TRANSPORTATION DIVISION OF HIGHWAYS WAKE COUNTY

PROJECT: 8.1402202 (R-2547C)

US 64 FROM EAST WAKE EXPRESSWAY TO SR 2502 SHEET 20 OF 34 REVISED 1/ 30/04

CROSS VANE ROCK WEIR DETAIL

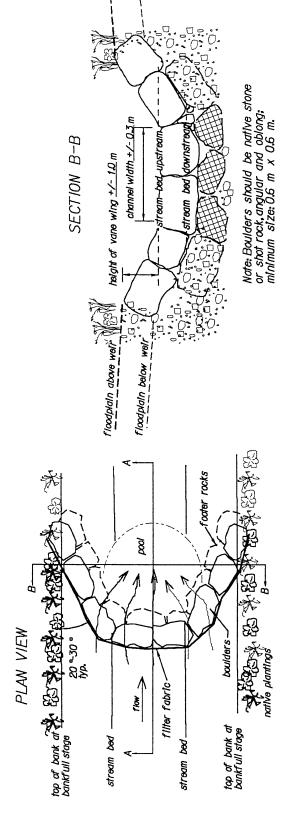

Rocks should fit tightly.

Trim filter fabric flush with ground.
When drop between upstream floodpiain and
downstream flood plain exceeds 0.3m,a boulder
sill is recommended in the floodplain. Note:

N. C. DEPT. OF TRANSPORTATION DIVISION OF HIGHWAYS WAKE COUNTY

channel drop 0.3_m(max.)

> boulders

chainel O color sub-pavement o

pool depth 0.15-0.3 m

foater rocks

p. 9.0.

filler fabric

native plantings

SECTION A-A

rrojected top of vane wing

(range 4 °20 °)


flow

channel bed

PROJECT: 8.1402202 (R-2547C)

US 64 FROM EAST WAKE EXPRESSWAY TO SR 2502 SHEET 26 A OF 34 REVISED 1/30/04

TYPICAL STEP - POOL PROFILE (NOT TO SCALE)

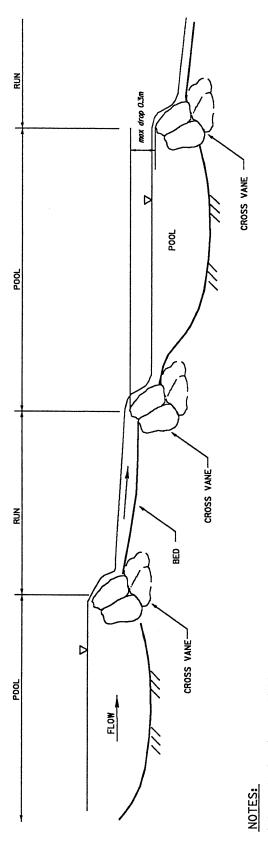

I. POOL AND RUN LENGTHS ARE DEPENDENT ON A MAXIMUM DROP OF 0.3m AT CROSS VANES.

2. CHANNEL BED TO PLACED ON BEDROCK TO THE EXTENT POSSIBLE.

N. C. DEPT. OF TRANSPORTATION DIVISION OF HIGHWAYS WAKE COUNTY

PROJECT: 8.1402202 (R-2547C)


US 64 FROM EAST WAKE EXPRESSWAY TO SR 2502

NATURAL CHANNEL DESIGN TYPICALS STATION 131+60 -L- LT.

SITE 7

SHEET 20 B OF 34 REVISED 1/30/04

TYPICAL STEP - POOL PLAN VIEW

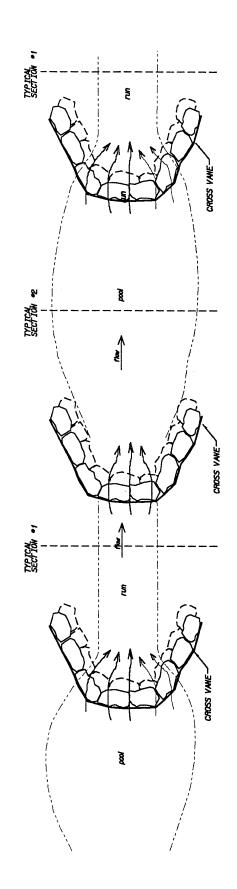

N. C. DEPT. OF TRANSPORTATION DIVISION OF HIGHWAYS
WAKE COUNTY

PROJECT: 8.1402202 GR-2547C)

PROJECT: 8.1402202 UR-2547C)
US 64 FROM EAST WAKE
EXPRESSWAY TO SR 2502

SHEET 20 COF 34 REVISED 1/30/04

NATURAL CHANNEL DESIGN TYPICALS STATION 131+60 -L- LT.


SITE 7


Morphological Measurement Table for R-2547C


Stream @ 131+60 -L- Lt.


| Variables | Existing Channel | Proposed Reach | USGS Station | Reference Reach (NCSRI Reg. Curves) |
|---|---------------------|-------------------|--------------|-------------------------------------|
| Stream type(Rosgen Classification) | B5a | A5/B5a | na | B B |
| 2. Dreinoge eree (IIA) | 31.6 | Step-Pool 31.6 | | 31.6 |
| 2. Drainage area (HA) | 31.0 | 31.0 | na | 31.0 |
| 3. Bankfull width (m) | 2.3 | 2.3 | na | 2.2 |
| 4. Bankfull mean depth (m) | 0.36 | 0.32 | na | 0.28 |
| 5. Width/depth ratio | 6.4 | 7.5 | na | 7.9 |
| 6. Bankfull cross-sectional area (m^3) | 0.42 | 0.65 | na | 0.26-1.30 |
| 7. Bankfull mean velocity (m/s) | 1.41 | 1.37 | na | 0.81-1.70 |
| 8. Bankfull discharge, cms | 0.57 | 0.57 | na | 0.21-2.2 |
| 9. Bankfull max depth (riffle) | 0.5 | 0.5 | na | 0.48 |
| 10. Width of floodprone area (m) | 4.2 | 4.3 | na | na |
| 11. Entrenchment ratio | 1.8 | 1.8 | na | na |
| 12. Meander length (m) | 11 | 10 | na | 14 |
| 13. Ratio of meander length to bankfull width | 4.8 | 4.2 | na | 6.3 |
| 14. Radius of curvature (m) | 7 | 12 | na | 5 |
| 15. Ratio of radius of curvature to bankfull width | 3 | 5 | na | 2.3 |
| 16. Belt width (m) | 1 | 1 | na | 1.5 |
| 17. Meander width ratio | 0.43 | 0.43 | na | 0.68 |
| 18. Sinuosity (stream length/valley length) | 1.07 | 1.0-1.08 | na | na |
| 19. Valley slope (m/m) | 0.025-0.04 | 0.025-0.040 | na | na |
| 20. Average slope valley slope/sinuosity | 0.023-0.04 | 0.023-0.04 | na | na |
| 21. Pool slope (m/m) | 0.005 | 0.005 | na | na |
| 22. Ratio of pool slope to average slope | 0.2 | 0.2 | na | na |
| 23. Maximum pool depth (m) | 0.66 | 0.6 or bedrock | na | 0.57 |
| 24. Ratio of pool depth to average bankfull depth | 1.83 | 1.88 | na | 2.03 |
| 25. Pool width(m) | 0.1-1.3 | 0.3-0.6 | na | na |
| 26. Ratio of pool width to bankfull width | 0.04-0.13 | 0.13-0.26 | na | na |
| 27. Pool to pool spacing (m) | 1.1-4.5 | 1.0-3.0 | na | 6.5 |
| 28. Ratio of pool to pool spacing to bankfull width | 0.48-1.96 | 0.43-1.3 | na | 2.95 |


SHEET 21 OF 34 REV 1/30/04

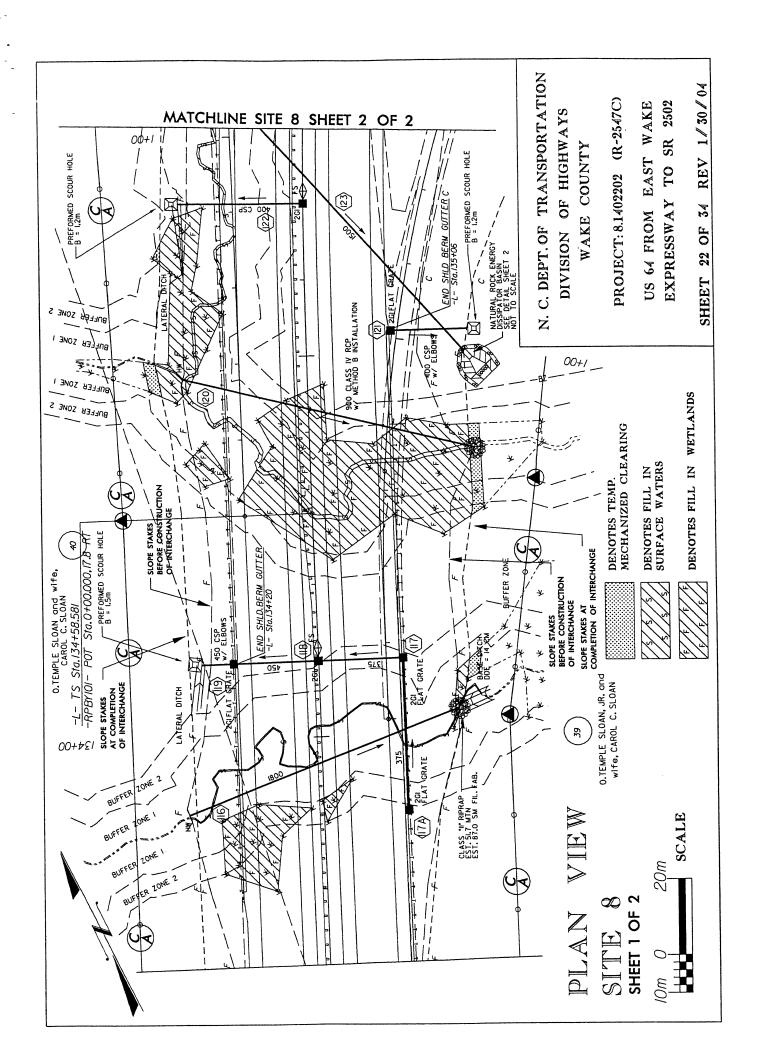


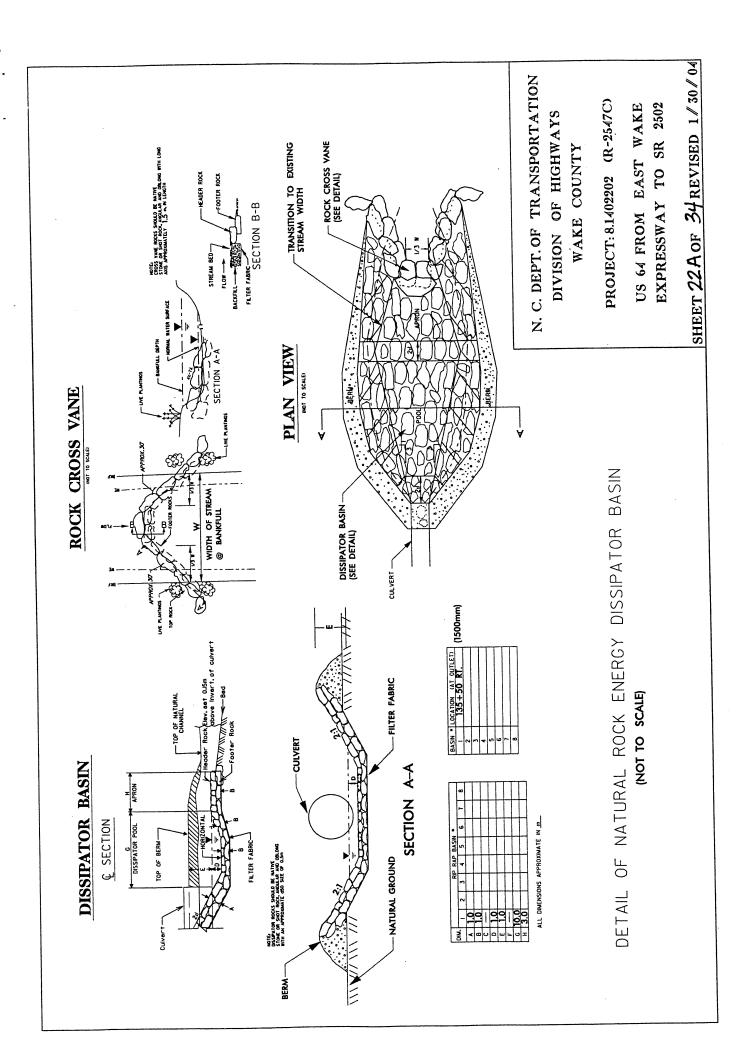


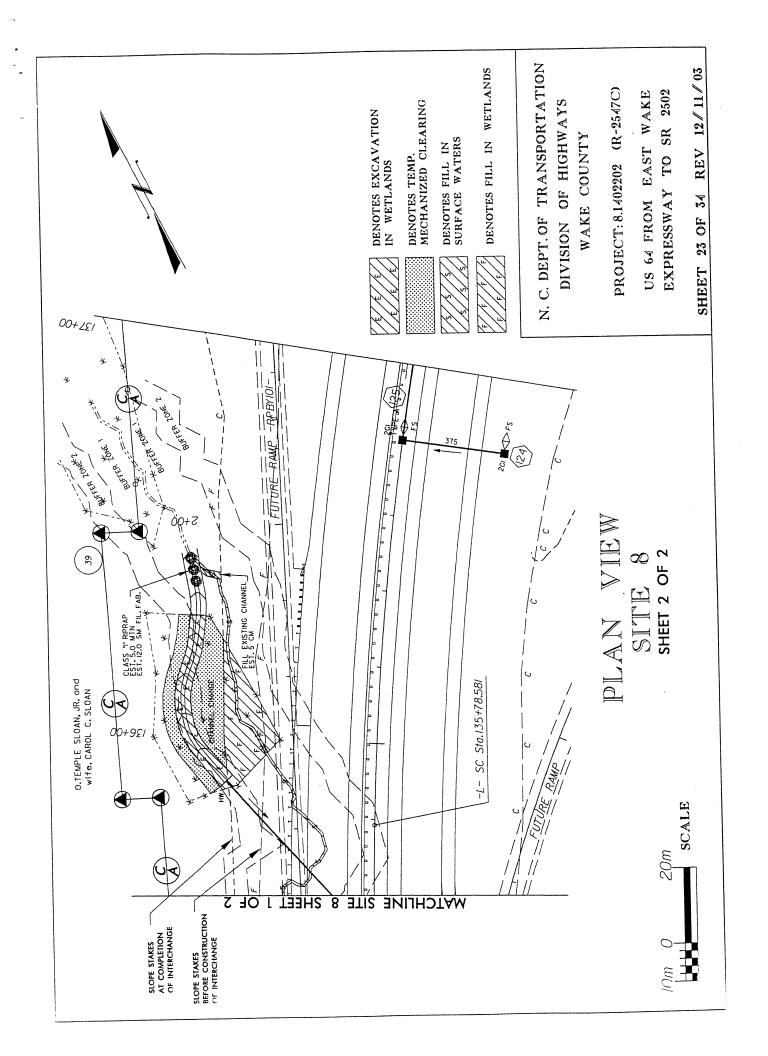


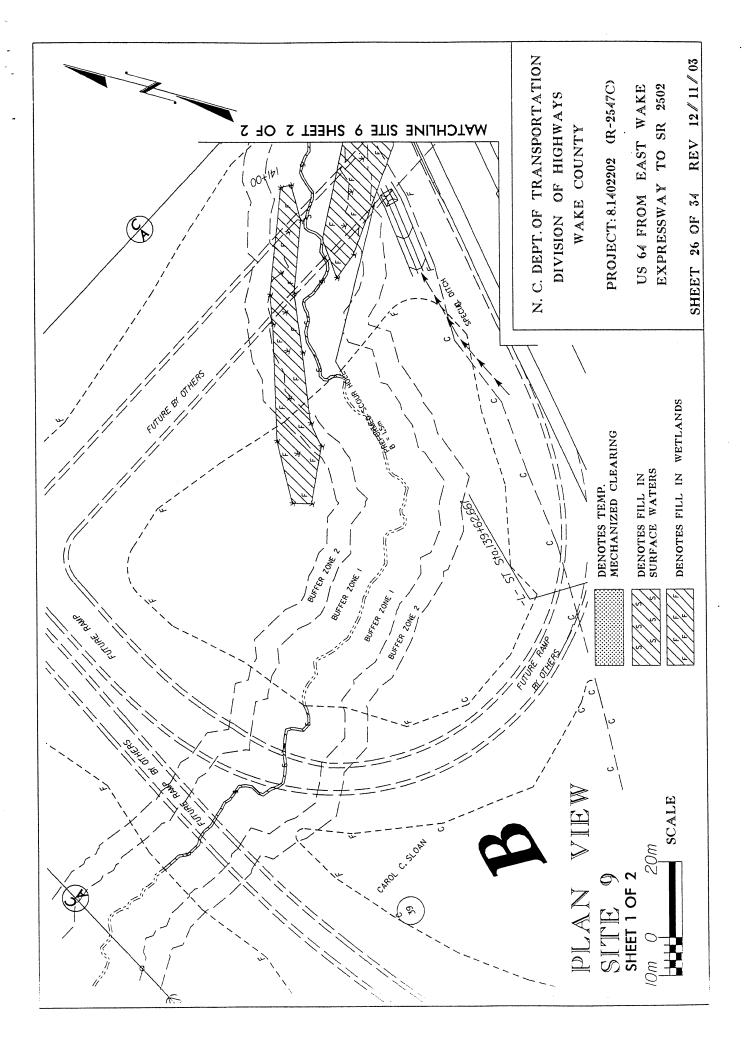

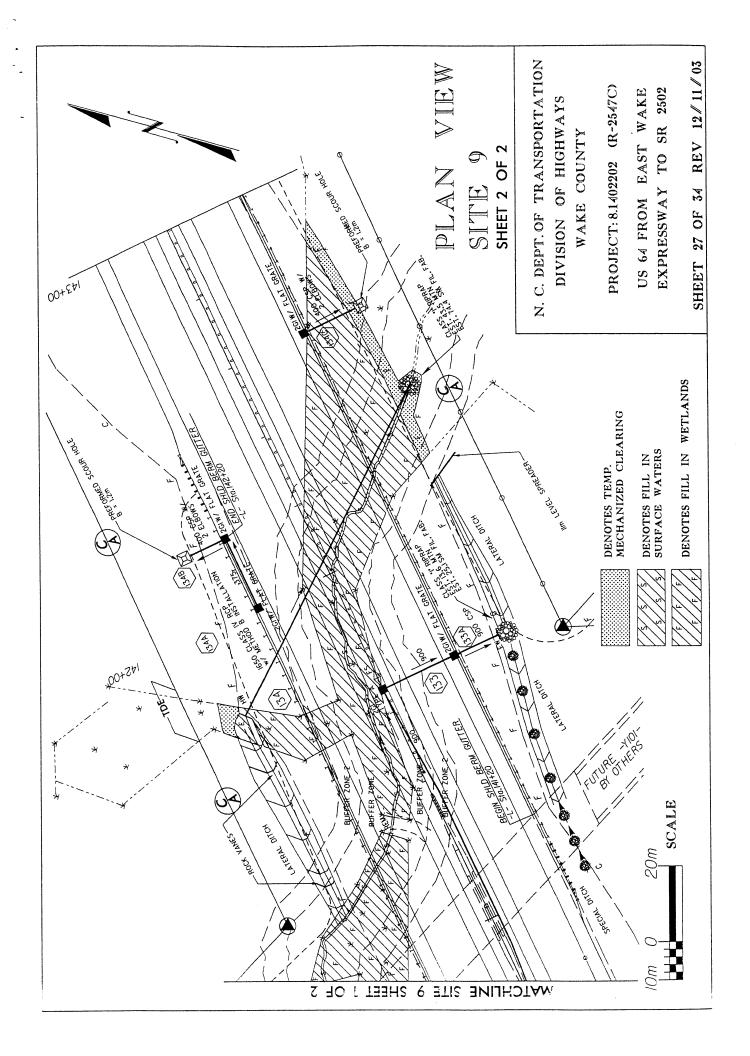


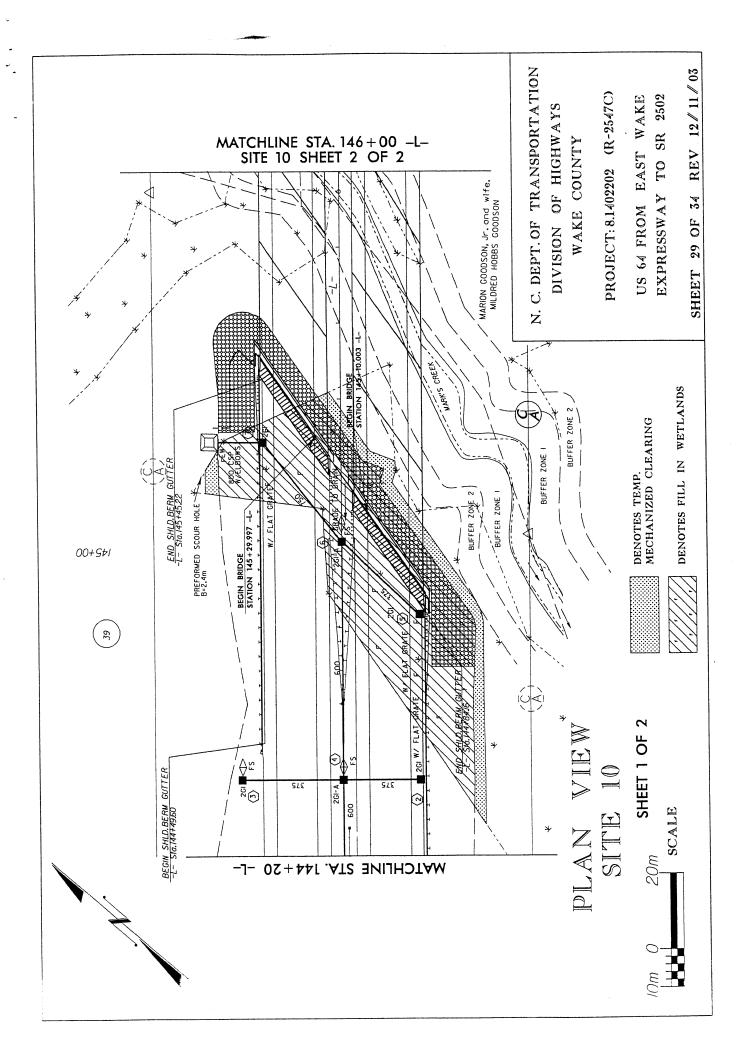


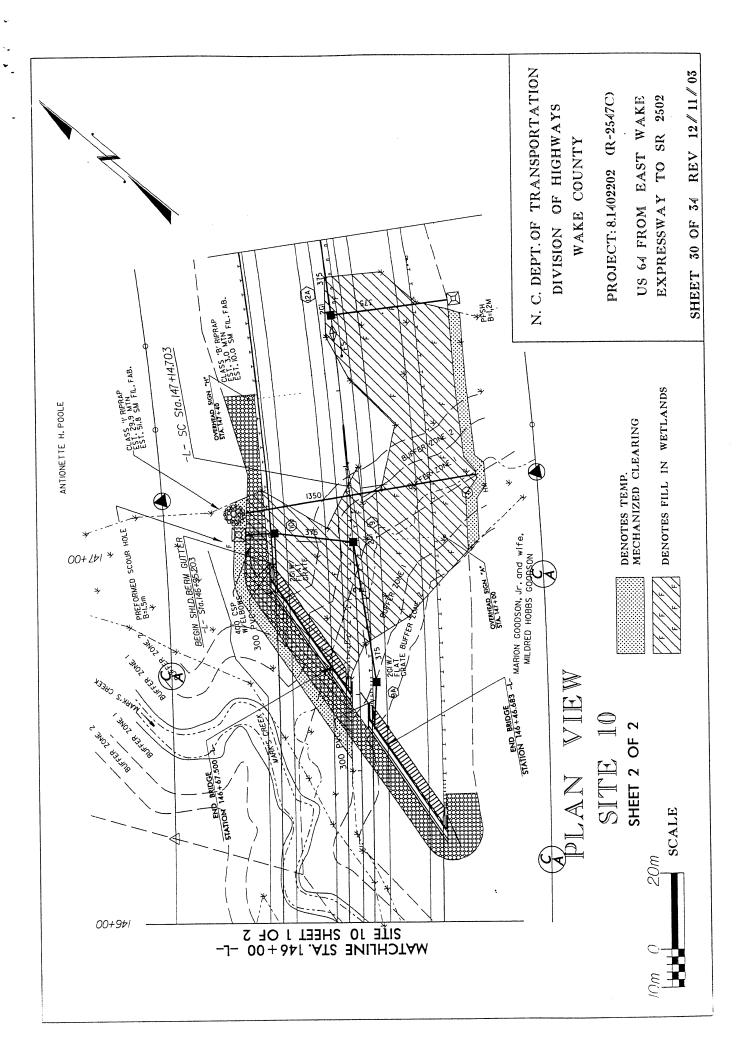


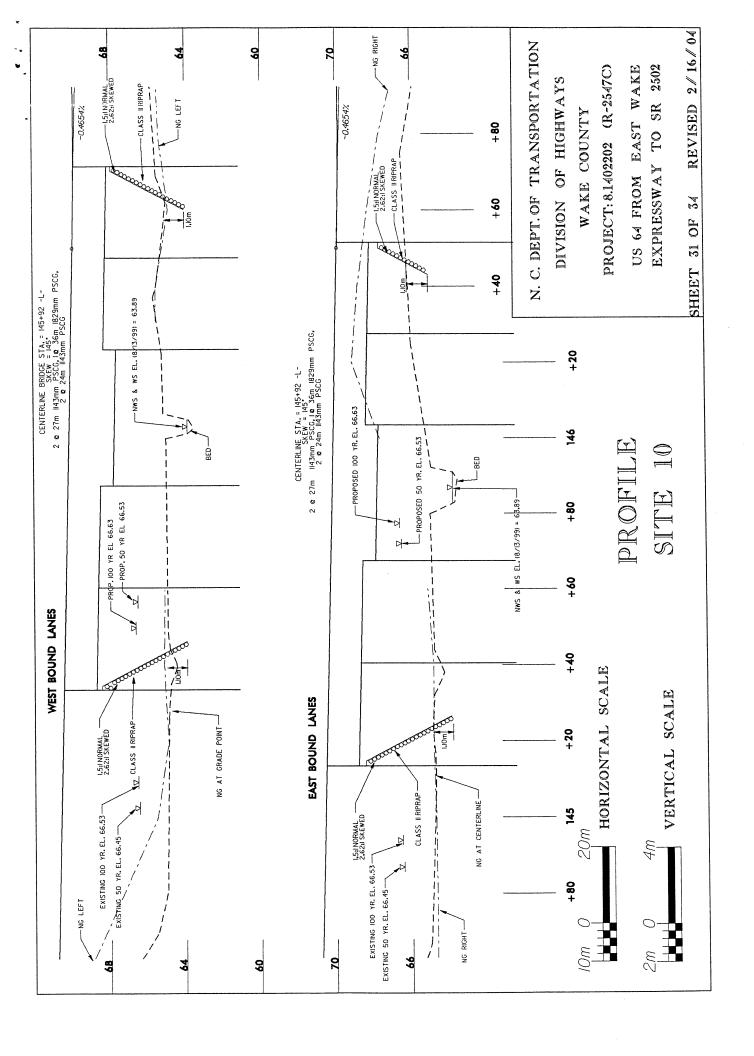


| | | | | | IMPACT | SUMMARY | КY | | | 0.00 | | | PITERED IMPACTS | ADACTS |
|-------------|---------------------------|---------------------------------------|-----------|--------|----------------|--|-------------------------|-----------------------|-----------------------------|--|-----------------------------|----------------------------|-------------------|-------------------|
| | | | | WETL | ETLAND IMPACTS | ည | | SURFACE WATER IMPACIS | VATER IMP | SIS | | | מונים | 212418 |
| Site No. | | Structure Size | _ & | ≣ Spu | ion | Mechanized Clearing (Method III) | Fill In SW (Natural) | Fill In SW (Pond) | Temp. Fill In SW (ha) | Existing Channel Impacted (m) | Relocated Channel (m) | Enclosed Channel (m) | Zone 1 (ha) | Zone 2 (ha) |
| | | 000035 | (na) | (na) | (ila) | (IIIa) | (IIIa) | 0.44 | | | | | | |
| | 1 89+08/89+63 -u / 50 RCF | 1/30 RCF | | | | | | 0.217 | | | | | | |
| | 2 95+95/96+62 -UNA | I N/A | | | | | | 0.012 | | | | | 0.0275 | 0.054 |
| | 3 98+20/98+50 -L N/A | I N/A | 20, 0 | 1000 | | 0,00 | | 1 2.2 | | | | | 0.0698 | 0.0672 |
| | 4 103/104+80-L- | 4 103/104+80-L- 3 @ 26m BRIDGE | 0.427 | 0.0121 | | 0.048 | 0000 | | | 13 | | 13 | 0.022 | 0.014 |
| | 5 10+30 -Y16- | 1800 RCP | | | | | 0.002 | | | 2 | | | 0.471 | 0 292 |
| 4,7 | 5A 110/113 -L- | 1050 RCP | | | | | | 1,00 | | | | | 308 | 0 148 |
| | 6 118/119+60 -L- | - 900 RCP | 0.040 | | | 0.015 | | 0.315 | | 200 | 0 | 00 | 786.0 | 0.03 |
| L | 7 131/133 -L- | 1350 RCP | 0.033 | | | 0.003 | | | | 502 | 1 00 | | 100.00 | 0.005 |
| | 8A 134+00 -L- | 1800 RCP | 0.038 | | | 0.003 | | | | 13/ | , , | | 0.201 | 0.093 |
| | | | 0.225 | | 0.019 | | | | | 316 | 9 | | 0.52 | 0.201 |
| | 9 140/143 -1 - | 1650 RCP | 0.456 | | 0.003 | | 0.019 | | | 310 | 56 | 234 | 0.575 | 0.368 |
| | 0 144/147±80 1 | 2@27m 1@36 2@23 5m | | 0 274 | | | | | | | | | 0.291 | 0.254 |
| | 4 47/48±40 V404 | 14 17/19+40 V1041 @ 24m 2 @ 17m BBING | | | | 0.059 | | | | | | | 0.022 | 0.039 |
| | 011-04-01// | 1 (0 2+111, 2 (0 1111) DIVID | | | | | | | | | | | | |
| | | | | | | | | | | | | | | |
| | | | | | | | | | | | | | | |
| | | | 0000 | 0.0864 | 0000 | 0000 | 0.081 | 0.984 | О | 626 | 219 | | 2.8943 | 1.842 |
| TOTALS | LS: | nectare/meter | 2.002 | 0.2001 | | l | | | 000 | 3212 | 719 | ľ | 7.15 | 4.55 |
| | | acre/feet | 5.14 4 | 0.7.0 | | | | i | N.C. DEPT. | N.C. DEPT. OF TRANSPORTATION | ORTATION | | | |
| | | | | | | | | | S S | | | | | |
| | | | | | | | | | | | WAKE COUNTY | NTY | | |
| | | | | | | | | | | | | | | |
| | | | | | | | - | | PROJECT | PROJECT: 8.1402202 (R-2547C) | (R-2547C) | | | |
| | | | | | | | | SHEET 34 | 4 OF 34 | | | | REV. 2/9/2004 | 4 |
| | | | | | | | | | | | | | | |
| | | | | | | | | | | | | | | |
| | | | | | | | | | | | | | | |
| | | | | | | | | | | | | | | |

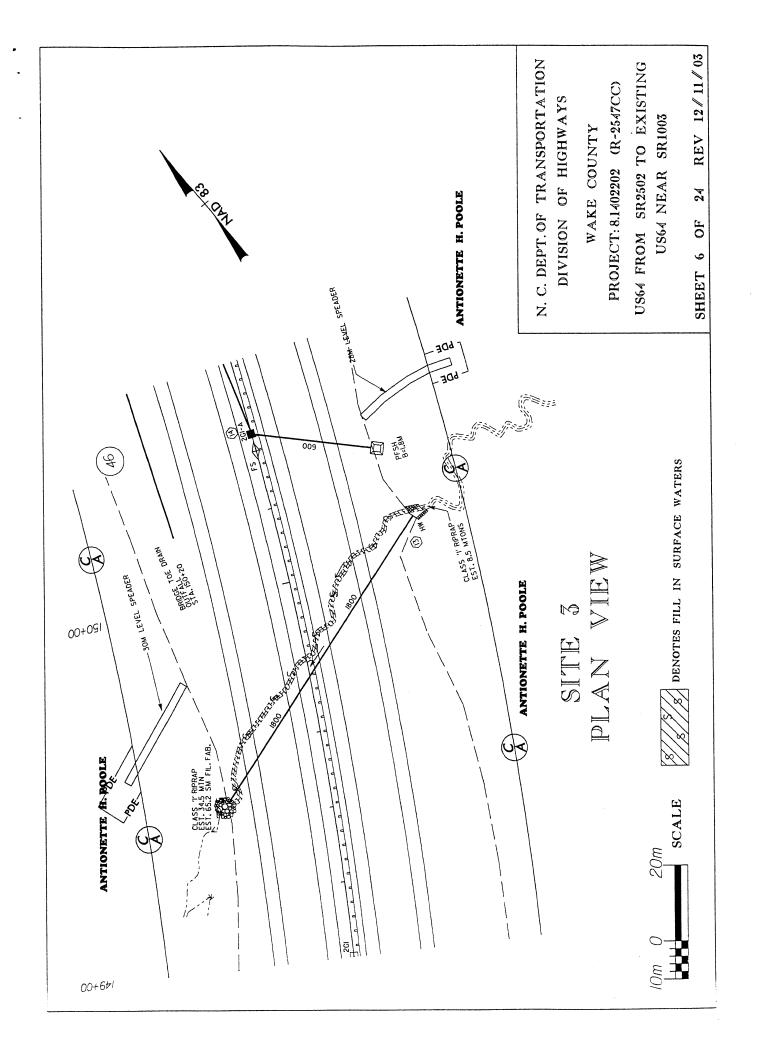

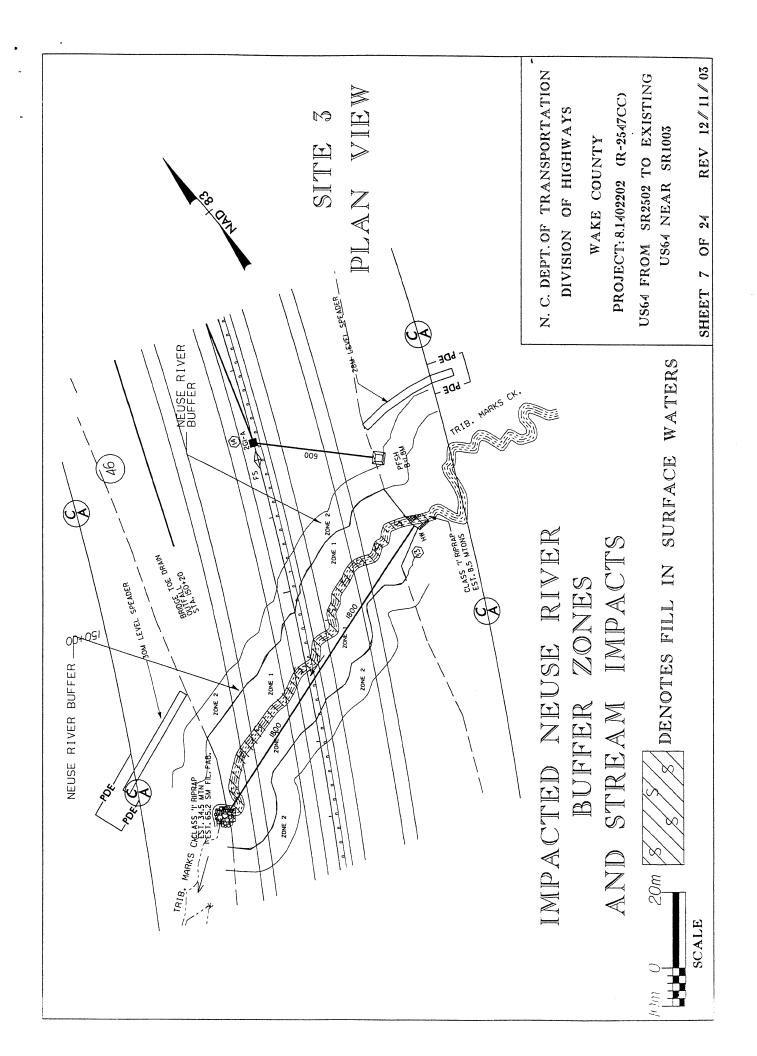

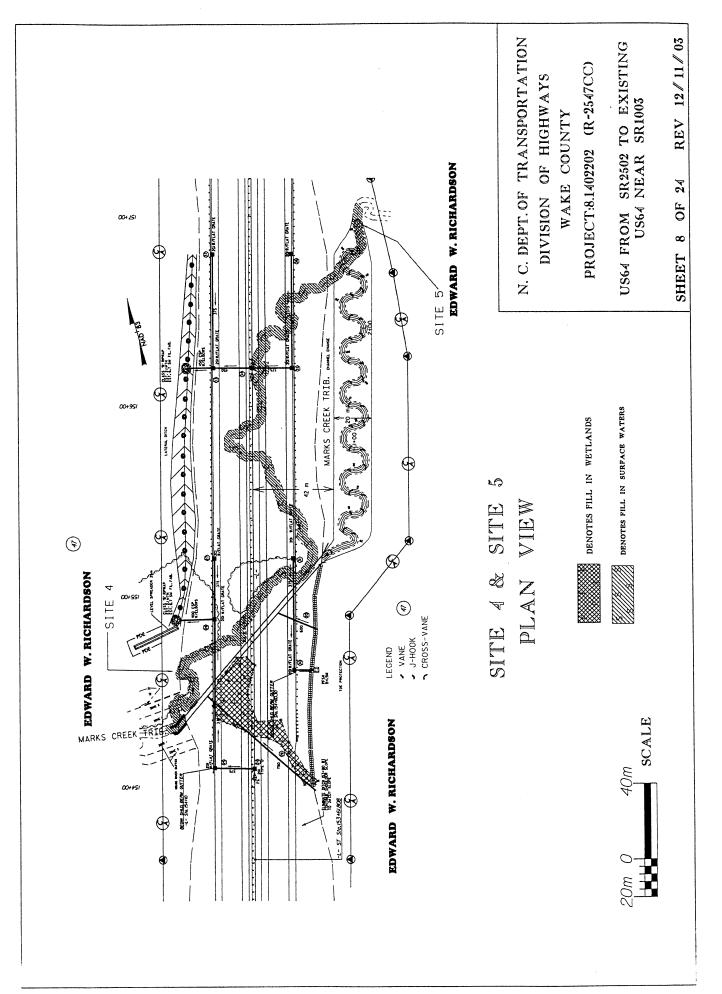

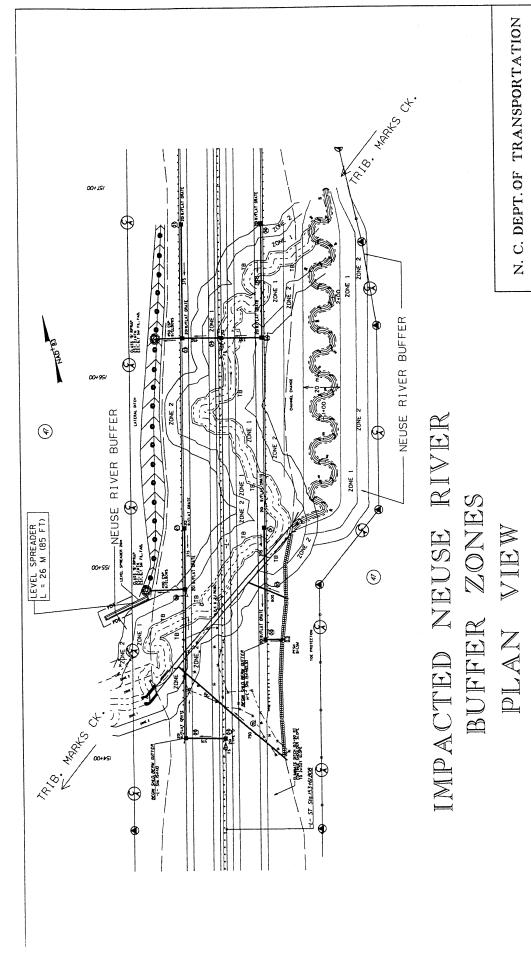



N. C. DEPT.OF TRANSPORTATION
DIVISION OF HIGHWAYS
WAKE COUNTY
PROJECT:8.1402202 (R-2547CC)


SITE


US64 FROM SR2502 TO EXISTING US64 NEAR SR1003 SHEET 9 OF 24 REV 12/11//03




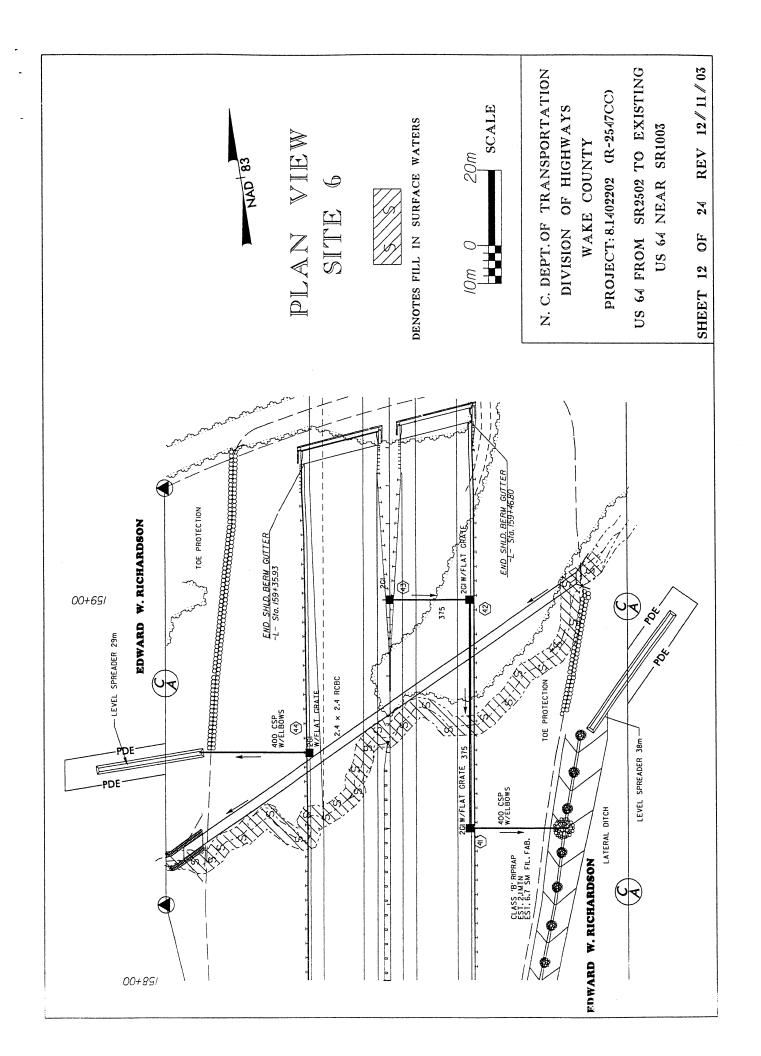

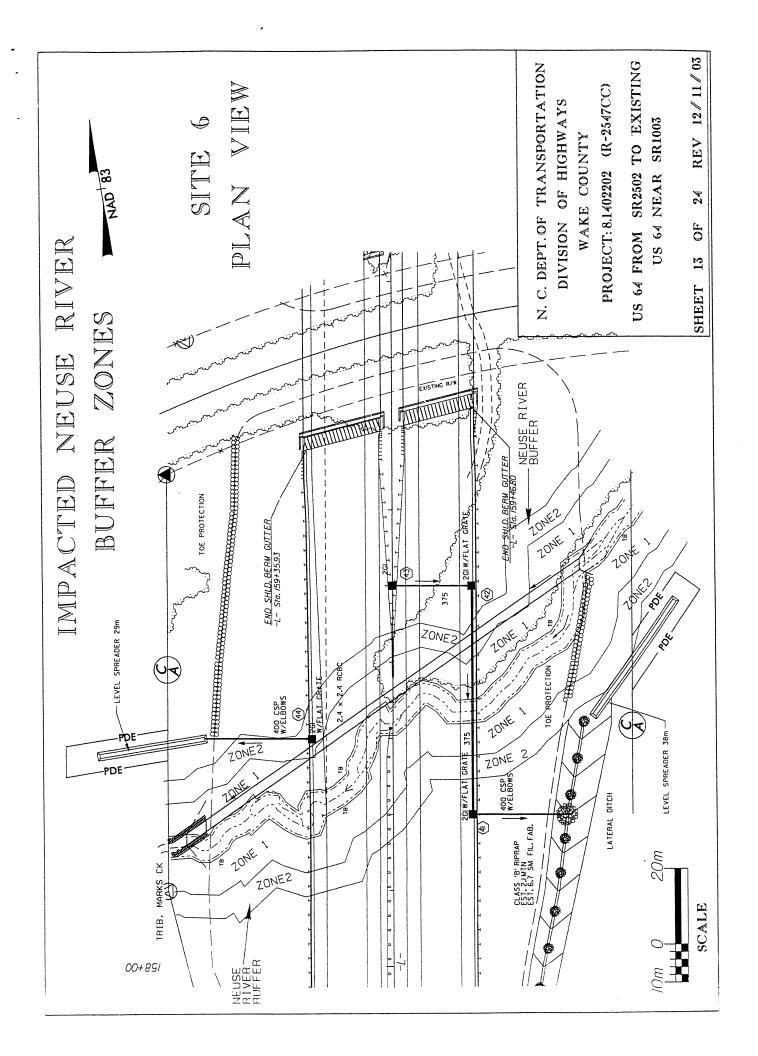

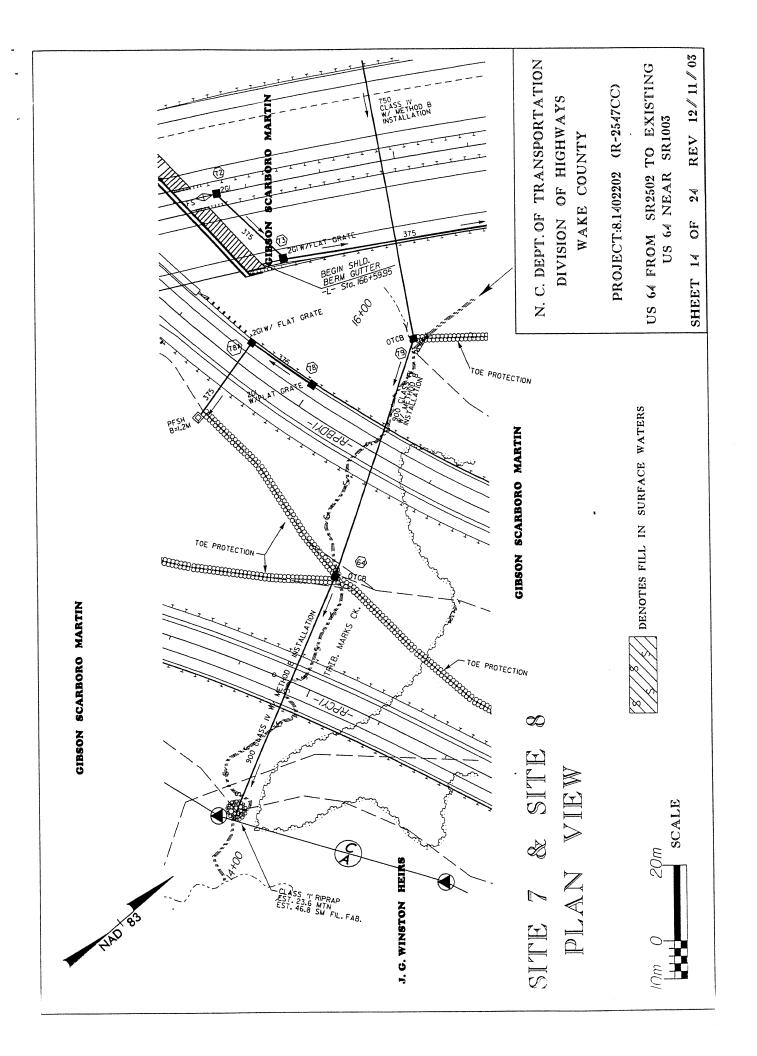

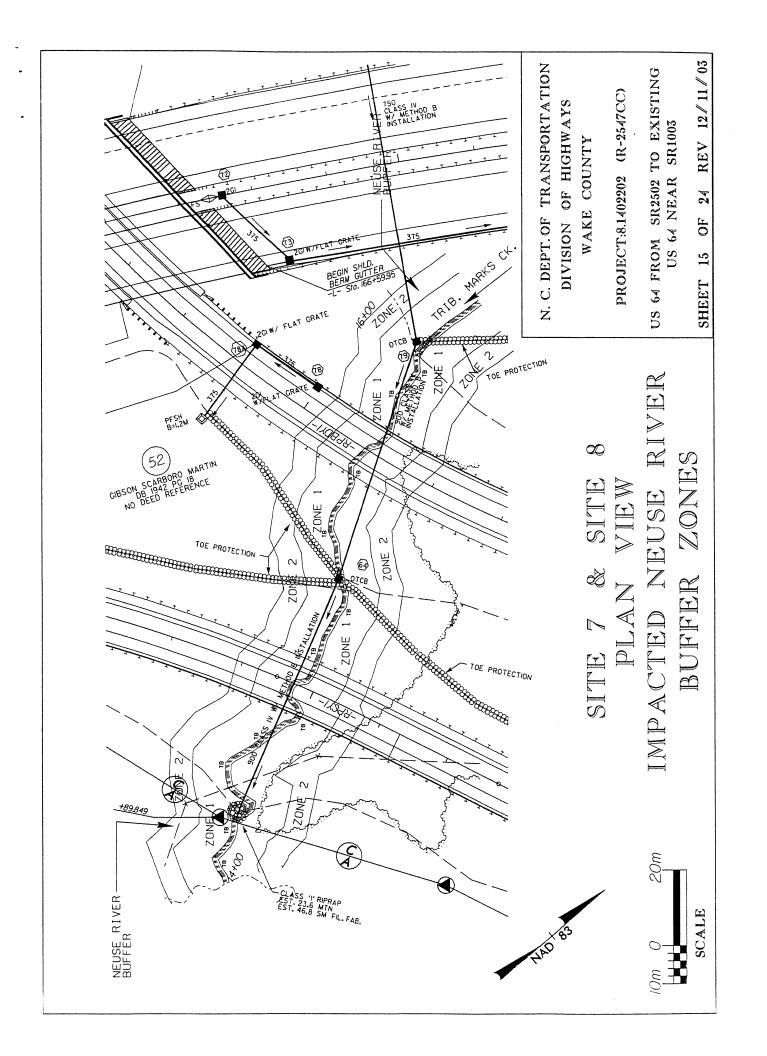

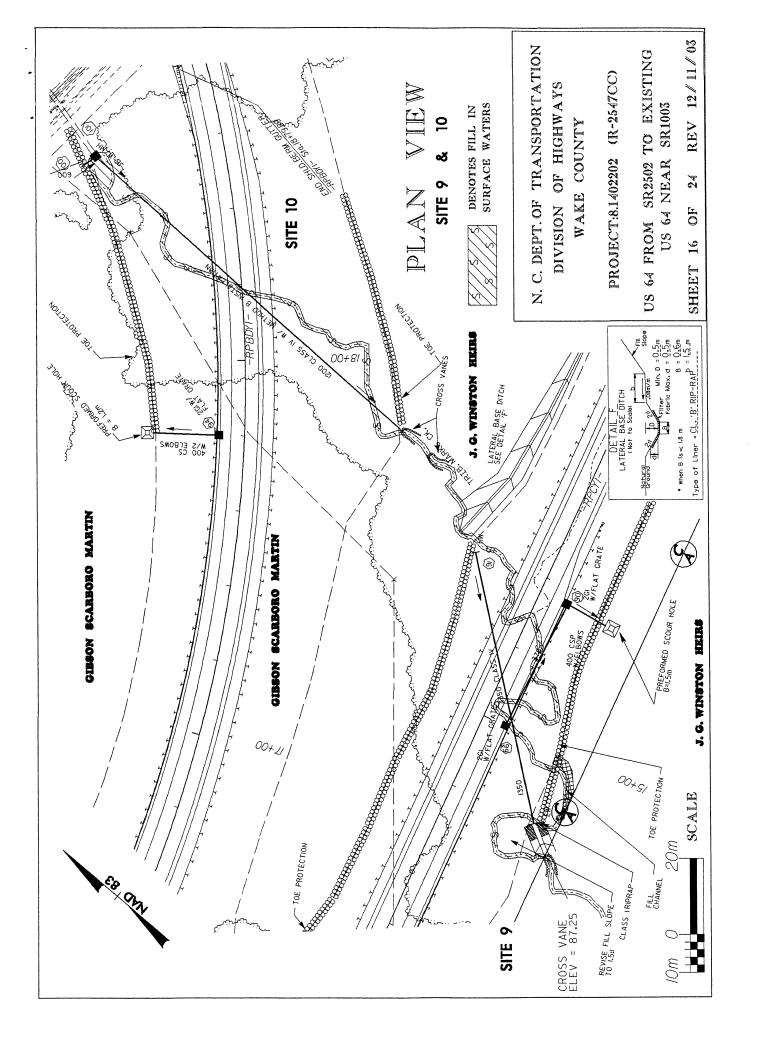


CROSS VANE ROCK WEIR DETAIL

SITE 9 & ooter rocks *1*000 100米四米80米 top of bank of the EST REST. PLAN VIEW 20°-30° typ. boulders filter fabric flow top of bank at bankfull stage stream bed stream bea

SECTION B-B

SITE 10

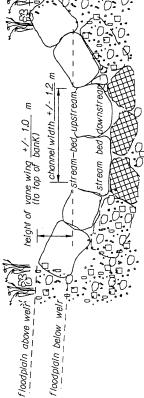

Note: Boulders should be native stone or shot rock, angular and oblong: minimum size: 0.9 m x 0.6 m.

Note:

downstream flood plain exceeds 0.3m.a boulder sill is recommended in the floodplain. When drop between upstream floodplain and Trim filter fabric flush with ground. Rocks should fit tightly.

N. C. DEPT. OF TRANSPORTATION DIVISION OF HIGHWAYS WAKE COUNTY

channel drop 0.3 m (max.)

(range 4°-10°)

flow

SECTION A-A

pool depth 0.3 m

boulders


channel bed channel bed sub-povement of sub-po


pool length +/- 5.0 m

filter fabric


PROJECT:8.1402202 (R-2547CC)

US 64 FROM SR2502 TO EXISTING US 64 NEAR SR1003 REV 12// 11// 03 24 SHEET 16A OF

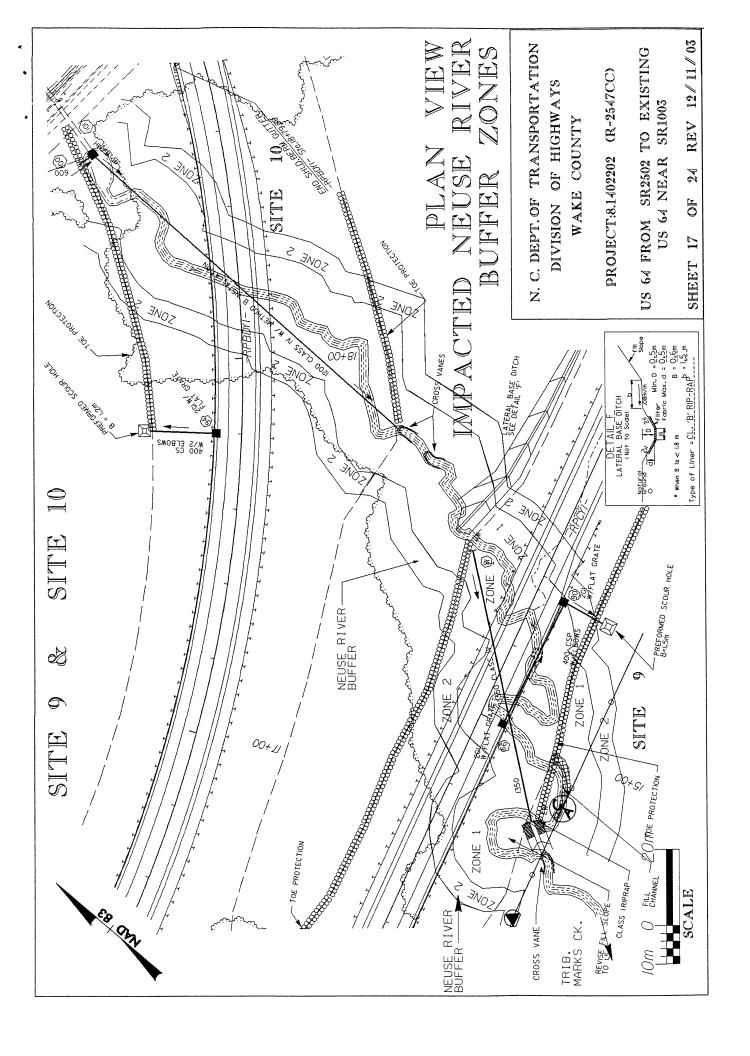

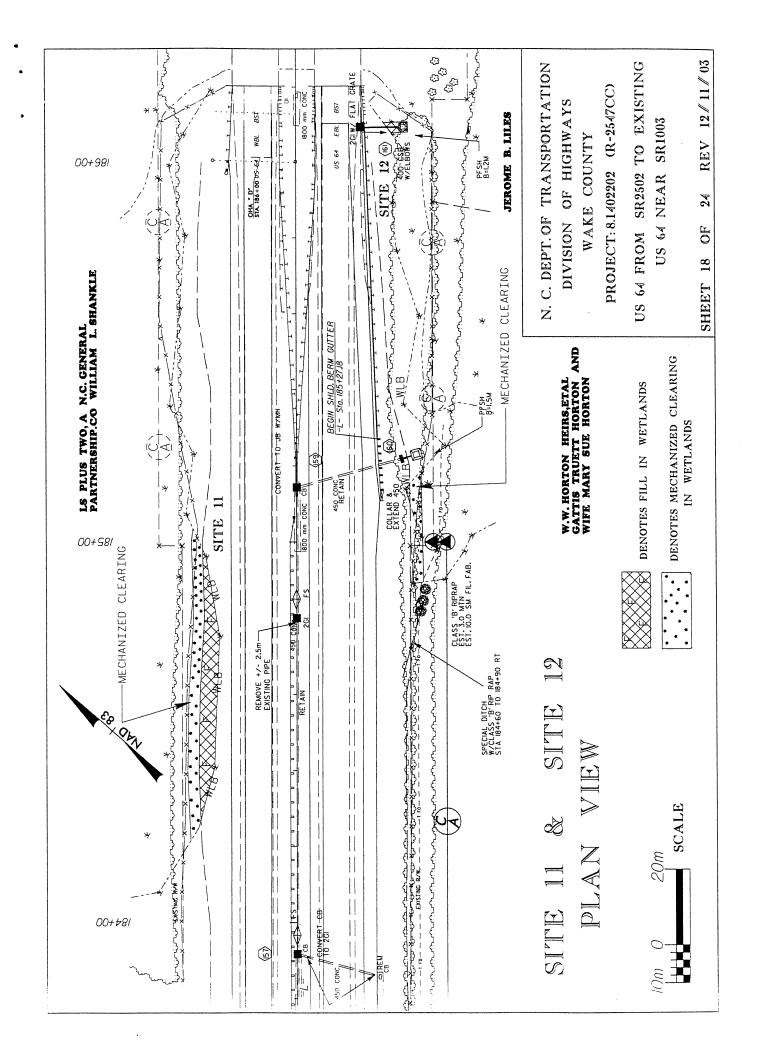

WAKE COUNTY BOARD OF EDUCATION

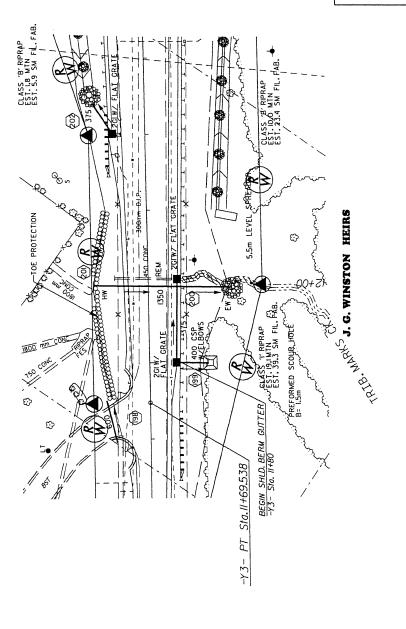



PLAN VIEW SITE 13

N. C. DEPT.OF TRANSPORTATION
DIVISION OF HIGHWAYS
WAKE COUNTY
PROJECT: 8.1402202 (R-2547CC)
US64 FROM SR2502 TO EXISTING
US64 NEAR SR1003

SHEET 19 OF 24 REV 12 // 11 // 05


DENOTES FILL IN SURFACE WATER

IMPACTED NEUSE RIVER BUFFER ZONES

WAKE COUNTY BOARD OF EDUCATION

PLAN VIEW


SITE 13

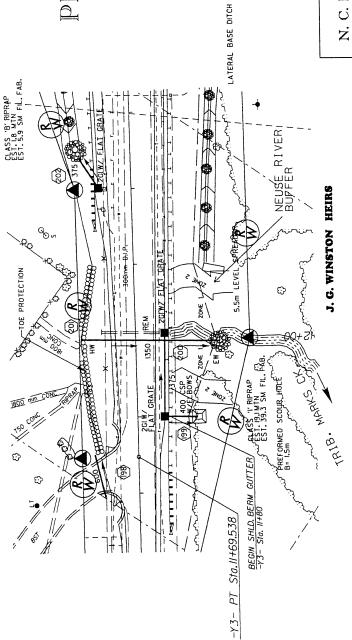


N. C. DEPT. OF TRANSPORTATION
DIVISION OF HIGHWAYS
WAKE COUNTY
PROJECT: 8.1402202 (R-2547CC)
US64 FROM SR2502 TO EXISTING
US64 NEAR SR1003

SHEET 20 OF 24 REV 12/11/03

om 0 20m

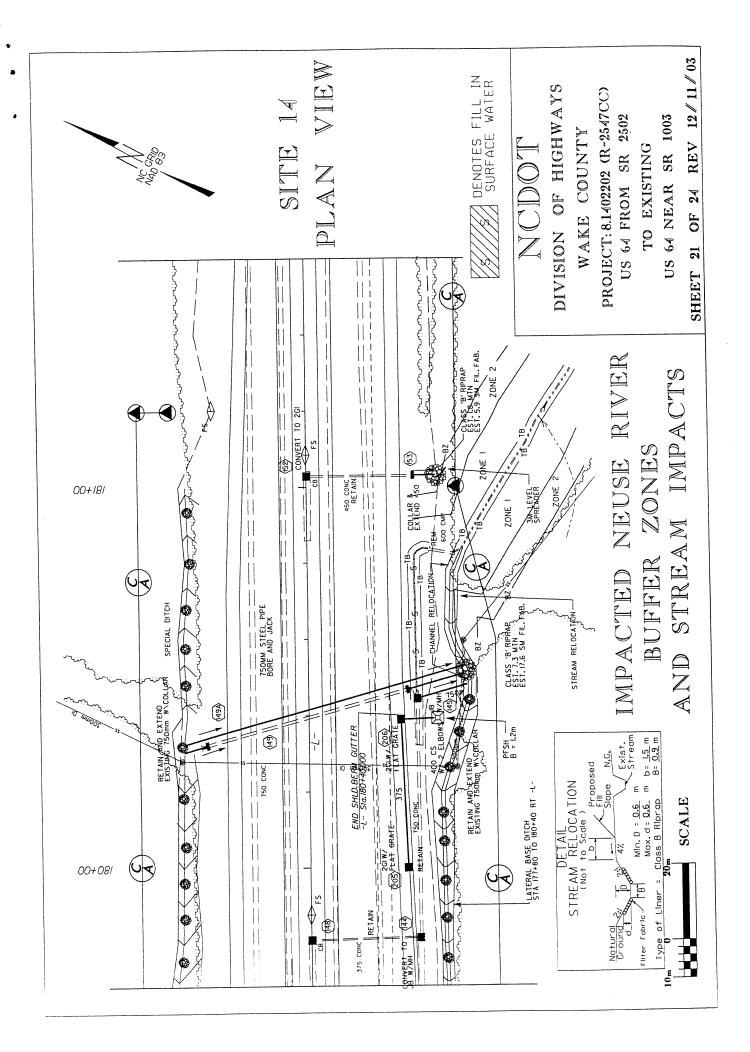

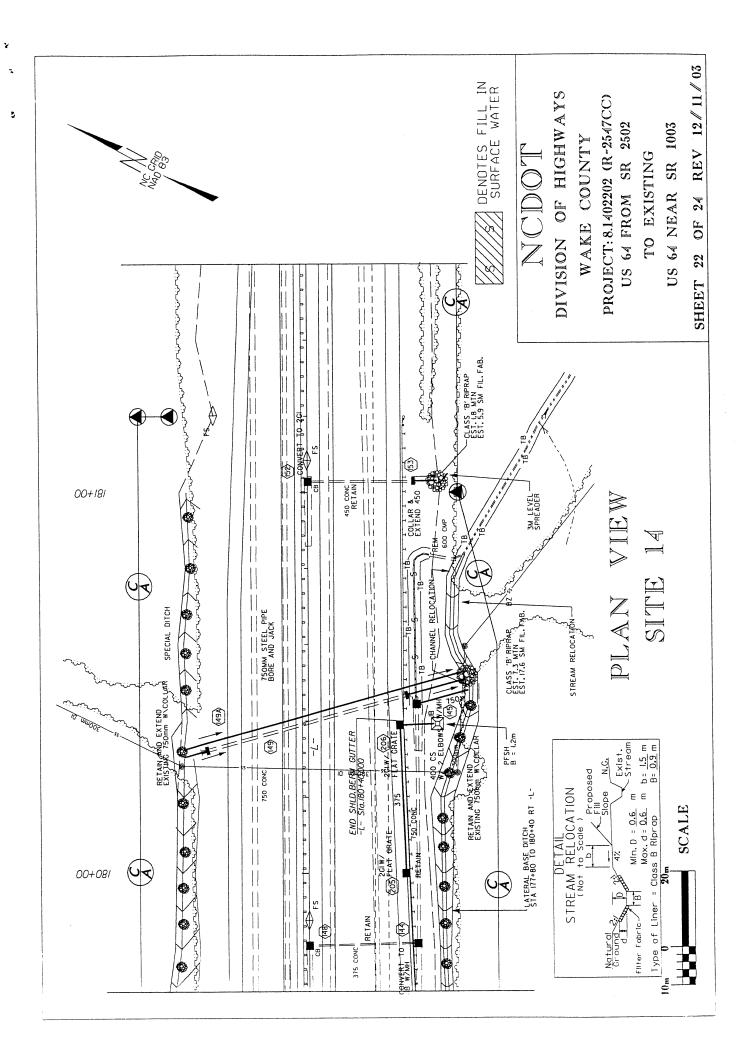

1.251 3.09 0.159 0.145 0.145 0.042 **BUFFER IMPACTS** 0.111 Zone 2 (ha) REV. 12/11/2003 1.826 0.243 0.3 0.24 0.28 0.028 0.159 Zone 1 (ha) 680 Enclosed Channel (m) 126 108 82 85 117 43 WAKE COUNTY PROJECT: 8.1402202 (R-2547CC) 289 948 N.C. DEPT. OF TRANSPORTATION DIVISION OF HIGHWAYS Relocated Channel (m) 240 40 σ Existing Channel Impacted 26 42 144 130 150 88 Ξ SURFACE WATER IMPACTS Temp. Fill In SW (ha) OF 24 SHEET 23 Fill In SW (Pond) (ha) 0.459 Fill In SW (Natural) (ha) 0.016 0.002 0.03 0.03 0.021 0.024 0.13 SUMMAR Clearing (Method III) (ha) 0.029 0.07 Mechanized 0.023 WETLAND IMPACTS Excavation In Wetlands (ha) 0.00 IMPACT Temp. Fill In Wetlands (ha) 0.00 Fill In Wetlands | h 0.29 0.024 1350 RCP 2 @ 750 PIPES Structure Size hectare/meter acre/feet 185+40 -L-12+00 -Y3-180+60 -L-(From/To) Station TOTALS: 4 5 6 7 & 8 9 Site So. 2 2 9 14 ~ က

1

APPENDIX A



STATE OF NORTH CAROLINA DEPARTMENT OF TRANSPORTATION

MICHAEL F. EASLEY
GOVERNOR

LYNDO TIPPETT SECRETARY

November 12, 2003

Ms. Coleen H. Sullins Assistant Director NCDENR/Division of Water Quality 1628 Mail Service Center Raleigh, North Carolina 27699-1628

Dear Ms. Sullins:

On April 22, 2002 and April 10, 2002; respectively, the United States Army Corps of Engineers (USACE) 404 Individual Permit (Action ID # 199300570) and the North Carolina Division of Water Quality (DWQ) 401 Water Quality Certification (WQC # 3344) were issued for the subject project. These permits authorized construction of Transportation Improvement Program (TIP) Number R-2547, Sections BB, C, and CC. On October 22, 2003, the DWQ issued a Notice of Violation that cited violations and/or additional information requests. This letter, attachments, and references constitute our responses to the DWQ requests.

As requested, we are in the process of performing a "self-audit" of this project. This self-audit is being performed by our Construction and Roadside Environmental Units. The self-audit is being accomplished through investigations comprised of a series of meetings with the Department and Design-Build Team personnel. This process is being used to identify specific breakdowns in quality control and quality assurance as related to erosion and sediment control.

We have also initiated a statewide audit for erosion control and permit compliance to prevent similar problems from occurring on any of our projects. Furthermore, we are developing improvements to our erosion control and permit compliance processes. Attachment "A" is a list of items that are currently underway and/or under consideration to improve the Department's overall process related to erosion control and permit compliance efforts.

As requested, an investigation to determine specific locations and the extent of any off-site impacts has been completed. The following is a list of these efforts, along with any changes that have been made to prevent these violations from reoccurring:

On September 29, 2003, construction operations were stopped on the Knightdale Bypass due to the violations to the Sedimentation Pollution Control Act (SPCA). After a 29-day work stoppage period, the project was determined to be in compliance with the SPCA. During this time period, the project was audited by multiple inspection teams with

Ms. Coleen H. Sullins Page 2 November 12, 2003

various corrective actions that included items such as maintenance of devices, installation of additional devices, as well as removal of accumulated sediment. The Contractor put forth a very large effort to correct the identified problems that were noted by Land Quality and NCDOT.

Three areas have been determined to need additional work to abate for the impacts resulting from the violation that occurred on the Knightdale Bypass. The Department will restore the areas adjacent to Poplar Creek, Marks Creek, and the Marks Creek Mitigation site. These three areas have had significant impacts that will require restoration efforts. The two stream sites will be restored to preexisting conditions and stream bank reforestation will occur when construction operations and growing season limitations permit. The Marks Creek Mitigation site will involve the removal of accumulated sediment from existing tributaries. Any established vegetation that is damaged during the restoration will be replaced.

The problems with inadequate Erosion Control plans have been corrected. Inspection forces are documenting deficiencies in the plans and ensuring corrective action is performed and recorded properly. The Contractor has allocated additional resources to maintain the existing devices and respond quickly to problems when they occur. These actions should prevent future occurrences from happening again on this project.

The additional information you requested is presented below indicating the comments raised followed by the Department's response.

Comment from DWQ: Please provide additional information detailing the design changes that have occurred to the stormwater collection and discharge system. In addition, please identify any sites where they may have been constructed. The information provided shall include the original plans along with the current plans such that the collection and conveyance devices, and the out-fall structures and locations are clearly depicted.

Response from the Department: Attachment "B" is a spreadsheet indicating where design changes have occurred in the stormwater collection design. The spreadsheet indicates the location of the changes and which changes have been installed to date. The spreadsheet further indicates the reason for the change. Enclosed, you will also find the original plans along with the current plans with collection and conveyance devices, out-fall structures and locations clearly depicted.

Comment from DWQ: Please explain how and why changes to the vertical and horizontal placement of storm-water out-falls occurred. In addition, please detail a proposed plan for DOT to comply with Condition 13 of the 401 Water Quality Certification (and the Neuse Riparian Buffer Rules with respect to storm-water).

Ms. Coleen H. Sullins Page 3 November 12, 2003

Response from the Department: As stated above, the explanation of how and why changes occurred to the vertical and horizontal placement of storm-water out-falls is included in the Attachment "B" spreadsheet. NCDOT is currently preparing a request for permit modifications due to the apparent necessary changes in the storm-water design. This request for a permit modification will be submitted following your approval of our response to the Notice of Violation.

Comment from DWQ: Please explain why an approximate 50 foot wide earthen causeway was substituted for the 28 foot wide timber matting authorized in the modified 401 Water Quality Certification dated March 21, 2003.

Response from the Department: As you are aware, a permit modification was necessary to construct the bridges at Marks Creek and Poplar Creek. Once this had been realized, the Department directed the Contractor to prepare the necessary permit drawings. As requested, the Contractor submitted permit drawings to the Department for a permit modification. The Contractor's permit drawings indicated temporary work bridges across the streams with temporary roads constructed of either timber mats or earthen causeways as dictated by site conditions. These drawings were revised by the Department to eliminate the earthen causeway option prior to submitting the application for the permit modification.

Once the modification was approved, the Department failed to distribute the application along with the approval letter from DWQ. As a result, the Contractor and Department field forces were not aware the earthen causeway option had been eliminated. The improper distribution resulted in the Contractor and Department field forces working with the permit drawings originally submitted by the Contractor. This breakdown in communication resulted in the Contractor and Department field forces believing the placement of the timber mats or optional earthen causeway for the work areas had been approved. The earthen causeways were constructed due to the variable grade of the existing terrain.

Unfortunately, even with the miscommunication of the option available to the Contractor, the earthen causeways were constructed beyond the limits of the Contractor's drawings. The expansion of the width of the temporary road and associated mechanized clearing occurred incrementally and was not detected or appropriately regulated by Contractor, CEI or Department personnel. Physical delineation of buffers and allowable impact areas could have prevented this violation.

Comment from DWQ: Please explain how impacts beyond those authorized to the riparian buffers occurred.

Ms. Coleen H. Sullins Page 4 November 12, 2003

Response from the Department: The Department concurs that impacts beyond those authorized occurred in the riparian buffer areas, and include the type and width of the temporary roads constructed, as well as disturbance beyond the authorized perimeter limits of impacts. As stated above, the extent of impacts in the buffer areas occurred incrementally over a period of time as construction progressed through various phases (i.e. drilled shafts, delivery of materials, construction of columns and caps, etc.). Again, project personnel failed to monitor and regulate the authorized limits of impact appropriately. The Department now recognizes that physically delineating the riparian buffers and authorized areas of impact could have prevented incremental growth of disturbed/impacted areas.

Comment from DWQ: Please explain how NCDOT plans to restore the unauthorized wetland impacts. In your response, you should include a complete restoration plan, an implementation schedule with dates, and a three-year monitoring plan.

Response from NCDOT: The Knightdale Bypass is currently 55% complete and scheduled to be finished in August 2005. Restoration work will begin as soon as possible following construction operations within the limits of the impacts. The impacts that have occurred to date will be restored to its preexisting condition. The restoration will require the Contractor to remove any unauthorized material that has been placed in jurisdictional areas. The sites will then be ripped to a depth sufficient to ensure that compaction from previous activities do not inhibit the function of the wetland. These areas will then be seeded and mulched using riparian seed mixtures. The sites will then be reestablished where practical with wetland tree species. The Department proposes to use visual monitoring protocols for these areas beginning at the completion of the project (8/5/03) and continuing for three years after the project is complete. An annual report will be provided to Water Quality for their review.

Comment from DWQ: Please detail DOT's internal protocols for the oversight of project construction to ensure compliance with the 401 Water Quality Certification. Include in your discussion: 1) a discussion on the oversight protocols that DOT uses in reviewing, processing, and disseminating the 401 Water Quality Certification to DOT construction staff, including individuals that are required to read and review it, 2) a discussion that describes how the 401 Water Quality Certification and its conditions are incorporated into the construction plan, as well as the actual construction of the project, 3) the parties responsible for overseeing the project construction and ensuring compliance with the 401 Water Quality Certification, 4) the oversight protocols used in this project were consistent with DOT's standard operational procedures, and 5) the protocols used by DOT to ensure that impacts did not exceed those authorized.

Ms. Coleen H. Sullins Page 5 November 12, 2003

Response from the Department: The Project Development and Environmental Analysis (PDEA) Branch of the Department performs the reviewing and processing of the 401 Water Quality Certifications. The DWQ 401 Water Quality Certification for this project was incorporated into the contract for this project. A pre-construction meeting was held in the Division with the Contractor and various subcontractors.

The sensitive nature of this project warranted a separate environmental pre-construction meeting. Accordingly, this meeting was held at the Resident Engineer's office on July 22, 2002. The purpose of the environmental pre-construction meeting was to address the regulatory permits, permit conditions, and review permit drawings with the Contractor. Mr. Eric Alsmeyer addressed the USACE permit conditions and Mr. Chris Murray addressed the NCDENR-DWQ permit conditions. Ms. Alice Gordon provided additional information concerning the permits during the meeting. The Contractor was informed that although the project is characterized as "Design-Build," no design changes were allowed without a permit modification. The Contractor was informed that no changes to the alignment of outfall locations, culverts, bridges, grassed swales or ditches are allowed without a permit modification.

The permit modification for the Marks Creek and Poplar Creek bridge sites was also reviewed and processed by the PDEA Branch of the Department. Upon approval of the modification of the original certification, it is normally distributed to the Department construction staff. In this instance, there is no record of the approval being distributed to the Department construction staff. Usually, this information is distributed to the Division Engineer, Division Construction Engineer and Resident Engineer.

The design of the project should incorporate and comply with DWQ 401 Water Quality Certification and relevant conditions. This should include (but is not limited to) roadway and bridge design, hydraulic design and the erosion and sediment control plan. Department personnel responsible for these designs are fully aware of DWQ 401 Water Quality Certification and relevant conditions. Additionally, the construction of the project should be in compliance with the DWQ 401 Water Quality Certification and relevant conditions.

The parties responsible for construction oversight and compliance with the 401 Water Quality Certification include: North Carolina Constructors (Contractor/Lead Designer), Sungate Design (Hydraulic Designer), KCI Engineering (Construction Inspection), Mr. Chris Murray (NCDOT Division Environmental Officer), Mr. Steve Leonard (NCDOT Resident Engineer), Mr. Tracy Parrott (NCDOT Division Construction Engineer), Mr. Donald Pearson (NCDOT Roadway Environmental Field Operations Engineer), Ms. Christy Wright (NCDOT Assistant Resident Engineer). Mr. Doug Ramsey (NCDOT Lead Project Inspector), and Mr. Dennis Jernigan (Roadway Construction Engineer).

Ms. Coleen H. Sullins Page 6 November 12, 2003

The oversight protocols for this project are basically the same as on any construction project. These protocols begin with the environmental meeting prior to construction to review the permit requirements and continue through inspection of the project for compliance by various personnel. These personnel include the Resident Engineer, Assistant Resident Engineer, construction technicians performing the inspection on a daily basis, a Roadside Environmental Engineer performing periodic reviews and a Bridge and Roadway Construction Engineer performing periodic reviews.

The oversight protocols in place prior to construction appeared adequate to ensure permit compliance. The actual project construction oversight on this project did not meet our standards. Department personnel, the Contractor, and the inspection team failed to adequately monitor construction of the project for permit compliance.

Comment from DWQ: Clearly explain how DOT manages sediment and erosion control on projects of this size/scope.

Response from the Department: The Department utilizes a four tier system of checks and balances. The first tier involves the Contractor who is responsible for implementing and maintaining the erosion and sediment control plan on the project. The second tier is comprised of the Resident Engineer and his inspectors, as well as the construction inspection firm charged with administering the contract. They ensure that the Contractor complies with all aspects of the SPCA. The majority of the corrective actions and inspections occur on the first two tiers of the system. The third tier consists of an oversight inspection performed by the Roadside Environmental Unit's Field Operations Engineer, as well as the Construction Unit's Roadway Construction Engineer. These individuals routinely inspect the project to ensure that all aspects of the Department's erosion and sediment control program are working correctly. The final tier involves the Land Quality Section staff reviewing the project when necessary. At any point in the construction of the project a violation to the SPCA is noted, then corrective actions occur. In the event the Contractor is negligent, then construction on the project stops until the project is deemed in compliance with the SPCA.

Comment from DWQ: It is the understanding of DWQ that safe guards are in place to assure control measures are maintained to ensure compliance with the sediment and erosion control requirements of the state of North Carolina. Please detail the measures that were taken to ensure compliance with the Knightdale Bypass. It should be noted that the inspection report from the DLR describes significant deficiencies in design, construction, installation, and maintenance over an extended period of time. Please explain why the deficiencies were so severe and prolonged.

Ms. Coleen H. Sullins Page 7 November 12, 2003

Response from the Department: The Department of Transportation required the Contractor for the Knightdale Bypass to design the erosion and sedimentation control plan utilizing 2,400 cubic feet of storage per disturbed acre. The Contractor chose to submit the erosion control plan in two phases. The first phase covered the clearing and grubbing portion of the construction process. The second and final phase involved the mass grading phase of the project. These plans were submitted to the Roadside Environmental Unit office for review as required by the delegation agreement between the Department and DENR Land Quality Section. Corrections were noted on the plan and the Contractor addressed those concerns.

Grading operations began and the clearing and grubbing phase were installed. The project progressed to the mass grading phase, which began the implementation of the second phase of the erosion control plan. During the transition between the two phases, there was a failure to document which devices were installed on which plan. The two plans became disconnected and information about changes were not properly documented. Violations began to develop and the Roadside Environmental Unit's Field Operations Engineer, as well as Land Quality staff cited the Contractor for these occurrences. Corrective actions were initiated and completed by the Contractor. Further problems began to develop as heavy rainfall from an unusually wet summer impacted the project. Additional inspections were made noting areas that needed attention. The overall condition of the project began to decline. In order to keep the project on track, the Contractor began incorporating additional erosion and sediment devices. Unfortunately, these devices were not sized properly or located in the proper areas. Many of these devices were not documented or engineered to meet existing conditions.

On September 29, 2003, the Department determined that the Contractor needed to cease all operations until all violations that had been noted on previous reports were corrected. Due to the extensive list of unsatisfactory items, the Contractor was unable to correct the items before Land Quality visited the project.

Unfortunately, even with all of the emphasis we place on environmental stewardship, mistakes still occurred. I sincerely apologize for what has happened on this project.

We stand ready to provide you with any additional information you may require for your review of this issue. If you have any specific questions or require any additional information, please contact me at (919) 733-7384 or Mr. Steven D. DeWitt, Director of Construction, at (919) 733-2210.

Ms. Coleen H. Sullins Page 8 November 12, 2003

Sincerely,

L. A. Sanderson, P.E. /EAP

L. A. Sanderson, PE State Highway Administrator

LAS/ECP:ks

CCLyndo Tippett, Secretary NCDOT
Roger Sheats, Deputy Secretary, NCDOT
Steve Varnedoe, PE, Chief Engineer — Operations
Steven D. DeWitt, PE, Director of Program Delivery
Jon Nance, PE, Division Five Engineer
Tracy Parrott, PE, Division Five Construction Engineer
Don Lee, PE, State Roadside Environmental Engineer
Steve Leonard, PE, Resident Engineer, Division Five
Gregory J. Thorpe, Ph.D., PE, Director of Environmental Management, PDEA
Division of Water Quality, Central Files
Division of Land Resources, Raleigh Regional Office
US Army Corps of Engineers — Wilmington Office
Danny Smith, Division of Water Quality
Wake County Environmental Services

Enclosure

Jeff Poupart, Non-Discharge Enforcement Unit

ATTACHMENT A

DRAFT

Suggested Improvements to Erosion Control and Permit Compliance Processes on Contract Construction Projects

- 1. Develop "Certified Professional in Erosion and Sediment Control" (CPESC) program to include Department, contractor, and private engineering firm employees.
- 2. Develop permit compliance process similar to Immediate Corrective Action (ICA) process. This would apply to all projects.
- 3. Conduct process review for all design-build and non-design-build projects to include both contract administration and design components. Review all pertinent contract and/or scoping requirements and strengthen/clarify as appropriate.
 - Review Department's Qa process including plan review protocol
 - Require contractor/DB team to submit Qc program plan with special attention to erosion and sediment control and permit compliance
- 4. Conduct awareness training to include:
 - Department employees to the lowest level
 - Distribute Best Management Practices Manuals to all employees
 - Conduct joint training with the contracting and private engineering industries
- 5. Re-emphasize and strengthen ICA process on all projects. Develop language to stop work on appropriate activities upon receipt of ICA. Require 72-hour compliance. Failure to comply will result in total project work stoppage.
- 6. Perform in-depth erosion control review on all design-build projects immediately and perform these inspections at least quarterly on all design-build projects and major design-build projects.
- 7. Include contract requirement for all projects to stake all jurisdictional areas with designated markings (i.e. pink flags) and require field orientation prior to work in or around permitted areas.
- 8. Strengthen Incentive/Disincentive provisions for ICAs & NOVs. Current design-build projects have \$5,000 per month incentive for no ICAs and/or NOVs. Propose \$5,000 penalty for ICA, with disincentive of \$1,000 per day until project brought into compliance. \$10,000 for NOVs with \$2,000 per day disincentive. The I/D provisions would be included in all design-build projects and select design-bid-build major grading projects.
- 9. Review pay item process for design-build. Review options of lump sum, reverse banking, retainage, etc.
- 10. Develop performance based prequalification process for sedimentation and erosion control and environmental permit compliance. This would apply to all prime contractors and subcontractors.
- Provide/require mandatory training for design-build firms. Training to include contractors, design
 firms, CEI firms, and Department employees. Training to be held prior to beginning any work on
 projects.
- 12. Require biweekly/monthly certified document from erosion control designer on design-build projects to certify erosion control compliance with plans and details of actual construction.

| along the right side of the roadway. No additional impacts occur as a result of these changes. Please note that there are significant drainage revisions from the permit drawings. These have been investigated to determine any potential problems with riparian buffer regulations. Every effort has been made to address all buffer regulations for treatment of stormwater and to provide diffuse flow at buffer zones. Each structure has been investigated individually to ensure that any redesign did not cause unnecessary impacts. Any drainage that was revised was done so with the intent of ensure that any redesign did not cause unnecessary impacts. Any drainage that was revised was done so with the intent of improving the function of the systems and to provide a lesser impact to the environment. | | - | | | | general comment | Ils | 74 CC 21 of | | ၁ ၁ | Ιt |
|--|--------|---------------------|------|--------|---|---|--------------|-----------------|------------------|------------|------|
| The permit drawing depicts a drainage structure along the southern fill slope of the roadway. The plan sheet depicts a lateral base ditch along this fill slope. Additional drainage structures are depicted in this area on the plan sheet. An additional 750mm cross pipe was added to supplement the existing undersized cross pipe. A lateral ditch was added to convey off-site drainage to the stream. Also, the drainage design was revised to make use of the existing 750mm pipe that runs laterally along the right side of the roadway. No additional impacts occur as a result of the existing 750mm pipe that runs laterally | | 180+50 | т | BUILT | 2,202,29 4 04,205,2 4 041;24 1 4 04;24 1 | structures | † I | 2C 21 of | SI-OO | | |
| The plan sheet depicts a lateral ditch along the northern fill slope of the roadway right of Station 180+00. This lateral ditch is not depicted on the permit drawing. The lateral ditch causes no additional impacts. | LT | 0 + +821 | Г | BUILT | dorib | channel ditch | νι 1 | 30 12 bns 42 | | <u>၁၁</u> | |
| Changed condition and explanation The permit drawing depicts fill in surface water at Station 180+60 RT, but does not depict a relocated channel. No additional stream impacts have occured as a result of this revision as the portion of the channel and the buffer impacts were accounted for in the summary dated 2/7/01. | | 09+081 | Г | BUILT | channel relocate | ni lənnandə bətsəolər timrəq ni ton Ilft | ÞΙ | 10 12 bns 42 | EI-DD | ၁၁ | |
| astronolare bas astributed | Offsei | Sta | Line | Status | Str.# | Description | Permit site# | Permit sheet | NCC Plansheet | Sec | Item |

| | J | | | Ø | | | Permit s | Permit s | NCC Plansheet | | |
|--|--------|-----------------|------------------|--------------|---------------------|--|----------|-------------------------------|-----------------------|------------|---------------------------------------|
| Changed condition and explanation | Offset | Sta | Line | Status | Str.# | Describtion | te # | <u>8</u> | NCC Sheet CC | သ | Item |
| Plan sheet 10D depicts toe protection and a lateral base ditch along the northern slope of this Y line in the buffer. The permit drawing does not depict either of these features in the buffer. An off-site drainage area was unaddressed in the previous permit drawing. To convey the discharge adequately, a ditch was required. Since this is off-site drainage, it is acceptable to ditch through the buffers. The ditch will impact an additional 0.013 hectares (0.032 acres) of buffer zone area. | TJ | 12+00 | K bCX1 | HOLD | eot + dətib torq | lateral ditch and toe prot not in permit | 01 २४ 6 | oroo To VI bas 42 | | | |
| The permit drawing depicts a level spreader located at Station 18+60 -Ramp BDYI-LT. This device was removed on plan sheet 11C since the drainage system associated with it has been removed eliminating the concentrated discharge. Moreon than the concentrated discharge. | : | 09+11 | I KBDA | revised | sbreader | Level spreader in permit deleted | 01386 | CC 16 and 17 of 24 | Э | ၁၁ | |
| additional impacts occur as a result of this change. The permit drawing indicates that the structure is a 1350mm pipe. Plan sheet 11C depicts the structure is a 1200mm pipe. The pipe size was found to be excessive. No additional impacts have occurred as a result of this change. | LINKL | 18+20 | I I I I | BUILT | 100 | str 100 pipe. 1200mm i.s.o. 1350mm | 01386 | 2C 16 2d 17 of 2d | C 10D/11 CC- | ၁၁ | |
| The permit drawing depicts the inlet of the structure originating directly outside of the fill slope and not connecting to a pipe underneath an adjacent road. Plan sheet 11C depicts the inlet of the structure directly connected to the pipe underneath the adjacent road by a junction box. The fill slopes on the permit drawing have been revised to show the bridge approach fill which covers this area completely. This change will impact an additional 10 meters (33 feet) of stream. | LT | 18+20 | KPBDY | BUILT | 001 | of 100 connected to existing | 01386 | 24 24 30 71 of 2C 16 | Э | 22 | 0 0 0 0 0 0 0 0 0 0 0 0 0 0 0 0 0 0 0 |
| The permit drawing depicts a level spreader located at Station 17+60 -Ramp BDY1-RT. This device was removed on plan sheet 11C since the drainage system associated with it has been revised to a single inlet that directs the discharge to the opposite side of the ramp outside of the buffer zones. No additional impacts occur as a result of this change. | | 06+†8I 09+LI | I I KbBDA | revised | A/V qenqin | drainage str in buffer deleted \ modified ri mont shown in | | To 71 brus 124 | -၁၁ -၁၁ | <u>၁</u> ၁ | εε 7.9 |
| Plan sheet 14 depicts the placement of Class B riprap within the wetland limits at Station 184+90 Rt. The permit drawing does not depict this riprap. The riprap was added to stabilize the transition from the ditch to the wetlands. The riprap will impact an additional 0.001 hectares (0.003 acres) of wetlands. Plan sheet 15 depicts a PFSH inside the wetland limits located at the outlet of a pipe and an additional drainage inlet at Station 186+05 Pt. These forms | ТЯ | 189+02 | Γ | BUILT | HSd | permit permit permit | रा ऋा | 24 CC 18 of | 14/12 CC- 14/12 | 23 | Þ |
| addition of guardrail in this area. This required a drainage inlet to be added. A properly sized PFSH was added to diffuse the flow from the outlet pipe. The PFSH will impact an additional 0.002 hectares (0.006 acres) of wetlands. The permit drawing depicts a lateral ditch that flows to a level spreader on the south side of the roadway. | TI | 13+00 | ξX | BUILT | 204, ditch | - lateral ditch changed | £1 | CC 19 of | CC-70 | ၁၁ | ς |
| aspects an additional reconfigured rateral ditch that conveys drainage from the north side of the road and outlets into the ditch and level spreader to the south side of the road. The ditch was reconfigured based on existing field conditions and causes no additional impacts to the level spreader design. | | 15+00 | K3 | HOFD . | 199, 200, | + ditch added PSH shown other | 13 | CC 18 | CC-70 | 22 | 9 |
| The permit drawing depicts a drainage pipe with a PFSH located at Station 12+00 RT -Y3 The plan sheet depicts the PFSH and drainage system located at Station 11+80 RT -Y3 Additional shoulder berm gutter was added which betters protects the buffers as runoff that previously flowed directly into the buffers is now collected and directed to a properly sized PFSH outside of the buffers. | | 00171 | | 65011 | HSd | 961 rts To sbis | | 10 61 bns 42 | | | |
| outside of the buffers. No additional impacts occur as a result of this change. The plan sheet depicts a lateral ditch and toe protection on the north side of the roadway. These features are not depicted on the permit drawing. These revisions do not impact the buffer zones or jurisdictional streams. | TJ | 15+00 | ελ | BUILT | toe protection | eot bns ditch latestal timreq ni ton torq | £1 | CC 18 | CC-70 | 20 | |

| | ž | Sta | Line | Status | \$tr.# | Description | 42 | 2 | NCC Plansheet | Sec |
|--|-------|-------------------------|---------------------|--------|-----------------|---|----------------|---|----------------------|---------------|
| Permit drawings indicate a headwall at the inlet of this pipe. The design of this site was revised to be a junction box joining the two pipes rather than a headwall on the end of one of the pipes, because the fill in the gore area between -Ramp BDYI- and -L- completely covers both ends of the pipes. A 750mm cross pipe has been added under -L- to eliminate a drainage diversion. No additional impacts occur as this entire area was included in the summary quantities dated 2/7/01. | | 16+25 | RPBDY I | TJĪŪB | 7 9 | w 12 .o.s.i 97 str llswbs9d | 8 % L | CC 14 | -၁၁ | DD 61 |
| Plan sheet 10A indicates a junction box and additional drainage atructures that flow into this pipe. The design of this site in the gore area between -Ramp BDY1- and -L- completely covers both ends of the pipes. A 750mm cross pipe has been added under -L- to eliminate a drainage diversion. No additional impacts occue as this area was included in the current. | LT/RT | 00+291 | Γ | TJIUA | ¹ 89 | bəbbs əqiq + s97 rts | 8 <i>7</i> 8 L | 24 3uq 12 of CC 14 | : | CC CC |
| Permit drawing indicates that a PFSH is located along -Ramp BDY1- line at Station 16+00. The PFSH on the permit is shown on the side of a 2:1 fill slope. This drainage system was revised to direct the drainage system to the opposite side of the ramp to a level area with a properly sized PFSH. No additional impacts occur as a result of this observed | TA\TJ | 16+30 | KPBDY I RPBDY | moved | 787,87 49 | PSH moved to 15+80 no stream between | 8 % L | CC 14 | -၁၁ | CC CC |
| sheet 10D indicates that the two structures are separated and 2m (6LF) of live stream is located between the pipes. Plan converged from the two ramps burying the channel and pipe ends. No additional impacts have occured as this area was included in the summary quantity dated 2/7/01. | | | I I | | <u>†9</u> | 44 pipe 900mm i.s.o.e.i | 8 % L | 24 24 CC 14 | -၁၁ | CC CC |
| Plan sheet 10A indicates that the structure is a 900mm pipe. The permit drawing indicates that the structure is a 1500mm pipe. The pipe size was found to be excessive and redesigned according to NCDOT guidelines. 
| Permit drawing indicates that a PFSH is located along -Ramp CYI- at Station 14+30. This PFSH has been eliminated from the plan sheet. The drainage area has been directed toward a properly sized PFSH located at Station 15+30 -Ramp CYI No additional impacts have occurred as a result of this change. Plan sheet 10D indicates that riprap will be placed at the outlet of the structure where bank excavation has been conducted. The permit drawing does not depict the riprap and instead depicts a cross vane at the outlet. The cross vane was inadvertantly omitted from the placed at the riprap and instead depicts a cross vane at the outlet. The cross vane was | TJ | 14+90 | BECKI | BUILT | qsıqiı | tiprap instead of | 01386 | 24 Sud 17 of 24 24 34 | -၁၁ |)) |
| stream impacts as it will be installed in a portion of the channel required to the ciparing channel. Plan sheet 10D depicts a PFSH along the southern fill slope directly outside of the riparian buffer. The permit drawings depict a level spreader in this area. Due to the contour of existing ground, a PFSH would function better in this location. No additional impacts have occured as a result of this change. | TJ | 12+30 | BBCAI | HOLD | HSd | PSH in stead of IvI | | 30 71 bns 24 | CC- 10D/11 CC- |) 33 <i>L</i> |
| Drainage structure #66 was moved to from Station 14+60 to Station 15+00 -Ramp CY1- to eliminate unnecessary pipe. Additional drainage was directed to the PFSH located at Station 15+30 RT and it was sized accordingly. | רז | 0 <i>L</i> + <i>L</i> I | I I KVBDY | НОГР | 16 '001 '46 | Təfflud ni rts əganiarb bəffibom \ bəfələb | 01 22 (| Jo 71 bns | • | |

| | Offse | Sta | Line | Status | Str.# | Description | mit site# | mit sheet | NCC Plansheet | Sec_C | Item 5 |
|---|---------|---------|-------------|--------|---------------------------|---|-----------|-----------------------------|---------------|------------------|---|
| Permit drawing depicts a 1.5m (5 LF) base ditch that outfalls to a drainage pipe that is connected to the box culvert. The sheet indicates toe protection along the eastern fill slope and a PFSH located approximately 30m (100LF) away from the riparian buffer. Lateral ditches were removed and replaced by toe protection. Runoff from the roadway is directed to a properly sized PFSH to provide diffuse flow. No additional impacts | | 154+40 | Γ | НОГД | ńotib | toe prot in stead of ditch to lyl sprdr | | 1230 G | | | |
| The PFSH located at Station 154+60 RT shown in plans is not shown in the ground day; my process | RT . | 124+50 | Г | HOLD | 30, 31, PSH | PSH not in permit | | 9 of 24 | | 22 | |
| Permit drawing indicates a 0.9m (3LF) base ditch along the western side of the crant of this change. | TJ | 122+00 | Γ | BNILT | dətib | base ditch was redesigned to lateral | S 28 17 | CC 8 and | ८- ၁၁ | ၁၁ | |
| ateral ditch has been redesigned on the plan sheet to match field conditions. It outlets in the level spreader. No additional mpacts have occurred as a result of this change. Plan sheet indicates riprap for bank stabilization at the outlet of the structure. This riprap was inadvertantly omitted from permit drawing. An additional 4 meters (13 feet) of stream impacts have occurred as a result of this change. | TI | 128+40 | Γ | HOLD | qsrqir | 10m (30LF) of riprap at be3 not permitted | 9 | 20 12 of CC 12 | · | ၁၁ | - |
| ermit drawing depicts a lateral base ditch that originates at the railroad and terminates at the creek on the west side of the oadway. The plan sheet indicates that this lateral ditch has been decreased in length and reconfigured. The result of this shange has further minimized jurisdictional impact. Toe protection was used in place of a portion of the riprap lined ditch ulong the western fill slope. The same discharge is directed toward the level spreader located of Society. | I TJ | 129+00 | Γ | HOLD | oot + dotib protection | + bagrand changed toe prot added | 9 | Jo 21 205 | 8 - 22 | 22 | |
| defitional impacts occured as a result of this change. Sermit drawing depicts a lateral base ditch that terminates at the creek on the eastern side of the roadway. The plan sheet lepicts a reconfigured lateral ditch that terminates at the edge of the riparian buffer. Toe protection is depicted along the lope within the riparian buffer. The drainage depicted on the permit drawing dated 4/8/02 renders the level spreader used in the ditch flow into the level spreader so that diffuse flow could be provided before the outfer. The ditch was eliminated in the buffer and replaced with toe protection. This reduced the buffer impacts. | TA TA s | 158+80 | r | HOLD | oot + totib protection | bagnado dotib latetal babba torq aot + | 9 | CC 12 of 24 | 8-00 | 22 | *************************************** |
| The structure at Station 159+30 LT shown on the permit drawings has been removed on the plans. This structure was no singer needed and eliminated from the plans. The same discharge is directed toward the plans. | r TJ | 128+40 | Т | НОГР | A/M | str deleted | 9 | 24 and 13 of | CC-8 |)))) | |
| The structure at Station 159+40 RT shown on the permit drawings has been removed on the plans. Structure #43 has been deed to the plans in the median. This structure was no shown in the permit drawings. The structure located at 159+40 RT has no longer needed and eliminated from the plans. Structure #43 was added due to revisions in the guardrail configurations as taken as a false sump in the median. The same discharge is still directed toward the level spreader. No additional imparate occurred as a result of this change. | RT TA | 00+6\$[| T | HOLD | £ t 'Z t | str changed | 8 38 L | CC 14 sud 13 of CC 17 | : | 22 | |
| lan sheet 10A indicates that the structure is a 900mm pipe. The permit drawing indicates that the structure is a 1500mm ipe. The pipe size was found to be excessive and redesigned according to NCDOT guidelines. No additional impacts occ | Cr b | 19+52 | I I I | BUILT | | mm00čI .o.s.i | | to či bna t2 | 10A/D ; | | |


| | 0 | | = | Status | | | iit sit | iit sh | NCC Plansheet | Sec |
|--|----------|------------------|----------|------------------|--------------------|--|-------------------|--|------------------|-----------|
| Changed condition and explanation | Offsed T | Sta 141+30 | Line | E yllsinaq | Str. # sədətib | Description X-set of lateral ditch | 6 ** | C 28 of | C-2F | Sec C |
| There is a discrepancy between the lateral ditch cross section depicted on permit drawing 28 and plan sheet 2F. The detail the permit drawing will be revised to coincide with plan sheet 2 F and will be submitted for a permit modification. | 131 | | | BUILT | | not per permit | | 34 \$ 3.5 | V JJ | <i>33</i> |
| The permit drawing indicates a PFSH is located at Station 145+40. The plan sheet indicates that this device has been shifted to Station 145+20. The bridge was revised to span the buffers in that drawing was not adjusted to match the revised length of bridge. The drainage system has been shifted 20 meters in that drawing was not adjusted to match the revised length of bridge. The drainage system has been shifted 20 meters (60LF) back away from the buffers, but is the same configuration. No additional impacts have occurred as a result of this change. | TA/TJ | 142+50 | Г | HOLD | HS4 , 7,8,2 | biovs ot bavom H2¶ egbird | CC 7 | 2C 5 of 34 | <i>†</i> -ɔɔ | CC |
| Permit drawing indicates a level spreader that is 5m (15LF) long at station 147+20. This device is not depicted on the plan sheet. Site 10 of R-2547C (Sheets 29 and 30 of 34) and Sites 1 and 2 of R-2547CC (Sheets 4 and 5 of 24) show the same areas of the project. The note on Sites 1 and 2 of R-2547CC states 'See Site 10 on part R-2547C of the permits for drainage and diffusing devices.' This level spreader was omitted for because the field conditions for the level spreader were considered unacceptable since it was located on a slope greater than 10 percent. No additional impacts occurs on considered unacceptable since it was located on a slope greater than 10 percent. No additional impacts occurs as | TJ | 147+20 | ר | revised | Y/N | ləvəl (TJLI) mč spreader mising snslq morf | CC 7 | CC 5 of 30 of 34 | s-22 | ၁၁ |
| This change. Plan sheets depict an additional cross pipe that originates from the end bent that outfalls into a PFSH. This additional pipe system collects stormwater from the bridge and conveys it to a properly sized PFSH. No additional discharge is directed to fine property sized PFSH and no additional impacts occur as a result of this change. | TJ | 147+20 | r | əldaliava | 9,01,6,A6 H2 | added pipes HSq | C 10' | 24 & C 30 of 34 | \$-22 |) |
| boundary. Due to field conditions, the pipe outlet was adjusted. An additional wetland impact of 0.003 besters (0.007) | LT/R1 | 14Y+20 | r | BUILT | qsrqir, I I | 23-00 pipe outlets in wetland | 7 22 | CC 5 of 24 & C 30 of 34 | CC-2 | |
| acres) has occured as a result of this change. Plan sheet indicates that a headwall is located at the inlet of the 1350mm pipe. The permit drawing depicts the structure without a headwall. The headwall does not impact any additional area and no additional impacts have occurred as a result this change. | TJ | 147+20 | ٦ | BUILT | II | 1350mm pipe headwall | CC 2 | CC 5 of 30 of 34 | cc-5 | 22 |
| Permit drawing depicts a PFSH at 146+40. This device is no longer depicted on the plan sheet. The drainage structure was no longer required since the road slopes away (toward the median) from the inlet. Since the concentrated flow was removed the PFSH was no longer needed. No additional impacts occurred as a result of this change. | | 01+051 07+971 | T T | revised TJIUB | A/M EI | PSF not in final and plans snalq Str 13 has beadwall | 3 CC 7 C 10 | 24 & C 24 & C 30 of 34 10 0 O | 9-00 S-00 | 22 |
| Inlet. The headwall causes no additional impacts. Permit drawings indicates level spreader on the east side of the roadway that is straight. The plan sheet indicates a level spreader in this location that is rounded. The permit drawing shows a level spreader as a rectangular symbol for illustrative. | TA TA | 120+40 | 7 | BUILT | headwall | To baset an bebauor stead of straight lvl spret | ε | 24 CC 6 and 7 of 24 | 9-၁၁ | <u>၁</u> |
| purposes only. The actual level spreader should be constructed to match the contour of the existing ground so that the leng of the structure will be level. No additional impacts occured as a result of this change. NCDOT requests additional riprap for bank stabilization at north bank outlet. | ТЯ | 120÷00 | Т | HOLD | | NCDOT NCDENR | £ | CC 6 and 7 of 24 | 9-33 | ၁၁ |

| | Offset | 6 1 | Linc | Status | | | ermit site | ermit shea | NCC Plansheet | Sec |
|--|--------|----------------------|--------|-------------------------|----------------------------|---|------------|-----------------------|------------------|--------|
| Changed condition and explanation A plunge pool is currently being designed at the outlet of structure #115 to dissipate energy and provide stability to the existing channel as a part of the mitigation site located downstream. Additional stream impacts will result from the | ТЯ | Sta 132+60 | T e | E partially TJIUB | Sir. # A\N | Description the stimit of limits at plunge pool | <u></u> | 34 C 19 °E | C-1¢ | 2 |
| Stream relocation at Station 131+40 to 132+00 Lt calls for root wads and low stage check dams in the channel detail as shown on the plan sheet 2G. The low stage check dams are not shown on the permit drawing. The low stage check dams | LI | 131+40 | ר | HOLD | channel | low stage check dams not in permit | L | 34 C 19 <i>0</i> £ | C-7G | ٦ 2 |
| Limits of cut/fill throughout most of this plans and will be removed so as to match the permit. do not account for the construction of the proposed interchange. The cut/fill lines shown in the permit drawing are | LT/RT | 133+00 | T | BUILT | A/V | stimil sot tnsrsfilib | 8 | C 22 of | C-12 | S |
| The level spreader associated with the PFSH's at Station 135+00 RT on permit drawings is absent from plan sheet. The label separate structures, a PFSH and a level spreader, when the intent was for this to be one structure, a PFSH with a level spreader, when the intent was for this to be one structure, a PFSH with a level spreader apron. This was the intent in the original drainage design; therefore the labels on the plans were revised to match | K.I. | 132+00 | Γ | revised | spreader apron | Level spreader apron in permit not in plans | 8 | C 22 of | C-12 | 3 |
| the drainage structure located at Station 134+00 Rt on plan sheet is not shown on the permit drawing. This drainage inlet was required due the addition of shoulder berm gutter necessary due to changes in the fill slope from 4:1 to 2:1. The additional discharge is directed toward a properly sized PFSH located outside of the buffer to provide diffuse flow. No | K.I. | 134+00 | Ţ | TIIUB | 711 , A711 | str not in permit | 8 | 34 C 22 of | C-12 | C |
| A plunge pool is currently being designed at the outlet of structure #116 to dissipate energy and provide stability to the existing channel as a part of the mitigation site located downstream. Additional stream impacts will result from the construction of the plunge pool and will be included as a part of the mitigation site located downstream. Additional stream impacts will result from the construction of the plunge pool and will be included as a part of the mitigation of the | ТЯ | 134+02 | Γ | НОГЪ | bool bjrnge | requested plunge pool not in permit | 8 | 34 C 22 of | C-12 | 3 |
| construction of the plunge pool and will be included as part of the mitigation site quantities. Drainage structures #134A and #134B at Station 142+00 LT are not shown on the permit drawings. The fill slopes were changed from 4:1 to 2:1. This required the addition of shoulder berm gutter and the associated drainage system. The concentrated flow has been directed to a properly sized PFSH located outside of the buffer to provide diffuse flow. No | רו | 145+50 | r | BUILT | 1344,134 B 4 PSH | str not in permit | 6 | 34 C 27 of | C-16A | Э |
| additional impacts occur as a result of this change. Drainage structure #134C at Station 142+60 RT is not shown on the permit drawings. The fill slopes were changed from 4:1 to 2:1. This required the addition of shoulder berm gutter and the associated drainage system. The concentrated flow has been directed to a properly sized PFSH located outside of the buffers to provide diffuse flow. No additional impacts occur as a result of this change. | RT | 145+70 | Γ | TJIUA | ьгн 134С + | str not in permit | 6 | 34 C 27 of | C-16A | |
| Special ditch and associated PSH depicted on plan sheet 16A at Station 140+30 LT are not depicted on permit drawing 26. The plans show temporary measures until the -Y101- interchange is constructed. The temporary measures cause no additional impacts since the entire interchange was included in the summary dated 3/22/2002. | КĽ | 140+80 | Γ | HOLD | + hətib H29 | bns dotib lsioeqs tirmeq ni ton H29 | 6 | C 26 of | C-16A | |
| Special ditch and lateral ditch along the southern fill slope on plan sheet 16A at Station 141+00 to 141+60 are not depicted on permit drawing 27. The plans show temporary measures until the -Y101- interchange is constructed. The temporary measures cause no additional impacts since the entire interchange was included in the summary dated 3/22/2002. | КI | 141+30 | Γ | BUILT | eaftotib | special and lateral ditch not in permit | 6 | 34 C 29 of | C-16A | Э |


| Changed condition and explanation | Offset F | St. 112+00 | Line | Status | #:11S | Description Pipe 67-76A not per | ermit site# | ermit sheet | NCC Plansheet C-10A | Sec | Item 9 |
|---|----------|---------------------|------|--------|----------------------------|------------------------------------|-------------|----------------|---------------------|----------|----------|
| Ine pipe along the left shoulder (Station 112+00 to 113+00) on plan sheet 10C is not depicted on the permit drawing. The pipe was previously routed along the median, but was moved to the shoulder to avoid a conflict with an additional attenuator (guardrail). An additional 20 meters (60 LF) of shoulder berm gutter has been added which will slightly increase the discharge directed to the PFSH. The PFSH has been sized according current DWO requirements. No additional important | ТЯ | 004711 | a | gg o y | 60 f 00 f 10 | permit | | 34 | | | |
| The median pipe size (Station 112+80) on plan sheet 10C differs from the size shown on the nermit drawing. | Cr | 117+80 | Γ | HOLD | 49 <i>L</i> 1€8° 1€ | nedian pipe not per timrəq | ٨s | C 16 of | | | 01 |
| The toe limits do not match at the southwest bridge approach. The toe limits have been revised to correctly show the excavation for the detention basin as depicted in the permit drawing dated 6/29/01. 
| There is a discrepancy in drainage structures at Station 111+90 between the permit drawing and plan sheet 10A. This area has been revised to avoid conflicts with the revised guardrail locations. See the previous item for additional evaluation. | LT/R1 | 06+111 | Γ | HOLD | 69'89'29 | Discrepency in drainage str | ٧s | 34 34 | C-10V | | |
| At Station 117+90, a 400mm CSP and a PSH w/ level spreader apron are shown on the permit drawing but not on plan sheet drainage inlets. The drainage system was shifted so as to outlet outside of the buffer zone to an appropriately sized PFSH. No additional impacts occur as a result of these changes. | TA | 06+411 | Γ | HOLD | V/N | 400mm CSP & PSH not on plans | 9 | 3 dt 3 dt 3 dt | 11-D | <u>3</u> | |
| Drainage structures and a PSH w/ level spreader apron are depicted on plan sheet 11 at Station 117+40. These structures and the PSH are not depicted on the permit drawing. Dimensions for PFSH's were revised to match MCDENR-DWQ current recommendations for size dated October 10, 2001. The level spreader associated with the PFSH on permit drawing is absent from plan sheet. The label was revised to remove the "with level spreader," label to reduce confusion. The confusion arose that this should be two separate structures, a PFSH and a level spreader, when the intent was for this to be one structure, a PFSH with, a level spreader apron. This was the intent in the original drainage design; therefore the labels on the plans were revised to match the current DWQ requirements and MCDOT approved PFSH detail. | LI | 0 1 +411 | ר | TJIUB | ,68,A28,28 H29 | str & psh not per permit | 9 | 34 34 | 11 - 2 | Э | LT |
| There is a discrepancy in toe limits between permit drawing and plan sheet 11 at Station 117+90 Bt. The fill closes in this | RT | 06+411 | Γ | BUILT | V/N | stimil sot trensflib | 9 | C 18 of | C-11 | Э | SI |
| There is a discrepancy in toe limits between permit drawing and plan sheet 1 IA at Station 119+30 LT. The current design requirements and existing field conditions dictated the change in the fill limits. This change will impact an additional 0.001 | TJ | 0£+611 | Т | BUILT | A/N | etimil əot trərəffib | 9 | 34 C 18 of | AII-D | | 91 |
| The slope drain at Station 131+10 Lt on plan sheet 14 that flows into the relocated channel is not shown on the permit drawing. The area necessary to install the slope drains has been added to the impact summary sheet. Bevised nermit | TJ | 131+10 | Γ | TJIUA | toe drain lənnadə | ni ton nisnb əqolz timrəq | L | 34 C 19 of | C-14 | Э | <u> </u> |
| drawings will be prepared and submitted in the modification application. There is a discrepancy in depiction of limits of relocated channel between plan sheet 14 and permit drawing at Station 131+30 LT. The plans are being revised to match the permit drawing and details. | TI | 131+80 | Γ | ногр | channel | etimil transfilib lannada | L | 3t C 16 OL | C-14 | Э | 81 |

| | | Offs | Sta | Line | Status | π * +5 | Description | Permit site £ | Permit shec | NCC Plansheet | Sec | Item |
|---|--|----------------|-----------------|----------|--|---------------|---|---------------|----------------|------------------|-----|------|
| that betasibation to telition | The permit drawing depicts a lateral ditch that terminates at Zone 2 of the riparian buffer. Plan all permit At this site, the pond is to be drained and maintained permanently as an A-basin. 
| Drainage structure #24 oed due to conflicts caused red due to conflicts Caused | There have been minor changes in the drainage structures located at approximately Station 41+70 by the addition of guardrail. No additional impacts have occured as a result of the changes. As difference as a result of the changes. | LI | 0L+IÞ | Γ | HOLD | ¥¢ζ | Str + 400 CSP + riprap (in PDE) not in permit | ٤ | BB 13 of | <i>L-</i> 88 | вв | 7 |
| wings. Station due to field conditions. The would have required an me) would have required an me) would have required an me). | and Mr. Mitchell (NCDENR), NCC will omit the original design and re-design per the permit design and in the location of a 600 mm pipe that drains the Class A Basin and the assistance is a discrepancy in the location of a 600 mm pipe that drawing dated 3/18/2002 would not fund. The elevation of the bottom of the basin (necessary to provide the required sediment storage volutionally in the buffer impacts are impacts have occured as a result of the change. As discussed with Mr. Hennesy and Mr. Mitchell expedite the construction of the PSH in this location. | RT | 0 S+S † | Т | BUILT (except for PSH ~ this will be installed | | H2Y & sqiq mm00d tirmsq rsq ton | € | BB 17 of 30 | | ВВ | |
| ill be regraded to natural | Plan sheet IID indicates an undercut of alluvial soils at toe of fill slope that extends outside of the Station II+75 Lt. The removal of the soils was required for slope stability concerns. The area we ground and revegetated appropriately. The additional impacts will be added to the summary. There is a discrepancy between the permit drawing and plan sheet IIB in reference to the fill cut. | | 09+09 \$L+11 | T XIO | TJIVA TJIVA | V/N | Undercut alluvial soils for slope stability fill cut/fill slope | 9 | BB 20 of 30 | | | |
| to be drained and retained fill slope in the riparian on the permit drawing. The | Lt. The cut/fill slope changed slightly in this area due to field conditions. At this site, the pond is as a permanent A-basin. Impact has been reduced due to field conditions. Plan sheet I IB depicts a 750 mm drainage structure and rock slope protection along the northern buffer at Station 60+80 Lt. The rock slope protection and the drainage structure are not depicted pipe was inadvertantly omitted from the permit drawing. 
| es at the Zone 2 boundary, the bufferzones change | Permit drawing depicts a lateral ditch at Station 71+00 Rt that terminates at the outlet of a 400 m plan sheet depicts this lateral ditch extending to Zone 2 of the riparian buffer. The ditch terminate and causes no additional impacts. As discussed with Mr. Hennessy and Mr. Mitchell (MCDEMR) because the pond is modified to a stream. Therefore there is no impact, however streambank re-form both stream banks. | | 00+5 <i>L</i> | T | DEFELED HOFD | V/N V/N | ditch continues to zone 2 of filled pond (filled by R2641) structure deleted | : | BB 74 of 30 | | | |
| lenoitible old havemen a | The permit drawing depicts a drainage structure outside of the riparian buffer at Station 75+00 R, not depicted on the plan sheet. The drainage structure was part of a drainage system that has bee discharge has been directed toward the buffer in this area and no additional impacts have occured | • | 00+ <i>5L</i> | 7 | 0313330 | TAT. | outside buffer | | 30 | | | |

APPENDIX B

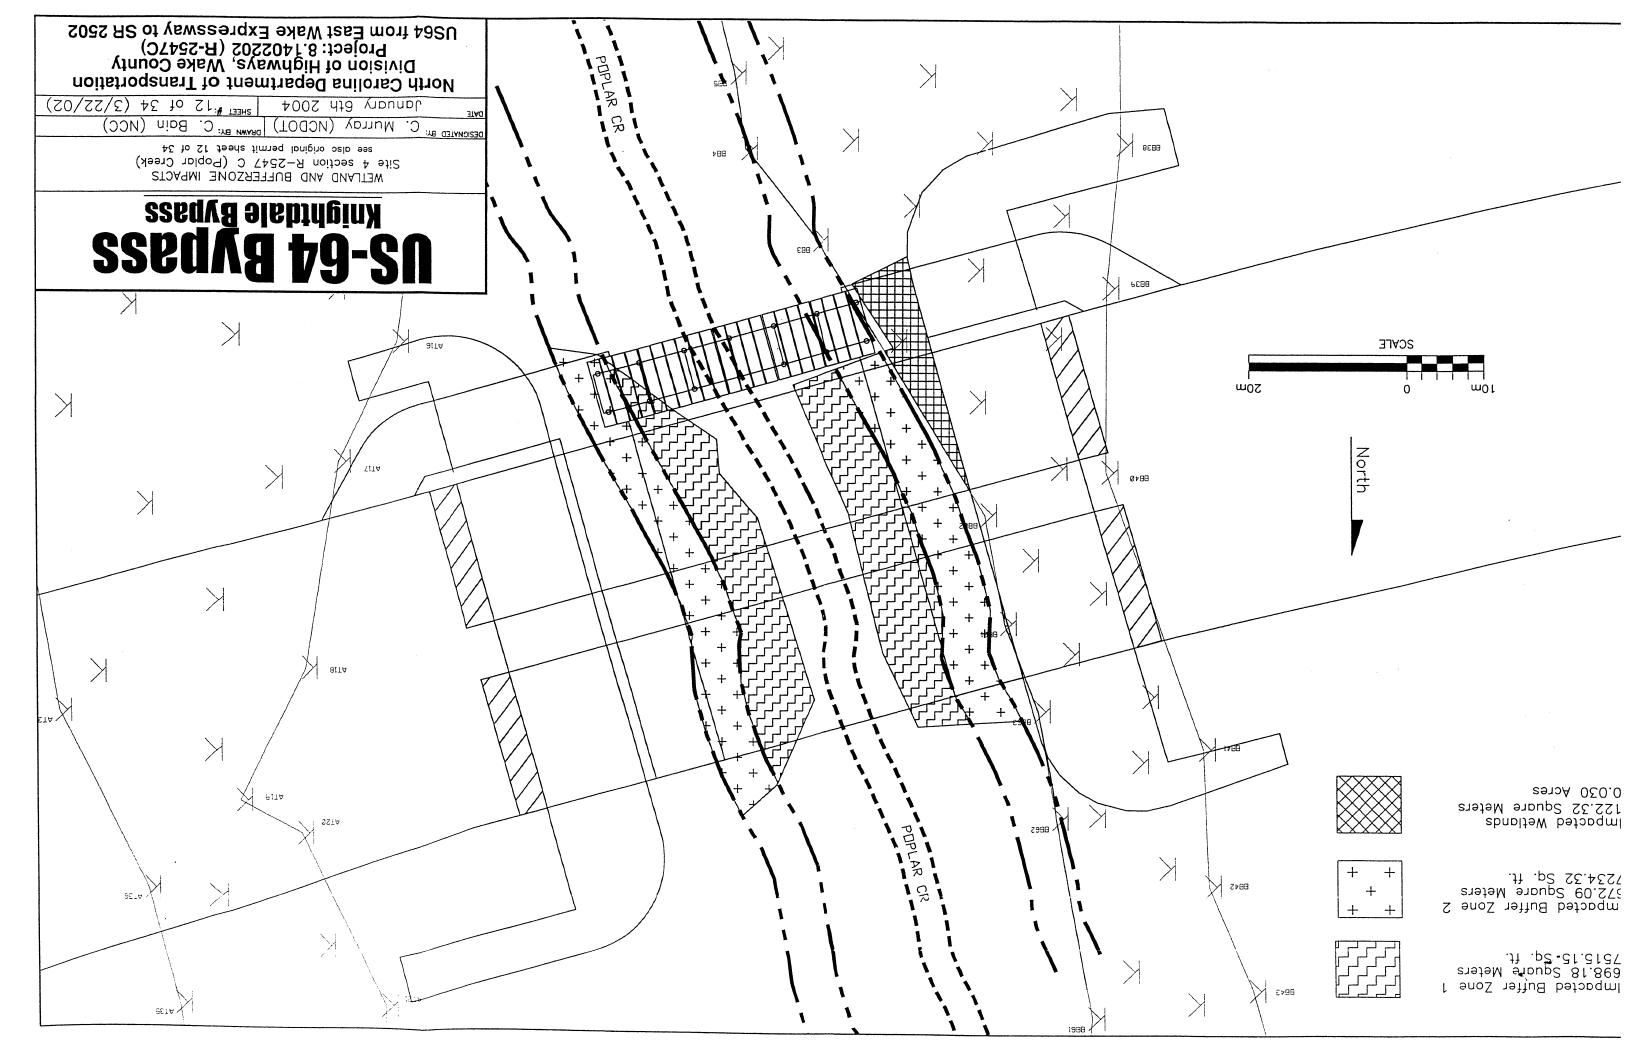

APPENDIX C

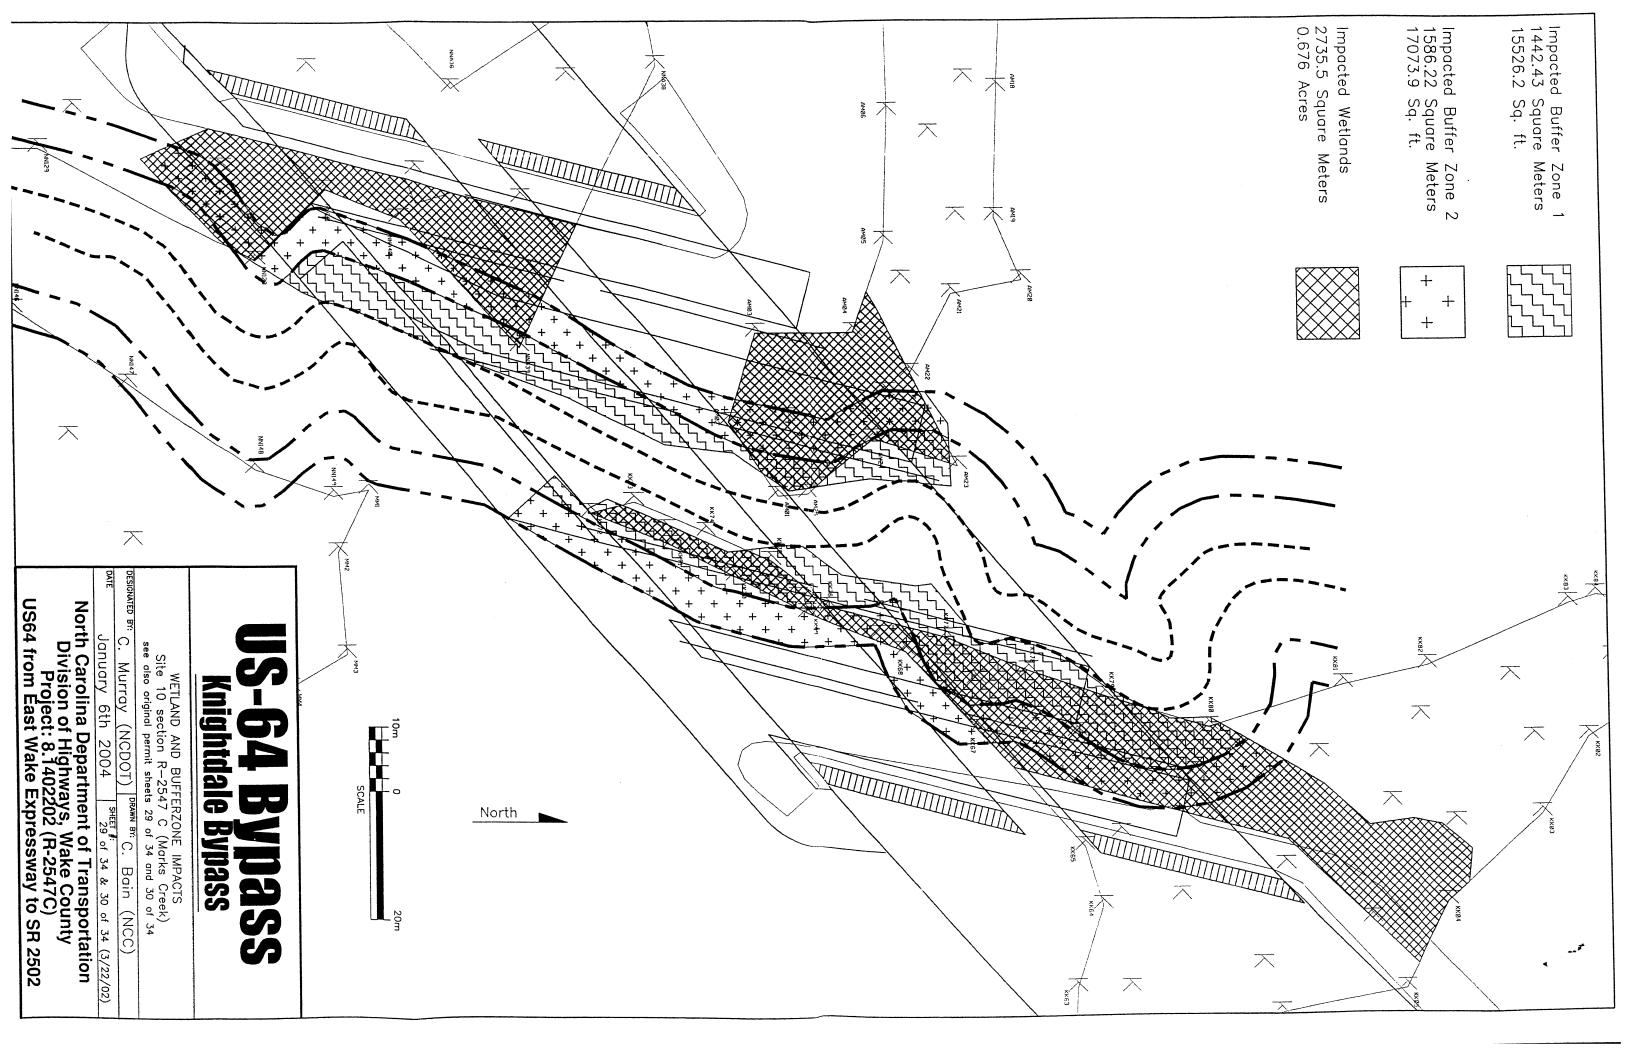

North Carolina Constructors DOAL 6 % * TIST 3 % PROFILE (VERTICAL) $\Lambda = 110 \text{ km/h}$ PROFILE (HORIZONTAL) % Zl ADT 2022 = 82,640PLANS 478,84 = 2002 TQA -, 272 DESIGN DYLY **CEVAPHIC SCALES** 00 I BUS

40221

K 2547B

MAY 24, 2002 TELLING DYLE:

VO BY: DATE:

Ø REB 7-22-03


TOTAL LENGTH STATE PROJECT 8.1402212 = 5.560 km FENCLH 218NCLNKE2 F.Y. PROJECT DPI-0199(004) = 0.506 kmLENGTH ROADWAY F.A. PROJECT DPI-0199(004) = 5.054 km

DESCRIPTION OF REVISION

RELEASE FOR CONSTRUCTION

KEAISIONS

PROJECT LENGTH

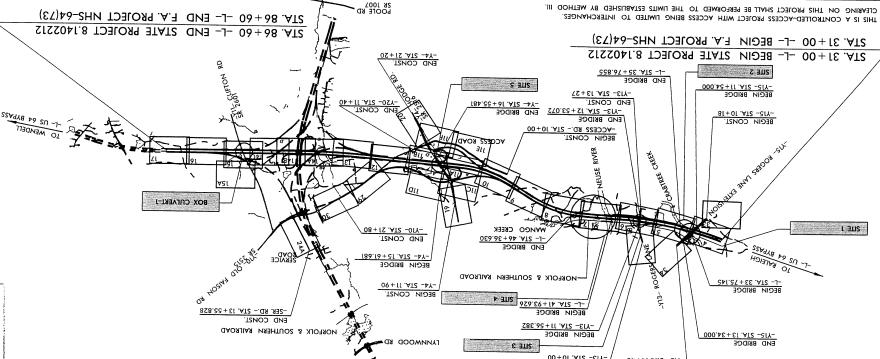

ROADWAY DESIGN ENGINEER

Solta / Linning

Spohony

rst.ddTPcsn

HECKED BA:

:3TAQ

DATE:

HYDRAULICS ENGINEER

MENENEN METSING

12NBN METZ

SEAL

WITH CAROVIN

GRADING, DRAINAGE, PAVING, STRUCTURES, SIGNALS, & SIGNING LAGE OF WORK: FINAL PLANS

EAST WAKE EXPRESSWAY

CKYBIKEE CKEEK 10 EV21 OF SR 2601 (CLIFTON RD) TOCVIION: SECLION BB: - US 64 BYPASS FROM WEST OF

DATE: 7-22-03 RELEASE FOR CONSTRUCTION

NC GRID NAD 83

LILTE SHEEL


DEPARTMENT OF TRANSPORTATION STATE OF NORTH CAROLINA

| TOTAL | SHRET NO. | | E PROJECT REPERENCE NO. | TATE | STATS |
|----------------|--------------|--------|-------------------------|-------------|-------|
| | τ | | 7547BB | <u>Г</u> -Я | N.C. |
| 140 | CLATAEDERIC | | A.A. 19801. NO. | E PROLND. | ITAT8 |
| | 34 | | DPI-0199(004) | 02202 | ≱ſ.8 |
| R/W, UTILITIES | | V⁄d | (TS)42-SHN | 90220 | ≱Г.8 |
| CONSTRUCTION | | | (ET)42-2HM | 02212 | ≱ſ.8 |
| | | \neg | | | |
| | | | | | ···· |
| | | | | | |
| | | | | | |

NULESS OTHERWISE SHOWN AND/OR MILLIMETERS HESE PLANS ARE IN METERS ALL DIMENSIONS IN

MYKE COUNTY

DIVISION OF HIGHWAYS STATE OF NORTH CAROLINA

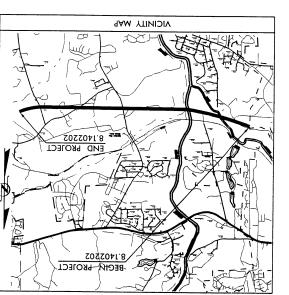

See Sheet 14 For Index of Sheets See Sheet 16 For Conventional Symbols

KENIZION ZOMWYKŁ

| | | | | | | | | 7/22/2003 | TYPICAL SECTIONS | SB |
|--|------------|---------------|---------------|-----------|------------|-------------|------------|-------------|------------------------------------|--------------|
| | | | | | | | 2/12/2004 | 7/22/2003 | TYPICAL SECTIONS | ∀Z |
| | | | | | | 2/12/2004 | 12/16/2003 | 7/22/2003 | TYPICAL SECTIONS | 2 |
| | | | | | | | | 7/22/2003 | CONVENTIONAL SYMBOLS | ıc |
| | | | | | | | | 7/22/2003 | INDEX, GEN. NOTES, STDS | 18 |
| | | | | | | | | 7/22/2003 | INDEX, GEN. NOTES, STDS | ĄI |
| | | | | | | | 12/16/2003 | 11/12/2003 | INDEX OF SHEETS & REVISION SUMMARY | BEA-BB-12 |
| | | | | | | 12/16/2003 | 11/12/2003 | 7/22/2003 | INDEX OF SHEETS & REVISION SUMMARY | BEATBB-11 |
| | | | | | | 12/16/2003 | 11/12/2003 | 7/22/2003 | INDEX OF SHEETS & REVISION SUMMARY | BEA-BB-11 |
| | | | | | | 12/16/2003 | 11/12/2003 | 7/22/2003 | INDEX OF SHEETS & REVISION SUMMARY | |
| | | | | | 12/16/2003 | 12/3/2003 | 11/12/2003 | 7/22/2003 | INDEX OF SHEETS & REVISION SUMMARY | BEATBB 0 |
| SI33HS 3 64850H | | | | | 12/16/2003 | 12/3/2003 | 11/12/2003 | 7/22/2003 | INDEX OF SHEETS & REVISION SUMMARY | REV_88-8 |
| 1-100-100 or other acts of the second of the | | | | | 12/16/2003 | 12/3/2003 | 11/12/2003 | 7/22/2003 | | BEA⁻BB-∆ |
| | | | | | 12/16/2003 | 12/3/2003 | 11/12/2003 | 7/22/2003 | INDEX OF SHEETS & REVISION SUMMARY | REV_BB-6 |
| | | | | | 12/16/2003 | 12/3/2003 | 11/12/2003 | 7/22/2003 | INDEX OF SHEETS & REVISION SUMMARY | BE√BB-2 |
| the state of the s | | | | | 2/12/2004 | 12/16/2003 | 11/15/5003 | 7/22/2003 | INDEX OF SHEETS & REVISION SUMMARY | BE√BB-4 |
| | | | | | 7/12/2004 | 12/16/2003 | 11/15/5003 | | INDEX OF SHEETS & REVISION SUMMARY | BEA-BB-3 |
| 1 (1998 N. 1977) | | | | 2/12/2004 | 12/16/2003 | 12/3/2003 | 11/13/2003 | 7/22/2003 | INDEX OF SHEETS & REVISION SUMMARY | BEV_BB-2 |
| | | | | | | 00007 67 61 | 5005751711 | 7/22/2003 | INDEX OF SHEETS & REVISION SUMMARY | BE√BB-1 |
| СОММЕИТЅ | LEVISION 7 | E REVISION | G NOISTATU | b | 3 | Z | т | 7//22/2003 | TITLE SHEET | I |
| | | , internal | REVISION | BEAISION | REVISION | REVISION | REVISION | Ω∓R DATE | SHEET TITLE | SHEET NO. |

| ROADWAY DESTGN ENGINEER |
|--|
| 50-21-2000 S 14.70 |
| BODDWAY DESIGN ENCINEED \$ DOO!!!!!!!!!!!!!!!!!!!!!!!!!!!!!!!!!!! |
| (T) (73853 |
| |
| NO ASSAULT |
| "MININ" |

| DESCRIPTION OF REVISION | :3TAO | :VB | ON |
|--------------------------|----------|-----|----|
| RELEASE FOR CONSTRUCTION | 7/22/03 | 838 | 0 |
| BEAIZIONS | 11/12/03 | REB | B. |
| BEAISIONS | 12/3/03 | BBA | 2 |
| BEAIZIONZ | 15/16/03 | REB | 2 |
| BEAIZIONZ | \$/15/04 | REB | 9 |
| | | | 9 |
| KEVISIONS | | | - |

12/16/2003

7/22/2003

7/22/2003

7/22/2003

7/22/2003

7/22/2003

7/22/2003

| ON | |
|----|-----------------------------|
| 2 | North Carolina Constructors |
| 2 | |
| В | |
| | |
| 4 | UU HH |

ROCK PLATING

CORRUGATED CONCRETE ISLAND

PREFORMED SCOUR HOLE DETAIL

DITCH DETAILS

TYPICAL SECTIONS

TYPICAL SECTIONS

| LPA GROUP Of North Caroling, p., 4904 Protessional Court, Sulte 201 Raleigh, North Carolina 21609 | STIME LINES | A9J 9UO |
|---|-------------|------------|
| | 317 | 3HT |

S-6

7-S

S-E

SD

SC

| TUDEY OF SHEETS |
|---|
| STATE OF HORTH CAROLINA OF TRANSPORTATION RALEIGH |

DATE: 2-12-04

KELEASE FOR CONSTRUCTION

PROJECT REFERENCE NO. SHEET NO.

| -6Y_SUMMO: Y.SUM | DEMINO NOTE |
|--------------------------|---------------------------|
| јевише : | REVISION SUMMARY |
| | INDEX OF SHEETS |
| ocument Control Number : | |
| IECKED BY: DATE: | DEPARTMENT OF TRANSPORTA. |
| ·ATAC | 111100A2 UTGOM 30 3TAT2 |

MEATZION BOADWAY DESIGN ENGINEER
THRUTTON

SON OF THE CONTROL OF T

| I :3TAG | : 78 | 101 |
|----------|----------------------|--------------|
| 7/22/03 | BEB | 0 |
| 11/15/03 | REB | D. |
| 12/16/03 | 839 | 2 |
| 2/12/04 | REB | 8 |
| | | 19 |
| | | 9 |
| | 11\15\03 15\16\03 | BEB 13/15/03 |



THE LPA GROUP Of Worth Corolling, p.d. PASSON (Corolling, p.d. PROPERTIES COROLL), Suite 201 (MARCHITE) (Corolling 21609)

| COMMENTS | \ BEAISION | EVISION | 2 BEAISION | √ BEAISION | 3 | 2 | I | DATE | MODIFIED FLUME DETAIL | S-I |
|----------|---------------|---------|---------------|---------------|--------------|------------|------------|------------|--|--------|
| | | | | | | | | 11/12/2003 | GUARDRAIL PROTECTION ON DUAL BRIDGE APPROACH MEDIAN | 2-1 |
| | | | | | | | | 11/12/2003 | DETAIL OF GUARDRAIL PROTECTION FOR MEDIAN OBSTRUCTIONS | 5-K |
| | | | | | | | | 12/16/2003 | ROCK VANE DETAIL | 7-2 |
| | | | | | | 12/16/2003 | 11/12/2003 | 7/22/2003 | YAAMMUS JIAABAANƏ | ₩. |
| | | | | | | 0000 | 11/12/2003 | 7/22/2003 | CUIDERAIL SUMMARY | 38 |
| | | | | | | 12/16/2003 | 11/12/2003 | 7/22/2003 | PLAN SHEET | Þ |
| | | | | | 2/12/2004 | 12/16/2003 | 11/12/2003 | 7/22/2003 | PLAN SHEET | G |
| | | | | | 1 007 171 17 | 12/16/2003 | 11/12/2003 | 7/22/2003 | PLAN SHET | 9 |
| | | | | | | | 11/12/2003 | 7/22/2003 | PLAN SHEET | |
| | | | | | | | 11/12/2003 | 7/22/2003 | PLAN SHEET | 8 |
| | | | | | | | | 7/22/2003 | PLAN SHEET | 6 |
| | | | | | | | 11/12/2003 | 7/22/2003 | T33HS NALA | ØI |
| | | | | | | | 11/12/2003 | 7/22/2003 | PLAN SHEET | AI |
| | | | | | | | 11/12/2003 | 7/22/2003 | PLAN SHEET | 81 |
| | | | | | | | 11/12/2003 | 7/22/2003 | PLAN SHEET | JIC IC |
| | | | | | | 12/16/2003 | 12/3/2003 | 2/22/2003 | PLAN SHEET | ID |
| | | | | | | | | 7/22/2003 | PLAN SHEET | IE IE |
| | | | | | | | | 7/22/2003 | PLAN SHEET | 91 |
| | | | | | | | | 7/22/2003 | PLAN SHEET | 2 |
| | | | | | | | | 7/22/2003 | PLAN SHEET | 3 |
| | | | | | | | | 7/22/2003 | PLAN SHEET | A |
| | | | | | | | 12/16/2003 | 7/22/2003 | PLAN SHEET | 8 |
| | | | | | | | 12/16/2003 | 7/22/2003 | PLAN SHEET |) J |

KENIZION ZNWWYKK

| 100 | , DYJE: 3-13-0 KELEYZE LEOK COM | |
|-----------|------------------------------------|-------|
| | | K JUL |
| Z-88-V3A | 88 <i>1</i> +97-8 | |
| SHEET NO. | PROJECT REFERENCE NO. | |

| * C | DATE: 2-12- | Constant and |
|------------|-------------------------------|--------------|
| HUCTION | KELEASE FOR CON | |
| 學的學術 | | |
| | | AL - JIL |
| REV_BB-3 | 88 <i>1</i> 5 57–8 | METRICON |
| SHEET NO. | PROJECT REFERENCE NO. | |

KEAISION SOMWARY

| | | | | | | | | 7/22/2003 | PROFILE | 9# |
|----------|-------------|----------|----------|----------|----------|--------------------|---------------|-------------|--------------------------------------|--------------|
| | | | | | | | | 7/22/2003 | PROFILE | 94 |
| | | | | | | | | 7/22/2003 | PR0FILE | 44 |
| | | | | | | | | 7/22/2003 | PROFILE | 43 |
| | | | | | | | | 7/22/2003 | PROFILE | ₹5 |
| | | | | | | | | 7/22/2003 | PROFILE | Īψ |
| | | | | | | | | 7/22/2003 | PROFILE | ØÞ |
| | | | | | | | | 7/22/2003 | PROFILE | 68 |
| | | | | | | | | 7/22/2003 | PROFILE | 38 |
| | | | | | | | | 7/22/2003 | PROFILE | ζε |
| | | | | | | | | 7/22/2003 | PROFILE | 98 |
| | | | | | | | | 7/22/2003 | PROFILE | 32 |
| | | | | | | | 12/16/2003 | 2/22/2003 | PLAN SHEET | |
| | | | | | | | | 7/22/2003 | PLAN SHEET | 34 |
| | | | | | | 2/12/2 00 4 | 11/12/2003 | 7/22/2003 | PLAN SHEET | 33 |
| | | | | | | 2/12/2004 | 11/12/2003 | 7/22/2003 | PLAN SHEET | 30 |
| | | | | | | | | 2/22/2003 | | 62 |
| | | | | | | | 11/12/2003 | 7/22/2003 | PLAN SHEET | A ₽ S |
| | | | | | | | 11/15/2003 | 2/22/2003 | PLAN SHEET | 20 |
| | | | | | | | CBBC/ CI/ II | | PLAN SHEET | 61 |
| | | | | | | | | 7/22/2003 | PLAN SHEET | 18 |
| | | | | | | | | 7/22/2003 | PLAN SHEET | ΔI |
| | | | | | | | | 7/22/2003 | PLAN SHEET | 91 |
| | | | | | | | | 7/22/2003 | PLAN SHEET | AGI |
| | | | | | | 0.000 | | 7/22/2003 | CULVERT DETAIL CONSTRUCTION SEQUENCE | 12 (DET) |
| COWWENTS | L NOIGIA TH | 9 | 9 | b | 3 | 12/16/2003 2 | 11/12/2003 | 7/22/2003 | PLAN SHEET | 12 |
| | BEAISION | BEAISION | REVISION | REVISION | REVISION | BEAISION | I BEVISION | OFR ∃TAO | SHEET TITLE | NO. |

| 111111111111111111111111111111111111111 | Ley_summary.sum |
|---|--------------------------|
| REVISION SUMMARY | Ейепате : |
| INDEX OF SHEETS | |
| HALEIGH | Document Control Number: |
| DEPARTMENT OF TRANSPORTATION NET ARMONDALIAM DEPARTMENT OF TRANSPORTATION | CHECKED BY: DATE: |

| ONDWAY DESIGN ENGINEER | Я |
|---|----|
| 0-2/-2/11/11/11/11/11/11/11/11/11/11/11/11/11 | |
| S DOOR | _ |
| NI ST. ST. NI SI | |
| \$ DONCE 18 2 2 2 2 2 2 2 2 2 2 2 2 2 2 2 2 2 2 | = |
| I X JMAC IIII | |
| Thousand The Control of the Control | ₹′ |
| 11/1/1/1/1/1/1/1/1/1/1/1/1/1/1/1/1/1/1/1 | ŕ |
| LANGE CAROLL | |
| - Millings | |

| DESCRIPTION OF REVISION | :3TAG | : 78 | ON |
|--------------------------|----------|------|----|
| RELEASE FOR CONSTRUCTION | 1/22/03 | 838 | 0 |
| REVISIONS | 11/15/03 | REB | L |
| BEAISIONS | 15/16/03 | REB | Z |
| REUSIONS | 74/21/2 | | 3 |
| | , , | | 9 |
| | | | 9 |



DATE: 12-16-03 KELEASE FOR CONSTRUCTION P-2547BB REV_BB-4
PROJECT REFERENCE NO.

INDEX OF SHEETS AND REVISION SUMMARY

DEPARTMENT OF TRANSPORTATION

RALEIGH

RALEIGH

KENIZION ZOMWYKK

| \$ \$882771 \$882771 \$882771 \$882771 \$90138 \$9020 \$1504 \$ | | | | 1 | | | | | | | |
|---|--|----------|----------|----------|----------|----------|----------|-------------|--------------------|---------------------|--------------|
| SIRECTAIN SIRE | | | | | | | | 11/12/2003 | 7/22/2003 | CBOSS SECTIONS | 9-X |
| | | | | | | | | 11/12/2003 | 7/22/2 00 3 | CROSS SECTIONS | Y-2 |
| Section Sect | | | | | | | | 11/15/2003 | 7/22/2003 | CBOSS SECTIONS | ≯- X |
| SHEATER SHEA | | | | | | | | 12/3/2003 | 5003/22/T | CBOSS SECTIONS | X-3 |
| Company Comp | | | | | | | | 12/3/2003 | 7/22/2003 | CBOSS SECTIONS | Z-X |
| 97 SERVICE SER | | | | | | | | 12/3/2003 | 7/22/2003 | CHOSS SECTIONS | I-X |
| 19 19 19 19 19 19 19 19 | | | | | | | | | 7/22/2003 | CBOSS SECTION INDEX | |
| Second S | | | | | | | | | 7/22/2003 | | |
| Seed | | | | | | | | | 7/22/2003 | | |
| BHOLITE 1/55/5883 | | | | | | | | | 7/22/2003 | | |
| Bedelite 1/157/5883 1/157 | | | | | | | | | 7/22/2003 | | |
| Part | | | | | | | | | 7/22/2003 | | |
| Post (Proposition of the control of the co | | | | | | | | | 7/22/2003 | | |
| 2. | | | | | | | | | 7/22/2003 | | |
| 26 bb0clife 1/1575993 | | | | | | | | | | | - |
| Part | | | | | | | | | | | |
| Fe block of the bl | | | | | | | | | | | |
| Part | AND CONTRACTOR | | | | | | | | | | |
| 23 BODLITE 1/55/5003 BODLITE 1/55/ | | | | | | | | \$007/71/II | | | |
| 27 BUDLITE 1/55/5003 Part Par | | | | | | | | CDBC/CI/II | | | |
| 20 | 3 1 4 4 1 1 1 | | | | | | | | | | |
| 4θ | | | | | | | | | | | ĮŞ |
| 48 | | | | | | | | | | | 20 |
| 4) BROFILE 7/22/2003 (A) PATE 1/22/2003 (B) PATE 1/22/2003 (COMMENTS) (COMMENTS) (COMMENTS) | The second secon | | | | | | | | | | 64 |
| NO. DATE 1 2 3 4 5 6 7 COMMENTS NO. DATE 1 2 3 4 5 6 7 COMMENTS NO. COMMENTS | | | | | | | | | | | 84 |
| NO. REVISION REVISION REVISION REVISION PRIVIOUS REVISION DEVISION | COMMENTS | L | 9 | g | | 3 | 7 | T | | PROFILE | L Þ |
| | 52.12.14100 | REVISION | REVISION | REVISION | REVISION | BEVISION | REVISION | REVISION | 23A 3TAΩ | SHEET TITLE | NO. SHEET |



Lev_summary.sum

CHECKED BA:

_:YB WWARG

_ :3TAQ _

- DATE: -

| KEVISIONS | | | _ |
|--------------------------|----------|--------|----|
| | | | S |
| | | | 3 |
| REVISIONS | 12/16/03 | REB | 8 |
| BEAISIONS | 12/3/03 | 838 | 8 |
| REVISIONS | 11/15/03 | REB | ß |
| RELEASE FOR CONSTRUCTION | 1/22/03 | 838 | 0 |
| DESCRIPTION OF REVISION | :3TAG | : \/ 8 | -0 |

| Chiororycon | | | |
|--------------------------|----------|-----|-----|
| | | | 9 |
| | | | 13 |
| BEAIZIONZ | 15\16\03 | REB | 8 |
| BEAISIONS | 12/3/03 | 838 | 2 |
| BEAIZIONS | 11/15/03 | REB | լ |
| RELEASE FOR CONSTRUCTION | T/22/03 | 838 | 0 |
| DESCRIPTION OF REVISION | :3TAG | :YB | -01 |

| :3TAG | : 78 | ON |
|----------|----------|------------------------------|
| 1/22/03 | 838 | 0 |
| 11/15/03 | 838 | L |
| 12/3/03 | 838 | 3 |
| 12/16/03 | REB | 8 |
| | | 1 |
| | | 9 |
| | 17/22/03 | REB 17/12/03 REB 11/12/03 |

| DESCRIPTION OF REVISION | :3TAG | : 78 | ON | |
|--------------------------|----------|------|----|---|
| RELEASE FOR CONSTRUCTION | 1/22/03 | 838 | 0 | ı |
| REVISIONS | 11/15/03 | REB | J. | İ |
| BEAISIONS | 15/3/03 | 838 | 2 | |
| BEAIZIONZ | 12/16/03 | REB | 8 | |
| | | | 1 | |
| | | | 9 | |
| Chicachter | | | _ | |

| 1/22/03 | 838 | 0 | D LOSON DOUGO OF |
|----------|----------|--------------|--|
| 11/15/03 | REB | L. | <u>sionstructors</u> |
| 15/3/03 | 838 | 2 | |
| 15\16\03 | REB | 8 | |
| | | 1 | |
| | | 9 | |
| | 11/15/02 | REB 11/15/03 | ### BEB 11/15/03 ### BEB 15/16/03 ### BE |

| THE LPA GROUP Of North Caroling p.g. 4904 Professional Carolina 21609 Radelah North Carolina 21609 |
|--|

NOTER GREDING

| 141 | RELEASE FOR COM: | |
|----------|-----------------------|-----------|
| | | A 111 |
| 9-88-V3A | 88 <i>1</i> 4188 | WAETRICES |
| SHEEL NO | PROJECT REFERENCE NO. | |

KEAISION RAWWYKK

| | | | | | | | | 11/12/2003 | | |
|----------|---------------|---------------|---------------|---------------|----------|----------|------------|------------|----------------|--------------|
| | | | | | | | 0.0007 (| | CROSS SECTIONS | X-24A |
| | | | | | | | 11/12/2003 | 7/22/2003 | CROSS SECTIONS | ≯Z-X |
| | | | | | | | 12/3/2003 | 7/22/2003 | CROSS SECTIONS | X-23 |
| | | | | | | | 12/3/2003 | 7/22/2003 | CROSS SECTIONS | X-22 |
| | | | | | | | 12/3/2003 | 7/22/2003 | CROSS SECTIONS | IZ-X |
| | | | | | | | 12/3/2003 | 7/22/2003 | CROSS SECTIONS | X-20 |
| | | | | | | | 12/3/2003 | 7/22/2003 | CBOSS SECTIONS | 6I-X |
| | | | | | | | 12/3/2003 | 7/22/2003 | CBOSS SECTIONS | 8I-X |
| | | | | | | | 12/3/2003 | 7/22/2003 | CHOCS SECTIONS | |
| | | | | | | | 12/3/2003 | 7/22/2003 | CROSS SECTIONS | |
| | | | | | | | 12/3/2003 | 7/22/2003 | CROSS SECTIONS | 9I-X |
| | | | | | | | 12/3/2003 | 7/22/2003 | | GI-X |
| | | | | | | | | 7/22/2003 | CBOSS SECTIONS | ≯I-X |
| | | | | | | | | | CROSS SECTIONS | £1-X |
| | | | | | | | | 7/22/2003 | CROSS SECTIONS | X-12 |
| | | | | | | | | 11/12/2003 | CBOSS SECTIONS | AII-X |
| | | | | | | | 11/12/2003 | 7/22/2003 | CROSS SECTIONS | II-X |
| | | | | | | | | 11/12/2003 | CROSS SECTIONS | ₩1-X |
| | | | | | | | 11/12/2003 | 7/22/2003 | CROSS SECTIONS | ØI-X |
| | | | | | | | | 11/12/2003 | CROSS SECTIONS | A6-X |
| 7.2 | | | | | | | 11/12/2003 | 7/22/2003 | CROSS SECTIONS | 6-X |
| | | | | | | | | 7/22/2003 | CROSS SECTIONS | 8-X |
| | | | | | | | | 11/12/2003 | CROSS SECTIONS | 8Z-X |
| | | | | | | | | 11/12/2003 | CROSS SECTIONS | AT-X |
| | | | | | | | 11/12/2003 | 7/22/2003 | CBOSS SECTIONS | |
| | | | | | | | | 11/12/2003 | | Z-X |
| СОММЕИТЅ | \ BENIZION | e KEAISION | 2 BEAISION | KEVISION 4 | 3 | 2 | Ţ. | 3TAU | CROSS SECTIONS | ₩9-X |
| | | | DEVICEOUS | BEVISION | REVISION | BEAISION | KEAISION | SPFC | SHEET TITLE | NO. SHEET |
| | | | | | | | | | | |

| רפע_summary.sum | |
|---------------------------|--|
| ыны ВЕЛІ | TAMMASUMAREY YAMMASUMANA |
| | INDEX OF SHEETS |
| Document Control Number : | 10777744 |
| | DEPARTMENT OF TRANSPORTATION NELECT OF TRANSPORTATION |
| ya Mamaan | |

| ENCINEEE | DEZICM | YAWQAOA |
|-------------------|--------------|------------|
| 13/12/ | 11111177 | 1. |
| 000 | a s | 1279 |
| 11,1000 | IN MET ME | 14. |
| • • . | | |
| - <u>-</u> -;∕\ 8 | 288 4 | |
| آر بمراتي | \$€∀I | |
| LANO | , 1 | الم الم |
| | EESS, | 10/21 |
| 14,708 | AD H | OTHE |
| *1111 | 11111111 | 7 . |

| | | | 9 |
|--------------------------|----------|-----|----|
| | | | 1 |
| BEAIZIONZ | 15\16\03 | REB | 8 |
| BEAIZIONS | 12/3/03 | REB | 2 |
| BEAISIONS | 11/12/03 | REB | L |
| RELEASE FOR CONSTRUCTION | 7/22/03 | REB | 0 |
| DESCRIPTION OF REVISION | :3TAG | :48 | 10 |



| | Којејоћ, ио⊏тћ | | HOLTATROSEMAR |
|--------------|-------------------|-----|---------------|
| lorth Caroll | A to quogo Aql | 3HT | A9J |
| Court, Sulte | Ionolesetord F00P | | 9UORS |

| 334.5 | RELEASE FOR CONS | |
|-------------------|-------------------------------|---------|
| | | AL -JUL |
| 9-88- <i>N</i> 38 | 88 <i>1</i> 5 27–8 | WETRICE |
| SHEET NO. | PROJECT REFERENCE NO. | |

KEAISION 20MWARK

| | 12/3/2003 | 7/22/2003 | CBOSS SECTIONS | 9 > -X |
|---|------------|---------------------|----------------|------------------|
| | 12/3/2003 | EØØZ/ZZ/L | CBOSS SECTIONS | ⊆ Þ-X |
| | 12/3/2003 | 7/22/2003 | CBOSS SECTIONS | ₽₽- X |
| | | 7/22/2003 | CBOSS SECTIONS | X-43 |
| | | 5 00 2/22/7 | CROSS SECTIONS | ZÞ-X |
| | | 7/22/2003 | CROSS SECTIONS | I+-X |
| | | 7/22/2003 | CROSS SECTIONS | ØÞ-X |
| | | 7/22/2003 | CROSS SECTIONS | 6E-X |
| | | 7/22/2003 | CROSS SECTIONS | X-38 |
| | | 7/22/2003 | CROSS SECTIONS | ZE-X |
| | | 7/22/2003 | CROSS SECTIONS | 9E-X |
| | | 7/22/2003 | CROSS SECTIONS | 98-X |
| | | 7/22/2003 | CROSS SECTIONS | 7-34 |
| | | 7/22/2003 | CROSS SECTIONS | X-33 |
| | | 7/22/2003 | CROSS SECTIONS | X-32 |
| | 12/3/2003 | 7/22/2003 | CBOSS SECTIONS | 12-X |
| | | 11/12/2003 | CROSS SECTIONS | X-30B |
| | | 11/12/2003 | CBOSS SECTIONS | ₩2-X |
| 12/3/2003 | 11/12/2003 | 7/22/2003 | CROSS SECTIONS | ØE-X |
| | | 7/22/2003 | CBOSS SECTIONS | 6Z-X |
| | | 7/22/2003 | CROSS SECTIONS | X-28 |
| | | 7/22/2003 | CROSS SECTIONS | 72-X |
| | | 7/22/2 00 3 | CROSS SECTIONS | 9Z-X |
| | | 7/22/2003 | CROSS SECTIONS | X-25 |
| | | | | |
| S 3 4 P P P P P P P P P P P P P P P P P P | I | RFC DATE II/I2/2003 | CROSS SECTIONS | X-24B |

| YDMYA DEZICH ENCINEER | ВС |
|--|------|
| Jell 1/2/ 188888- | |
| 2 05-16 | |
| S DONE STATE OF STATE | |
| | |
| 33N191 1 | ٠, ١ |
| | 5 |
| E - \$ 8588 | 3 |
| | = |
| : /\REW : : | 3/ |
| = /: A/ D/X2: | |
| CAROLINA CAROLINA | S |
| SS33. A | • |
| 1811 | |
| MY CAROLLI | |
| MINIMA | |
| | |

| KEAISIONS | | | |
|--------------------------|----------|-----|----|
| | | | 9 |
| | | | 1 |
| REVISIONS | 12/16/03 | REB | 8 |
| REVISIONS | 12/3/03 | REB | 2 |
| REVISIONS | 11/15/02 | REB | L. |
| RELEASE FOR CONSTRUCTION | 7/22/03 | REB | 0 |
| DESCRIPTION OF REVISION | :3TAG | :48 | 01 |

| | | | 9 | |
|--------------------------|----------|-----|----|-------------------------------|
| REVISIONS | 12/16/03 | REB | 8 | |
| REVISIONS | 12/3/03 | REB | 2 | |
| REVISIONS | 11/15/03 | REB | L | erth Carolina Constructors |
| RELEASE FOR CONSTRUCTION | 7/22/03 | 838 | 0 | C 10100 Douge Build the Wiles |
| DESCRIPTION OF REVISION | :3TAG | :48 | ON | |

| | ú |
|---|---|
| THE LPA GROUP Of North Coroling p.g. (GROUP of North Coroling p.g. 4904 Professional Court, Surfa 200 Transportation consultants (GROUP of North Coroling 21609 | |

| | Tev_summery.sum |
|------------------------------|--------------------------|
| REVISION SUMMARY | Ейенате : |
| INDEX OF SHEETS | |
| | Document Control Number: |
| RALEIGH | |
| DEPARTMENT OF TRANSPORTATION | CHECKED BX: DATE: |
| STATE OF MORTH CAROLINA | :YE DAANU |

North Carolina Constructors

THE LPA GROUP Of Worth Corolling, p.g.

PA POT Besigned Court, Suite 20

Releigh, worth Corolling Steps

Releigh, worth Corolling Steps

| | CNOTOTATOL | | | |
|---|--------------------------|----------|-----|----|
| _ | | | | 9 |
| _ | | | | 1 |
| _ | REVISIONS | 15/16/03 | REB | 8 |
| _ | BEAISIONS | 12/3/03 | 838 | 2 |
| _ | REVISIONS | 11/15/03 | REB | L |
| _ | RELEASE FOR CONSTRUCTION | 7/22/03 | REB | 0 |
| _ | DESCRIPTION OF REVISION | :3TAG | :78 | ON |

| | KEVISIONS | | | |
|---|--------------------------|----------|-----|----|
| | | | | 2 |
| | | | | 0 |
| | BEAISIONS | 15\16\03 | REB | 8 |
| | BEAISIONS | 12/3/03 | REB | 3 |
| | BEAIZIONZ | 11/15/03 | REB | ß |
| | RELEASE FOR CONSTRUCTION | 7/22/03 | REB | Q |
| _ | DESCRIPTION OF REVISION | :3TAG | :48 | 70 |

| | - |
|-----|-----|
| | t |
| | t |
| REB | İ |
| 83H | Ī |
| BEB | Ī |
| 838 | |
| ΥB | ŀ |
| | :Y8 |

| | ENCINEER | DEZICN | YAWQAOA | |
|----|----------|--------|--------------|---|
| 2, | 1.1/21 | 111117 | 7 a . | |
| 1 | 1100 | a s a | * Marie | |
| | | NIÓ | 199 | |
| 3 | . 1/83 | 21 | | |
| : | -: /\ B | 288°Z | Var. | 1 |
| | *\ | /PEXI | 1 : = | j |
| Ę | 1:4 | - 3// | | ı |
| 1 | ·/ ·**Wo | - W | X: /> | |

| | ENGTNEER | DESTGN | ΥA |
|-------|----------|-------------|---------|
| 32 | 12/2/11 | S Z | ı,, |
| - / | 0,00 | - 10 | **/ |
| 11 | | Ç INE | 1 |
| IIIII | 17/19 | 5854 | |
| 11111 | | \bekal | , `o |
| | a sitto | 1663 | Ç |

rev_summary.sum

| | KENIZION ZNWWARK |
|--------------------------|--------------------------------|
| јепате : | UNA VGAMMI2 MOTZIVAG |
| | INDEX OF SHEETS |
| ocument Control Number : | |
| ECKED BA: DATE: | DETATAO92NART OF TRANSPORTATIO |
| DAIE: | ANTICHURIN CANCELIA |

| | | | | | | | 12/3/2003 | 7/22/2003 | CBOSS SECTIONS | ī∠-X |
|--|----------|----------|---------------|----------|---------------|---------------|---------------|-------------|----------------|------------------|
| | | | | | | | 12/3/2003 | 7/22/2003 | CBOSS SECTIONS | 0L-X |
| | | | | | | | 12/3/2003 | 7/22/2003 | CBOSS SECTIONS | 69-X |
| | | | | | | | 12/3/2003 | 7/22/2003 | CROSS SECTIONS | 89-X |
| | | | | | | | 12/3/2003 | 7/22/2003 | CBOSS SECTIONS | ∠9-X |
| | | | | | | | | 7/22/2003 | CROSS SECTIONS | 99-X |
| | | | | | | | | 7/22/2003 | CROSS SECTIONS | |
| | | | | | | | | 7/22/2003 | CROSS SECTIONS | 9-X |
| | | | | | | | | 7/22/2003 | | 19 -X |
| | | | | | | | 12/3/2003 | 7/22/2003 | CROSS SECTIONS | £9-X |
| | | | | | | | 15/3/5003 | 7/22/2003 | CROSS SECTIONS | Z9-X |
| | | | | | | | 15/3/5003 | | CBOSS SECTIONS | 19-X |
| | | | | | | | 2002/2/21 | 7/22/2003 | CROSS SECTIONS | Ø9-X |
| | | | | | | | | 7/22/2003 | CHOSS SECTIONS | 6 G -X |
| | | | | | | | | 7/22/2003 | CROSS SECTIONS | 8G-X |
| | | | | | | | | 7/22/2003 | CROSS SECTIONS | ZG-X |
| | | | | | | | | 7/22/2003 | CROSS SECTIONS | 9 9- X |
| Company of the Compan | | | | | | | 12/3/2003 | 7/22/2003 | CROSS SECTIONS | X-22 |
| and the second s | | | | | | | 12/3/2003 | 7/22/2003 | CROSS SECTIONS | ≯ 9−X |
| | | | | | | | 12/3/2003 | 7/22/2003 | CROSS SECTIONS | X-23 |
| | | | | | | | 12/3/2003 | 7/22/2003 | CBOSS SECTIONS | Z9-X |
| | | | | | | | 12/3/2003 | 7/22/2003 | CROSS SECTIONS | IG-X |
| | | | | | | | | 7/22/2003 | CROSS SECTIONS | Ø9-X |
| Company of the Compan | | | | | | | | 7/22/2003 | CBOSS SECTIONS | 6 7 -X |
| | | | | | | | | 7/22/2003 | CBOSS SECTIONS | 8 7- X |
| | | | | | | | 12/3/2003 | 7/22/2003 | CBOSS SECTIONS | ∠ ⊅ −X |
| СОММЕИТЅ | REVISION | BEVISION | P BEAISION | BEAISION | 3 BEAISION | S BEAIRION | I BEAISION | RFC DATE | SHEET TITLE | NO" SHEEL |

KENIZION ZOMWYKK

DATE: 12-16-03 KELEASE FOR CONSTRUCTION U−SQ41BB VEATBB−7

PROJECT REFERENCE NO. SHEET NO.

| F 200 | RELEASE FOR CONS | |
|-----------|-----------------------|----------|
| 0.00=1711 | | |
| BFV BB-8 | 88 <i>1</i> +97-8 | MATTRICA |
| SHEET NO. | PROJECT REFERENCE NO. | |

KEVISION SUMMARY

| | 12/3/2003 | 7/22/2003 | CROSS SECTIONS | Z6-X |
|---|-----------|--------------------|----------------|--------------|
| | 12/3/2003 | 7/22/2003 | CROSS SECTIONS | 96-X |
| | 12/3/2003 | 7/22/2003 | CROSS SECTIONS | 96-X |
| | 12/3/2003 | 7/22/2003 | CROSS SECTIONS | ≯6- X |
| | 12/3/2003 | 7/22/2003 | CROSS SECTIONS | £6-X |
| | | 7/22/2003 | CROSS SECTIONS | Z6-X |
| | | 7/22/2003 | CHOSS SECTIONS | 16-X |
| | | E 00 Z/ZZ/L | CHOSS SECTIONS | Ø6-X |
| | | 7/22/2003 | CBOSS SECTIONS | 68-X |
| | | 7/22/2003 | CHOSS SECTIONS | 88-X |
| | | 7/22/2003 | CHOSS SECTIONS | 98-X |
| | | 7/22/2003 | CHOSS SECTIONS | 98-X |
| | | 7/22/2003 | CEOSS SECTIONS | ₽8-X |
| | | 7/22/2003 | CEOSS SECTIONS | |
| | | 7/22/2003 | CBOSS SECTIONS | X-83 |
| | | 7/22/2003 | CBOSS SECTIONS | Z8-X |
| | | 7/22/2003 | CROSS SECTIONS | 18-X |
| | | 7/22/2003 | | Ø8-X |
| | | 7/22/2003 | CBOSS SECTIONS | 6Z-X |
| | | 7/22/2003 | CKOSS SECTIONS | 8Z-X |
| | | 7/22/2003 | CBOSS SECTIONS | ZZ-X |
| | | 7/22/2003 | CBOSS SECTIONS | 9L-X |
| | | 7/22/2003 | CROSS SECTIONS | GZ-X |
| | | | CROSS SECTIONS | ₽ ∠-X |
| | | 7/22/2003 | CROSS SECTIONS | £7-X |
| S 3 4 2 COWMENTS | | DATE 7/22/2003 | CROSS SECTIONS | ZL-X |
| BEAIZION BEAIZION BEAIZION BEAIZION BEAIZION BEAIZION | REVISION | DAR 3100 | SHEET TITLE | NO. SHEET |



| KEAISIONS | | | |
|--------------------------|----------|-----|-----|
| | | | 9 |
| | | | 1 |
| BEAIZIONZ | 12/16/03 | REB | 8 |
| BEAIZIONS | 12/3/03 | REB | 2 |
| BEAIZIONZ | 11/12/03 | REB | B |
| RELEASE FOR CONSTRUCTION | 7/22/03 | 838 | 0 |
| DESCRIPTION OF REVISION | :3TAO | :48 | -01 |



| LPA GROUP of North Caroling, 1904 Professionalcourt, Sulte 204 Raielgh, North Carolina 21609 | THE AGUONS CONSULTINE STRANSPORTED TO CONSULTINE STRANSPORTED TO CONSULT THE STRANSPORTED THE STRANSPORTED TO CONS |
|--|--|
|--|--|


| EICH | |
|----------------|--------------|
| NOITATAO92NAAT | FPARTMENT OF |
| ANIL CAROLINA | STATE OF NO |

| rev_summary.sum | |
|--------------------------|--------------------------|
| Ейспате : | AND YAAMUS NOISIVAA |
| | INDEX OF SHEETS |
| Document Control Number: | RALEIGH |
| CHECKED BX: DATE: | DEPARTMENT OF TRANSPORTA |

DATE: 12-16-03 RELEASE FOR CONSTRUCTION W-SP47BB REFT NO. SHEET NO.

KENIZION ZOMWYKK

| | ĺ | 1 | i | | | 1 | | | | 20. N |
|--|---------------|---------|---------------|------------|---------------|----------|----------|-------------|----------------|---------------|
| | | | | | | | | 7/22/2003 | CBOSS SECTIONS | 611-X |
| | | | | | | | | 7/22/2003 | CROSS SECTIONS | X-118 |
| | | | | | | | | 7/22/2003 | CROSS SECTIONS | ∠II-X |
| | | | | | | | | 7/22/2003 | CROSS SECTIONS | 9II-X |
| | | | | | | | | 7/22/2003 | CROSS SECTIONS | SII-X |
| | | | | | | | | 7/22/2003 | CROSS SECTIONS | ≯ II-X |
| | | | | | | | | 7/22/2003 | CB02S SECTIONS | X-113 |
| | | | | | | | | 7/22/2003 | CBOSS SECTIONS | X-IIZ |
| | | | | | | | | 7/22/2003 | CBOSS SECTIONS | III-X |
| | | | | | | | | 7/22/2003 | CBOSS SECTIONS | III-X |
| | | | | | | | | 7/22/2003 | CROSS SECTIONS | Ø11-X |
| | | | | | | | | 7/22/2003 | CROSS SECTIONS | 6ØI-X |
| | | | | | | | | 2/22/2003 | CROSS SECTIONS | X-108 |
| | | | | | | | | 2/22/2003 | CBOSS SECTIONS | 701-X |
| nerth . | | | | | | | | 7/22/2003 | CBOSS SECTIONS | 9ØI-X |
| , The state of the | | | | | | | | 7/22/2003 | CBOSS SECTIONS | 901-X |
| Company of the Compan | | | | | | | | 7/22/2003 | CBOSS SECTIONS | 701-X |
| | | | | | | | | 7/22/2003 | CHOSS SECTIONS | X-103 |
| | | | | | | | | 7/22/2003 | CHOOS SECTIONS | Z0I-X |
| | | | | | | | | 7/22/2003 | CBOSS SECTIONS | 101-X |
| | | | | | | | | 7/22/2003 | CBOSS SECTIONS | ØØI-X |
| | | | | | | | | 7/22/2003 | CBOSS SECTIONS | 66-X |
| | | | | | | | | 7/22/2003 | CBOSS SECTIONS | |
| COWWENTS | ∆ BEAISION | EAISION | P BEVISION | REVISION 4 | 3 BEAISION | Z | I | AFC DATE | | 96-X |
| | | | | | 10101/130 | BEAISION | BEAISION |) JA8 | SHEET TITLE | SHEET |

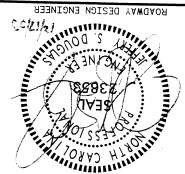

| | DESCRIPTION OF REVISION |
|---|-------------------------|
| | EASE FOR CONSTRUCTION |
| | REVISIONS |
| | BEAIZIONZ |
| | |
| | |
| | |
| | SNOISIA |
| _ | |

| DESCRIPTION OF REVISION | :3TAO | :78 |
|--------------------------|----------|-----|
| RELEASE FOR CONSTRUCTION | 7/22/03 | REB |
| BEAISIONS | 11/15/03 | REB |
| BEAIZIONZ | 12/16/03 | REB |
| | | |
| | | |
| | | |

| DESCRIPTION OF REVISION | :3TAO | :Y8 | ON | |
|--------------------------|----------|-----|----|---------------|
| RELEASE FOR CONSTRUCTION | 7/22/03 | REB | 0 | |
| REVISIONS | 11/12/03 | REB | ß | SJOJON SJOJON |
| BEAIZIONZ | 12/16/03 | 838 | 2 | |
| | | | 8 | |
| | | | 9 | |
| | | | 9 | |

7/22/2003

7/22/2003

| <u>saotaurisno</u> | S snilors3 dtro | Ņ |
|--------------------|-----------------|---|
| | ORE | |
| | | |

CROSS SECTIONS

CROSS SECTIONS

THE LPA GROUP OF WORTH Corolling, p.g. 3ROUP PT 1880160 Corolling 27609 Redelon Worth Corolling 27609 Redelon Worth Corolling 27609

X-151

X-1S0

STATE OF TRANSPORTATION

RALEIGH

RALEIGH

Lev_summary.sum

_ :3TAQ _

CHECKED BA:

-:YB NWARC

REVISION SUMMARY

DATE: 12-16-03 RELEASE FOR CONSTRUCTION HOTECT REFERENCE NO. SHEET NO.

INDEX OF SHEETS AND REVISION SUMMARY

DEPARTMENT OF TRANSPORTATION

RALEIGH

RALEIGH

KEAISION SOMWYKK

| : careroo | BEAISION | REVISION | KEAISION | REVISION | BEAISION | BEAISION | FVISION | AFC ∃TAΩ | SHEET TITLE | SHEET NO. |
|--|----------|----------|----------|----------|----------|----------|------------|-------------|----------------|-----------|
| COMMENTS | L | 9 | g | b | 3 | 2 | Ţ | 2//22/2003 | CBOSS SECTIONS | X-122 |
| The second secon | | | | | | | | 7/22/2003 | CROSS SECTIONS | X-123 |
| | | | | | | | | 7/22/2003 | CBOSS SECTIONS | X-124 |
| | | | | | | | | 7/22/2003 | CROSS SECTIONS | X-125 |
| | | | | | | | | 7/22/2003 | CROSS SECTIONS | X-126 |
| | | | | | | | 11/12/2003 | 7/22/2003 | CROSS SECTIONS | ZZI-X |
| And the second of the second o | | | | | | | | 11/12/2003 | CROSS SECTIONS | A7SI-X |
| e maranismos | | | | | | | 11/12/2003 | 7/22/2003 | CROSS SECTIONS | X-128 |
| | | | | | | | | 11/12/2003 | CROSS SECTIONS | X-128A |
| | | | | | | | | 7/22/2003 | CROSS SECTIONS | K-129 |
| | | | | | | | | 7/22/2003 | CROSS SECTIONS | W-130 |
| | | | | | | | | 7/22/2003 | CROSS SECTIONS | 151-X |
| | | | | | | | | 7/22/2003 | CROSS SECTIONS | X-13S |
| | | | | | | | | 7/22/2003 | CROSS SECTIONS | X-133 |
| | | | | | | | | 7/22/2003 | CROSS SECTIONS | X-134 |
| | | | | | | | | 7/22/2003 | CBOSS SECTIONS | X-132 |
| | | | | | | | | 7/22/2003 | CBOSS SECTIONS | 9EI-X |
| | | | | | | | | 7/22/2003 | CHOSS SECTIONS | 7ε1-X |
| | | | | | | | | 7/22/2003 | CHOSS SECTIONS | X-138 |
| | | | | | | | | 7/22/2003 | CHOSS SECTIONS | 451-X |
| | | | | | | | | 7/22/2003 | CHOSS SECTIONS | 0+I-X |
| | | | | | | | | 7/22/2003 | CHOSS SECTIONS | I+I-X |
| | | | | | | | | 7/22/2003 | CBOSS SECTIONS | X-142 |
| | | | | | | | | 7/22/2003 | CBOSS SECTIONS | X-143 |
| | | | | | | | | 7/22/2003 | CHOSS SECTIONS | 7-144 |

| | 1177117017 | | |
|-----|--------------|---|--|
| 1 | ENCINEER | DEZICM | YAWQAOP |
| | | | |

Lev_summary.sum

- PATE: -

_ :3TAQ _

Document Control Number :

CHECKED BA:

| DESCRIBLION OF REVISION RELEASE FOR CONSTRUCTION REVISIONS | - |
|--|----|
| BEAIZIONS | 1 |
| | 15 |
| BEVISIONS | |
| | 1 |
| | t |
| | T |
| | Ť |
| KEAISIONS | _ |

| Chlorerienz | | | |
|------------------------------|----------|-----|-----|
| | | | 8 |
| | | | 1 |
| | | | 8 |
| BEAISIONS | 15\16\03 | 838 | 2 |
| BEAISIONS | 11/15/03 | REB | ß |
| RELEASE FOR CONSTRUCTION | 7/22/03 | REB | 0 |
| DESCRIPTION OF REVISION | :3TAO | :78 | 101 |

| DESCRIPTION OF REVISION | :3TAO | :78 | ON | |
|--------------------------|----------|-----|----|-----------------------------------|
| RELEASE FOR CONSTRUCTION | 7/22/03 | REB | 0 | |
| REVISIONS | 11/15/03 | BEB | ß | Rorth Carolina Constructors dirow |
| BEAISIONS | 15/16/03 | 838 | 2 | |
| | | | 8 | |
| | | | 9 | |
| | | | 9 | |
| KEAISIONS | | | | |

| Ī | | LPA GROUP of Worth Coroling, p.g. 4904 Professional Court, Suite 201 Raleigh, Worth Coroling 27609 | HT AND AND AND AND AND AND AND AND AND AND |
|---|--|--|--|

| 4000 | DATE: 12–16– | |
|-----------|-----------------------|------------|
| | | AL JIL |
| HEV_BB-II | 887 2 5-7 | MATERICES! |
| SHEET NO. | PROJECT REFERENCE NO. | |

DEPARTMENT OF TRANSPORTATION

RALEIGH

KENIZION ZOMWYKK

| | DEVICION | REVISION | REVISION | KEAISION | REVISION | SEAISION S | I BEAISION | PFC DATE | SHEET TITLE | NO. SHEET |
|--|------------|----------|----------|----------|----------|------------|---------------|-------------|----------------|-----------------|
| COMMENTS | VEVISION T | 9 | g | b | 3 | 7 | Ţ | 2/\22\2003 | CBOSS SECTIONS | X-145 |
| | | | | | | | | 7/22/2003 | CHOSS SECTIONS | 9 † I-X |
| | | | | | | | | 7/22/2003 | CBOSS SECTIONS | ∠≯ I−X |
| | | | | | | | | 7/22/2003 | CBOSS SECTIONS | X-148 |
| | | | | | | | | 7/22/2003 | CBOSS SECTIONS | 6 + I-X |
| | | | | | | | | 7/22/2003 | CBOSS SECTIONS | X-120 |
| ************************************** | | | | | | | | 7/22/2003 | CBOSS SECTIONS | X-151 |
| | | | | | | | | 7/22/2003 | CBOSS SECTIONS | ZGI-X |
| and the second | | | | | | | | 7/22/2003 | CROSS SECTIONS | X-153 |
| | | | | | | | | 11/12/2003 | CROSS SECTIONS | ¥251-X |
| | | | | | | | 11/12/2003 | 7/22/2003 | CROSS SECTIONS | 7-154 |
| | | | | | | | | 11/12/2003 | CROSS SECTIONS | X-154A |
| | | | | | | | | 7/22/2003 | CROSS SECTIONS | X-122 |
| | | | | | | | | 7/22/2003 | CROSS SECTIONS | 9 G I-X |
| | | | | | | | 11/12/2003 | 7/22/2003 | CROSS SECTIONS | ∠9 I −X |
| | | | | | | | | 11/12/2003 | CROSS SECTIONS | ₩ZGI-X |
| | | | | | | | | 7/22/2003 | CBOSS SECTIONS | X-158 |
| | | | | | | | 11/12/2003 | 7/22/2003 | CBOSS SECTIONS | 69I-X |
| | | | | | | | | 11/12/2003 | CROSS SECTIONS | ∀6 ⊆ I-X |
| | | | | | | | | 7/22/2003 | CROSS SECTIONS | Ø91-X |
| | | | | | | | | 7/22/2003 | CROSS SECTIONS | [9I-X |
| | | | | | | | | 7/22/2003 | CROSS SECTIONS | X-162 |
| | | | | | | | | 7/22/2003 | CROSS SECTIONS | X-163 |
| | | | | | | | | 7/22/2003 | CHOSS SECTIONS | ≯9I-X |
| | | | | | | 100 | | 7/22/2003 | CROSS SECTIONS | X-165 |

| ROADWAY DESIGN ENGINEER | |
|--|--|
| 21/21 | |
| S DOGOTE | |
| | |
| S S S S S S S S S S S S S S S S S S S | |
| | |
| £3882 1 | |
| | |
| 1 1 2 1 2 1 E | |
| 10/SS340. | |
| THE CAROLIN | |
| LANGTH CAROL | |
| TO CERSON OF THE PROPERTY OF T | |
| | |

Tev_summary.sum

CHECKED BA:

_ :3TAO _

- :3TAO -

| REVISIONS | | | - |
|--------------------------|----------|-----|-----|
| | | | Q |
| | | | 1 |
| | | | 8 |
| REVISIONS | 12/16/03 | 838 | 2 |
| REVISIONS | 11/15/03 | REB | J. |
| RELEASE FOR CONSTRUCTION | 7/22/03 | 838 | O |
| DESCRIPTION OF REVISION | :3TAO I | :78 | roi |

| DESCRIPTION OF REVISION | :3TAO I | :78 | FON | |
|--------------------------|----------|-----|-----|----------------------------|
| RELEASE FOR CONSTRUCTION | 1/22/03 | 838 | 0 | |
| WEAIZIONS | 11/15/03 | REB | I, | erth Carolina Constructors |
| REVISIONS | 12/16/03 | 838 | 2 | |
| | | | 8 | |
| | | | 1 | |
| | | | 9 | |
| REVISIONS | | | | |

| | Rabelgh, North Carolina 27609 | REPORTATION CONSULTANTS |
|-----|-----------------------------------|-------------------------|
| UUR | LPA GROUP of North Carolina, p.a. | 3HT A9.1 A9.1 A∪C |

| A TALL | DVIE: 13-19- | |
|------------|--|---------|
| 71.00-1711 | All the second of the second o | A IVI |
| RFV BB-12 | 897 7 22-8 | METPICA |
| SHEET NO. | PROJECT REFERENCE NO. | |

INDEX OF SHEETS AND REVISION SUMMARY

DEPARTMENT OF TRANSPORTATION

NALEIGH

RALEIGH

KEAISION 20MWARY

| | | | | | | | | 7/22/2003 | CBOSS SECTIONS | 621-X |
|-----------|----------|----------|---------------|---------------|---------------|---------------|----------|-------------|----------------|----------------|
| | | | | | | | | 7/22/2003 | CBOSS SECTIONS | 871-X |
| | | | | | | | | 7/22/2003 | CBOSS SECTIONS | 771-X |
| | | | | | | | | 7/22/2003 | CBOSS SECTIONS | 9/I-X |
| | | | | | | | | 7/22/2003 | CROSS SECTIONS | 9/1-X |
| | | | | | | | | 7/22/2003 | CBOSS SECTIONS | ≯∠I-X |
| 444, 4644 | | | | | | | | 7/22/2003 | CBO22 SECTIONS | £71-X |
| | | | | | | | | 7/22/2003 | CROSS SECTIONS | Z/1-X |
| | | | | | | | | 7/22/2003 | CHOSS SECTIONS | IZI-X |
| | | | | | | | | 7/22/2003 | CROSS SECTIONS | Ø71-X |
| 2.7 | | | | | | | | 7/22/2003 | CROSS SECTIONS | 691-X |
| | | | | | | | | 7/22/2003 | CROSS SECTIONS | 89I-X |
| | | | | | | | | 7/22/2003 | CKOSS SECTIONS | ∠9 1 -X |
| | L | 0 | | | | | | 7/22/2003 | CHOSS SECTIONS | 99I-X |
| COMMENTS | REVISION | PEAISION | 2 BEAISION | ₹ BEAISION | 3 BEAIRION | S BEAISION | BEVISION | RFC DATE | SHEET TITLE | NO. SHEET |

| ENCIŅEEK | DEZICM | YAWQAOA |
|----------------|-------------|-------------------------|

Tev_summary.sum

СНЕСКЕВ ВХ:

_:Y8 NWAR0

_ :3TAU _

_ :3TAQ _

| | DE BEVISION |
|---|-------------|
| | NOITOURT |
| | 51 |
| | |
| | |
| | |
| | |
| | |
| , | |
| | |

| DESCRIPTION OF REVISION | :3TAG | :YB | 7 |
|--------------------------|----------|-----|---|
| RELEASE FOR CONSTRUCTION | 11/15/03 | REB | 7 |
| BEAIZIONZ | 12/16/03 | REB | 1 |
| | | | 1 |
| | | | 1 |
| | | | 1 |
| | | | 7 |
| KEAISIONS | | | _ |

| DESCRIPTION OF REVISION | :3TAG | :78 |
|--------------------------|----------|-----|
| RELEASE FOR CONSTRUCTION | 11/15/03 | BEB |
| BEAIZIONZ | 12/16/03 | ВЗЯ |
| | | |
| | | |
| | | |
| | | |

| DESCRIPTION OF REVISION | :3TAG | :78 | ON | |
|--------------------------|----------|-----|----|----------|
| RELEASE FOR CONSTRUCTION | 11/15/03 | REB | 0 | |
| BEAIZIONZ | 12/16/03 | REB | ß. | 5 |
| | | | 2 | |
| | | | 8 | 8 |
| | | | 9 | \ |
| | | | 9 | <u> </u> |
| | | | | |

| DESCRIPTION OF REVISI | :3TAG | :YB | ON | |
|--------------------------|----------|-----|----|----------------------------|
| RELEASE FOR CONSTRUCTION | 11/15/03 | REB | 0 | |
| BEAIZIONZ | 12/16/03 | REB | L | erth corolina constructors |
| | | | 2 | |
| | | | 3 | |
| | | | 9 | |
| | | | 9 | |
| | | | | |

| N | LYA GHOUP OT NORTH, COPOUND, P.C., 4904 POTGRESSION COURT, SUITE 201 Robelgh, North Coroling 27609 |
|---|--|

| Roleigh, North Carolina 27609 | STNATJUZNO |
|------------------------------------|------------|
| 4904 Professional Court, Suite 201 | |
| LYA UKUUP OT NOFTIN COPONING, P. | JUL V |

DESCRIPTION OF REVISION NO. BY: DATE: RELEASE FOR CONSTRUCTION REB 7-22-03 RR 11-12-03

North Carolina Constructors

MILLED RUMBLE STRIPS WILL BE REQUIRED ON THE OUTSIDE AND MEDIAN SIDE

STATIONS AND OFFSETS FOR PIPES ON THE DRANAGE SUMMARY SHEETS

CROSS-SECTION PRIOR TO SETTING OF THE SLOPE STAKES FOR THE EMBANKMENT

THE GUARDRAL LOCATIONS SHOWN ON THE PLANS MAY BE ADJUSTED DURING

900mm RADIIOR RADII AS SHOWN ON THE PLANS. LOCATIONS OF DRIVES WILL

UNDERDRANS SHALL BE CONSTRUCTED IN ACCORDANCE WITH STD. NO. 815.03.

STREET RETURNS SHALL BE CONSTRUCTED IN ACCORDANCE WITH STD. NO. 848.04

DAINEWAYS SHALL BE CONSTRUCTED IN ACCORDANCE WITH STD. NO. 848.02 USING

BERM DITCHES SHALL BE CONSTRUCTED IN ACCORDANCE WITH STD. NO. 240.01 AT

CHADE SHOULDER SLOPES AND SUBGRADE SHOULDER SLOPES ON NORMAL CROWN

ALL CURVES ON THIS PROJECT SHALL BE SUPERELEVATED IN ACCORDANCE WITH

THE GRADE LINES SHOWN DENOTE THE FINISHED ELEVATION OF THE PROPOSED

FOLLOWING THE CLEARING OPERATIONS, INMEDIATELY SAUSTIVE AREAS, THE POLICY, BUILDER MY PERFORM CLEARING OPERATIONS, BUT HE STANDARD OPERATIONS UNTIL IMMEDIATELY PRIOR TO BEGINNING GRADING OPERATIONS. THE STREAM COR DEPRESSION), MEASURED FROM THE STREAM SOPERATIONS (NOTGENUBBING) SHALL BE ALLOWED IN THIS BUFFER THE STREAM COR DEPRESSION), MEASURED FROM THE STREAM SONE ON BOTH SIDES OF THE STREAM COR DEPRESSION, MEASURED FROM THE STREAM SONE OF THE STREAM

IN AREAS IDENTIFIED AS "ENVIRONMENTALLY SENSITNE AREAS", THE

AREA: THIS DESIGNATION REQUIRES SPECIAL PROCEDURES TO BE

THIS PROJECT IS LOCATED IN AN "ENVIRONMENTALLY SENSITIVE

CENERAL NOTES - METRIC

AND MULCHING AND STAGED SEEDING WITHIN THE PROJECT.



SUPERELEVATION IS TO BE REVOLVED ABOUT THE GRADE POINTS SHOWN

GRADE LINES MAY BE ADJUSTED AT THEIR BEGINNING AND ENDING AND AT OR FUTURE SURFACING AT GRADE POINTS SHOWN ON THE TYPICAL SECTIONS.

STRUCTURES IN ORDER TO SECURE A PROPER TIE-IN.

CLEARING ON THIS PROJECT SHALL BE PERFORMED TO THE

THE DESIGN/BUILDER WILL BE REQUIRED TO DO ALL NECESSARY WORK TO PROVIDE SUITABLE CONNECTIONS WITH ALL ROADS, STREETS, AND DRIVES ENTERING THIS PROJECT.

SECTIONS, SHALL BE MANTANED THROUGH SUPERELEVATED SHOULDER DEPTHS CONSISTENT).

STD. NO. 225.04 USING THE RATE OF SUPERELEVATION AND RUNOFF SHOWN ON THE PLANS.

ACCORDANCE WITH STD. NO. 560.01 OR 560.02. THE ALGEBRAIC DIFFERENCE, OF FINISHED SHOULDER CONSTRUCTION ON HIGH SIDE OF SUPERELEVATED CURVES SHALL BE IN

THE DESIGN/BUILDER SHALL CHECK THE STRUCTURE END BENT PLANS DETAILS, AND

ARE FROM EXISTING GROUND SURVEYS, DESIGN/BUILDER MAY NEED TO ADJUST LOCATIONS BASED EXISTING FIELD CONDITIONS.

ASPHALT PAVED SHOULDERS OF -L- (STD.DWG.665.01).

CONSTRUCTION. THE DESIGN/BUILDER SHOULD CONSULT WITH THE

OR EXCAVATION APROACHING A BRIDGE.

USING THE RADII NOTED ON THE PLANS.

BE AS SHOWN ON THE PLANS.

TOCATIONS SHOWN ON THE PLANS.

ON THE TYPICAL SECTIONS.

NWILLS ESTABUSHED BY METHOD III.

REVISIONS

ADDED 21, 2J & 2K TO INDEX

S DONOR SEVING S

OUTLETS AT 51+05 (ADDITIONAL 261); 52+30 (SN39); 53+40 (SN42); 54+92 (SN45); 56+64 (SN48) 06+12 OT 20+12 MOH-1

OUTLETS AT 36+60 (SN9); 37+70 (SNII); 38+70+/- (SNIS); 40+20 (SN20)

OUTLETS AT 32+20 (SN3); 33+47+/- (SN5); 33+70 (ADDITIONAL 261) FROM 31+00 TO 33+70 (BEGIN BRIDGE)

OUTLETS AT 60+80 (SNE6); 61+80 (SNE9); 62+30; 73+20; 73+20; 64+20; 65+20 (SN66); 66+60 (SN69); 67+31; 68+20; 69+20; 70+20; 71+20; 72+30; 73+20; 74+35 (SN78); 75+00; 09+98 OL 06+65 WOH +

FROM 58+55 TO 59+40

FROM 46+32 TO 51+10

OUTLET AT 41+20 (SN22A)

EROM 41+20 TO 41+70 (BEGIN BRIDGE)

EBL OUTSIDE SHOULDER DRAIN

(NOTE: 'SN'=STRUCTURE NUMBER) SHOULDER DRAINS:

UNDERCUT EXCAVATION IS EXPECTED ON -L- FROM STA.67+89 TO 68+87.

GENERAL--REVIEW THE ROADWAY FOUNDATION RECOMMENDATIONS FOR SPECIFIC RECOMMENDATIONS, INCLUDING THE FOLLOWING:

ROADWAY FOUNDATION RECOMMENDATIONS:

SEE SHEEL IB

IS BEING PROVIDED TO THE DESIGN/BUILDER. NOTE: THE ENTIRE UST OF THE "ROADWAY STANDARD DRAWINGS"

INDEX' CEN' NOTES, STDS

FINAL PLANS

KALEIGH DEPARTMENT OF TRANSPORTATION

STATE OF NORTH CAROLINA

hereby are considered a part of these plans: Dated January 15, 2002 are applicable to this project and by reference Highway Design Branch – N.C. Department of Transportation – Raleigh, N.C., Onted Indiana is 2009 are applicable to this are less to the contract of the contra The Following Roadway Standards as appear in "Roadway Standard Drawings"

ROADWAY METRIC STANDARD DRAWINGS

| CHOSS SECTIONS | 6Д-Х ПЯНТІ-Х |
|--|---|
| FINAL PLAN PROFILES | ₽9 NAHT ZE |
| INDEX, GENERAL NOTES, STANDARDS INDEX, GENERAL NOTES, STANDARDS (CONT'D) CONVENTIONAL SYMBOLS TYPICAL SECTIONS DITCH DETAIL OF CORRUGATED CONCRETE ISLAND DETAIL OF CORRUGATED SCOUR HOLE DETAIL OF CORRUGATED CONCRETE ISLAND DETAIL OF CORRUGATED CUNTER SYNGE SYNGE (NOTE: 21-23,25-28,31,32 NOTUSed) | IN IS IS SS SS SS AS AE ATHTNU 34 |
| I BENISION ROMWNEUL & INDEX OF SHEETS THE SHEET SHEET | BEA_BB-I - BEA_BB SHEET NO. |
| OE SHEELS | |

- STATION +/-: INDICATES VERTICAL SAGE WHICH HAS TWO OUTLETS. - IN CUT SECTIONS, OUTLET PIPE SHALL BE A IX GRADE INSTEAD OF A 3X MIN. GRADE.

FROM 46+50 TO 51+10 OUTLETS AT 46+50 (SN33); 47+80 (SN34); 49+71 (SN35)

MBT INSIDE SHOOTDEK DKAIN

OUTLETS AT 80+90;81+20 (SN90);82+40 (SN93);83+60 (SN95);84+60;86+80 (SN98) 09+98 01 06+08 WOYJ

ONTLETS AT 75+39+/-:76+00:77+00:78+00:78+85 (SN85),80+40 FROM 75+02 TO 80+90

OUTLETS AT 70+80; 71+80; 72+80 (SN74); 74+35 (SN76); 75+00 FROM 69+78 TO 75+00

81+69;(01NS) 00+69;00+89;01+73;02+83 OUTLETS AT 59+40 (SNSI); 60+50; 61+30; 62+30 (SN60); 63+30; 64+20; 65+20 (SN64); FROM 58+50 TO 69+78

ONTLETS AT 54+92 (SN44); 56+64 (SN47) FROM 54+92 TO 57+88

OUTLETS AT 51+05;52+30 (SN38); 53+40 (SN41) FROM 51+05 TO 54+33

OUTLETS AT 36+60 (SN8); 37+70 (SNIO); 38+69+/- (SNIS); 40+40 (SNI9) LYON 38+65 TO 41+55 (BEGIN BRIDGE) ONLTEL2 VL 35+50 (2NS): 33+42 (2N4)

EBOW 21+00 10 33+42 (BECIN BRIDCE)

MBT OUTSIDE SHOULDER DRAIN

OUTLETS AT 59+00 (SN52A) FROM 57+90 TO 59+00

SHOULDER DRAINS (CONT'D):

METRIC

CENERAL NOTES - METRIC (CONT'D)

rst.ddf+3S7

ocument Control Number

HECKED BA:

RAWN BY:

DATE: DATE:

THE LPA GROUP of North Caroling, p. NO RUMBLE STRIPS SHOULD BE INCLUDED ON THE CONCRETE PAVED SHOULDERS

AND AD LIVE

FROM 35+88 TO 41+25

EBT INSIDE SHONTDEB DBAIN

0+489.03+74.00+77+85.08+85.08+87); 80+00; 81+20 (SV92); 82+40; 83+50; 84+20; 85+40

OUTLETS AT 59+40 (SN53)

OUTLETS AT 46+32; 47+40; 48+60; 49+80 (SN36)

SHOULDER DRAINS SHALL BE CONSTRUCTED IN ACCORDANCE WITH STD. NO. 816.02 OR 816.03

THE PIPE WILL NOT BEGIN UNTIL THIS INFORMATION IS OBTAINED AND THE DESIGN IS ACTUAL PIOND HAS BEEN DRAINED AND SURVEYED BY THE DESIGN/BUILDER. CONSTRUCTION OF THE ELEVATIONS FOR THE PIPE AT -L- STATION 71+50 ARE PRELIMINARY ONLY AND THE

THE GEOTECHNICAL ENGINEER SHOULD OBSERVE ALL ROCK CUTS TO CONFIRM ALL LOOSE ROCK IS ADEQUATELY REMOVED AND TO DETERMINE THE LLOWABLE SLOPE TO BE USED.

THE LE(H):I(V) ROCK CUTS SHOULD BE CONSTRUCTED AT A SLOPE OF 3(H):I(V). SHOULD BE CONSTRUCTED AT A SLOPE OF IS(H): I'NE EARTH CUT ABOVE THE LOCATIONS OF SOFT WEATHERED ROCK AND HARD ROCK

AT ROCK LOCATIONS:

BASED ON FIELD CONDITIONS AT THE TIME OF CONSTRUCTION
40+40 TOWARD 40+00 AND 40+50. THE TOTAL EXTENT OF UNDERCUT SHALL BE
EXTEND TO ABOUT FLEYATION 54 METERS NEAR STA 40+40 AND WILL TAPER FROM
MILL TA BASED ON BORING RESULTS, UNDERCUTTING OF SOFT FOUNDATION SOILS WILL BE

09+99 01 00+99 V1S -7-00+04 01 09+85 V1S -7--RAMPC_REV- STA 10+00 TO 12+60 -LPC- STA, 11+20 TO 11+60 LOCATIONS OF GROUNDWATER WITHIN IS METERS OF SUBGRADE.

DESIGN SUBGRADE AT THE LOCATIONS.

TO BE PLACED AT THESE LOCATIONS. GROUNDWATER WAS IDENTIFIED ABOVE OR WITHIN IS METERS OF THE

BE CONDUCTED AS DIRECTED. UNDERCUT ALONG CULVERT PIPES ACROSS EXISTING PONDS SHOULD

SEE RECOMMENDATIONS FOR LOCATION OF LIME/CEMENT. SUBGRADE STABILIZATION IS REQUIRED THROUGHOUT THE PROJECT.

UNDERCUT OR STABILIZATION FABRIC SHOULD BE USED AT -YIO-STA 11+60 TO 12+40.

RELEASE FOR CONSTRUCTION

2HEEL NO:

8-2547BB

PROJECT REFERENCE NO.

DATE: 11-12-03

North Carolina Constructors

| DESCRIPTION OF REVISION | :3TAG | :\8 | ON |
|--------------------------|---------|-----|----|
| RELEASE FOR CONSTRUCTION | 7-22-03 | 838 | 0 |
| | | | L |
| | | | 2 |
| | | | 8 |
| | | | 19 |
| | | | 0 |

| DESCRIPTION OF REVISION | :3TAG | :YB | ŀ |
|--------------------------|---------|-----|---|
| RELEASE FOR CONSTRUCTION | 7-22-03 | REB | 1 |
| | | | T |
| | | | 1 |
| | | | T |
| | | | ŀ |
| | | | T |

840.00 Concrete Base Pad for Drainage Structures

| DESCRIPTION OF REVISION | :3TAG | :YB | ŀ |
|--------------------------|---------|-----|---|
| RELEASE FOR CONSTRUCTION | 7-22-03 | REB | 1 |
| | | | T |
| | | | 1 |
| | | | T |
| | | | ŀ |
| | | | T |

| REVISIONS | | |
|--|------------------|--------------------------|
| 1852 N 1852 N 1853 | ROADWAY DESIG | DESCRIPTION OF REVISION |
| 1852 N 1852 N 1853 | 111111 | RELEASE FOR CONSTRUCTION |
| | Silver | |
| | | |
| | NIONICA | |
| | | |
| | 10cz//: E L | |
| ₹3\$ \ | | KEAISIONS |
| | ▼3\$ 1 : /≡ · | |

William H. CAROLINA

| HADBADLICS ENGIN | OADWAY DESIGN ENGINEER |
|------------------|---|
| | Capal minimum |
| | OUS HIM |
| | |
| | 5 5 1 3 1 1 (S) 1 1 1 1 1 1 1 1 1 1 1 1 1 1 1 1 1 1 1 |
| | |
| | E / 23866/ |
| | I REAL I THE |
| | |

INDEX' CEN' NOTES, STDS FINAL PLANS

DEPARTMENT OF TRANSPORTATION

720.01 Concrete Shoulders

710.01 Concrete Pavement - Station Marking

Roleigh, North Carolina 27609 THE LPA GROUP of North Carolina, p.a.

700.05 Tying Proposed Pavement to Existing

700.04 Concrete Pavement Header Board

Y00.03 Dowel Assembly

700.02 Expansion Joint Layout - for Rigid Doweled Pavement at Bridges 700.07 Concrete Paverment Joints - Construction and Construction Joints

DIVISION 7 - CONCRETE PAVEMENTS AND SHOULDERS

sinemevs9 IlsingA - sqrit2 eldmuR belliM 10.399

854.01 Pavement Repairs

610.04 Asphalt Wearing Surface on Approach Slab

610.03 Guide for Paving Shoulders Under Bridges - Method III

610.02 Guide for Paving Shoulders Under Bridges - Method II

610.01 Guide for Paving Shoulders Under Bridges - Method 1

DIVISION 6 - ASPHALT, BASES AND PAVEMENTS

50.002 Method of Shoulder Construction - High Side of Superelevated Curve - Method II 56.001 Method of Shoulder Construction - High Side of Superelevated Curve - Method I

DINISION 2 - SUBGRADE, BASES AND SHOULDERS

422.10 Reinforced Bridge Approach Fills

DIVISION 4 - MAJOR STRUCTURES

310.10 Driveway Pipe Construction

310.05 Cross Pipe End Section - Prefabricated Steel Section for 450mm to 800mm Pipe 310.04 Parallel Pipe End Section - Prefabricated Steel Section for 400mm to 600mm Pipe 310.03 Cross Pipe End Section - Precast Concrete Section for 450mm to 750mm Pipe

310.02 Parallel Pipe End Section - Precast Concrete Section for 375mm to 600mm Pipe Method of Structural Plate Pipe and Pipe Arch Installation - Method 'B'

300.03 Method of Structural Plate Pipe and Pipe Arch Installation - Method 'A'

30.002 Method of Pipe Installation - Method 'B'

300.01 Method of Pipe Installation - Method 'A'

DIVISION 3 - PIPE CULVERTS

240.07 Guide for Berm Ditch Construction

225.09 Guide for Shoulder and Ditch Transition at Grade Seperations

225.08 Earth Berm Median Pier Protection

225.07 Grading for False Cut at Grade Seperations

225.06 Method of Grading Sight Distance at Intersections

225.05 Method of Obtaining Superelevation - Divided Highways

225.04 Method of Obtaining Superelevation - Two Lane Pavement

225.03 Deceleration and Acceleration Lanes

225.02 Guide for Grading Subgrade - Secondary and Local

225.01 Guide for Grading Subgrade - Interstate and Freeway

III bortteM - gninselO to bortteM 60.002

Il bontaM - gninsalO to bontaM 20.00S

DIVISION 2 - EARTHWORK

TITLE STD. NO.

and by reference hereby are considered a part of these plans: Raleigh, N.C., Dated January 15, 2002 are applicable to this project Drawings" Highway Design Branch - N.C. Department of Transportation -The following Roadway Standards as appear in "Roadway Standard

ROADWAY METRIC STANDARD DRAWINGS

838.80 Precast Endwalls – 300mm thru 1800mm Pipe 90° Skew Notes for Reinforced Brick Endwall - Std. Drawings 838.51 thru 838.70 Reinforced Brick Endwall - for Double and Triple 1800mm Pipe 90° Skew Heinforced Brick Endwall - for Single 1800mm Pipe 90° Skew Reinforced Brick Endwall - for Double and Triple 1650mm Pipe 90° Skew Reinforced Brick Endwall - for Single 1650mm Pipe 90° Skew Reinforced Brick Endwall - for Double and Triple 1500mm Pipe 90° Skew Reinforced Brick Endwall - for Single 1500mm Pipe 90° Skew 838.52 Reinforced Brick Endwall - for Double and Triple 1350mm/400mm Pipe 90° Skew Reinforced Brick Endwall - for Single 1350mm/1400mm Pipe 90° Skew 838.45 Notes for Reinforced Concrete Endwall - Std. Drawings 838.21 thru 838.40 Reinforced Concrete Endwall - for Double and Triple 1800mm Pipe 90° Skew 04.858 Reinforced Concrete Endwall - for Single 1800mm Pipe 90° Skew Reinforced Concrete Endwall - for Double and Triple 1650mm Pipe 90° Skew 838.33 Reinforced Concrete Endwall - for Single 1650mm Pipe 90° Skew 838.28 Reinforced Concrete Endwall - for Double and Triple 1500mm Pipe 90° Skew 838.27 Reinforced Concrete Endwall - for Single 1500mm Pipe 90° Skew 1320mm/t00mm bibe 80° Skew Reinforced Concrete Endwall - for Double and Triple 888.21 Reinforced Concrete Endwall – for Single 1350mm/l+00mm Pipe +00° Skew

838.20 Brick Endwall for Outfall - 100mm, 150mm or 200mm Pipe 1016mm x 1295mm thru 1676mm x 1295mm Pipe Arch Brick Endwall for Single Pipe Culverts -1016mm x 787mm thru 1676mm x 1295mm Arch 90° Skew 838.17 Brick Endwall for Single and Double Pipe Culverts 432mm x 330mm thru 1803mm x 1194mm Pipe Arch 838.16 Brick 'L' Endwall for Single Pipe Culverts -838.15 Brick 'L' Endwall for Single Pipe Culverts - 375mm thru 1200mm Pipe

43Smm x 330mm thru 1803mm x 1S00mm Pipe 60 $_{\odot}$ Skew 838.14 Brick Endwall for Single and Double Pipe Culverts

375mm thru 1200mm Pipe 90° Skew

838.11 Brick Endwall for Single and Double Pipe Culverts -838.10 Concrete Endwall for Outfall - 100mm, 150mm or 200mm Pipe

1016mm x 1295mm thru 1676mm x 1295mm Pipe Arch 838.08 Concrete 'L' Endwall for Single Pipe Culvert

1016mm x 787mm thru 1676mm x 1295mm Arch 90° Skew 838.07 Concrete Endwall for Single and Double Pipe Culvert -432mm x 330mm thru 1803mm x 1194mm Pipe Arch

838.06 Concrete 'L' Endwall for Single Pipe Culvert -838.05 Concrete 'L' Endwall for Single Pipe Culverts - 375mm thru 1200mm Pipe

432mm x 330mm thru 1803mm x 1194mm Arch 90° Skew

Concrete Endwall for Single and Double Pipe Culvert -40.858 838.02 Concrete Endwall and Sluice Gate – 375mm thru 900mm 90 $^{\circ}$ Skew

375mm thru 1200mm Pipe 90° Skew Concrete Endwall for Single and Double Pipe Culverts -

820.04 Drain Installation in Shoulder Berm Gutter

10.028 Funnel and Funnel Drain – 300mm Metal Funnel 816.04 Markers for Drainage Structure and Concrete Pad

316.03 Geocomposite Sholder Drain

76.02 Aggregate Shoulder Drain

Concrete Pads - for Shoulder Drain Installation

815.03 Pipe Underdrain and Blind Drain

306.02 Granite Right-of-Way Marker

806.01 Concrete Right-of-Way Marker

DIVISION 8 - INCIDENTALS

| 30.848 | Wheelchair Ramp - Curb Cut |
|---------------------|--|
| | Street Turnout |
| 848.03 | Driveway Turnout - Drop Curb Type |
| S0.848 | Driveway Turnout - Radius Type |
| 10.848 | Concrete Sidewalk |
| 846.02 | Expressway Gutter Transition for Drop Inlet |
| 10.348 | Concrete Curb, Gutter and Curb & Gutter |
| 844.02 | Brick Masonry Steps |
| 10.448 | Concrete Steps |
| 842.03 | Concrete and Brick Retaining Walls - with 0.6m Surcharge |
| 842.02 | Concrete and Brick Retaining Walls - with Sloping Surcharge |
| 842.01 | Concrete and Brick Retaining Walls - with No Surcharge |
| 840.72 | Pipe Collar |
| 17.048 | Concrete and Brick Pipe Plug |
| 99.048 | Drainage Structure Steps |
| 49.048 | Manhole Frame and Cover |
| 840.53 | Precast Manhole with Masonry Base - 300mm thru 1050mm Pipe |
| 840.52 | Precast Manhole – 1200mm, 1500mm and 1800mm Diameter |
| 15.048 | Brick Manhole – 300mm thru 900mm Pipe |
| 94.048 | Trafflic Bearing Precast Drainage Structure |
| 840.45 | Precast Drainage Structure |
| 14.048 | Spring Box - Concrete or Brick |
| 78.0 1 8 | Steel Grate and Frame |
| 98.048 | Traffic Bearing Drop Inlet - for Steel (840.37) Double Frame and Grates |
| 840.35 | Traffic Bearing Drop Inlet - for Cast Iron Double Frame and Grates |
| 840.34 | Traffic Bearing Junction Box - for Use with Pipes 1050mm and Under |
| 840.33 | Angled Vane Grates and Frames |
| 840.32 | Brick Junction Box - 300mm thru 1650mm Pipe |
| 16.048 | Concrete Junction Box - 300mm thru 1650mm Pipe |
| 840.30 | Driveway Drop Inlet |
| 840.29 | Frames and Narrow Slot Flat Grates |
| 840.28 | Brick Median Drop Inlet Type 'D' - 300mm thru 900mm Pipe |
| 75.048 | Brick Median Drop Inlet Type 'B' - 300mm thru 900mm Pipe |
| 840.26 | Brick Median Drop Inlet Type 'A' - 300mm thru 1800mm Pipe |
| 840.25 | Anchorage for Frames – Brick or Concrete |
| 42.048 | Frames and Narrow Slot Sag Grates |
| 840.22 | Frames and Widle Slot Sag Grates |
| 840.20 | Frames and Wide Slot Flat Grates |
| 91.0 1 8 | Concrete Median Drop Inlet Type 'D' - 300mm thru 900mm Pipe |
| 81.048 | Coucteie Median Drop Inlet Type 'B' - 300mm thru 900mm Pipe |
| 71.048 | Concrete Median Drop Inlet Type 'A' - 300mm thru 1800mm Pipe |
| 91.048 | Drop Inlet Frame and Grates - for use with Std. Drawings 840.14 and 840.15 |
| 840.15 | Brick Drop Inlet - 300mm thru 750mm Pipe |
| | |

Concrete Drop Inlet - 300mm thru 750mm Pipe

840.04 Concrete Catch Basin with Single and Multiple Pipes -

840.02 Concrete Catch Basin - 300mm thru 1350mm Piţiţ

840.01 Brick Catch Basin - 300mm thru 1200mm Pipe

840.03 Frame, Grates and Hood - for Use on Standard Gatch Basin

840.05 Brick Catch Basin with Single and Multiple Pipes-

300mm thru 1200mm Pipe

300mm thru 1200mm Pipe

AST. ddT P CST

HECKED BA:

KAWN BY:

ocument Control Number:

3000

DATE: __

DATE:

NEER

Drainage Ditches with Class 'B' Rip Rap 40.8/8 Drainage Ditches with Class 'A' Rip Rap Guide for Rip Rap at Pipe Outlets 20:9/8 Rip Rap in Channels Glare Screen - Chain Link Fabrio Guardrail Mounted Barbed Wire Fence with Wood Posts (2 - 7 Strands) t0.338 Woven Wire Fence - with Steel Post 50.998 Woven Wire Fence - with Wood Post 20.998 Chain Link Fence - 1.2m, 1.5m and 1.8m High Fence Cable Guiderail (Beg. October 2002 Let Use Detail in Lieu of Standard) Structure Anchor Units 862.03 Guardrail Installation 20.238 Guardrail Placement Precast Reinforced Concrete Barrier - 1.0m Single Faced Concrete Median Transition Barrier - Location of Overhead Assembly Concrete Median Barrier - Precast Permanent Double Faced Concrete Barrier - Types 'T', 'T1' and 'T2' Double Faced Concrete Barrier - Types I, II, III and IV Concrete Glare Screen - 455mm to 685mm Height 10.535 Median Construction - with Curb and Gutter 952.10 Method for Placement of Drop Inlets in Concrete Islands 90.238 Median Curb for Catch Basin - for Use with 450mm Curb and Gutter Using 450mm Curb and Gutter Method for Placement of Drop Inlet in Grassed Median -Concrete Mountable Median - for Use with Rigid or Flexible Pavement Concrete Islands Guide for Berm Drainage Outlet - 600mm and 800mm Pipe 850.10 Guide for Berm Drainage Outlet - 400mm and 450mm Pipe Concrete Paved Ditches

METRICS!


DATE: 7-22-03 RELEASE FOR CONSTRUCTION

8-2547BB SHEEL NO. ROJECT REFERENCE NO.

| NVENTIONAL SYMBOLS | NOO YOO | st.ddrp2S7 | HADBANTIC2 ENCINEER | M GOADWAY DESIGN ENGINEER |
|---|-------------------------------|--|--|--|
| FINAL PLANS | | Filename : | | Copyright 2000 S 1420 |
| SIAA IG IAINTE | umber: | Document Control N | | A STATE OF THE STA |
| TMENT OF TRANSPORTATION | PAPAG | CHECKED BA: | | |
| STATE OF NORTH CAROLINA | :3TAQ | DRAWN BY: | | WEST WILLIAM CAROLINATION OF THE CAROLINATION |
| Te\2S_L2 besiver | | | | |
| HZJUNS | Switch | | | SS 3 SOLIT |
| MEROST 35 | RR Signal Milepost | | | - Hims |
| MASIMAGNEL S.S | Standard Gange | | | |
| NIMEAY ID | RAILROADS | — - ЕЬВ — - | Existing Endangered Plant Boundaries | |
| | OrchardVineyard | 8AB | Existing Endangered Animal Boundaries | |
| | Woods Line | МГВ | Peroporal Metland Bondaries | · · |
| · · · · · · · · · · · · · · · · · · · | Hedge | — — MTB —— — | Existing Wetland Boundaries | , |
| ٥ | Single Shrub | -×××- | Fence Line | |
| | Single Tree | (9) | Parcel Number | |
| ☆ | VEGETATION | (2) " 2" | Property Mumber | |
| Δ.Δ. | Light House | + | Property Corner | |
| | Trail, Footpath | 4 □ ⊙ | Exist. Iron Pin | |
| | gbindtoo7 | <u>-</u> 91 | Property Line Symbol | |
| | Ferry | | Property Line | |
| <u>(</u> | Box Culvert or Tunnel | | Reservation Line | • |
| | Bridge | | City Line | |
| | Paved Walk | | | |
| d 0 ⊙ | Guard Post | | = | |
| | Right of Way Symbol | SHI | BOUNDARIES & PROPERT | |
| | Cuth | то-3 | End of Information and a series of the serie | |
| | Hard Surface | RUTTA | Abandoned According of UNS Record | |
| | Loose Surface | • | U/G Test Hole (S.U.E.*) | |
| | TOPOGRAPHY | 0 | Exist. Water Meter | |
| | loo9 gnimmiw2 | 0101 | Designated Fiber Optics Cable (5.U.E.*) | |
| * | Small Mine | vrvr | Designated Television Cable (S.U.E.*) Recorded Fiber Optics Cable | |
| M | Well | vrvr | Recorded Television Cable | |
| § | ngi2 | | Unknown Utility (S.U.E.*) | |
| | Cemetery | | Designated UC Telephone Conduit (S.U.E.*) | |
| L | Park | | Recorded UVG Telephone Conduit | |
| ₹ | School looks | 111 | Recorded Telephone Cable (5.U.E.*) | |
| Ţ | Church | | Designated Power Line (S.U.E.*) | |
| · · · · · · · · · · · · · · · · · · · | Gas Pump Yent or U/G Tank Cap | | Recorded Power Line | |
| | Gate | sss | Storm Sewer | СВ |
| | Frea Outline | | Designated Gas Line (*.3.U.E.*) | / = = |
| ·_ | sgnibling spoitphus | 523 | Recorded Gas Line | |
| CULTURE | I was said to | 227 227 | Recorded Sanitary Sewer Force Main(S.U.E.*). Designated Sanitary Sewer Force Main(S.U.E.*). | |
| CILLIID | BUILDINGS & OTHER | SS SS | Sanitary Sewer | |
| | | ************************************** | Designated Water Line (5.U.E.*) | |
| Chapter (Hits. State | | | Recorded Water Line | |
| DATE: 7-22-03 | | | | SAWBOFS |
| RELEASE FOR CONSTRUCTION | //// | | | CHMVLS |
| 200 ac/a/2008 | | T/11/ | | CAROLINA |
| B-2547BB IC PROJECT REFERENCE NO. SHEET NO. | METRICA | | | , y a u u n n n |
| | | | | |

DIVISION OF HIGHWAYS STATE OF NORTH CAROLINA

CONVENTIONAL SYMBOLS

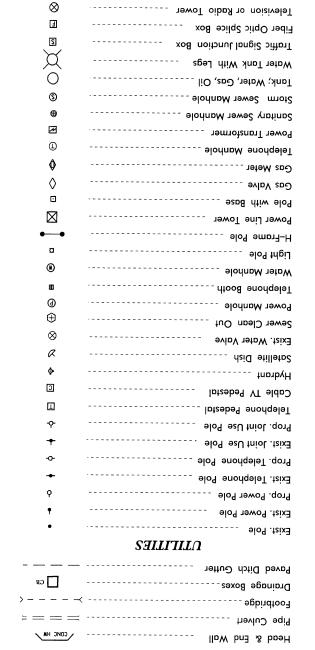

DESCRIPTION OF REVISION

RELEASE FOR CONSTRUCTION

 \otimes

KEVISIONS

MO- BY: DATE:

Signal Lines Cut Into the Pavement Utility Power Line Connects to Traffic



Edge of Pavement

KOVDS & KETVLED ILEWS

| ENCINEER | YTIJITU | SUBSURFACE | = 3.U.2* |
|----------|---------|------------|----------|

| CONC MM | MAJOR Bridge, Tunnel, or Box Culvert Bridge Wing Wall, Head Wall and End Wall |
|-----------------|--|
| | <i>SLKNCLNKE8</i> |
| ₩OI3 → | Prop Lateral, Tail, Head Ditches |
| | Falls, Rapids |
| | Shoreline |
| 木 | Swamp Marsh |
| / 0 | fundς |
| | Disappearing Stream |
| ← | wonA wolf |
| | Stream or Body of Water |
| | НХБИОГОСК |
| 30d | Prop. Perm. Drainage Easement Line |
| | Prop. Temp. Drainage Easement Line |
| | Prop. Temp. Construction Easement Line |
| | Exist. Easement Line |
| | Prop. Control of Access Line |
| —(₹)— · | Exist. Control of Access Line |
| | |
| v | (Concrete or Granite) R/w Marker |
| | Prop. Right of Way Line with Proposed |
| • | RW marker (Iron Pin & Cap) |
| _ | Prop. Right of Way Line with Proposed |
| | Exist. Right of Way Line wMarker |
| ∇ | Existing Right of Way Marker |
| • | Raseline Control Point |
| | |
| \otimes | Pavement Removal |
| - \$ | Prop. Cable Guiderail Equality Symbol |
| | Exist. Cable Guiderail |
| | Liop: contains |
| | Exist. Guardrail |
| 6 | Curb Cut For Future Wheelchair Ramp |
| 4DMD | Prop. Wheelchair Ramp |
| → → | Prop. Barbed Wire Fence |
| -0-0- | Prop. Chain Link Fence |
| | Prop. Woven Wire Fence |
| 3 | Prop. Slope Stakes Cut Prop. Slope Stakes Fill |
| | Prop. Slope Stakes Cut |


TYPICAL SECTIONS FINAL PLANIF DEPARTMENT OF TRANSPORTATION -L = 80 + 81 TO 82 + 79 -L- 71+70 TO 75+12 -L- 60+30 TO 69+88 WESTBOUND OUTSIDE LANE (-L- LT) -L STA. 72 + 33 TO 75 + 74 -L - STA. 77 + 75 TO 81 + 72 -L- STA. 60+20 TO 67+4] EASTBOUND OUTSIDE LANE (-L- RT) (FOR USE WITH CONCRETE SHOULDERS) FUTURE RAMP LOCATIONS ON THIS SHEET SHOUDERS HAVE BEEN PROVIDED ASPHALT AND CONCRETE NOTE THAT DETAILS FOR BOTH T JYSmm SHOULDER DRAIN LOCATIONS SEE GENERAL NOTES FOR SCALE

OT

TON

METRICE!

PROJECT REFERENCE NO.

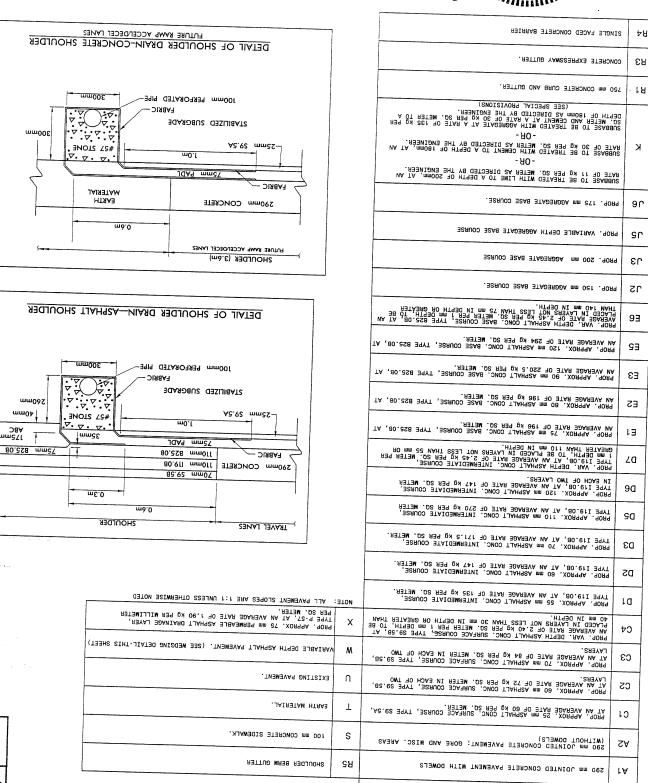

qvt.adflest

HECKED BA:

YB NWARC

DA LE:


:3TAG_

PAVEMENT DESIGN ENGINEER

70-21-ZOEVEREEFERE

PAVEMENT SCHEDULE

100 S 183

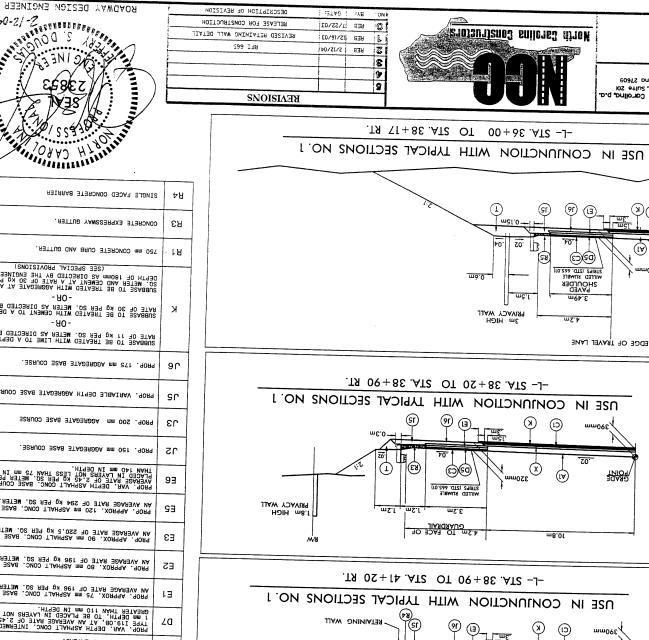

PRIVACY WALL


(**9**3)

(250.+054.) 254.0-

աացց

(CS)

(DS)

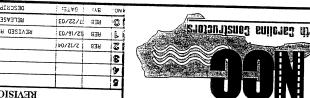

(E)(G)

AILLED RUMBLE TRIPS (STD. 665.01)

DETAIL SHOWING METHOD OF WEDGING

n'

(DS)

€ SURVEY

THE LPA GROUP of North Corolling, p.d


69(3)


EDGE OF TRAVEL LANE


azomn


PAVED SHOULDER MILLED RUMBLE STRIPS (STD. 665.01)

North Carolina Constructors

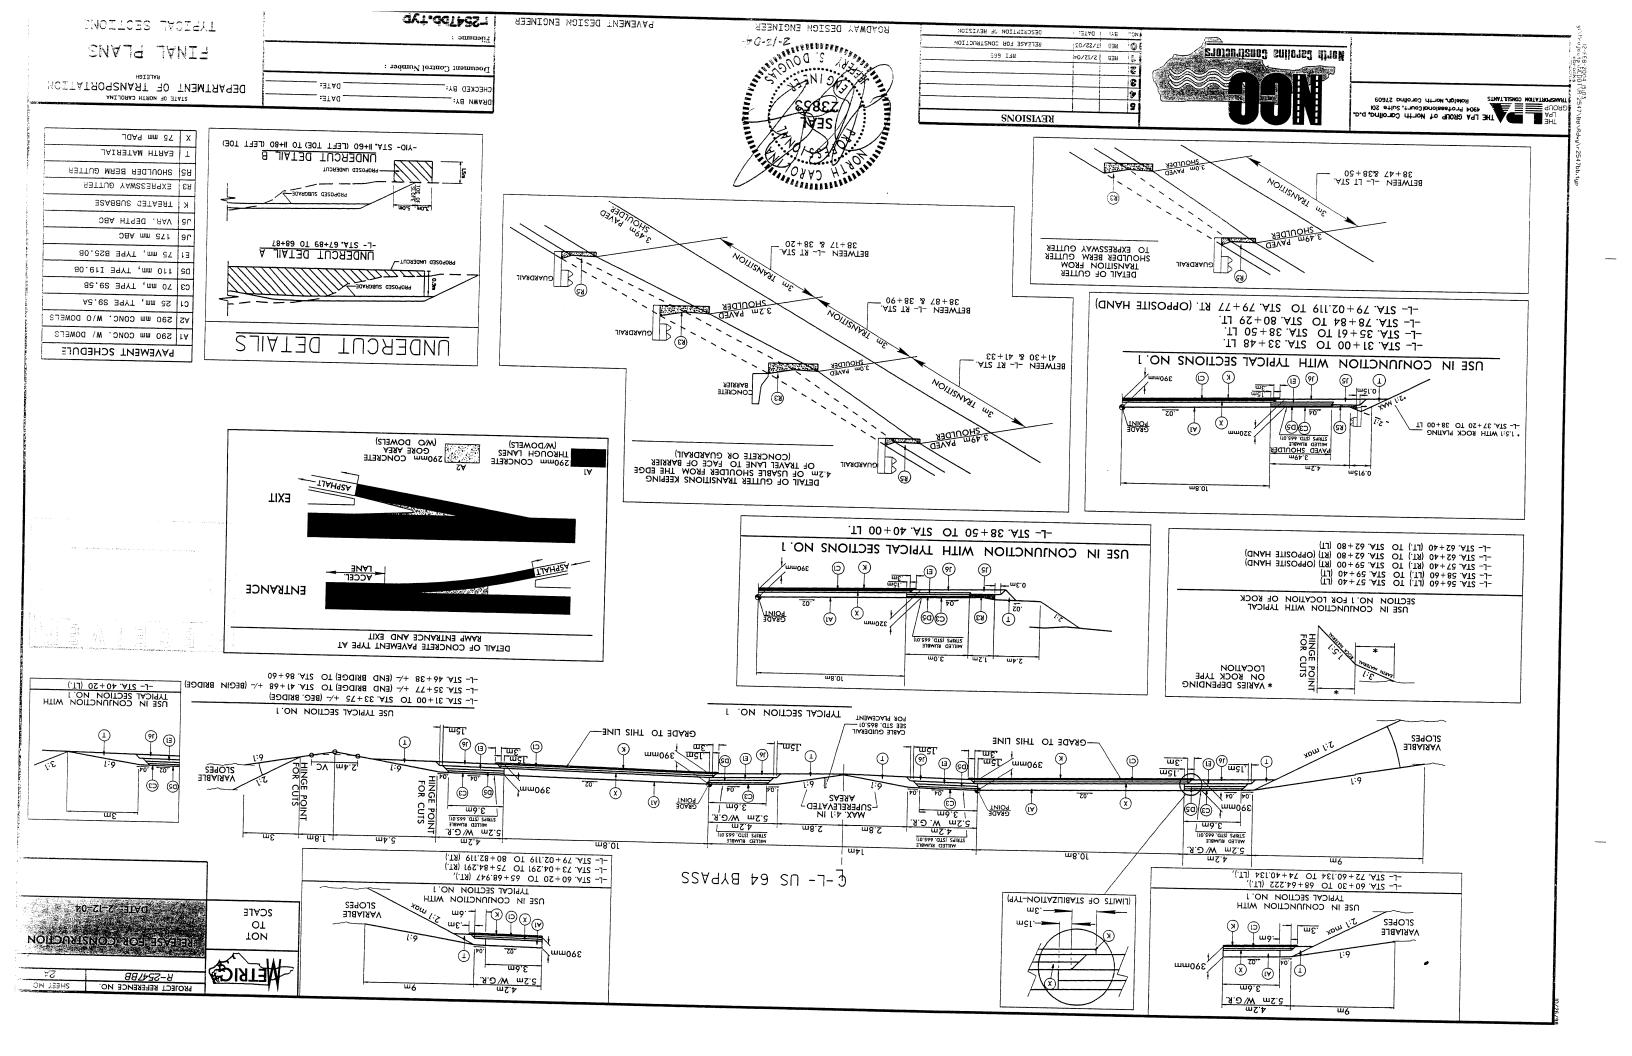

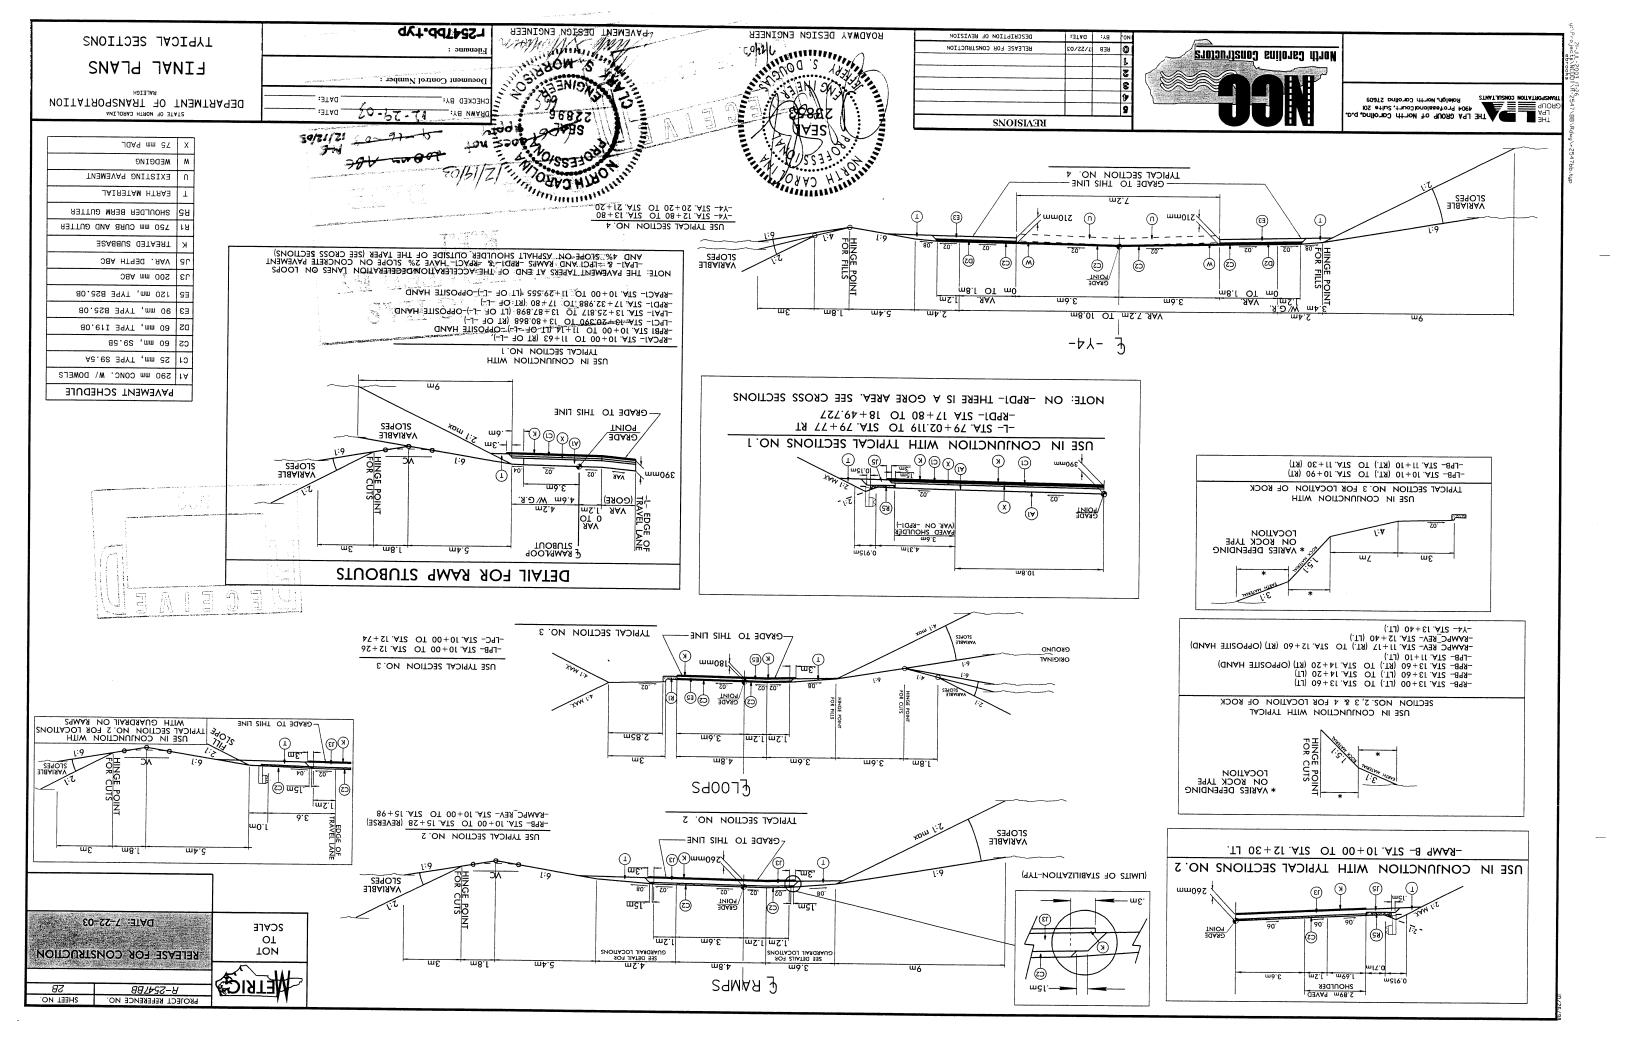

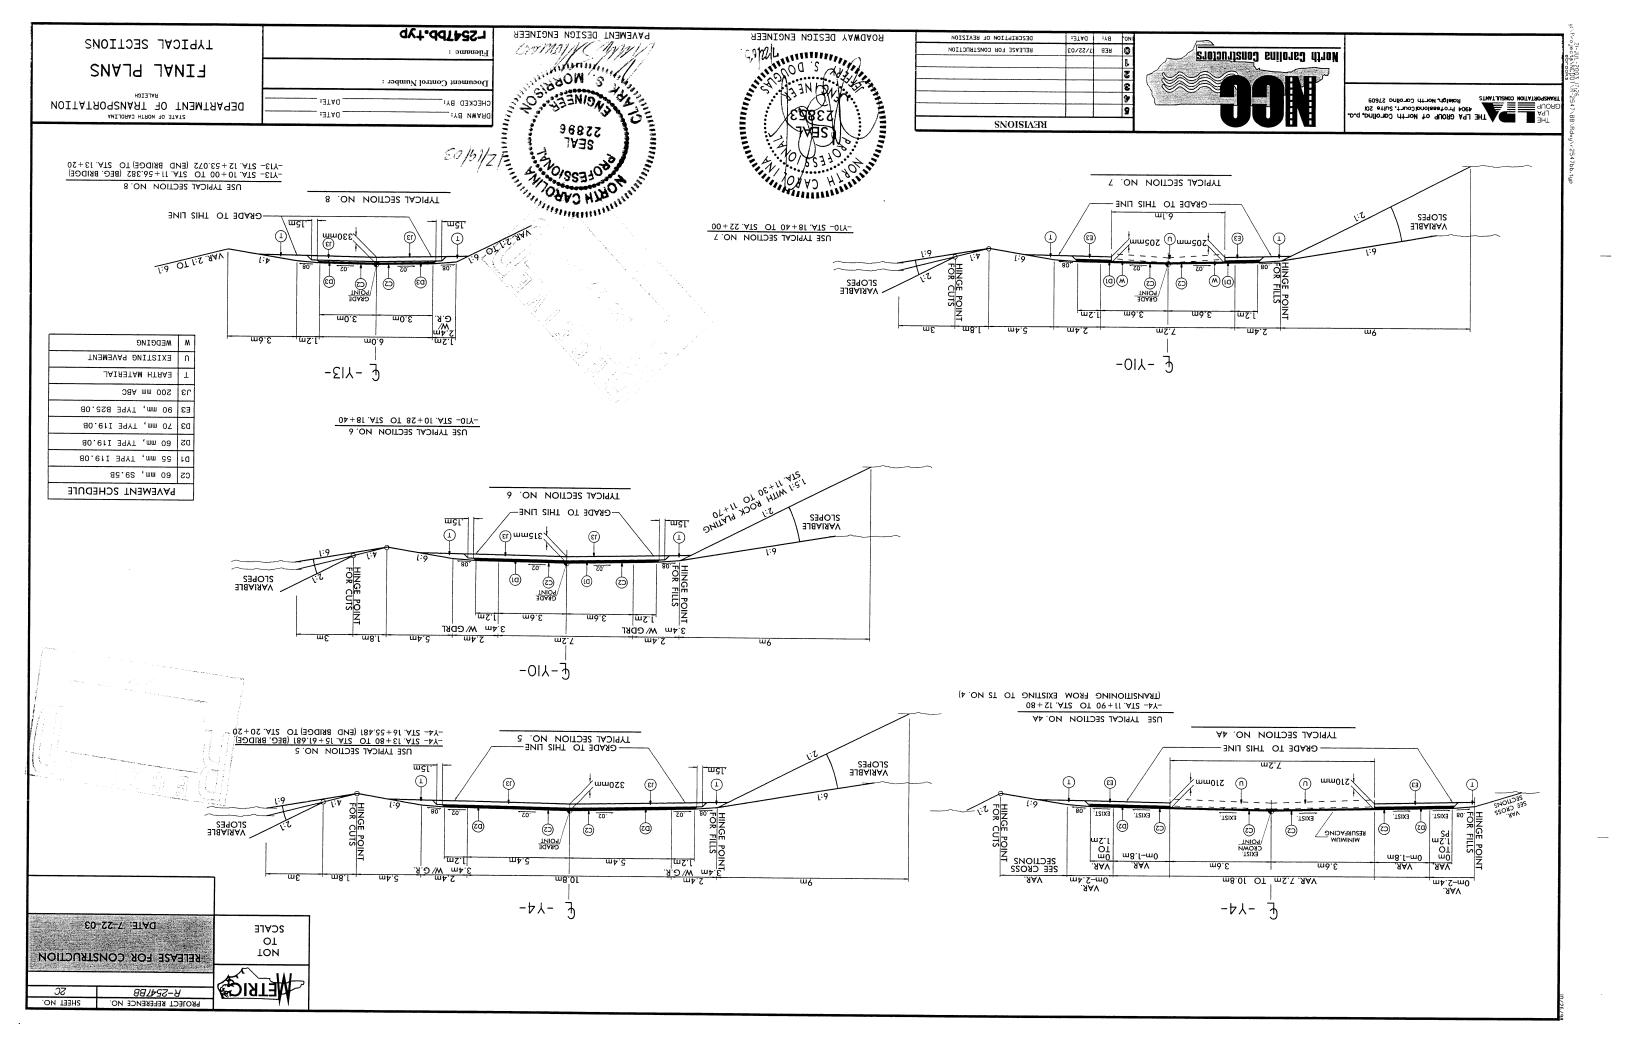

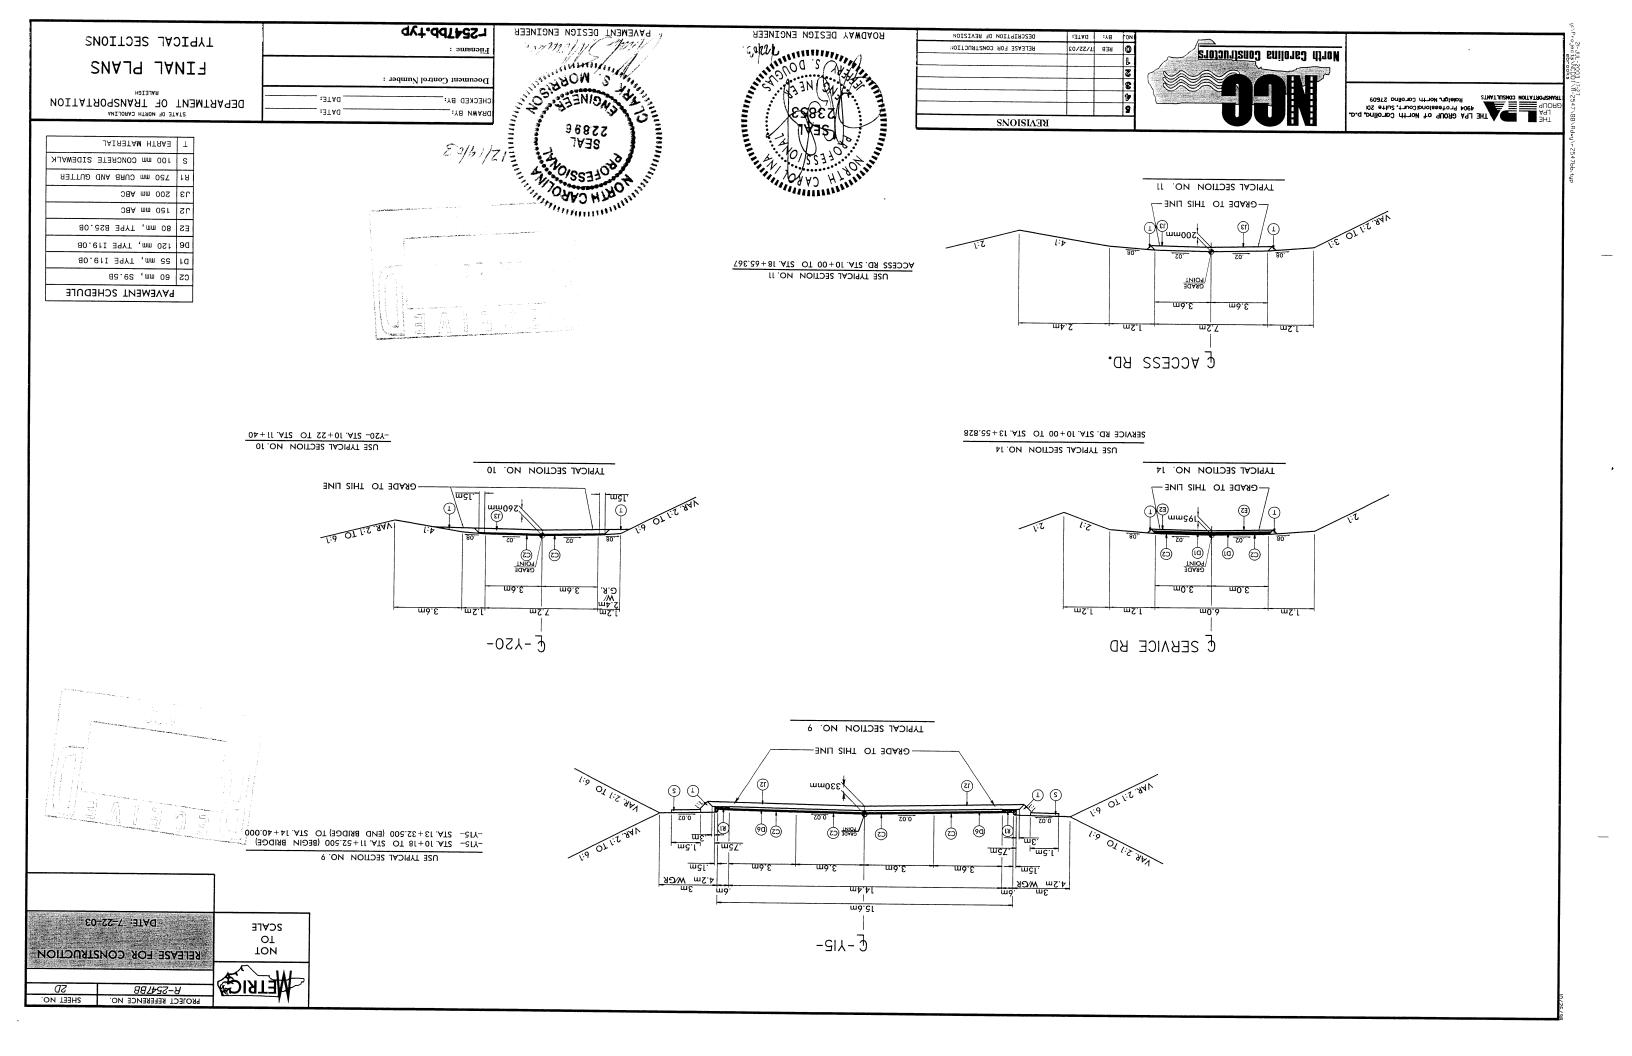

| | DITCHDETAIL.DSW |
|-------|---------------------------|
| | Filename : |
| | |
| | Document Control Number : |
| :3TAO | CHECKED BY: |


| | _ |
|--|---|
| HYDRAULICS ENGINEER | |
| The state of the s | |
| METESTER METESTER | |
| SEAL SEAL SEAL SEAL SEAL SEAL SEAL SEAL | |
| | |
| 6334 | 3 |
| 2EVI | Ē |
| 1. A. A. | Ē |
| 10/583300 A | MINITHITITITITITITITITITITITITITITITITITI |
| JONNO HIS | , |
| | |
| ~~~~ | |

| | | | 9 |
|-----------------------------|----------|------|----|
| | | | 3 |
| | | | 2 |
| -Y JIATEC GEGGA | 15-16-03 | 838 | L |
| RELEASE FOR CONSTRUCTION | 7-22-03 | BEB | 0 |
| DESCRIPTION OF REVISION | :3TAG | : 78 | ON |



KONEIGH, NOLTH CORONING 27609 THE LPA GROUP Of North Corollnd, p.o.

FROM STA. 39+00 TO STA. 41+20 -L- RT.

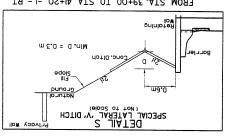

(Not to Scale)

DETAIL FSR FALSE SUMP

FROM OUTLET OF 750 FOR 22m STA. M+25 -YIS- LT.

Woturrol St. 2 1 Noturol
Ground II & Cround
III D=0.46 m
Mox.d=0.46 m
Type of Liner= CLASS '8' Rip RAP


EXISTING VY DITCH LINER


FROM STA. 34+80 TO STA. 37+00 -L- LT. DDE = 375m3

Volund of Liner CLASS '8' RIP RAP Type of Liner CLASS '8' RIP RAP

VV. DITCH O (NOT TO SCOIE)

2=DItch Slope

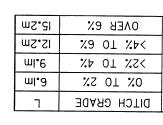

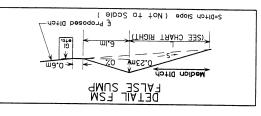


m 2.1 = 8 В m 2.0 = 0.5 m (Not to Scale) STANDARD BASE DITCH Y JIAT30


FROM STA 10+35 TO 10+60 -SERVICERD- LT

SPECIAL CUT BASE DITCH

FROM STA 11+40 TO 11+80 -SERVICERD- RT

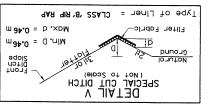



OUTLET = 10m MIN SLOPE = 0.003 m/m OUTLET = 120m MIN SLOPE = 0.003 m/m B = 0.6 m m 9.0 = 0.0 m STANDARD BASE DITCH

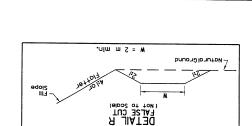

B = 0.6 m


m 3.0 = 0.6 m

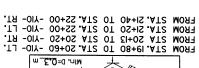

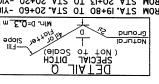


%8 (Not to Scale) LATERAL 'V' DITCH DETAIL

| M STA. 72+06 TO STA. 72+70 -L- RT. M STA. 75+33 TO STA. 75+40 -L- LT. M STA. 83+60 TO STA. 84+20 -L- RT. M STA. 12+20 TO STA. 84+20 -LC. REV- LT. M STA. 12+00 TO STA. 16+40 -ACC. REV- LT. M STA. 16+40 TO STA. 16+40 -ACC. REV- LT. M STA. 14+40 TO STA. 16+50 -ACC. REV- LT. M STA. 14+40 TO STA. 16+50 -ACC. REV- LT. | ERON ERON ERON ERON ERON ERON ERON ERON |
|--|--|
| ype of Liner = CLASS 'B' RIP RAP | |
| Fround AT PACK Min. D=0.46m Mox. d=0.46m Mox. d=0.46m | |
| eqois yet 10 to 10 | |
| SPECIAL LATERAL 'V' DITCH | |
| DETAIL T | |

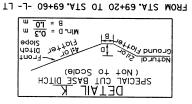

| | K K | AB TUD JAIC | SPEC | |
|----------|--------------------------------|-------------|------|--|
| | | | | |
| CIIIQL - | | 02+47 .ATS | | |
| | A. 62+30 -L- F - L- LT. DDE | | | |

FROM STA. 47+60 TO STA. 5I+10 -L- RT. DDE = 193m3

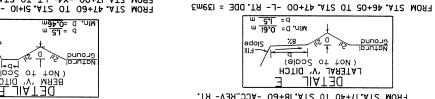


| Notural & Legisland | |
|--|-----------|
| (Not to Scale) | |
| LATERAL 'V' DITCH | |
| T JIAT30 | _ |
| M STA. 17+40 TO STA. 18+60 -ACC_REV- RT. | _ พดม- |
| 1 STA 12+80 TO 13+00 -YI3- LT | |
| I STA 11+80 TO 12+60 -SERVICERD- RT | BOP. |
| I STA 10+80 TO 11+40 -SERVICERD- RT | |
| STA 10+20 T0 10+60 -SERVICERD- RT | |
| STA -02Y - 02Y- 01 STA HT20 - Y20- RT. | |
| STA. 10+60 TO STA. 11+20 -Y10- RT. STA. 10+80 TO STA. 11+20 -Y20- LT. | |
| TR -PY- 03+EI AT2 0T 62+61 AT2 I | |
| 19 -PY- 03+EI ATZ 0T 20+SI ATZ 1 | RON: |

%8

| 2+80 T0 I3+00 -YI3- LT | I ATS | MORT |
|--------------------------------------|-------|-------------|
| 1+80 10 IS+60 -SERVICERD- RT | I ATS | FROM |
| 0+80 T0 II+40 -SERVICERD- RT | I AT2 | FROM |
| 0+20 T0 I0+60 -SERVICERD- RT | I ATS | FROM |
| 1+00 TO STA, II+20 -Y20- RT, | I.ATZ | MORT |
| 0+80 T0 STA. II+20 -Y20- LT. | I.ATZ | FROM |
| 0+60 TO STA. II+20 -YIO- RT. | I.ATZ | FROM |
| 74-05 TO STA 13+60 -Y4- RT | I.ATZ | FROM |
| 5+20 -RPB- LT. TO STA. 13+65 -Y4- R1 | I.ATZ | FROM |
| 3+60 T0 STA, I4+50 -RAMPC_REV- LT. | I.AT2 | FROM |
| .TJ -J- OP+88.AT2 OT OP+P8 | ATZ. | FROM |
| .TA -J- 08+TP .AT2 0T 00+TP | .ATZ | FROM |
| 31+40 TO STA 32+60 -L- RT. | ATZ | FROM |
| mab.0=0.0im | | |

| ſ | Min. D=0.46m | 10/10/ | |
|---|--------------|----------------|-------------------|
| 1 | edois 10 lie | / | Natural Ground |
| | | S of toN |) |
| | Д нэти | SPECIAL E | |

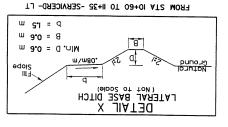

FROM STA. 78+20 TO STA. 78+80 -L- RT. DDE = 758m3

Ground Win, D. 0.45

(NOT TO SCORE) LATERAL BASE DITCH DE I AIL M

FROM STA. 13+70 TO STA. 13+80 -YIO- RT. DDE = 4m3

FROM STA. 62+15 TO STA. 62+30 -L- LT. DDE = 49m3

Cround of the Fabric CLASS '8' RIP RAP Type of Liner CLASS '8' RIP RAP

VY DITCH HOLD (NOT TO SCOLE)

FROM STA 11+80 TO STA 12+15 -Y10- LT. FROM STA 16+80 -Y10- LT.


FROM STA 52+30 TO STA 53+20 -L- LT.


FROM STA. 53+40 TO STA. 54+00 -L- RT. FROM STA. 82+50 TO STA. 15+00 -RAMPC_REV- LT. FROM STA. 14+50 TO STA. 15+00 -RAMPC_REV- LT.

m <u>21.0</u> = 0 .niM m <u>3.1</u> = 8 m <u>3.0</u> = 4




FROM STA. 69+60 TO STA. 70+96 -L- LT. DDE = 393m3

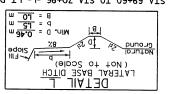


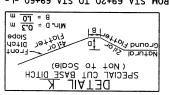


| 261m3 | = | -L- RT. DDE | 014-52 .AT2 | 01 | FROM STA. 52+60 | |
|-------|---|-------------|-------------|----|-----------------|--|

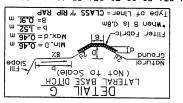

RDWY-

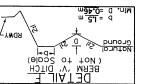


FROM STA 39+20 TO STA 39+50 -L- RT, DDE = 8m3

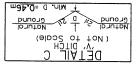



FROM STA. 10+20 TO STA. 11+00 -Y20- RT. DDE = 30m3

FROM STA, 10+20 TO STA, 10+80 -Y20- LT, DDE = 56m3 FROM STA. 18+60 TO STA 19+20 -Y4- RT. DDE = 58m3 FROM STA, 18+60 TO STA, 19+60 -Y4- LT, DDE = 75m3 FROM STA. 17+80 TO STA. 18+10 -Y4- LT. DDE = 44m3 FROM STA. 70+60 TO STA 71+31-L- RT. DDE = 61m3 FROM STA 36+60 TO STA 37+00 -L- RT, DDE = 159m3

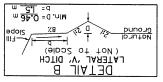


FROM STA. I2+60 TO STA. I3+70 -YIO- RT. DDE = 813m3 | Type of Liner=CLASS 'B' RIP RAP MAN. d= 0.46 m Natural Natural Ground Ground Min. D = 0. (Not to Scale)

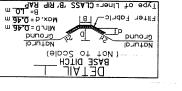


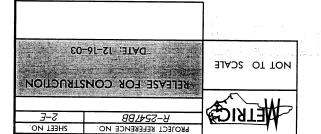

Filter Fobric de CLASS '8' RIP RAP (Not to Scale) TOE PROTECTION

DILCH DELVITS

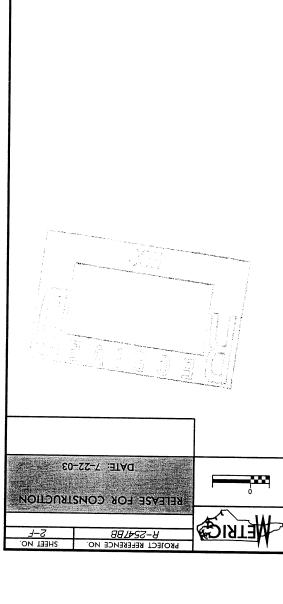

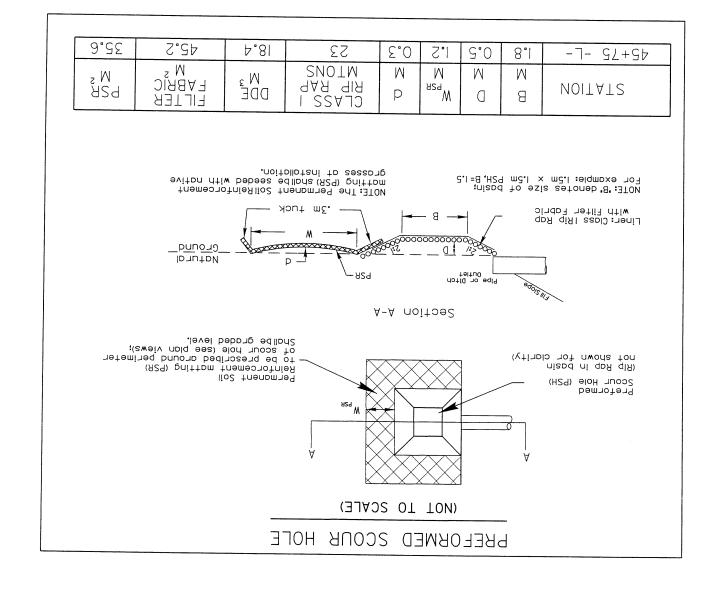



| :3TAG | :YB | ON |
|---------|-----|----|
| 7-22-03 | REB | 0 |
| | | L |
| | | 2 |
| \perp | | 8 |
| | | 9 |
| | | 2 |
| | | |
| | | |



THE LPA GROUP of North Coroling ps.

1990

1990

DEPARTMENT OF TRANSPORTATION


RALEIGH

DATE:

. :3TAU _

CHECKED BA: DRAWN BY:

LSS47bbPFSH.dgn

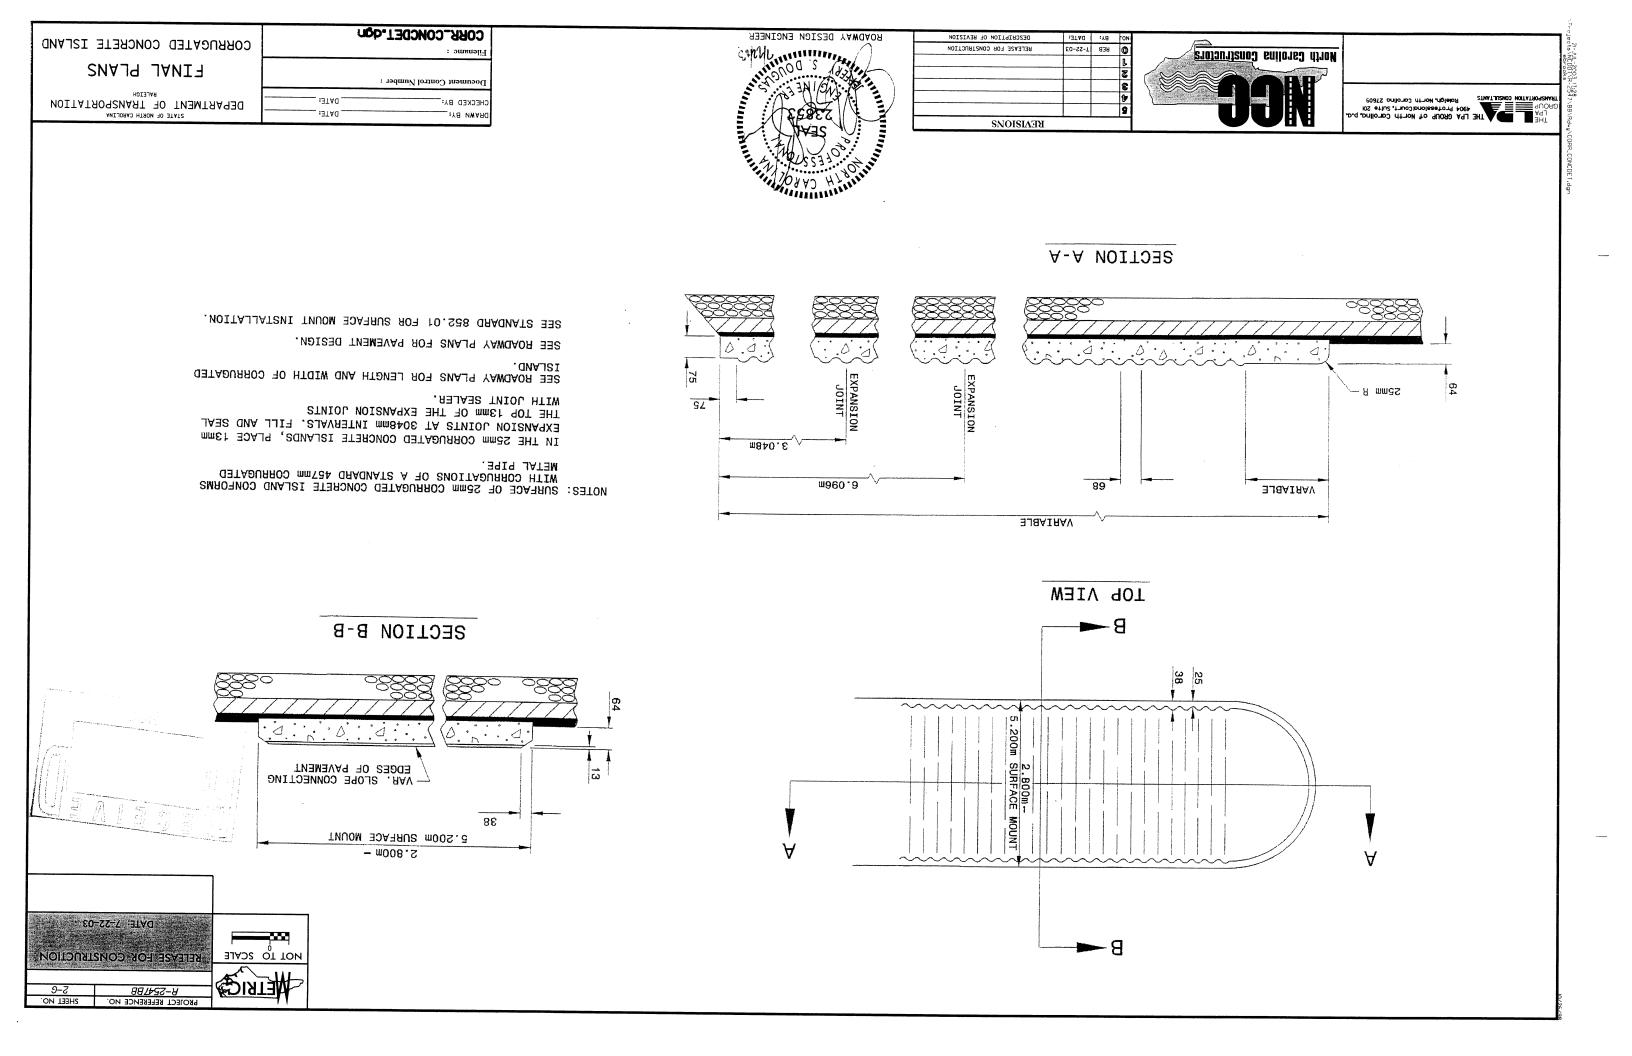


NOT TO SCALE


NOT TO SCALE

RELEASE FOR CONSTRUCTION

ROJECT REFERENCE NO. SHEET NO.

NOILOIS SSOUD ONILYTH HOCK ETVILL

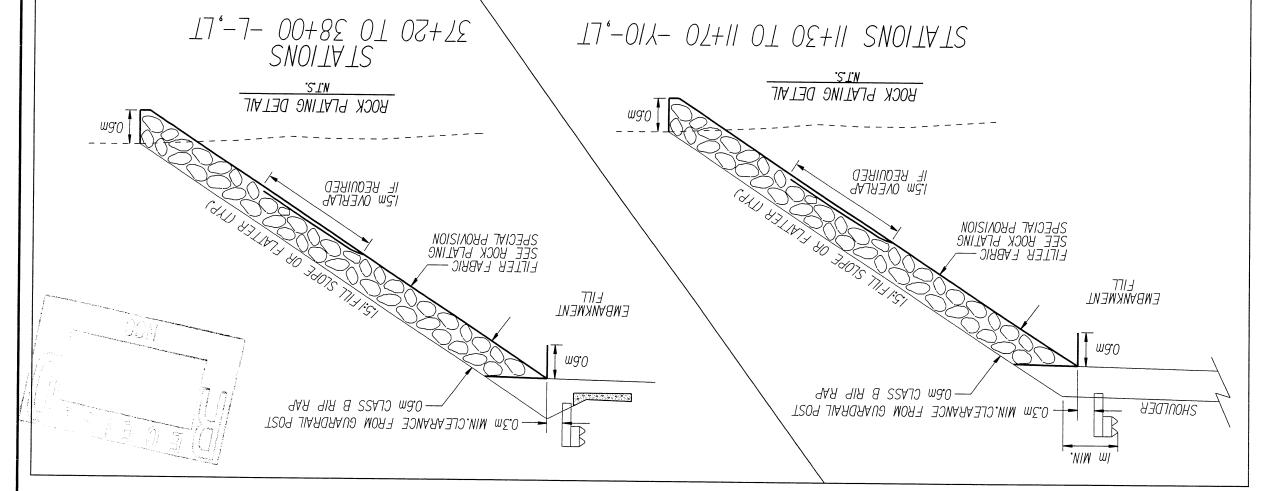

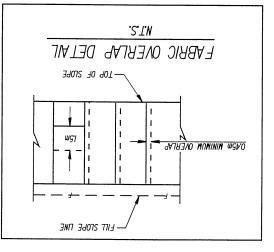

| L PLANS | ETNIA |
|-----------------------------------|-------|
| RALEICH NE TRANSPORTATION RALEICH | |

BOCK PLATING

| | Ејјепате : |
|-------|---------------------------|
| | Document Control Number : |
| DATE: | CHECKED BA: |

LOKPITG_PIn.dgn

| ADWAY DESIGN ENGINEER | ЮЯ |
|---|------------|
| Will | |
| S DOUGH | |
| THE COLUMN | |
| 21/3 July 18 | 3 |
| : Carocki | E |
| X CYBE ! | / 🗐 |
| IN INSTANT | Ξ |
| : 12 J | Ē |
| 107 SS33. | 1111111111 |
| AND HISH | |
| Walling A Strain Contraction of the Contraction of | |
| | |

| DESCRIPTION OF REVISION | 7-22-03 | BA: BEB | 0 |
|--------------------------|---------|------------|----|
| 101101013103 003 3343138 | 1-22-L | 838 | Q |
| | | | 10 |
| | | | 2 |
| | | | 8 |
| | | | 9 |
| | | | 2 |



THE GROUP OF NOrth Coroling, POR Bolds North Coroling, P. (1904 Professional court, Suite 20)

Rorth Carolina Constructors

KOMPIĞU' NOLLU COLONUO 31609

THE LPA GROUP of North Corollnd,
A904 Professional Court, Sulfe 201
A1004 Professional Court, Sulfe 201


| DESCRIPTION OF REVISION | :3TAG | :YE | ON |
|--------------------------|---------|-----|----|
| RELEASE FOR CONSTRUCTION | 7-22-03 | REB | 0 |
| | | | L. |
| | | | 2 |
| | | | 8 |
| | | | 8 |
| | | | 2 |
| KEAISIONS | | | |


| (pow | HYDRAULICS ENGINEER | DESCRIPTION OF REVISION |
|--------------------|--|--------------------------|
| AUDITALI T | · 50[22] L | RELEASE FOR CONSTRUCTION |
| Filename | AND METALLINE | |
| | 115/13/1 10/13/11 | |
| Посите | A COLUMN TO THE STATE OF THE ST | |
| | | |
| CHECKED | | |
| имаяа | | |
| CHECKED DKAWN B | 1 = 2 +CC4 : = | |

| | modifiedfiume.don |
|---------|---------------------------|
| | Ејјеввис : |
| | Document Control Number : |
| .atad | CHECKED BX: |
| - DATE: | Ya wwanu |

DEPARTMENT OF TRANSPORTATION STATE OF NORTH CAROLINA



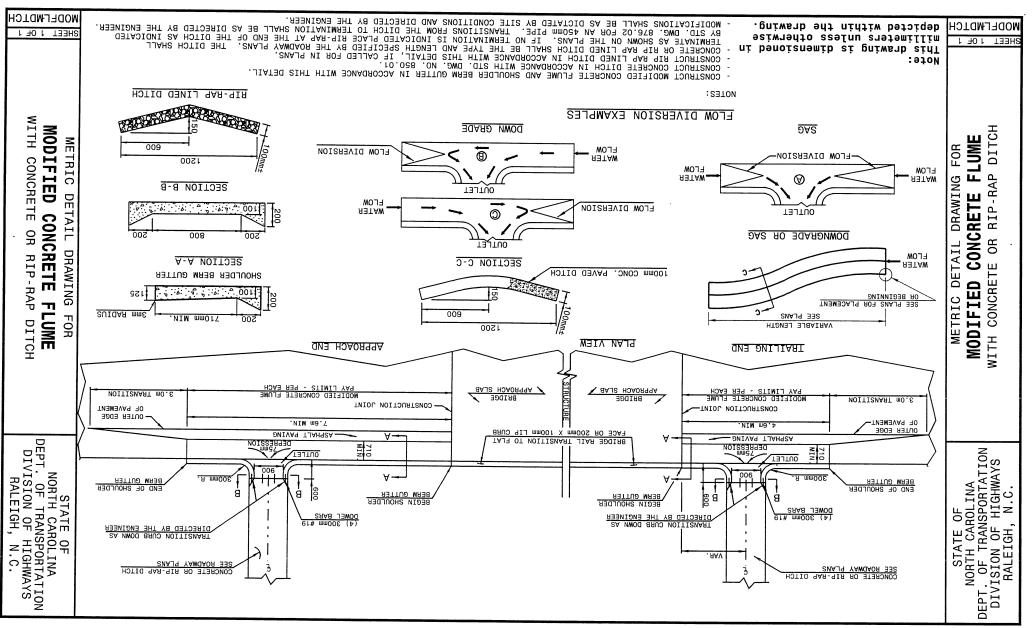


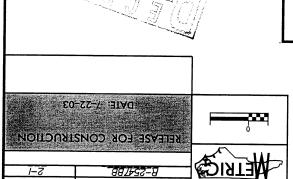


*882)-97-*8

PROJECT REFERENCE NO.

SHEET NO.

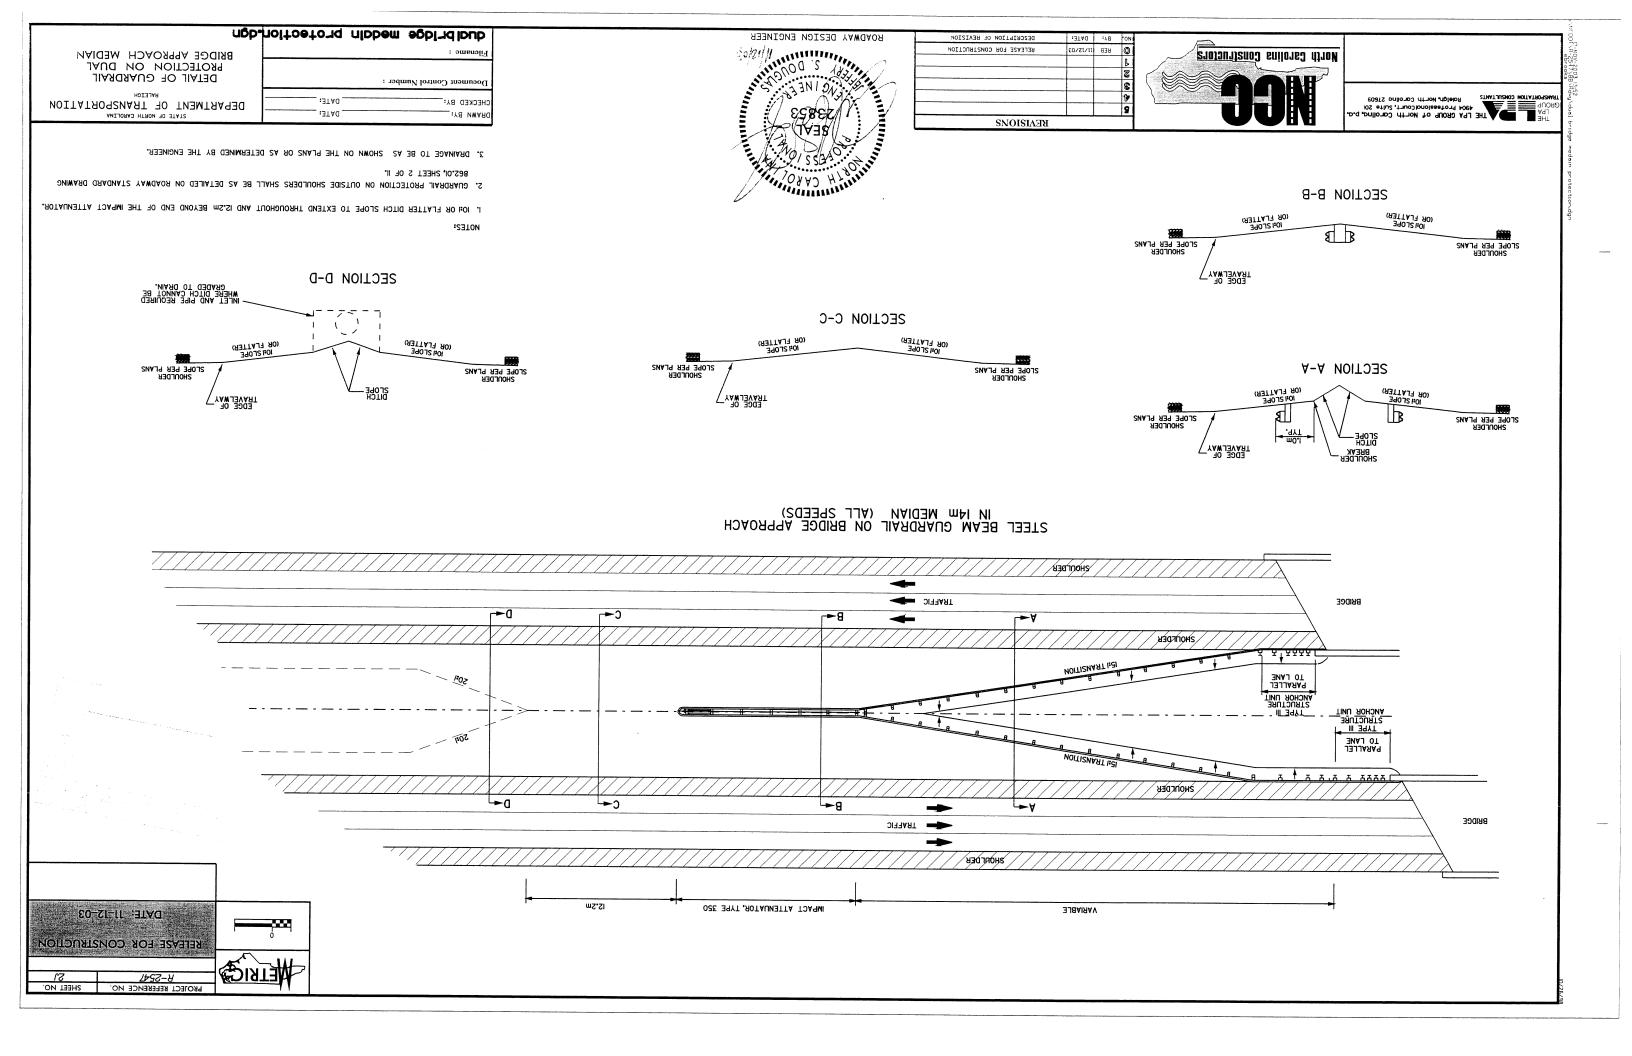

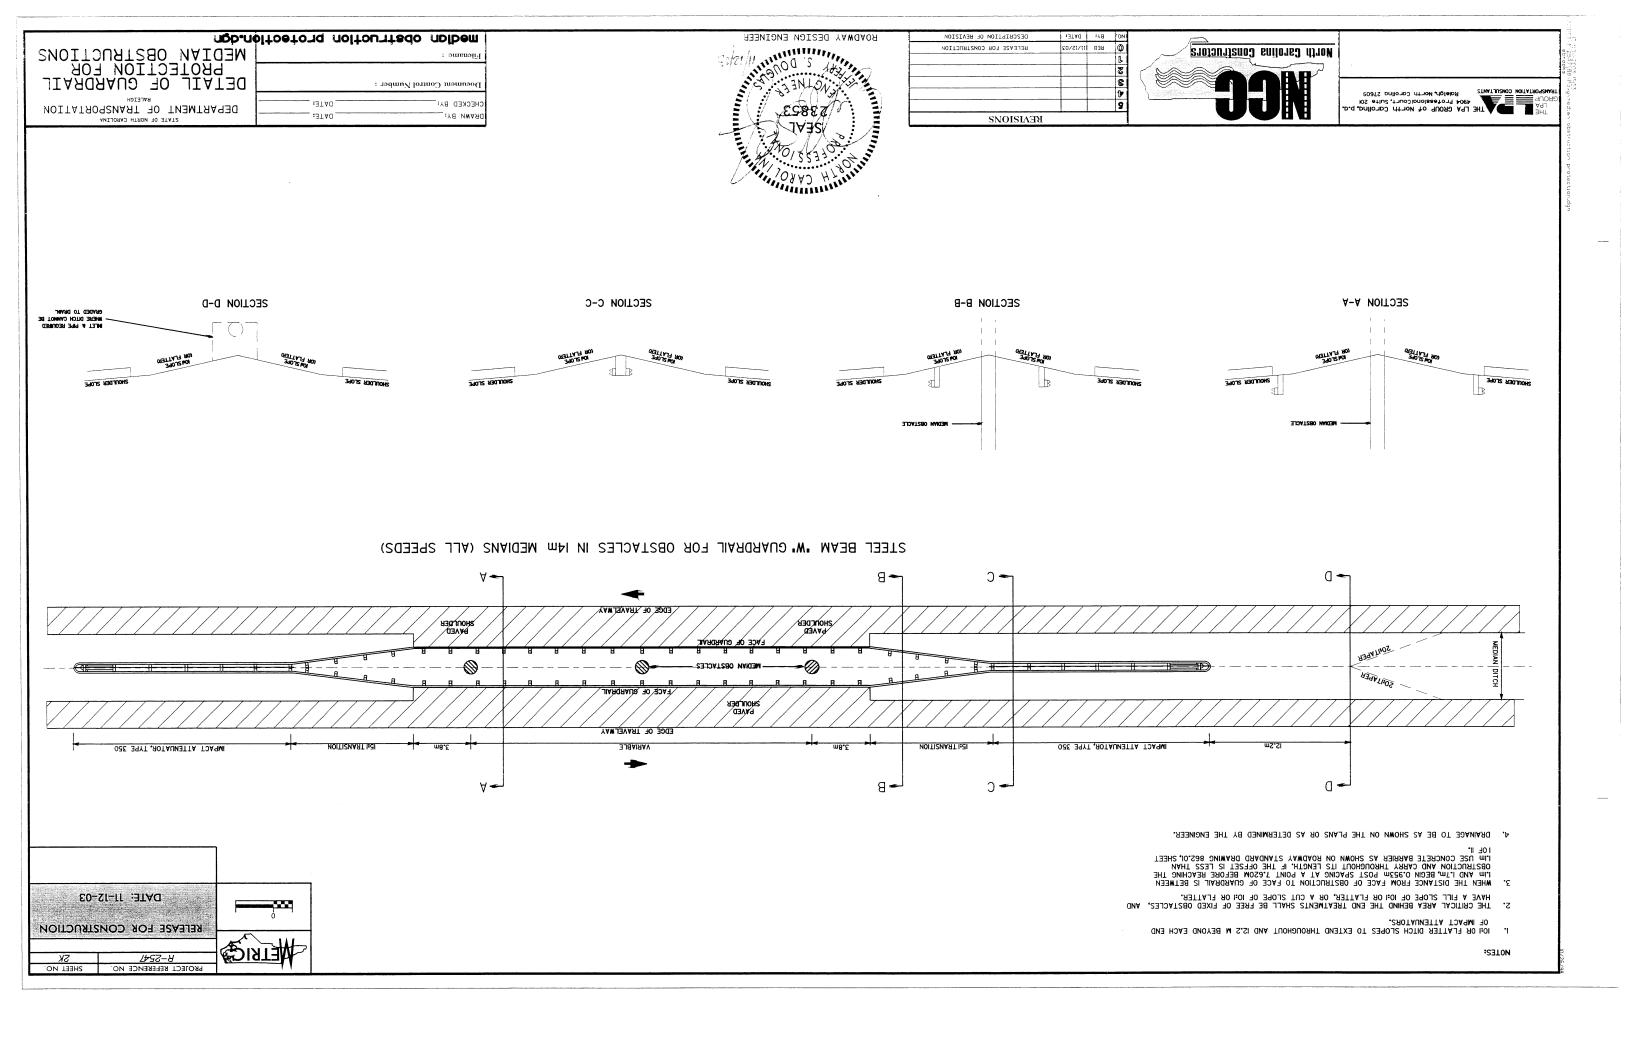


DESCRIPTION OF REVISION NO BY: DATE: RELEASE FOR CONSTRUCTION KEAISIONS

| Z | |
|---|----------------------|
| 4 | enilora Constructors |
| - | |
| - | |
| 1 | |
| 1 | |
| 1 | |

| <u> </u> | ing Cail | oaes dta | nM i | |
|----------|----------|----------|----------------|-------------|
| | | A |] | |
| | | | 609/Z DU | Th Corolli |
| | | | Carolina, p.a. | onal Court, |

THE LPA GROUP of LPA GROUP of LPA GROUP of CASOLITATION CONSULTANTS RAKEPORTATION CONSULTANTS

Lookvane.dgn CHECKED BA: -:YB NWA90

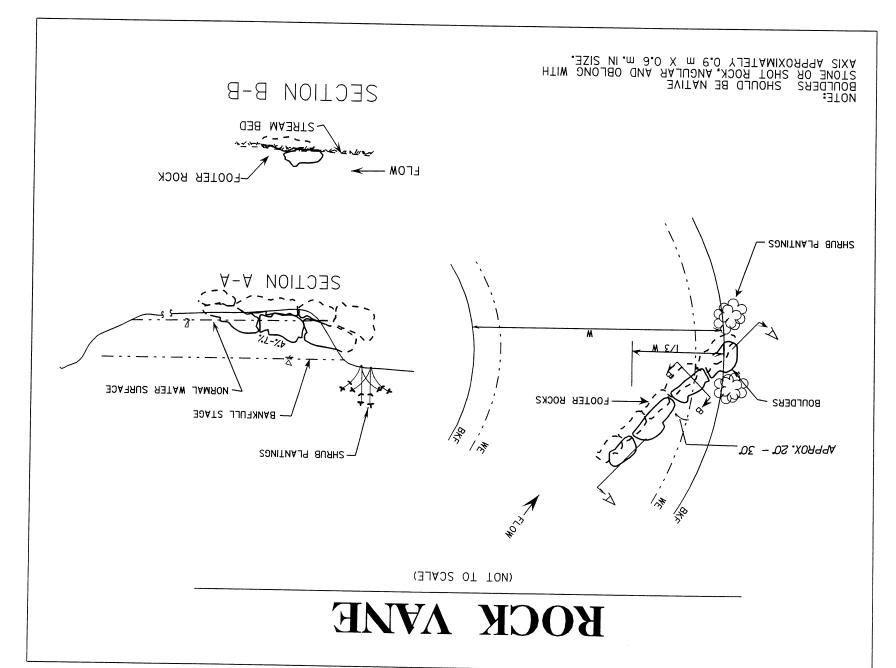

DATE: 12-16-03 KELEASE FOR CONSTRUCTION

FINAL PLANS

DEPARTMENT OF TRANSPORTATION

STATE OF NORTH CAROLINA

. DATE:

. DATE:

B-S247BB 2-L

CUARDRAIL SUMMARY FINAL PLANS

STATE OF HORTH CARDLINA
DEPARTMENT OF TRANSPORTATION
RALEIGH

DATE: CHECKED BA:

. • BTAQ _

guardrall.sum

DRAWN BY:_

HADBANLICS ENGINEER

ROADWAY DESIGN ENGINEER

| DEZCRIBLION OF REVISION | :3TAG | : Y & | ON |
|--|----------|-------|----|
| RELEASE FOR CONSTRUCTION | T-22-03 | REB | 0 |
| STHEMTASH GNE LIANGRALL END TREATMENTS | 11-15-03 | REB | B |
| UPDATED 8-77 ANCHOR UNITS | 12-16-03 | 838 | 2 |
| | | | 8 |
| | | | 9 |
| | | | 9 |
| KEAISIONS | | | |

JATOT

North Carolina Constructors

GROUP of North Caroling, p.g. Professional Court, Suite 20! Meigh, North Corolina 27609

| 910 | н | STMATJL | COME | MOITATS | INANSPOR |
|-----|------|----------------|------|----------------|-----------------|
| ᆚ | F06F | - = | | | A4J 4U0RĐ |
| 99 | 491 | 3ΗΤ.Δ.(| | | BHI. |

| | | | | | | | | | | | Contract of the second | 12837. E | 4.15 | 310,111 | 10101 | | | | | | | | | |
|--|--|---------------|---------------------|-------------|----------|--------------|--|----------|-------|--------------|------------------------|----------------|--------------|-------------|---------------|-----------------|--|-----------------|----------------|------------------|----------------|--------------|--------------------|-----------------------|
| | | | | | | | | | | | 70 | CAR CAR | 111 | 078.99- | 726.6 @ OI | 036-UAI | | ļ | | | | | | |
| | | | | | | | | | | | 14411 | AAD H | • | 027.21 | v ⊚ 11.430 | 035-M | | 3.81mUmm | @ STINU 2(3f) | 021.5213 | YAS | | | |
| | | | | | | | | | | | *** | 11111111 | | S\$1.71- | 506.1 ⊚ 6 | I-TAD | | | | | | | | |
| | | | | | | | | | | | T | | | -24.084 | 120.6 ® A | 77-8 | | | | ≯91.021 9 | JATOT | | | |
| | m285.382 | : | Of | Oι | | | 6 | 7 | 28 32 | JATOT | | | | 086.781- | 32 @ 15.240 | GRAU-350 | | | | 612.≱£8− | DEDUCTIONS | | | |
| | | | | | | | | | | _ | | + | | 020.031- | 217.2 @ 82 | TYPE III | CHOR DEDUCTIONS | NA | | 6984.383 | SUBTOTAL | | | |
| BYBKIEK © BKIDCE 2 COFOWN2 | 22.666 - 40+25.682] | EO + 09) Z | | | | | | ı | i T | | | | | | | | | | | | | | | |
| FILL SLOPE | <u>. </u> | | | | | | 1 | | | | 5.0 | | 042.21 | 9.8 | 8·t | 902.71+01 | | | | 084.0E | ТЯ | 983.74+0f | 10+17.209 | -D-4001- |
| FILL SLOPE | | | | | | | | | - | | 6.0 | | 15.240 | 9.4 | 9.E | 06+SI | 13+40 | | | 085.750 | 11 | 09Z'S6+SI | 000.01+51 | RAMPC_REV- |
| | | | | | | | ` | | - | | 6.0 | | 15.240 | 150.4 | 9.€ | -r- 25 +80 | 12+45 | | | 304.800 | TJ. | 12+91.736 | 950.87 + 22 -1- | -B-9MA9- |
| END BKIDGE | | | | | | + | | | | | | | | | | | | | | | | | | 1 |
| BECIN BKIDCE | | | | | | | + | | l l | £.0 | | 15.240 | | 8.4 | 2.4 | | 13 + 35.764 | | | 016.14 | 18 | 749.77 + EI | 13.7.2E+EI | -sr- |
| BECIM BKIDCE | | | | | | + | | | l l | | €.0 | | 15.240 | 8.4 | 4.2 | 962.96+61 | 13+80 | | | 72.390 | TJ. | 14+04.626 | 952.25+51 | |
| END BKIDCE | | | | | | - | | | l l | | 8.0 | | 0\$5.2f | 8.4 | ζ.μ | 706.92+11 | | | | 002.97 | 18 | \$06.92 + II | 407.E8+01 | -SIY- |
| END BKIDCE | | | | | | + | | | l I | 5.0 | | 15.240 | | 8.4 | 2.4 | | 960.84+11 | | | 019.14 | 11 | 960.84+11 | 981.30 + 11 | -sr- |
| BECIN BKIDCE | | | ++ | | | | | | l i | ε.0 | | 04S.2f | | 2.2 | 2.1 | | 270.68 + 21 | | | 076.62 | 13 | 247.97 + 21 | 270.52+SI | -SIX- |
| EITT STONE | | _ | | | | | | | l l | | 6.0 | | 15.240 | 2.2 | 2.1 | 270.52+21 | | | | | 11 | | | -£1Y- |
| EIT STOLE | | | + | | | - | | | l l | | 6.0 | | 15.240 | 2.2 | 2.1 | 286.36+11 | 08+01 | ļ | | 34.290 | | 282.38 + 21 | 270.52+21 | -£1Y- |
| EIIT STOLE | | | +-+ | | | | | | L L | 6.0 | | 045.2f | 1 | 2.2 | 7.1 | 08+01 | | - | | 090'66 | ТЯ | 285.62+11 | 222.72+01 | -£1Y- |
| EIT STORE | | | | | | | | | 7 | 6.0 | 8.0 | 045.2f | 045.2f | 3.6 | 2.4 | 09+6L | Z8E.3E+II | ļ | ļ | 090'66 | 11 | 285.32+11 | 222.72+01 | -£1Y- |
| EIIT ZIOBE | | | | | | | | | 7 | 6.0 | ε.0 | 05.2f | 05.21 | | | | 06+11 | | | 232.410 | TA | 019.09+ £1 | 002.82+11 | -01Y- |
| | | | | | | | | | 7 | 6.0 | 6.0 | 15.240 | 05.21 | 3.6 | p'7 | 09+01 | 12+00 | | | 0Z0.9ZI | 11 | 12 + 29.070 | 000.02+01 | -0IA- |
| FILL SLOPE | | | | | | | | | z | 8.0 | 5.0 | 07Z'SL | | | 7.2 | 18+30 | 09+81 | | | 089.901 | ΙΧ | 089.19+61 | 000.22+81 | - Þ Y - |
| EITT 2FOLE | | | | | | | | | l l | 6.0 | 1 | 05.240 | 042.21 | 3.4 | 2.4 | 09+81 | 19+20 | | | 95.250 | 11 | 19+50.250 | 000.22+81 | -bY- |
| END BKIDCE | | | | | | | | | ı ı | 1 | ε.0 | 2,531 | 057'51 | 3.4 | λ.Σ | | 127.94+61 | | | 076.62 | RT | 166.37 + 31 | 127.94+61 | -74- |
| BECIN BKIDCE | | | | | | | | | i | | ε.0 | | 05.240 | ≱.€ | 2.4 | 142.13+31 | 00+71 | | | 082.89 | 11 | 128.62+71 | 164.1241 | -74- |
| END BKIDGE | | | | | | | | | | 8.0 | | 05.7701 | 15.240 | 3.6 | ۵.۷ | 129.32+21 | | | | 077.49 | RT | 126.88 + 81 | l9l'l6+ 7 l | -74- |
| | | | | | | | | | · | - 0 | | 042.21 | | 3.4 | 2.4 | | 144.73+21 | | | 076.62 | 17 | 144.70 + 21 | 177.04+2f | -44- |
| HILL SLOPE | | | | | | - | 1 - 1 | | | | | | | | | | | | | | | | | |
| WEDIYN SIGN | | | ı | L | | <u> </u> | | | | | £.0 | | 15.240 | 5.2 | 4.2 | 80 + 20 | 08+87 | | | 079.73F | 11 | 046.74+08 | 000.08+87 | -1- |
| FILL SLOPE | | | | | | | - | | | 2,565 | 2,565 | 38.560 | 095.85 | 5.2 | .AAR. | | 78+20 | | | 089.901 | 11 | 044.47+87 | 097.79+77 | -1- |
| WEDIAN SIGN | | | ı | | | | ' | | - | | 6.0 | | 15.240 | 5.2 | 4.2 | 08+67 | 78+20 | | | 021.891 | TA | 000.18 + 97 | 005.09+77 | -1- |
| FILL SLOPE | | | | | | | | | | 2.565 | 2.565 | 38.560 | 38.560 | 5.2 | .9AV | | 78+20 | | | 086.601 | TA | 044.47+87 | 097.79+77 | -1- |
| FILL SLOPE | | | | | | | | | l | | 6.0 | | 15.240 | 2.2 | 2.4 | 72 + 42 | 09+04 | | | 228.600 | TA | 088.Sh+27 | 70+14.280 | |
| OAEKHEAD 21CH & BARRIER @ BRIDGE 5 COLUMNS | 1945.88 + 92 - 019.E3 + 1 | +65 | + | | | | l l | | | | 6.0 | | 04S.2f | 2.2 | 2.4 | 08+69 | 06+04 | | | 088.831 | 11 | 71+43.830 | 000.08+99 | -1- |
| WEDIAN SIGN & BRIDGE 5 COLUMNS | 22.666 | | + $+$ | | <u> </u> | | | l | l . | | 6.0 | | 045.2f | 2.4 | 8.1 | 945.38+92 | | | | 129.540 | 11 | 911.31 + 15 | 972.38+92 | -1- |
| WEDIAN SIGN & BRIDGE 5 COLUMNS | + | | - | <u> </u> | | | | | | 2.565 | 2.565 | 38.560 | 095.85 | 2.2 | .XAV | 08+09 | 766.38+62 | | | 065.841 | 1,9 | 545.58 + 03 | | -1- |
| WEDIAN SIGN | | | L | l . | | | | | | 2.565 | 2.565 | 38.560 | 38.560 | 2.2 | .8AV | 799.48 | 08+09 | | | | 11 | | £87.45+98 | -1- |
| WEDIAN SIGN | | | L L | <u>'</u> | | | | | | 2,565 | 2,565 | 319.85 | 38.80 | 5.2 | | | 02.09 | | | 065.841 | | 60 + 83,343 | £87.4£+65 | -1- |
| | | | l l | ı . | | | | | | 2,565 | 2,565 | 820.85 | 012.85 | 5.2 | . NAV . | Z0+99 | | | | 089.901 | 1,9 | 042.92+65 | 095.55+45 | -1- |
| FILL SLOPE | + | - | | | | | l | | | | 6.0 | | 012.240 | | | Z0+99 | 20170 | | | 089.901 | 17 | 042.92+68 | 94+52.560 | -1- |
| FILL SLOPE | + | | | | | | l | | ı | | | | 0,631 | 2.8 | Z'# | 23+80 | 00+29 | | | 228.600 | 1,8 | 63 + 83.600 | 000.22+12 | -1- |
| END BKIDGE (WEDIAN) | <u> </u> | | | | | | | | ı | 295.2 | † | 064.11 | | 2.2 | 4.2 | 0l + ZÞ | 46 + 29.235 | | | 83.820 | TA | 220.Ef + 74 | 46 + 29.235 | -1- |
| BECIN BKIDCE (WEDIAN) | - | | l. | l. | | | | | L | | 295.2 | 1 | 005:11 | | .AAV | | 684.88+34 | | | 96 5. 47 | TA | 47 + 13.038 | 244.88.442 | -1- |
| FILL SLOPE | | | | | | | | 1 | | 1 | 8.0 | | 067'61 | | . VAR. | 46+44,459 | | | | 082.89 | n | 8E0.Ef + 74 | 824.44+64 | -1- |
| BECIN BKIDCE | | | | | | | | ı | 1 | | " | | 15.240 | 2.2 | 4.2 | 766.22.997 | 08+19 | | | 042.0f2 | 11 | 7£8.£8 + f2 | 766,52 + 64 | -1- |
| WEDIYN 21CH 8 BKIDCE 3 COFNWA2 | | | | | | | | | 1 | | COCT | | | 174.8 | 4.2 | 41 + 71.322 | 41+30.000 | | | ZZE.ſ≱ | ТЯ | 41 + 71.322 | 41+30.000 | -1- |
| WEDIAN SIGN & BRIDGE 3 COLUMNS | | | t | ı | | | | | + :- | 606.2 | 2,565 | | OIT.IZ | Z:S/ 9.4 | .XAR. | 077.48+f4 | 38+60 | | | 372.046 | T.N | 077.48+f4 | 37 + 92,724 | -1- |
| DW2-3 | | | | | | | | | | 2,565 | - | 34.593 | | 2.2 | .AAR. | 38 + 60 | 492.29+14 | | | 072.93E | 11 | 492.29 + 14 | 37.24+75 | -1- |
| PRIVACY WALL | 000.042 (05+14 - 09+8E) | E) | | | 1 | | | _ _ | | - | - | | | 9. p | 9.6 | S7+17 | 247.88+1A | | | 30.480 | 11 | 247.88 + FA | Z9Z'SZ+l¥ | -1- |
| END BKIDCE (WEDIVA) | | | | | | | | · | | | | | | <i>L</i> .2 | Σ.μ | 38 + 90.000 | \$65.f0+8£ | | | 904.88Z | ТЯ | 38 + 90.000 | 765.10+3E | -1- |
| BECIN BKIDCE (WEDIVN) | | | ı | ı | | | | | L . | 2.565 | - | 750.8≯ | | ۵.۶ | .AAV | | 35 + 84.760 | | | 077.46 | ТЯ | 39 + 49.529 | 35+84,760 | -1- |
| HIFF STOBE | | | | -+ | | | | | | - | 2,565 | | 210.74 | 4.2 | .AAV. | 35+78.427 | | | | £01.17 | 11 | 36 + 49.529 | 724.87+25 | -1- |
| FILL SLOPE | T | | | -+ | | | | L | | _ | 6.0 | | 042.2f | lS9°≠ | ۵.۵ | 35.15+25 | 38+00 | | | 095.982 | 11 | 38+50.822 | 392,19+85 | -1- |
| MEDIAN SIGN | | | | -+ | | | | - l | l | | 6.0 | | 0≯2.2f | 2.2 | ۵.۵ | 33 + 92,102 | 31+70 | | | 012.072 | 18 | 33 + 92.702 | 31+22,192 | -1- |
| MEDIAN SIGN | | 1 | ı | | | | | | l | | 2.565 | | 39.900 | 7.4 | .AAV | 069.57 + 55 | 35+00 | | | 228.360 | 19 | 065.67 + 66 | 31 45.330 | |
| FILL SLOPE | | | | ` | - | | | | l l | 2,565 | | 39.98 | | 7.4 | .AAV | 32 + 00 | 018.13+88 | | | 220.980 | 7.3 | 015.33 + 55 | 31 445.330 | -]- |
| 2005 (112 | | - ON | | | | | | | l | L | | | | 5.2 | 2.4 | CONT. IN BA | 068.94+88 | | | 088.842 | 17 | 33 + 46.890 | 000.00 + IE | -1- |
| | BARRIER FO.Y28 .QTZ | NG NG | 9 | EA | w-320 | ſ-TA | l-TA⊃ \ | 220 B-77 | | END | END | END | END | | | | | | | 000 776 | لـــــنــــــا | 008 77 T E | 31 + 00 000 | -1- |
| REMARKS | CONCRETE | | TYPE 350 | <u> </u> | | | | UA3 | 2 | DNILIAST | НЭАОЯНА | DNUIANT | HDAO844 | нтаім | E.O.L. | TRAILING END | APPROACH END | DOUBLE FACED | CURVED SHOP | THƏIAЯTZ | , ' | 1 | | |
| | SINGLE FACED PRECAST | 1 30 | IDA9MI ATTENUATO | | S | ANCHOR | | | | | | | | SHOULDER | DIST. FROM | | L | | | | госуцои | END 214. | BEG. STA. | |
| | | | | | | | | | | ł | M | FLARE LENGTH | | JATOT | "N" | THIO9 THASSAW | | | LENGTH | | , ! | 1 | | |
| | | | | | | | | | | | | | | L., | | | | | | ŀ | , , | 1 | . 1 | |

DATE: 12-16-03

RELEASE FOR CONSTRUCTION

PROJECT REFERENCE NO. SHEET NO.

METRICE!

GUARDRAIL SUMMARY

G = GETING IMPACT ATTENUATOR TYPE 350 G = GETING IMPACT ATTENUATOR TYPE 350

"V" = DISTANCE FROM EDGE OF LANE TO FACE OF GUARDRAIL.

OTAL SHOULDER WIDTH OF FLARE FROM BEGINDING OF TRAVEL LANE TO SHOULDER BREAK POINT.

FLARE LENGHH = DISTANCE FROM BEGINDING OF TRAVEL LANE TO SHOULDER BREAK POINT.

FLARE LENGH = DISTANCE FROM BEGINDING OF TRAVEL LANE TO SHOULDER BREAK POINT.

C = GATHUR IMPACT ATTRUITATOR TYPE FROM BEGINDING.

| :3TAQ | :, | CHECKED B |
|---------------|---------|-----------|
| DATE: 2-28-03 | BA: KEB | COMPUTED |


guardrall.sum HADBAULICS ENGINEER ROADWAY DESIGN ENGINEER DESCRIPTION OF REVISION North Carolina Constructors S DONOUTE S DONO RELEASE FOR CONSTRUCTION Ø REB 7-22-03 COLDERAIL SUMMARY Filename: BEB 11-15-03 IAU-350 MEDIAN CUARDRAIL END TREATMENTS FINAL PLANS Occument Control Number: THE LPA GROUP Of North Caroling, p.g. ASOUP Of North Caroling p.g. ASOUP OF THE Caroling STG09 Professional Court, Suite 201 DEPARTMENT OF TRANSPORTATION
RALEIGH
RALEIGH DATE: _ CHECKED BA: . :3TAO _ THE NWARD KEAISIONS 3636.645 JATOT m0.87 = (m8.7 @ 01) :21UU DN3 223 m008.è£ſ = (mò.7 @ 8ſ) :ZTINU ROHDNA JATOT ress 10 END UNITS 000.47 STINU NA92-DIM 8 3712.645 JATOTAU 094.677 000.05 + 88 042.08+87 712,2731 £44.98+03 099.19+77 124.638 59+28.653 252.23+65 727.322 094.44.46 861.91+74 130.995 36 + 55.629 -1-39.230 31+39.230 31 + 00.000 HENGTH END STA. **Y**MCHOK2 REMARKS DATE: 11-12-03 RELEASE FOR CONSTRUCTION


METRICE!


8-52448


PROJECT REFERENCE NO. SHEET NO.


CHECKED BA: DYLE: 7-58-03

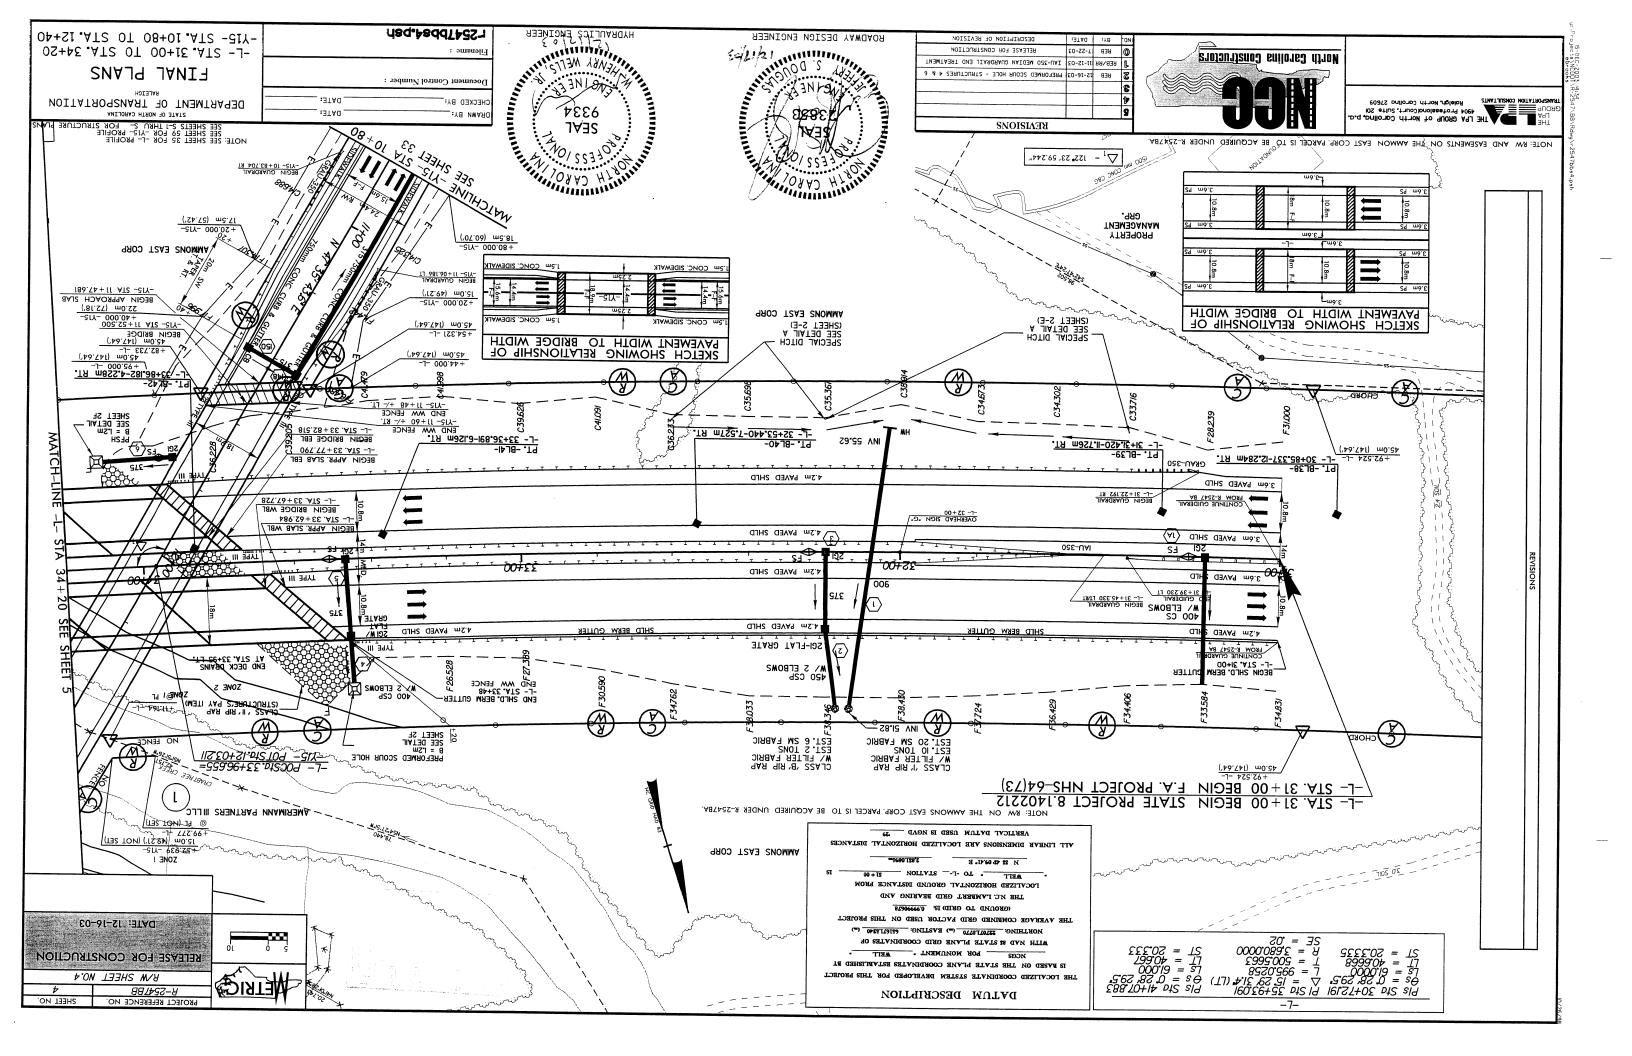


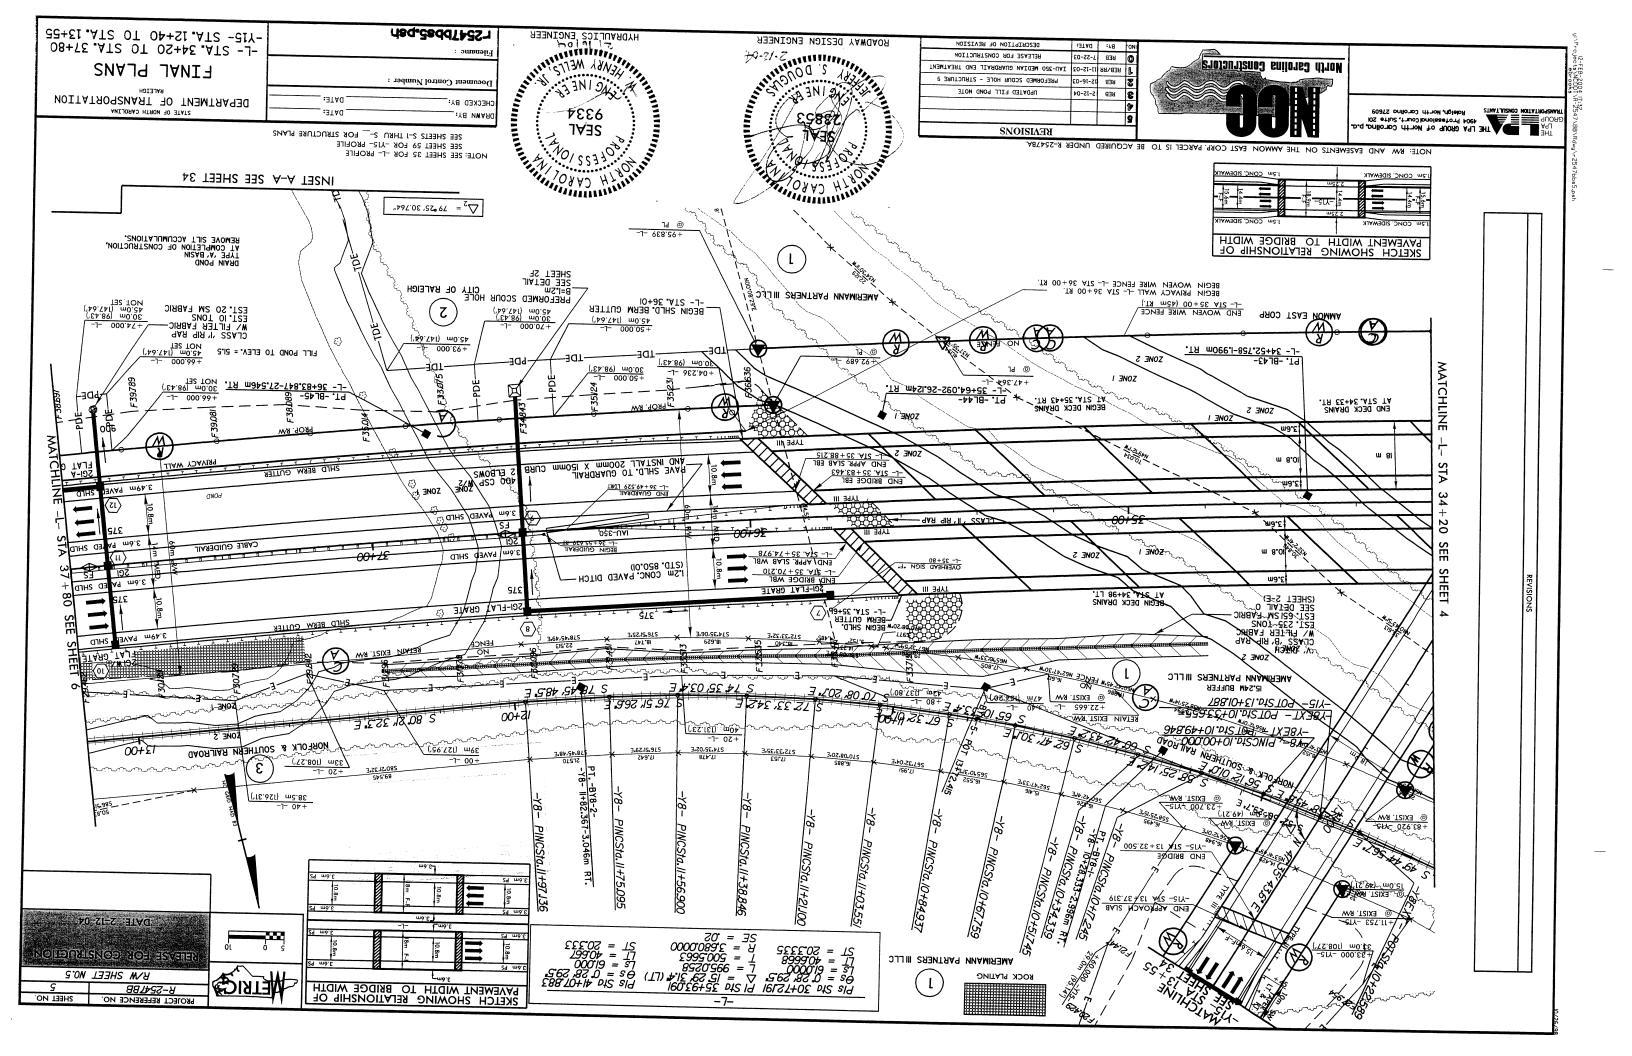


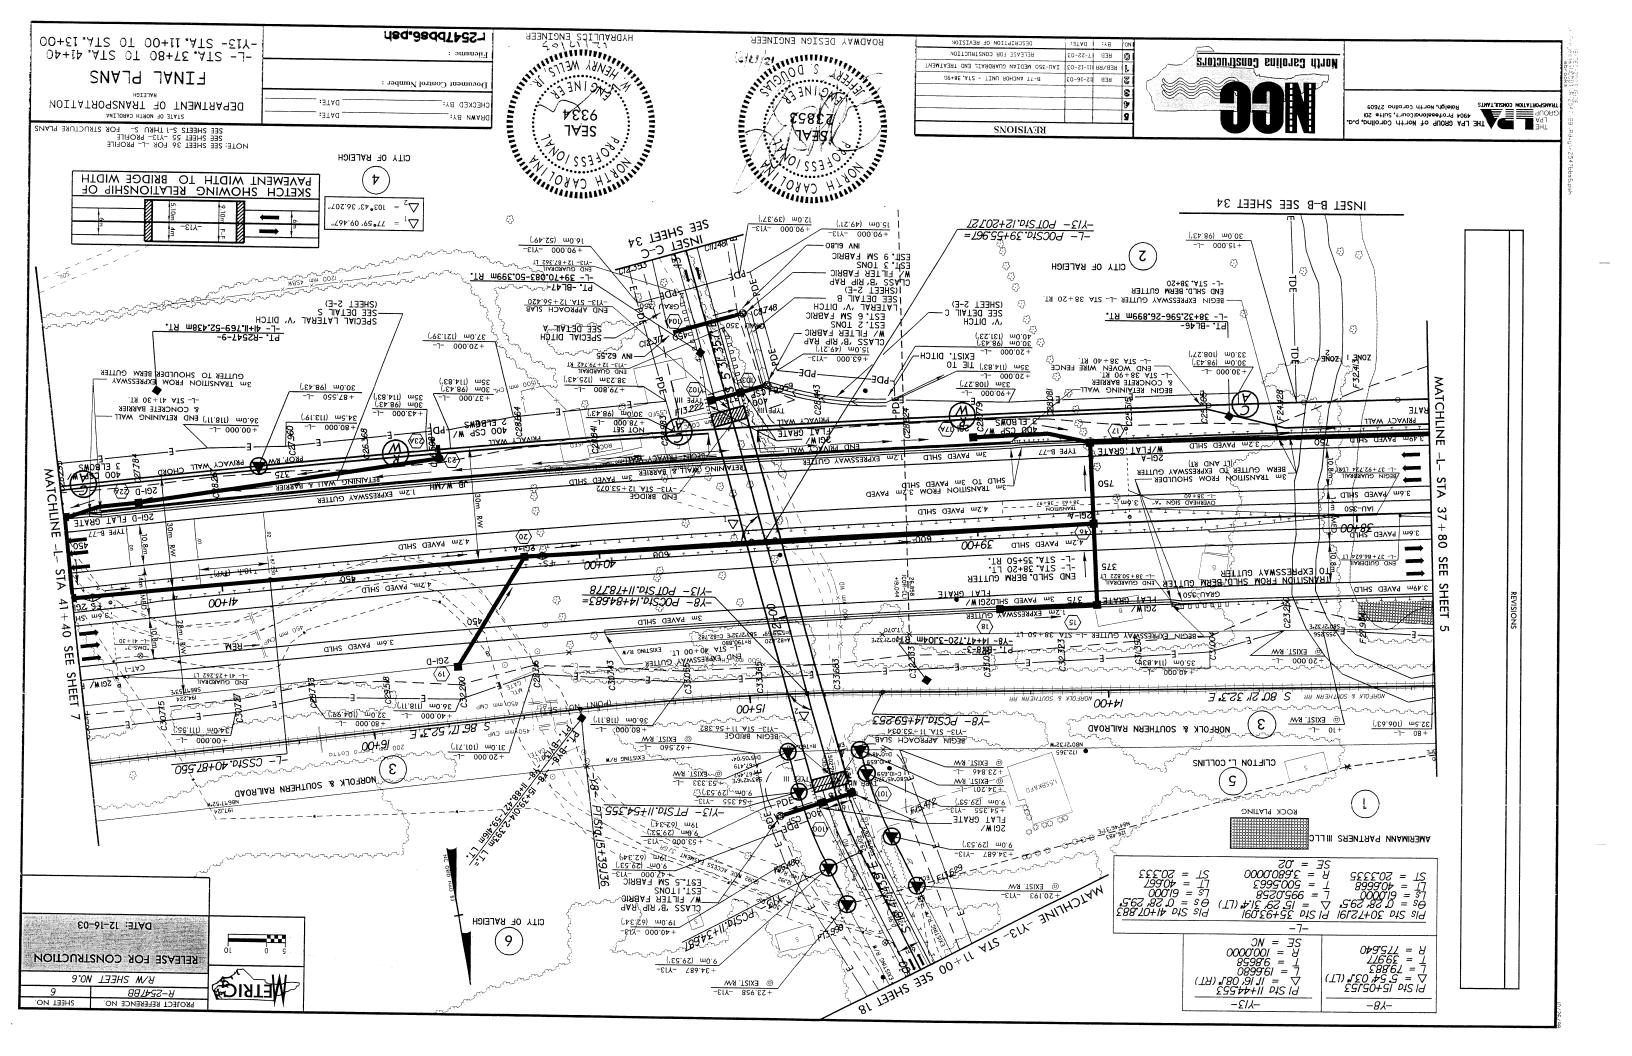


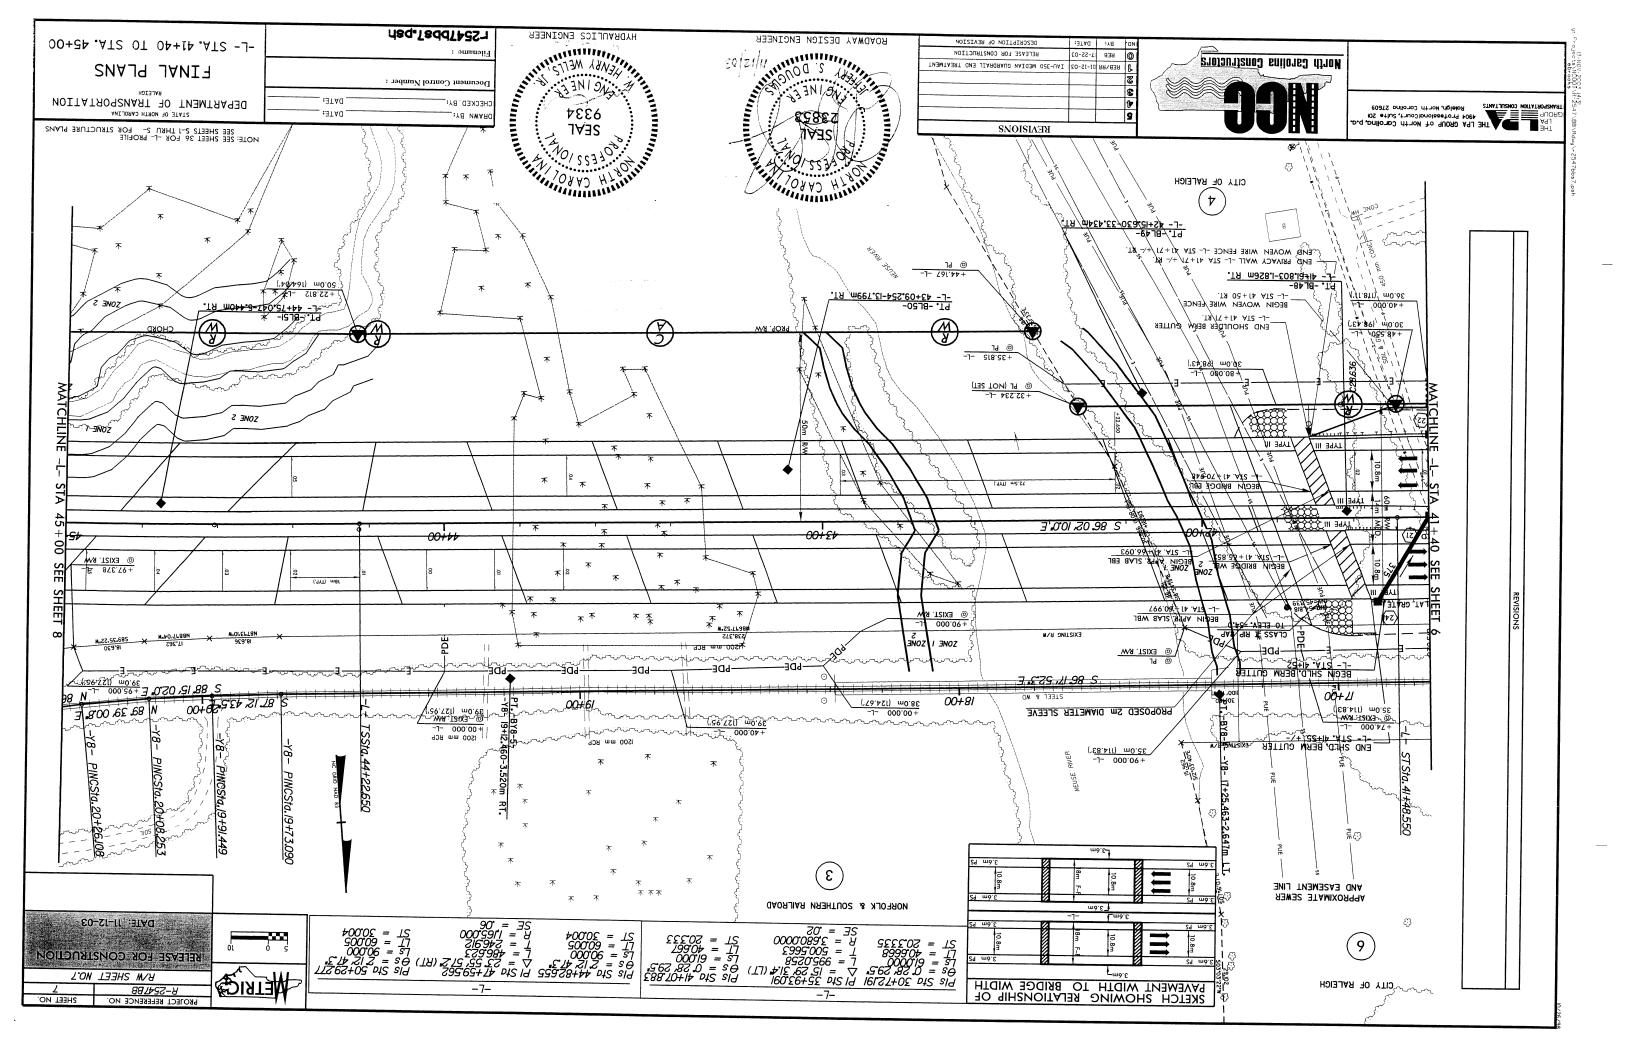


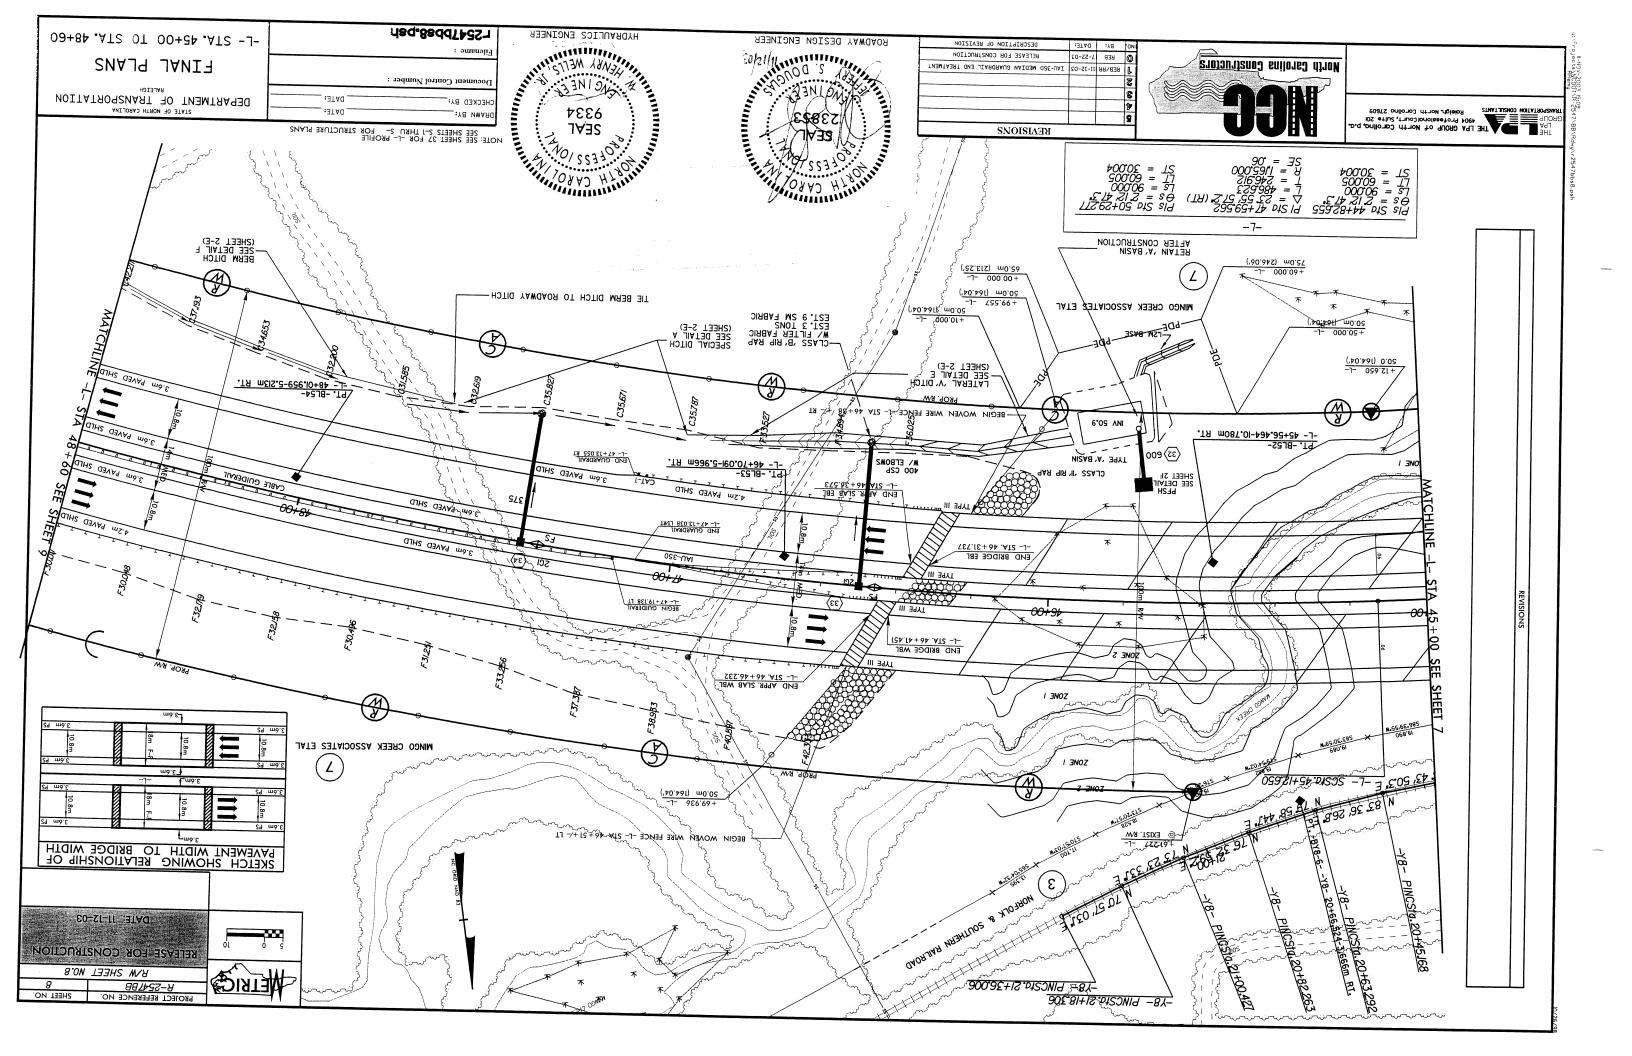


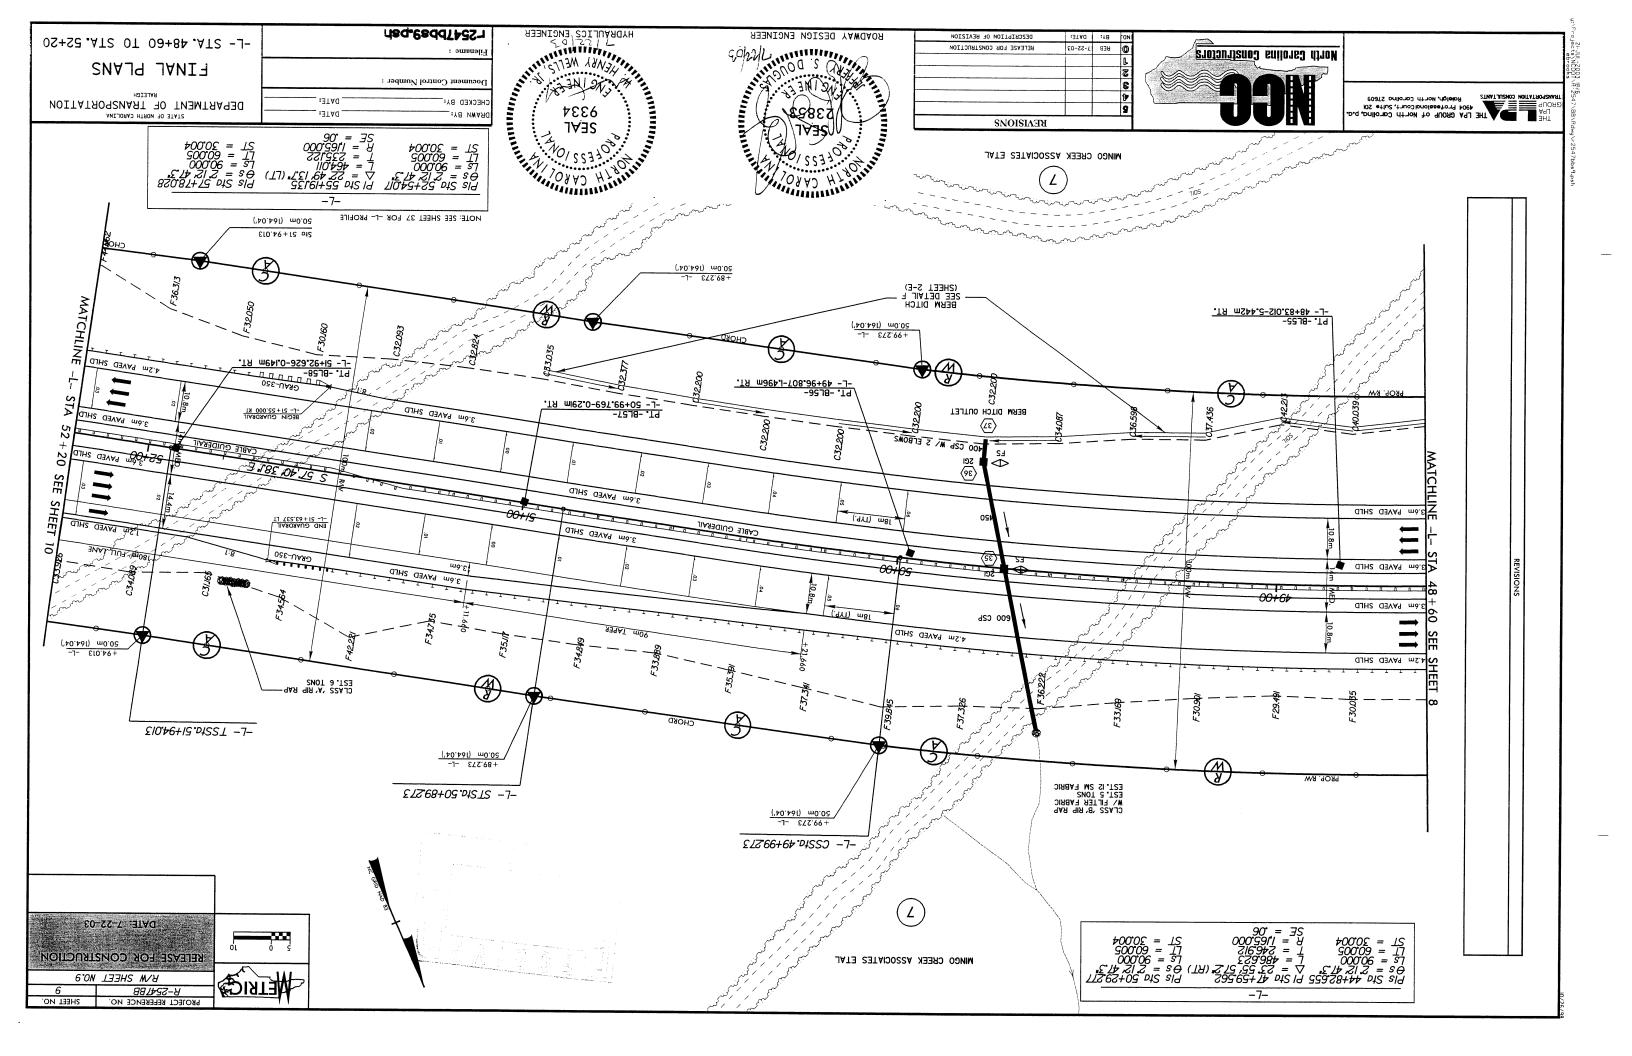


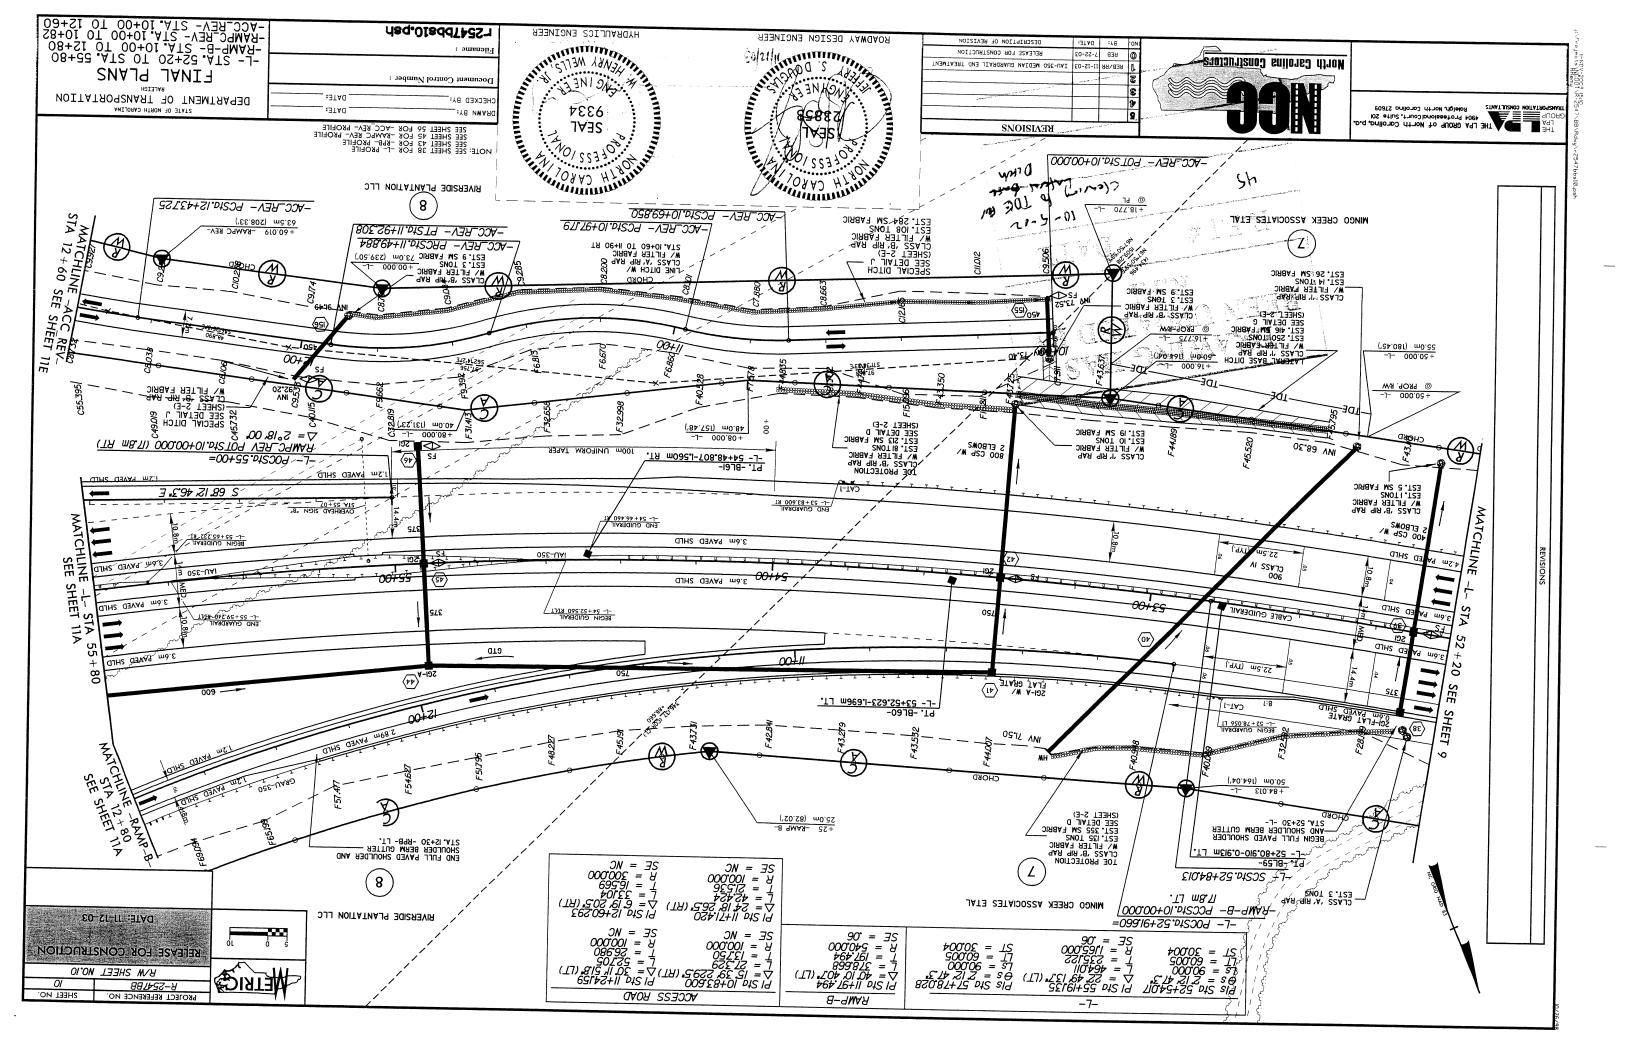


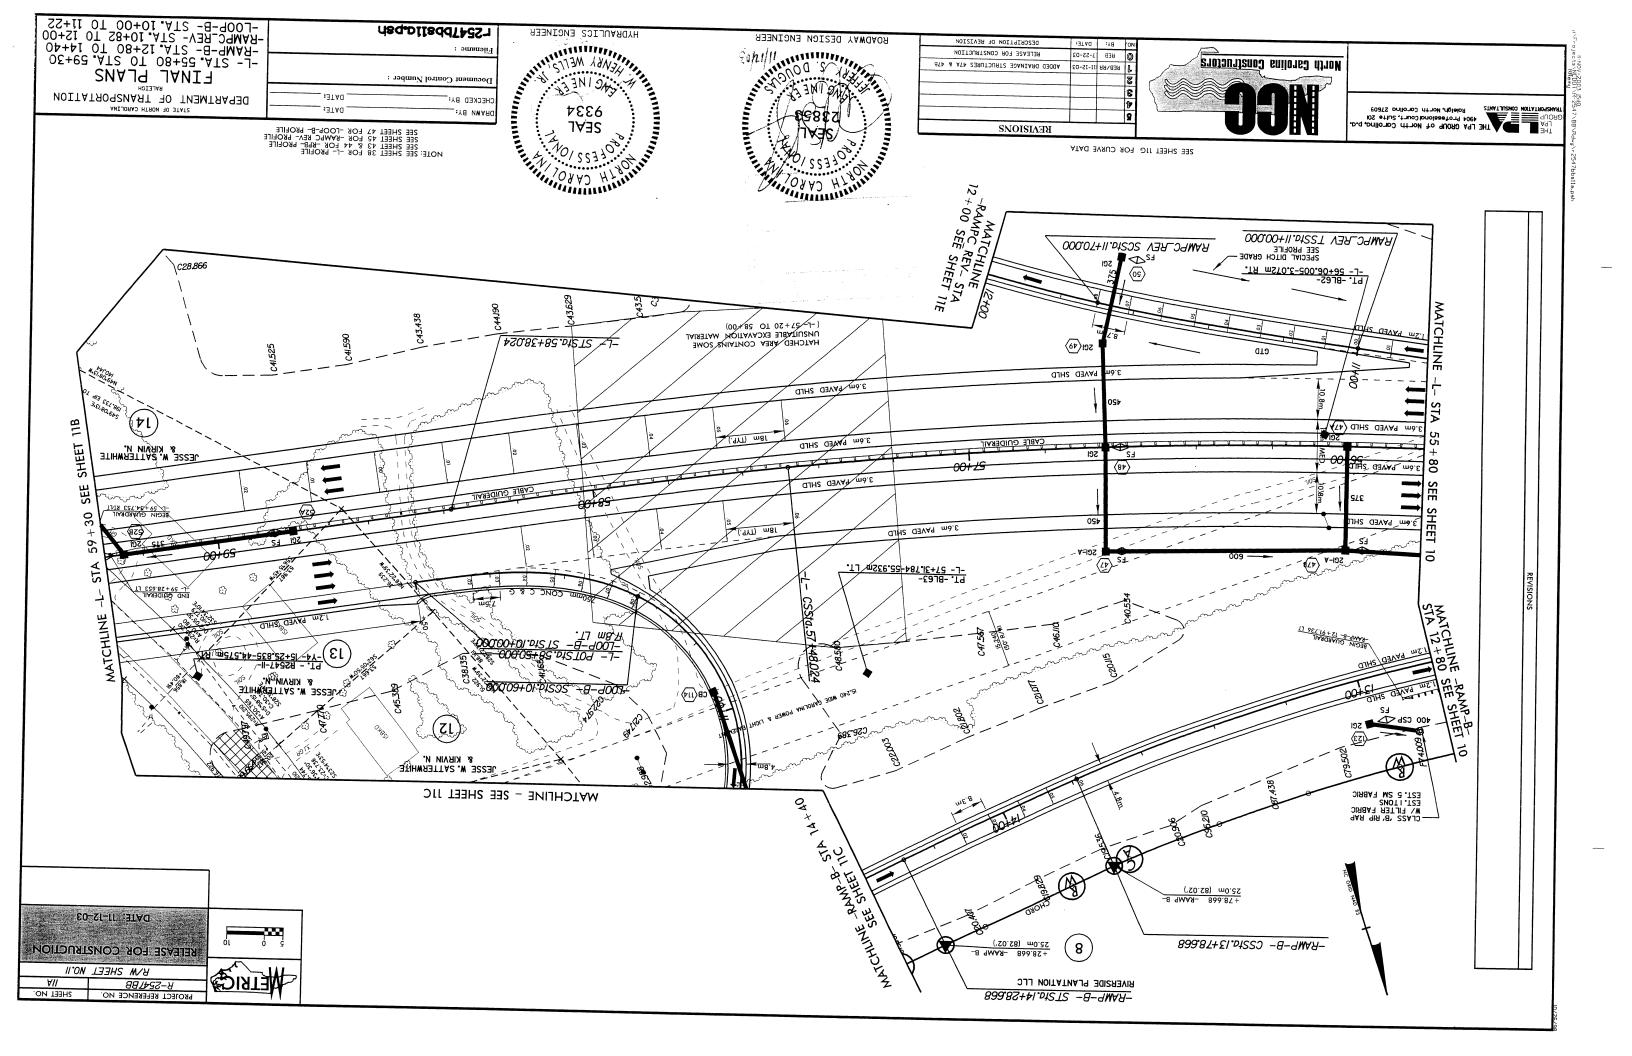


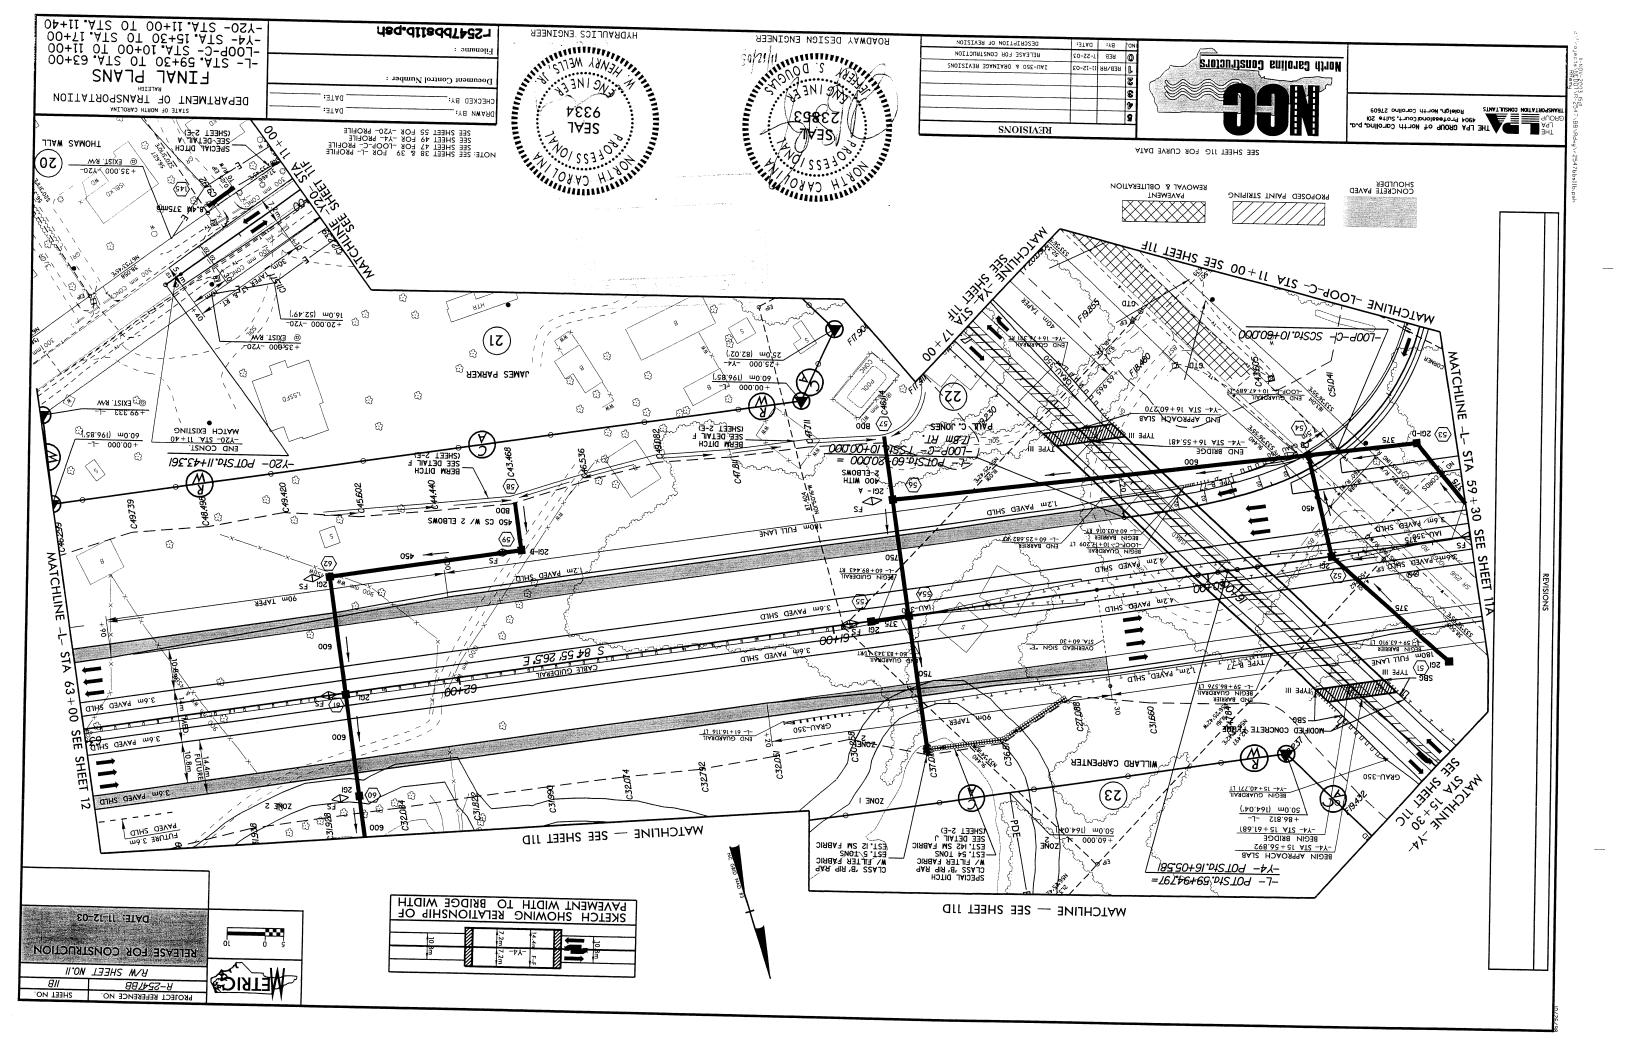

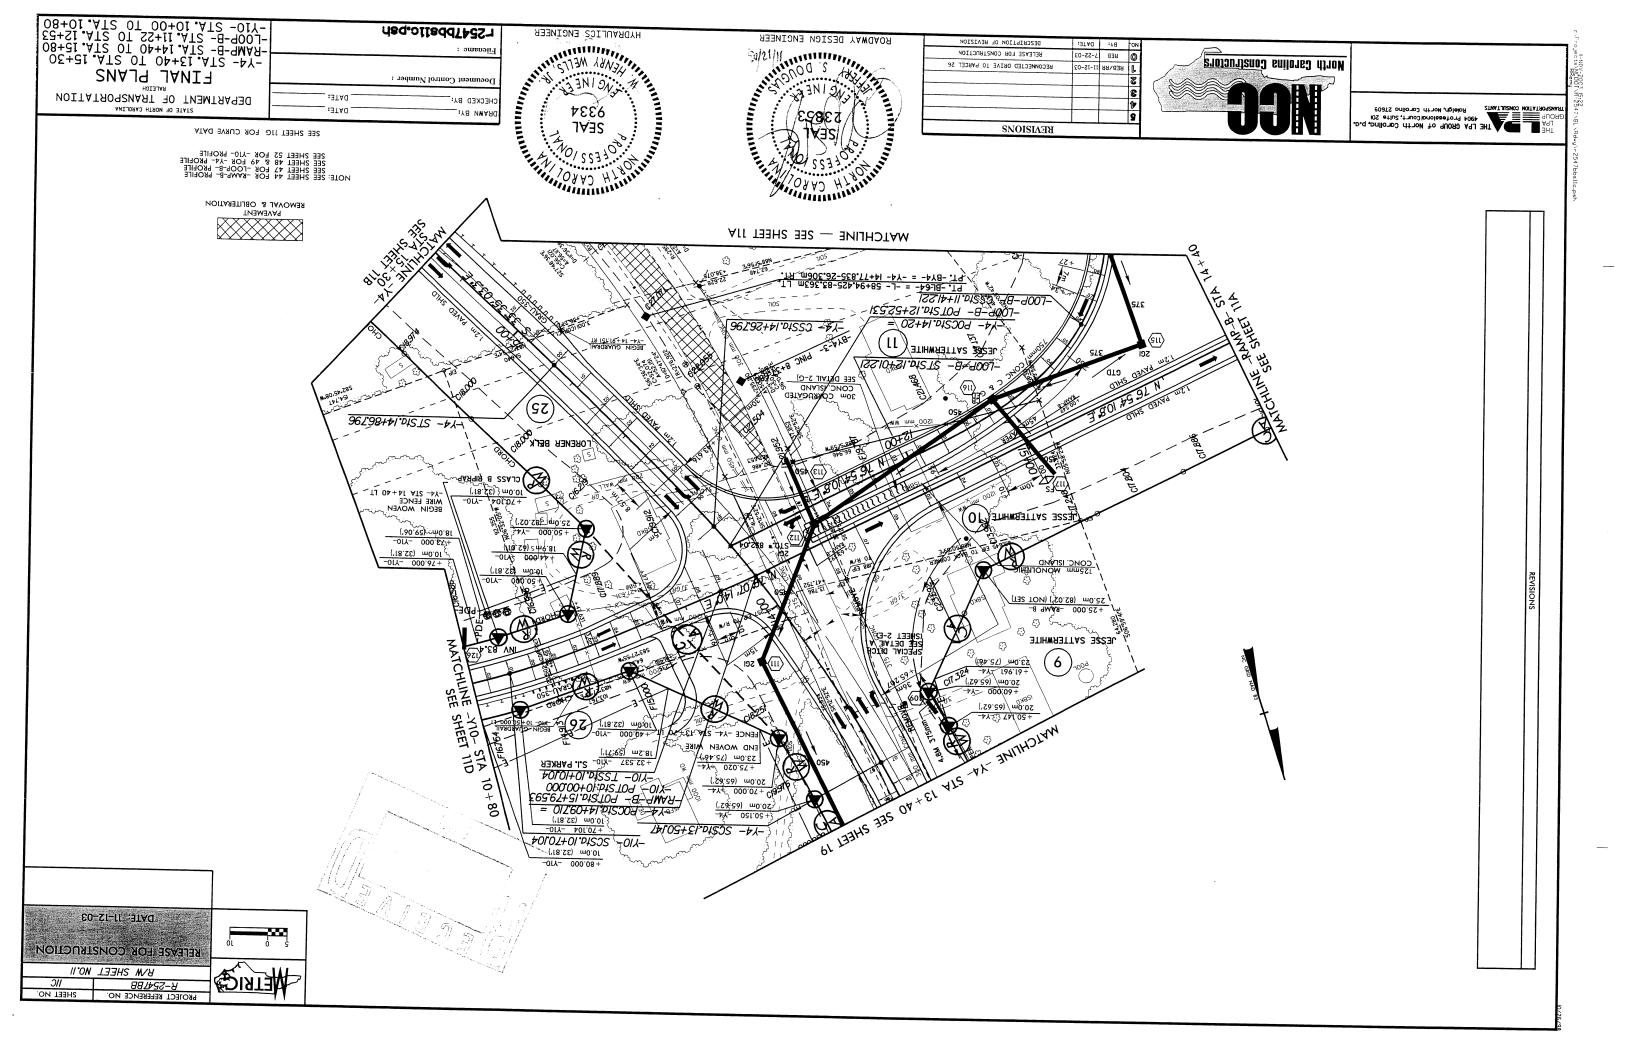

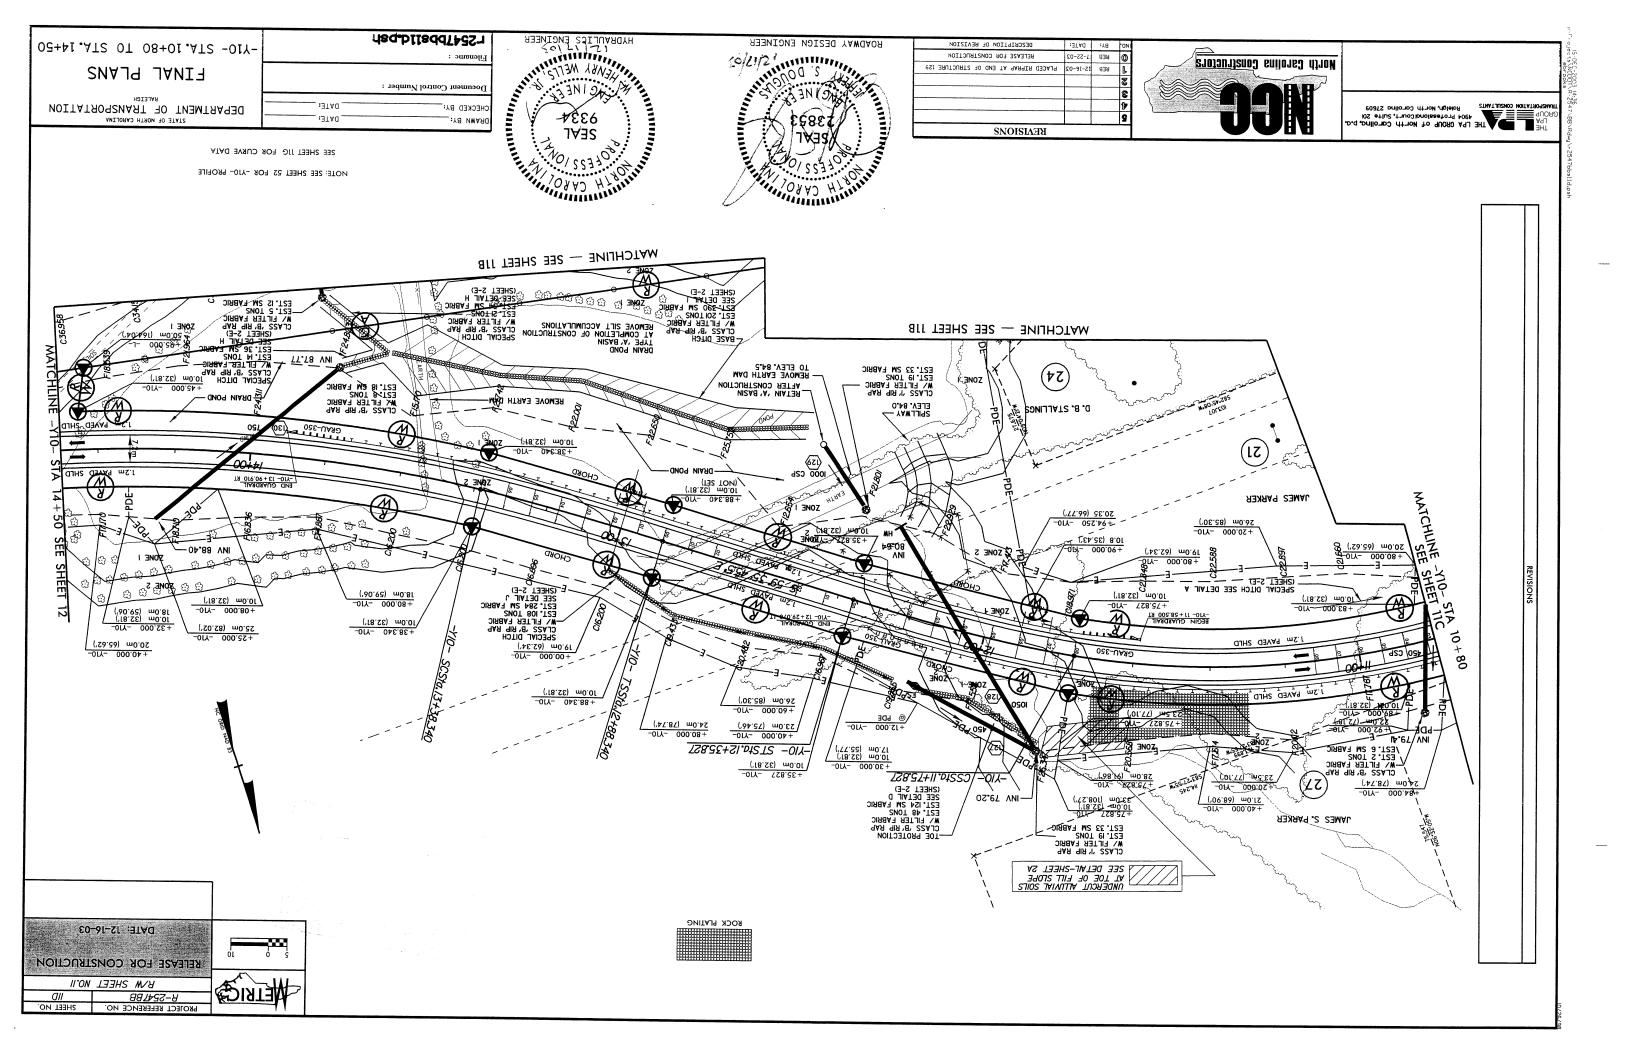

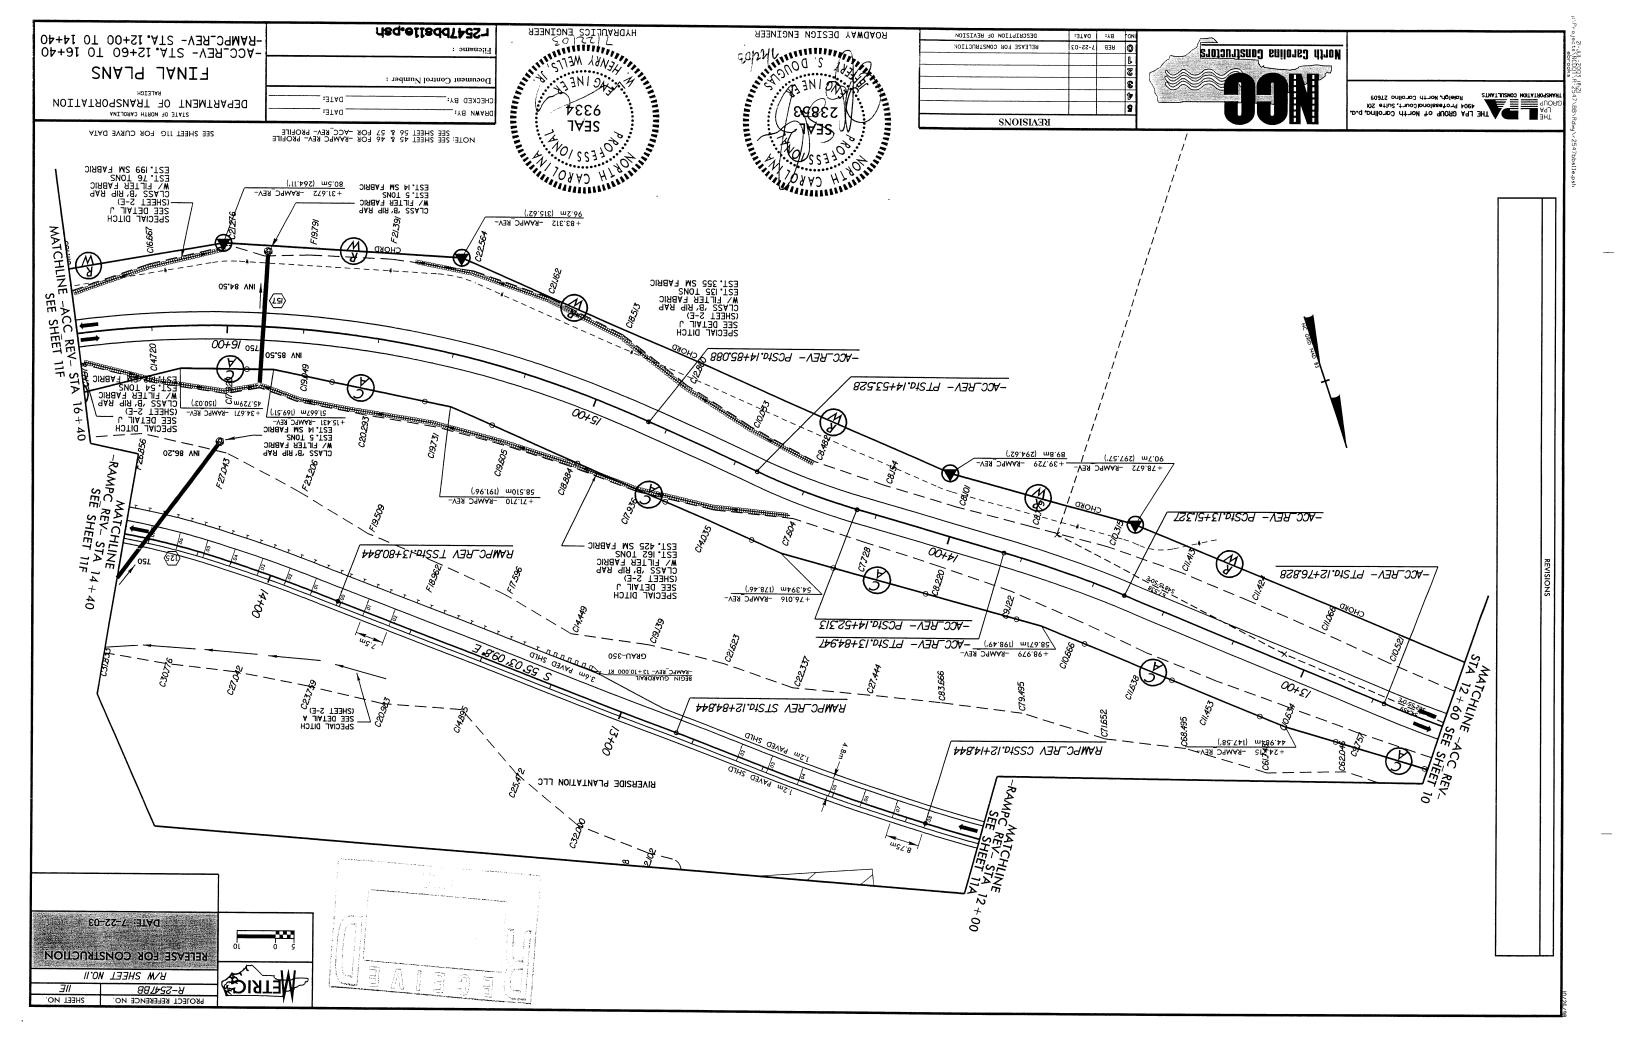

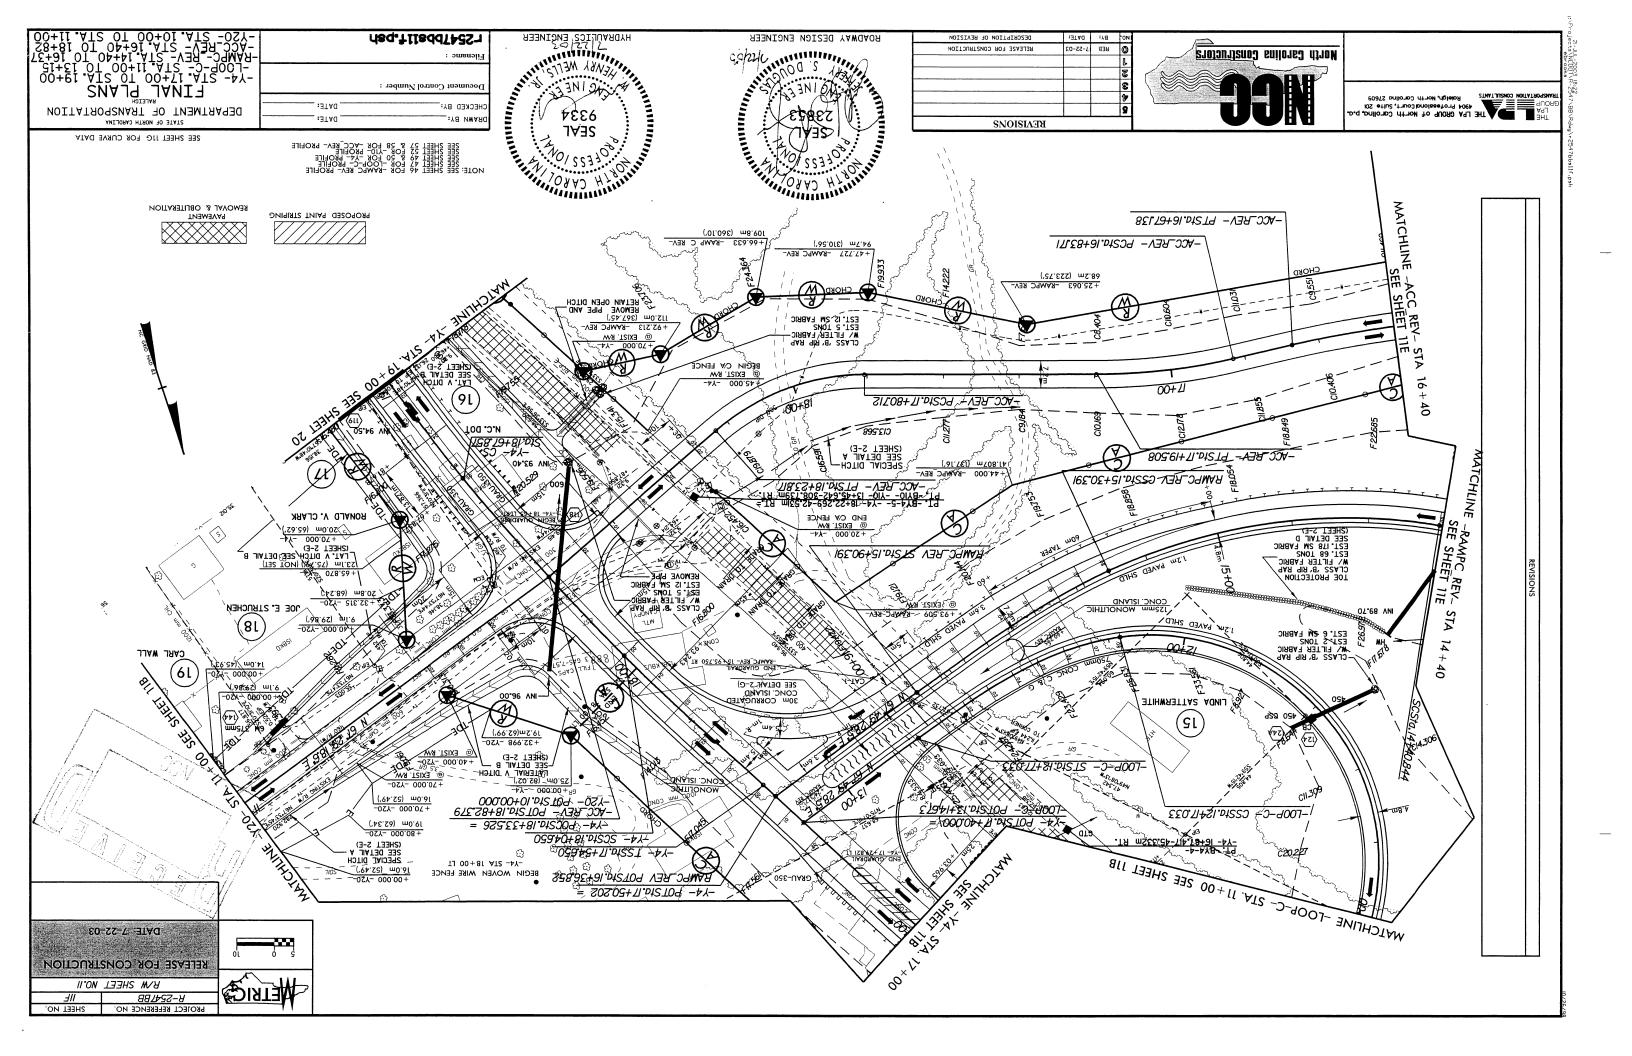

CHECKED BY:

Document Control Number:




EINAL PLANS

PARETCH

RALETCH

ARETCH

AR

BOVDMAY DESIGN ENCINEER

2 DO NESSES

1 SERVINE










THE LPA GROUP of North Corolling, p.c. PAGUP OF Worth Corolling, p.c. PAGUP PAGUP OF WORTH Corolling, p.c. Rependenting Steep



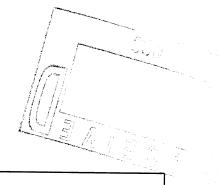



KELEASE FOR CONSTRUCTION


HETRICE PROJECT REFERENCE NO. SHEET NO.

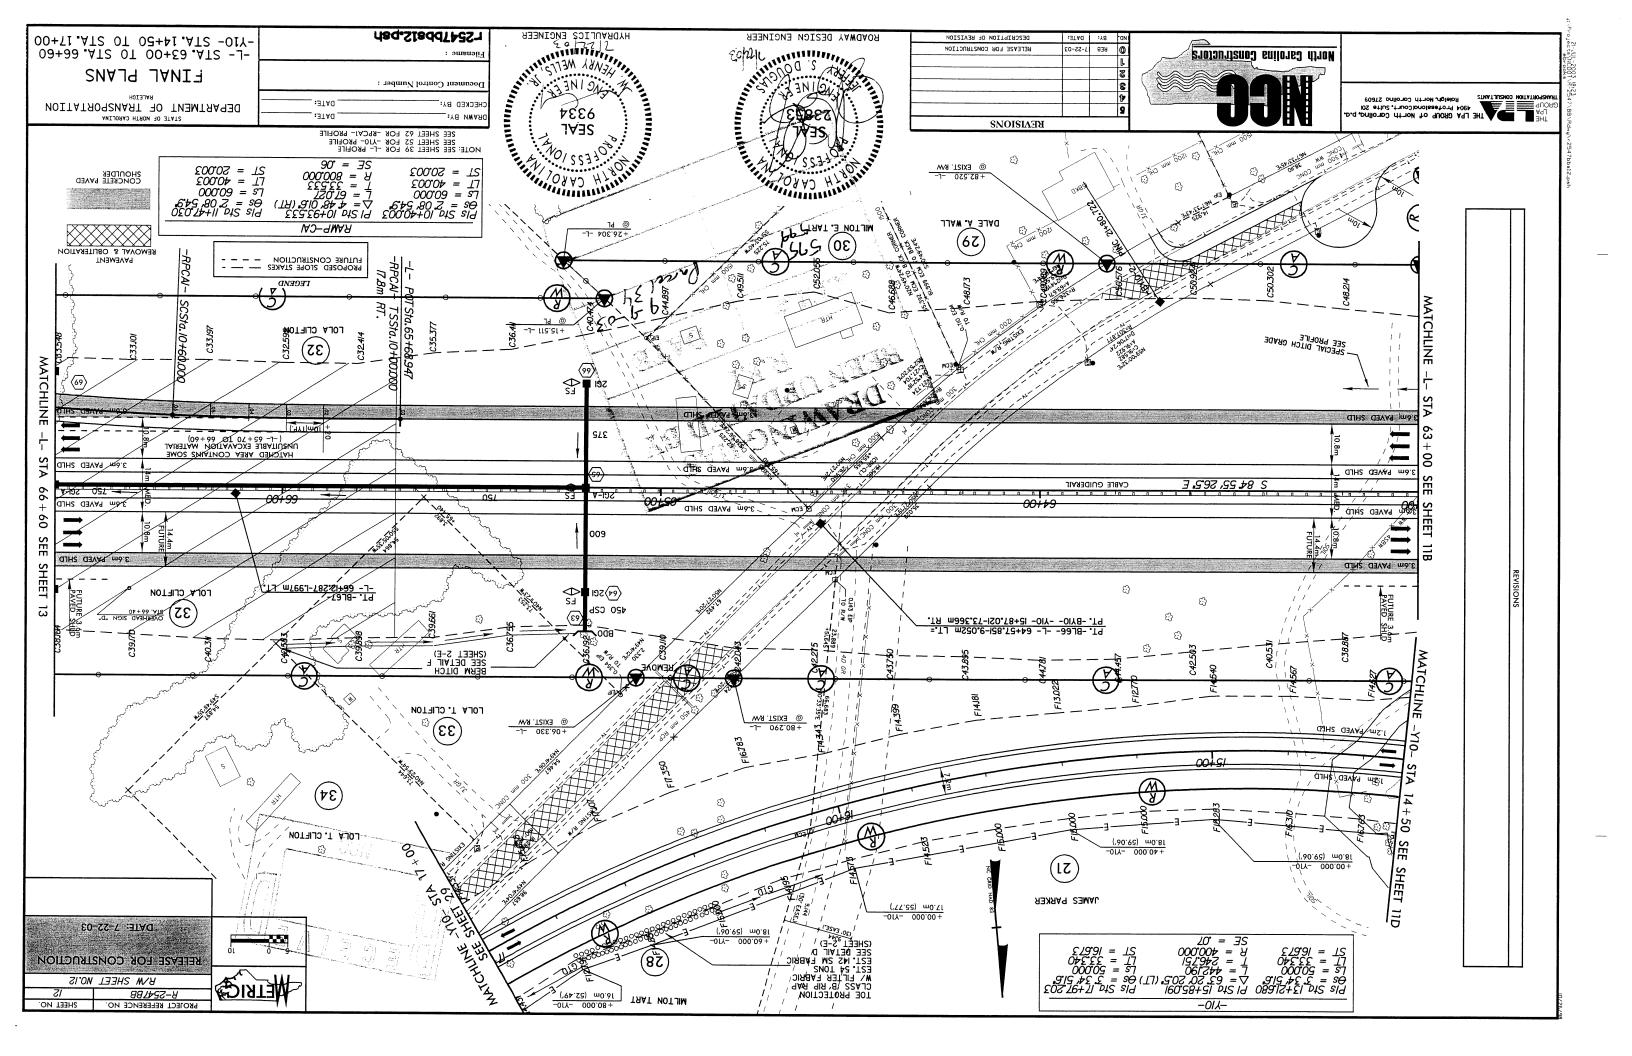


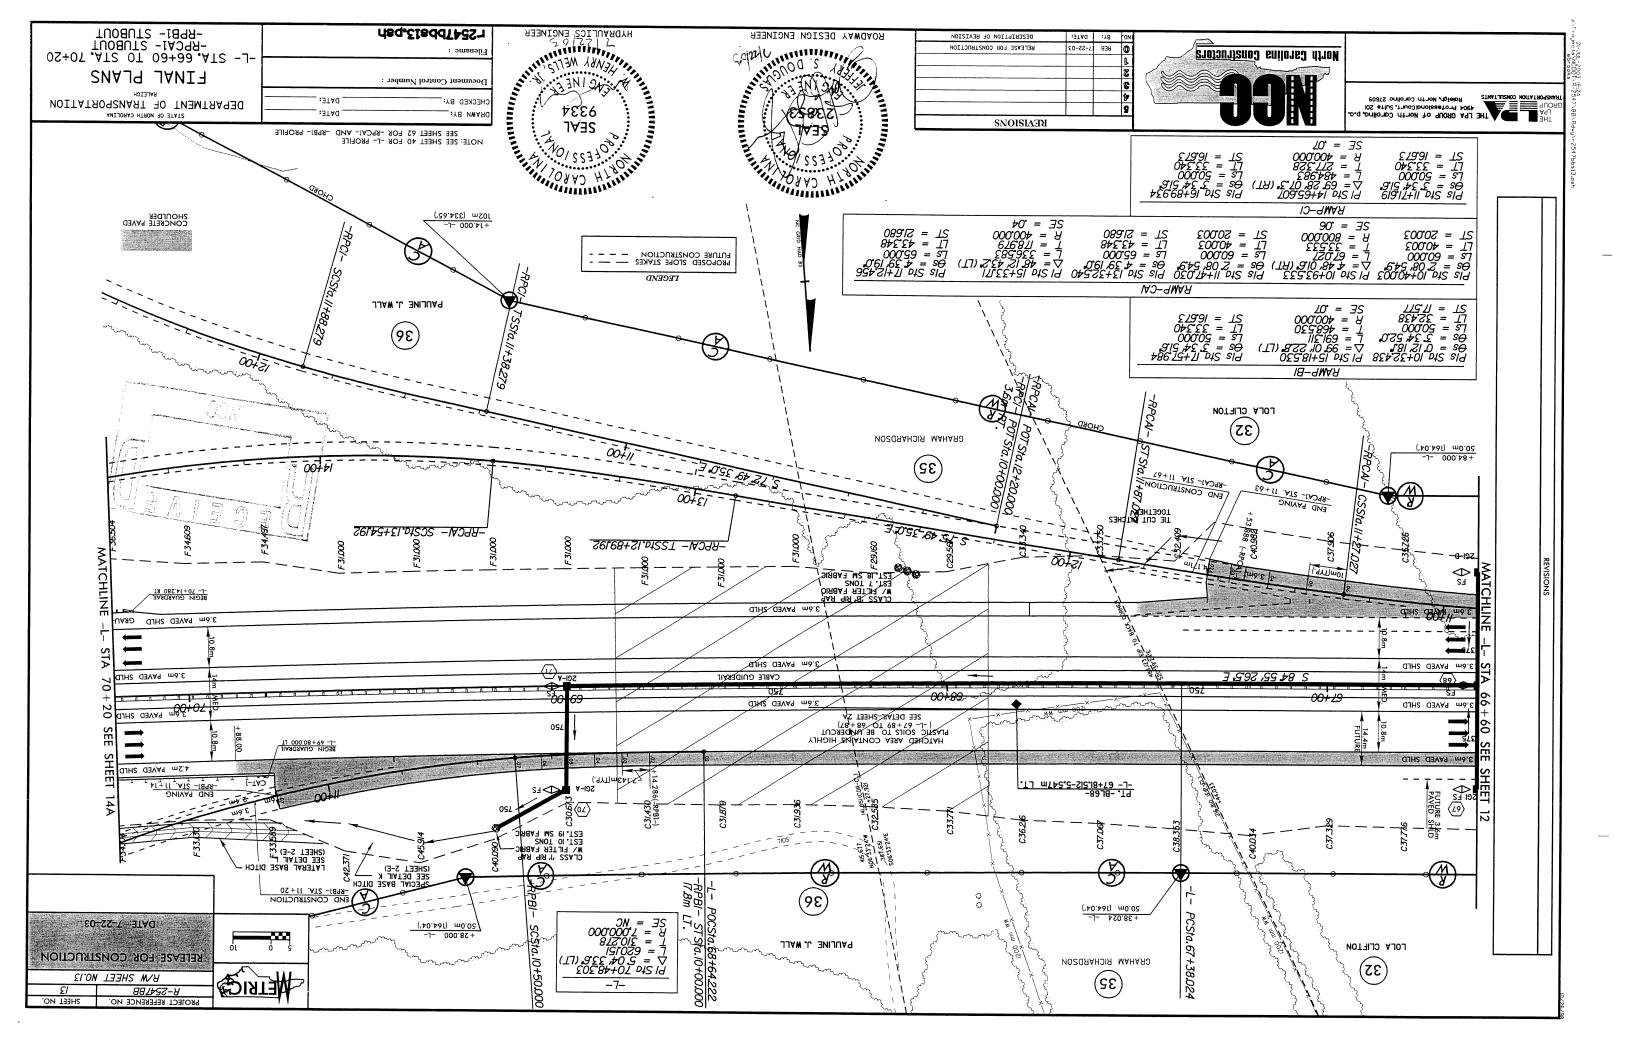


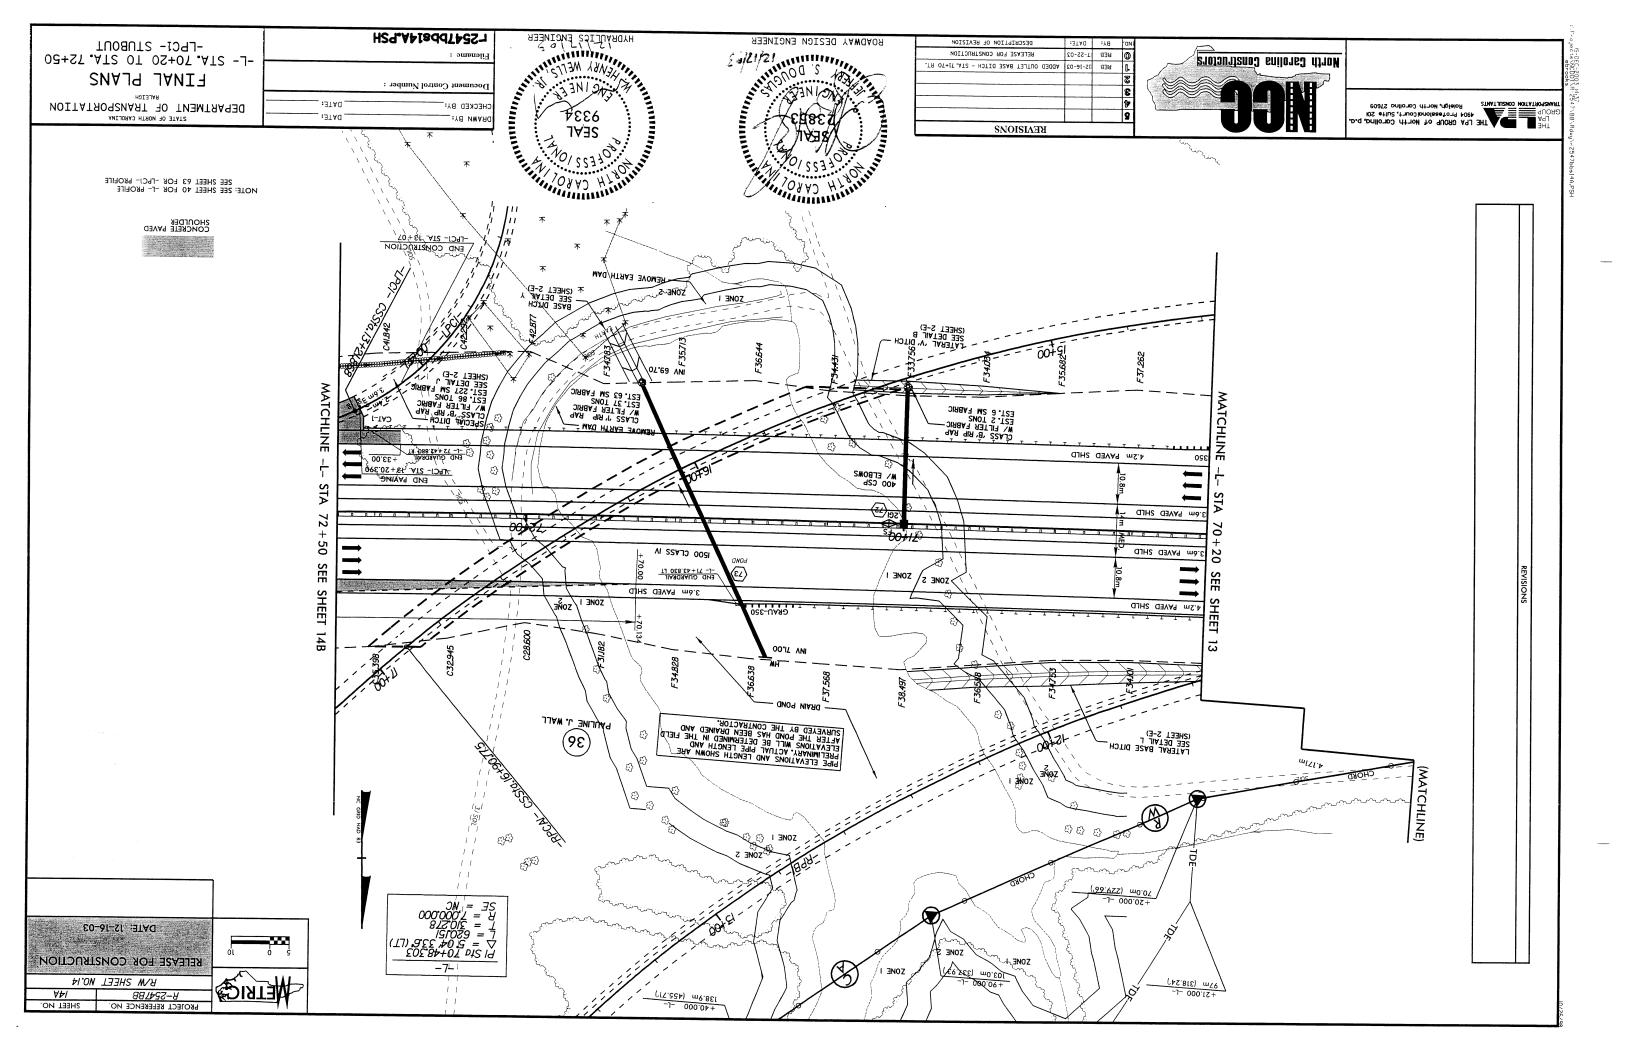

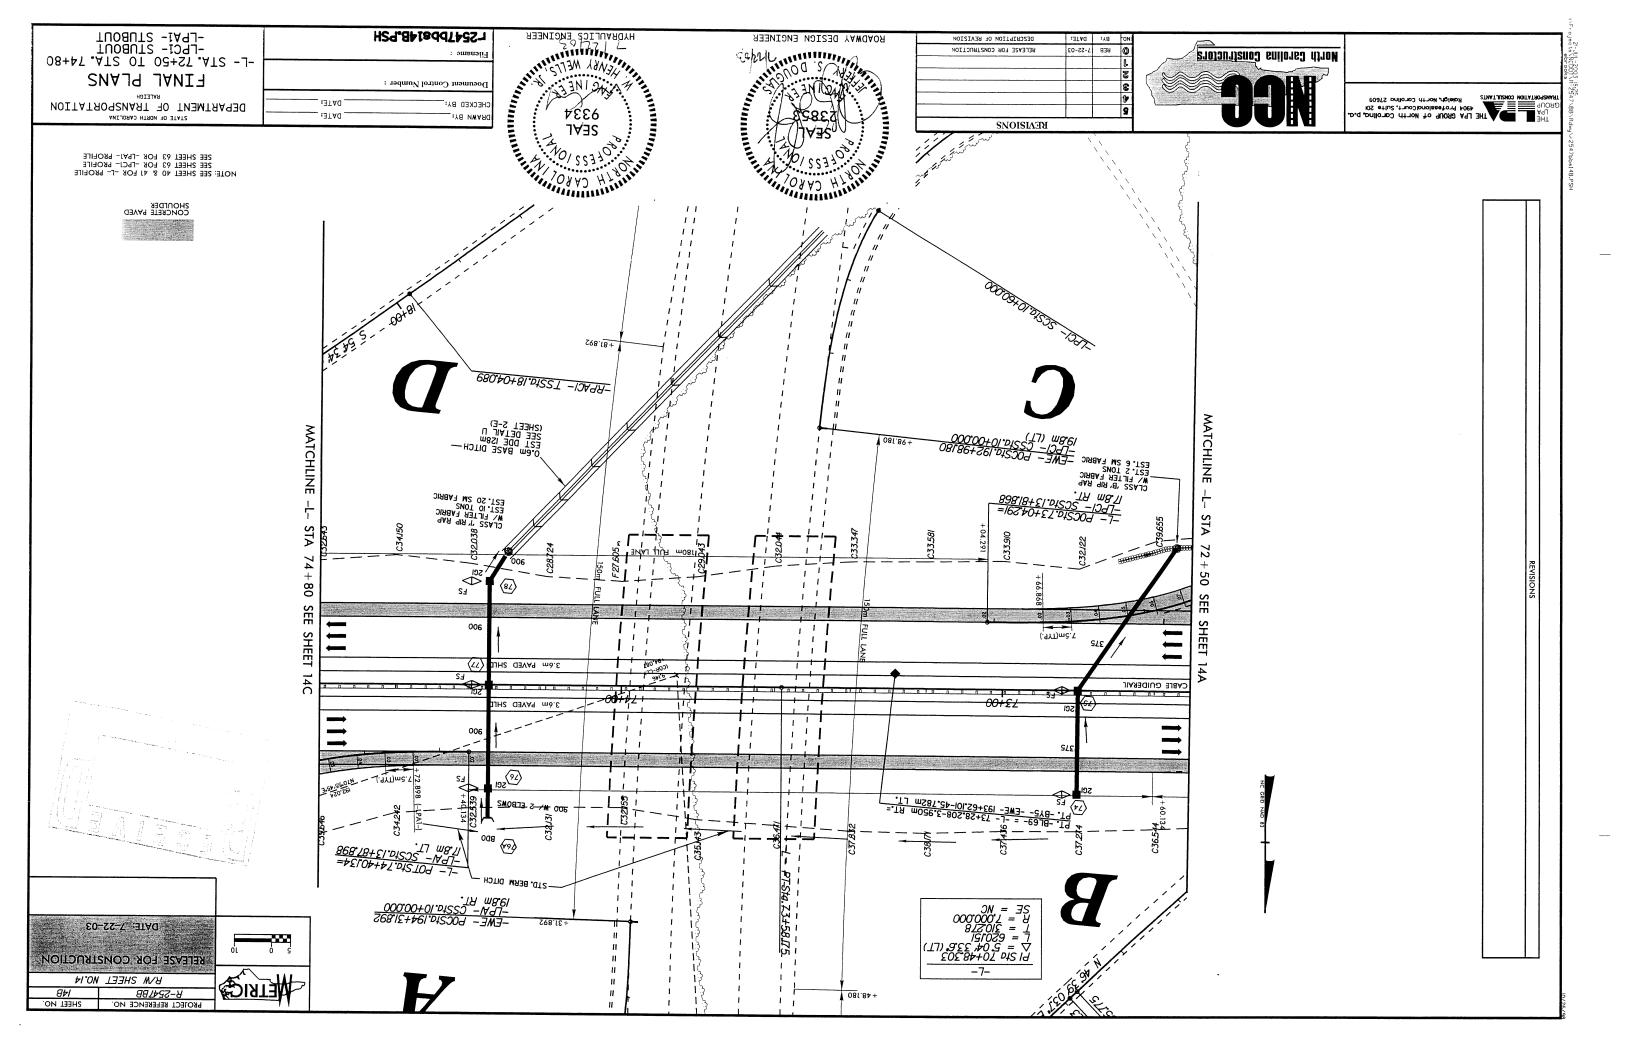

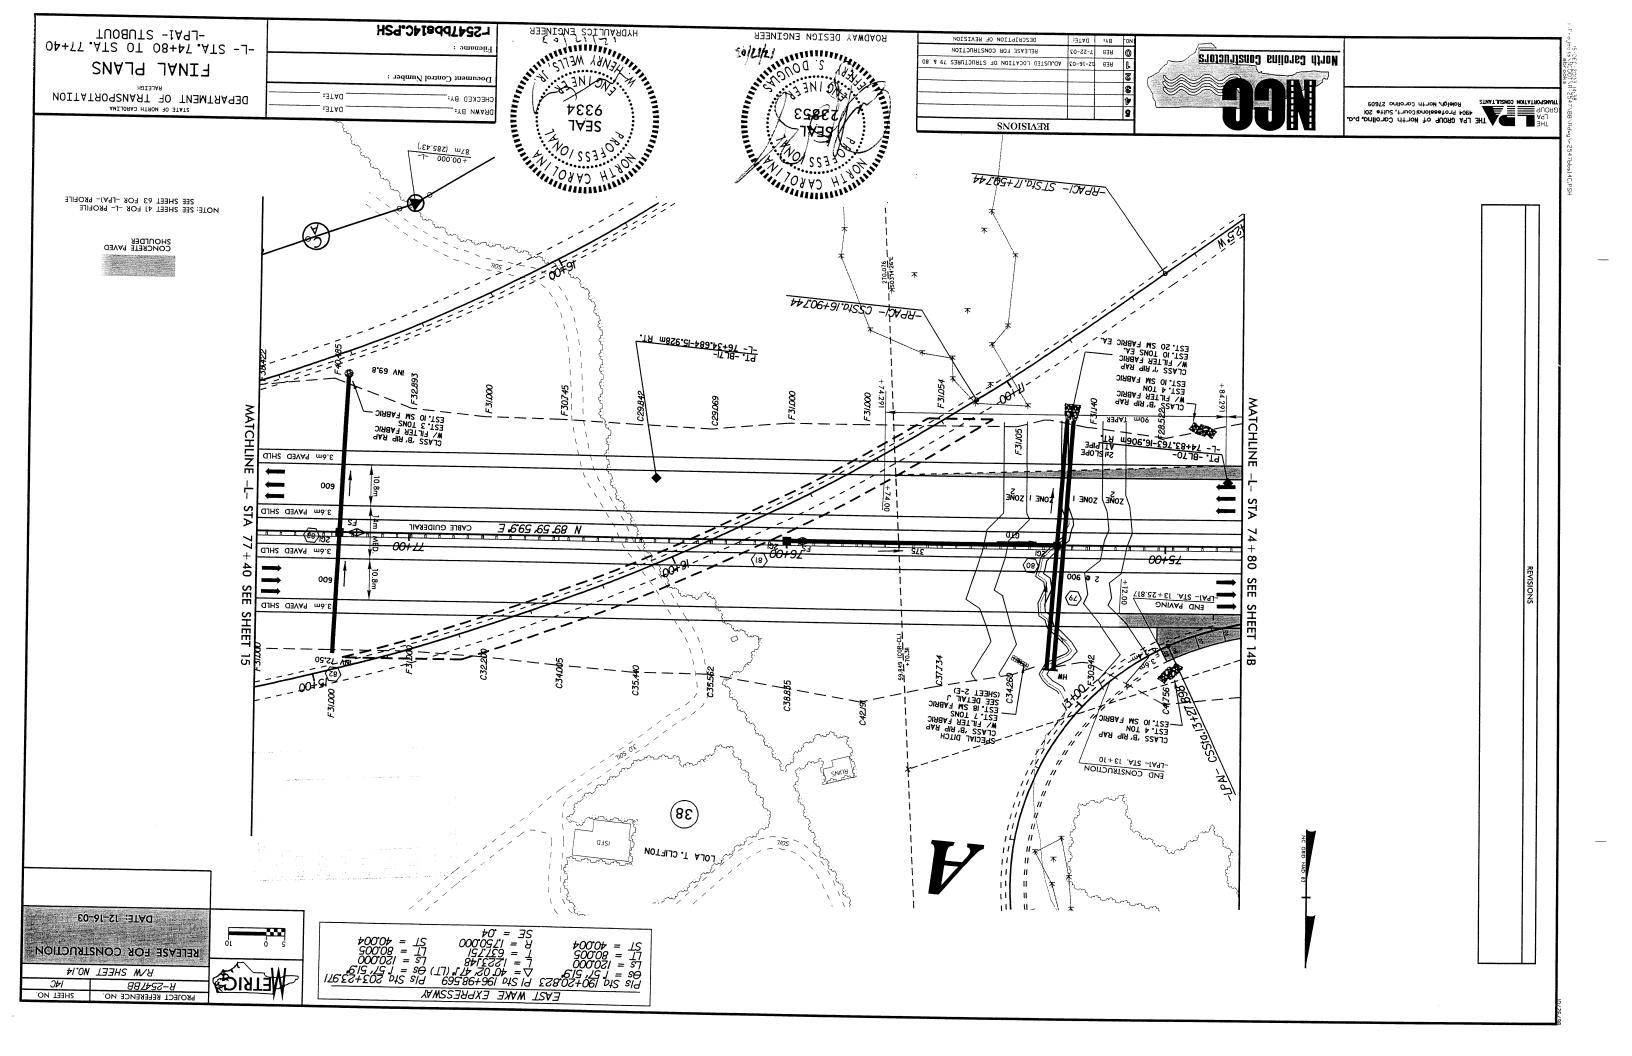

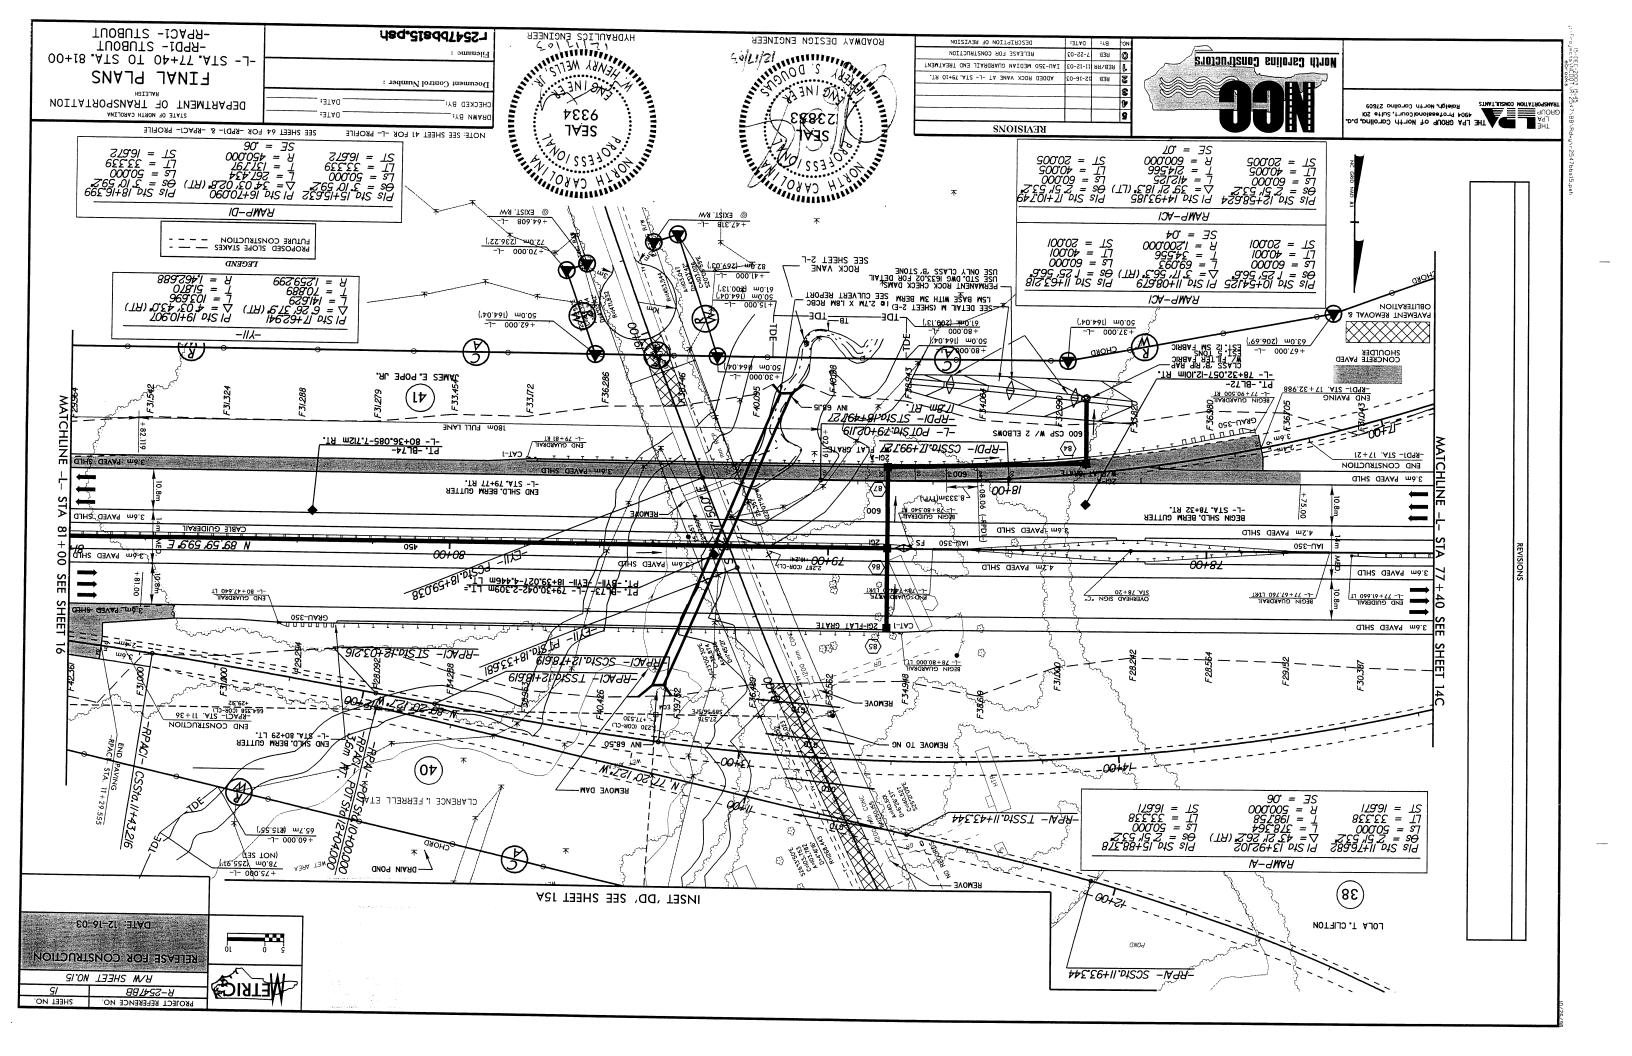

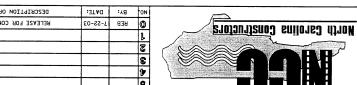

THE LPA GROUP OF North Corolling, p.g.

| DESCRIPTION OF REVISION | :3TAO | : 78 | 1 |
|--------------------------|---------|------|---|
| RELEASE FOR CONSTRUCTION | 7-22-03 | REB | |
| | | | |
| | | | 1 |
| | | | 1 |
| | | | |
| | | | |

IWPERVIOUS DIKE SNOT 2.21

CLASS I RIP RAP

| DESCRIPTION OF REVISION | :3TAO | :78 | |
|--------------------------|---------|-----|---|
| RELEASE FOR CONSTRUCTION | 7-22-03 | BEB | |
| | | | |
| | | | į |
| | | | |
| | | | |
| | | | |
| KEAISIONS | | | |

| <u>н</u> | NOISIA |
|----------|--------|
| | NOITOU |
| | |
| | |
| | |
| | |
| 11111 | |
| = | |
| = | L |

| ROADWAY DESIGN ENGINEER | |
|--|--|
| Coped Committee | |
| S DOUGHE | |
| 11000 | |
| S S LIZ AND MANY | |
| | |
| \$6887 VIS | |
| TANG Y | |
| = / = / = = = = = = = = = = = = = = = = | |
| = 11/d/201203 = | |
| 195533 B | |
| DAAS HISIN | |
| _ | |

| HADBADLICS ENGINEER | |
|--|--|

YA WWARU

\$LIFE

CHECKED BA:

FINAL PLANS

DEPARTMENT OF TRANSPORTATION STATE OF MORTH CAROLINA

CONSTRUCTION SEQUENCE CULVERT DETAIL

> DATE: NOTE: SEE SHEET 41 FOR -L- PROFILE

- 12. REMOVE ALL EROSION CONTROL DEVICES
- II. REMOVE TEMPORARY DIVERSION DITCHES
- 10. REMOVE TEMPORARY IMPERVIOUS DIKES
- - 1 @ 2.7m X 1.8m RCBC 9. EXCAVATE AND CONSTRUCT
- SUITABLE FILL MATERIAL 8. BACKFILL EXISITING SCOUR HOLE WITH
- AT INLET AND OUTLET
- 7. INSTALL TEMPORARY IMPERVIOUS DIKES
- VOLUME = 88 CUBIC METERS inside diwensions: J.5m wax depth, ONTSIDE DIMENSIONS: 12m X 6m
- 6. CONSTRUCT STILLING BASIN 20m X 14m
- 5. CONSTRUCT TEMPORARY DITCH AT OUTLET
- - 4. REMOVE EXISTING CROSS PIPE
- 3. CONSTRUCT TEMPORARY DIVERSION DITCH


DATE: 7-22-03-

RELEASE FOR CONSTRUCTION

88*1*4588 PROJECT REFERENCE NO.


(DEL)


- 2. INSTALL STONE SILT SCREEN
- J. REMOVE BEAVER DAM

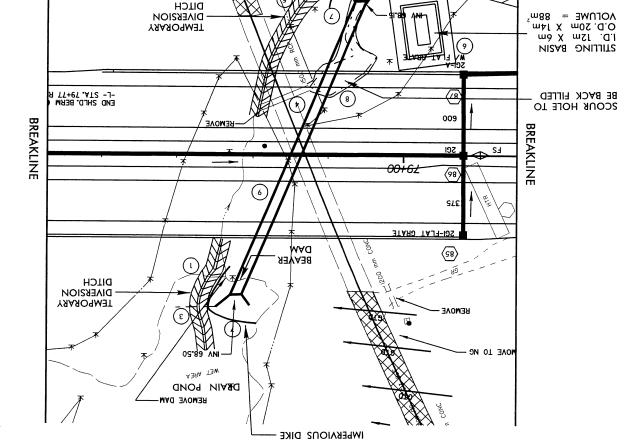



ROCK SILT SOREEN


CONSTRUCTION SEQUENCE FOR 1 ® 2.7m X 1.8m RCBC

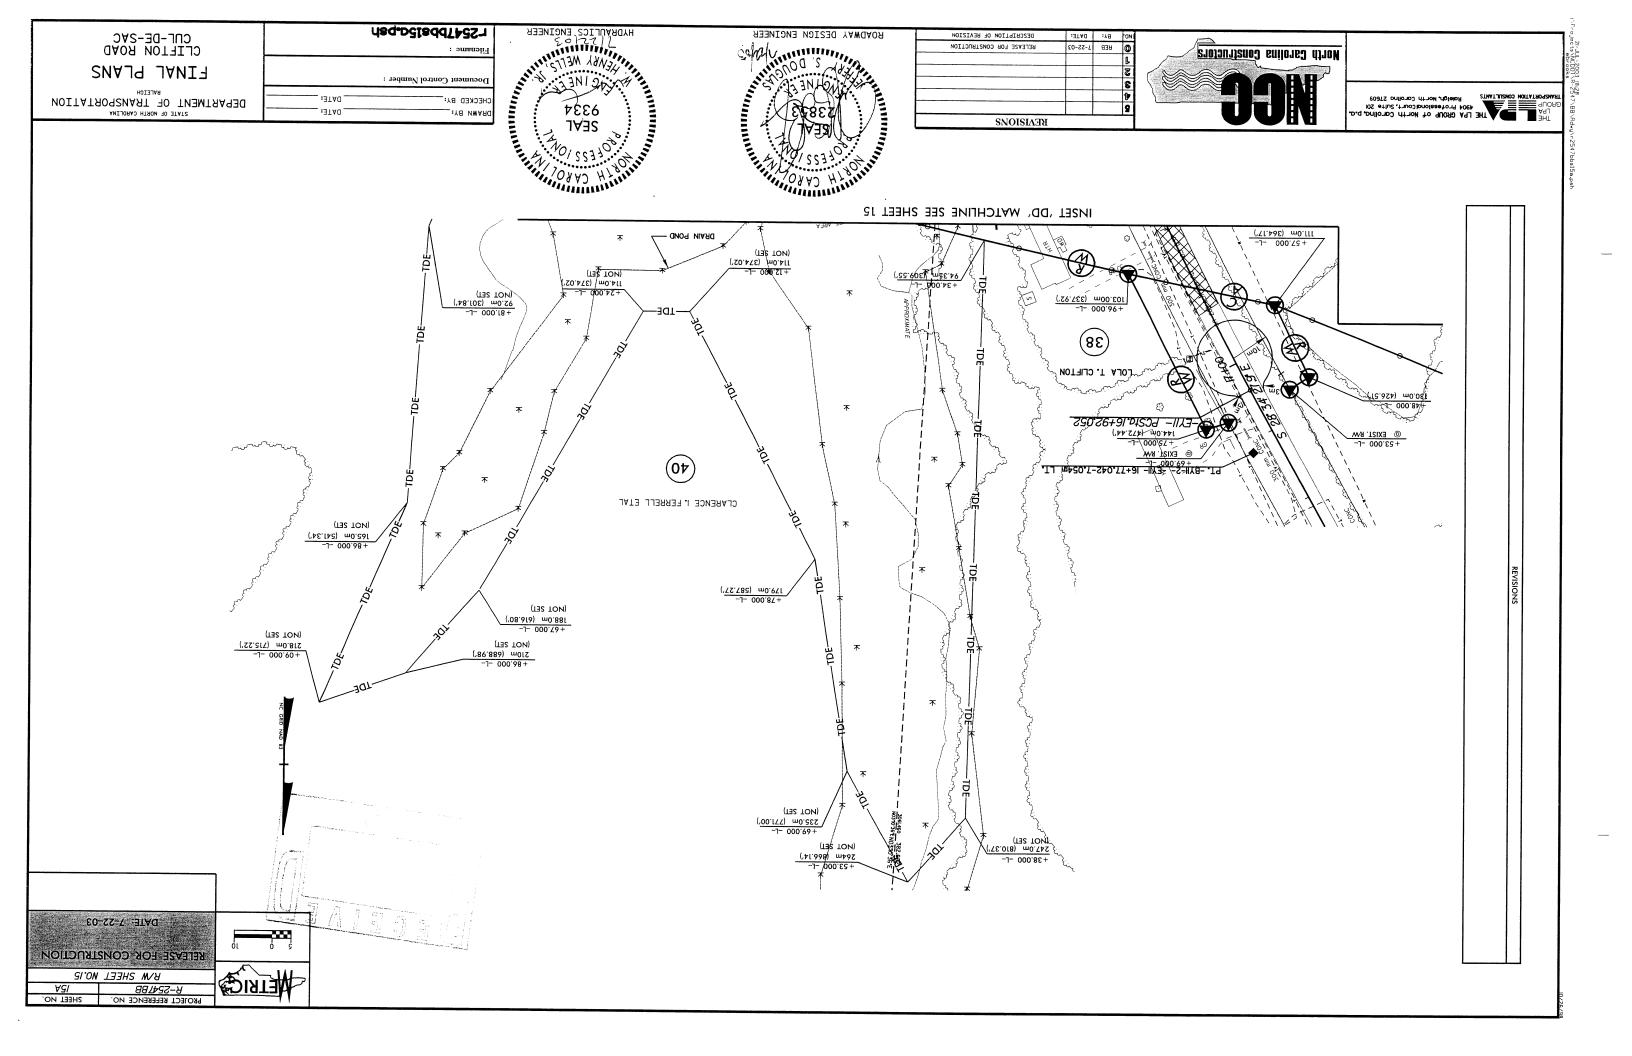


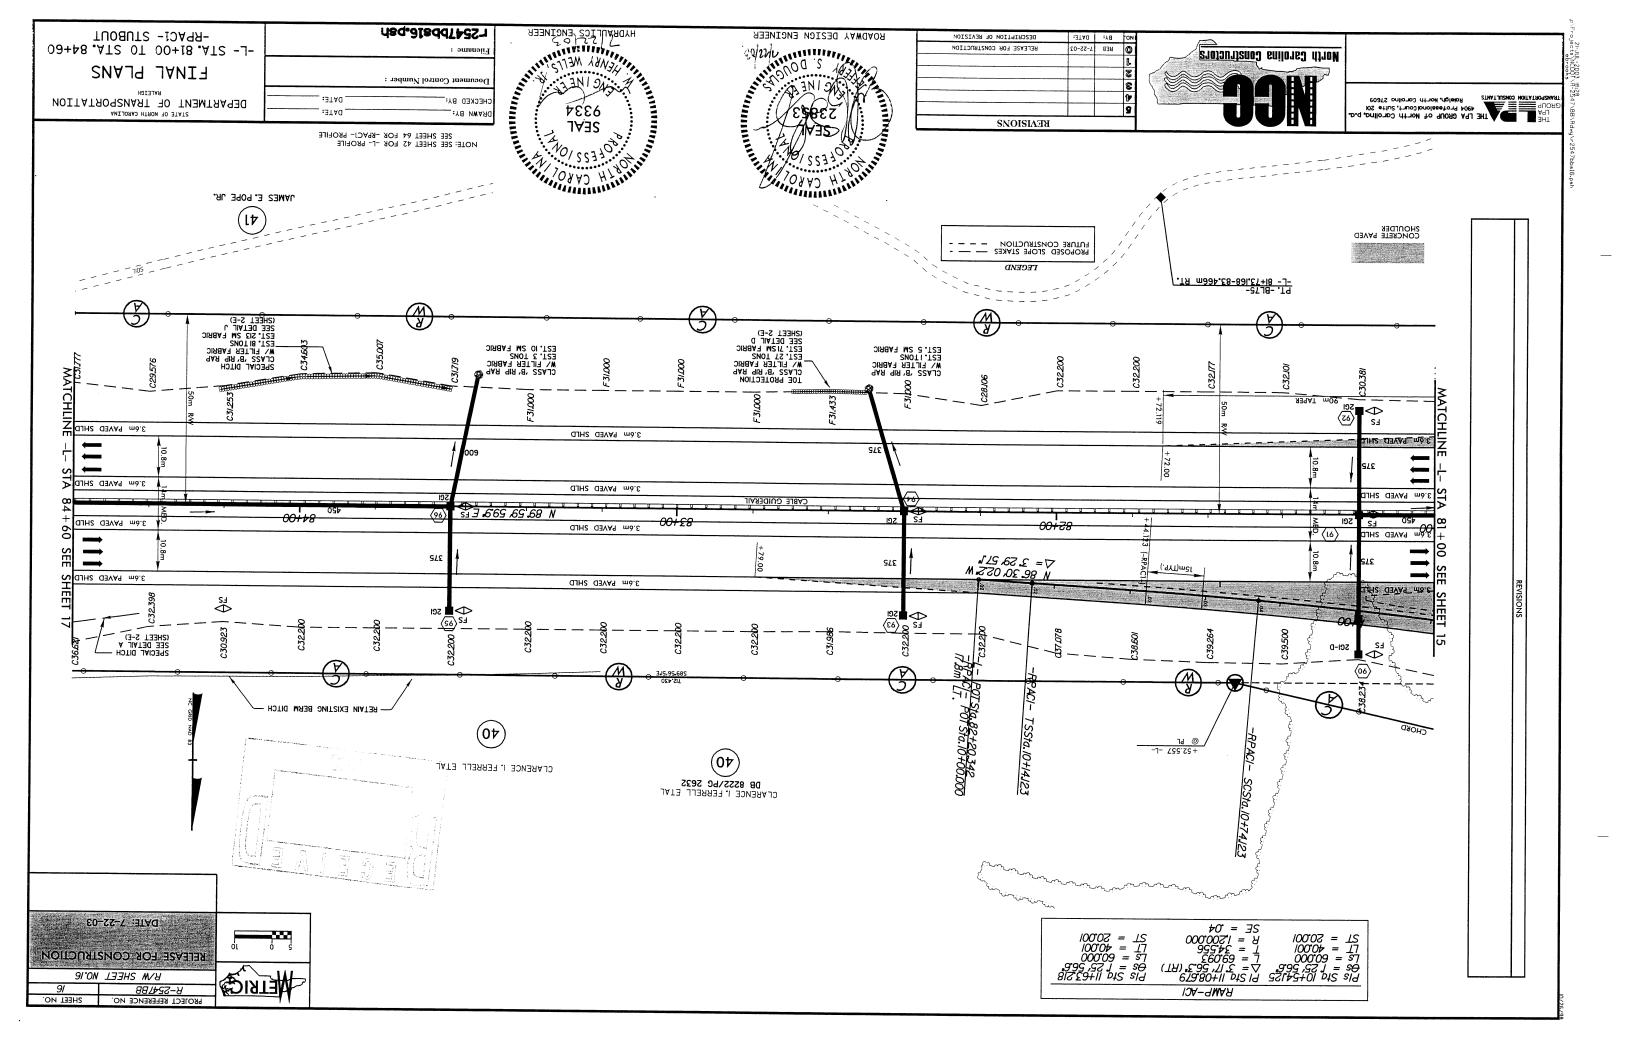


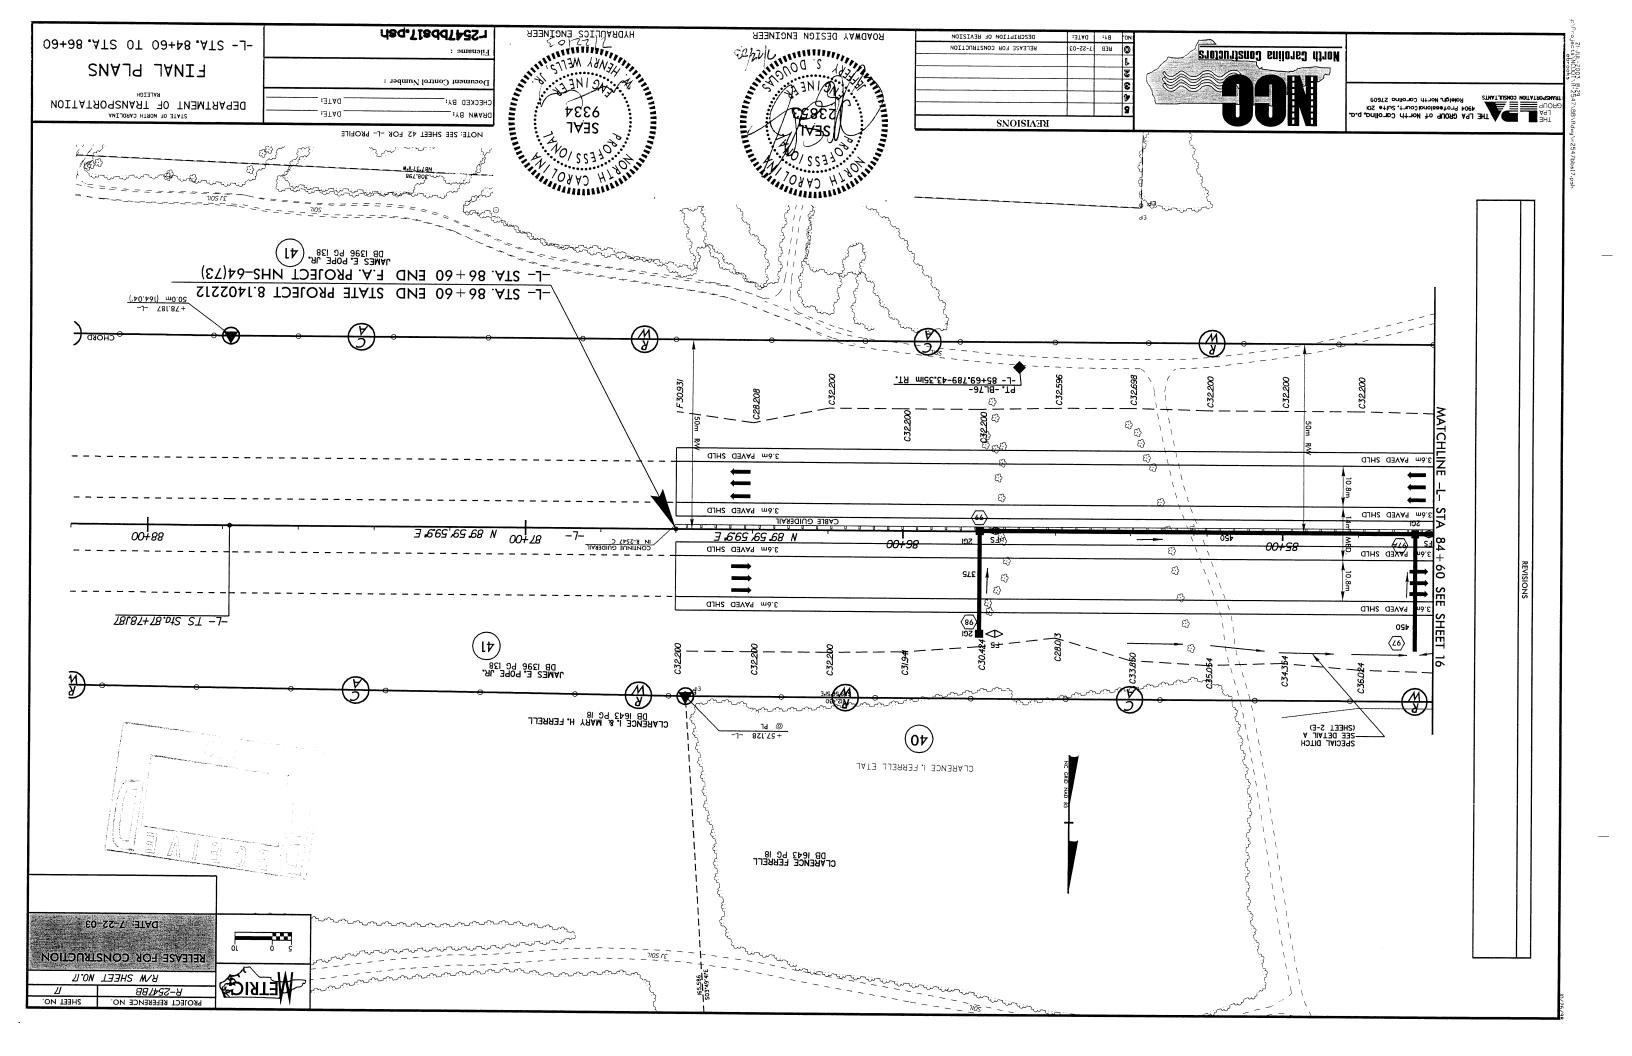


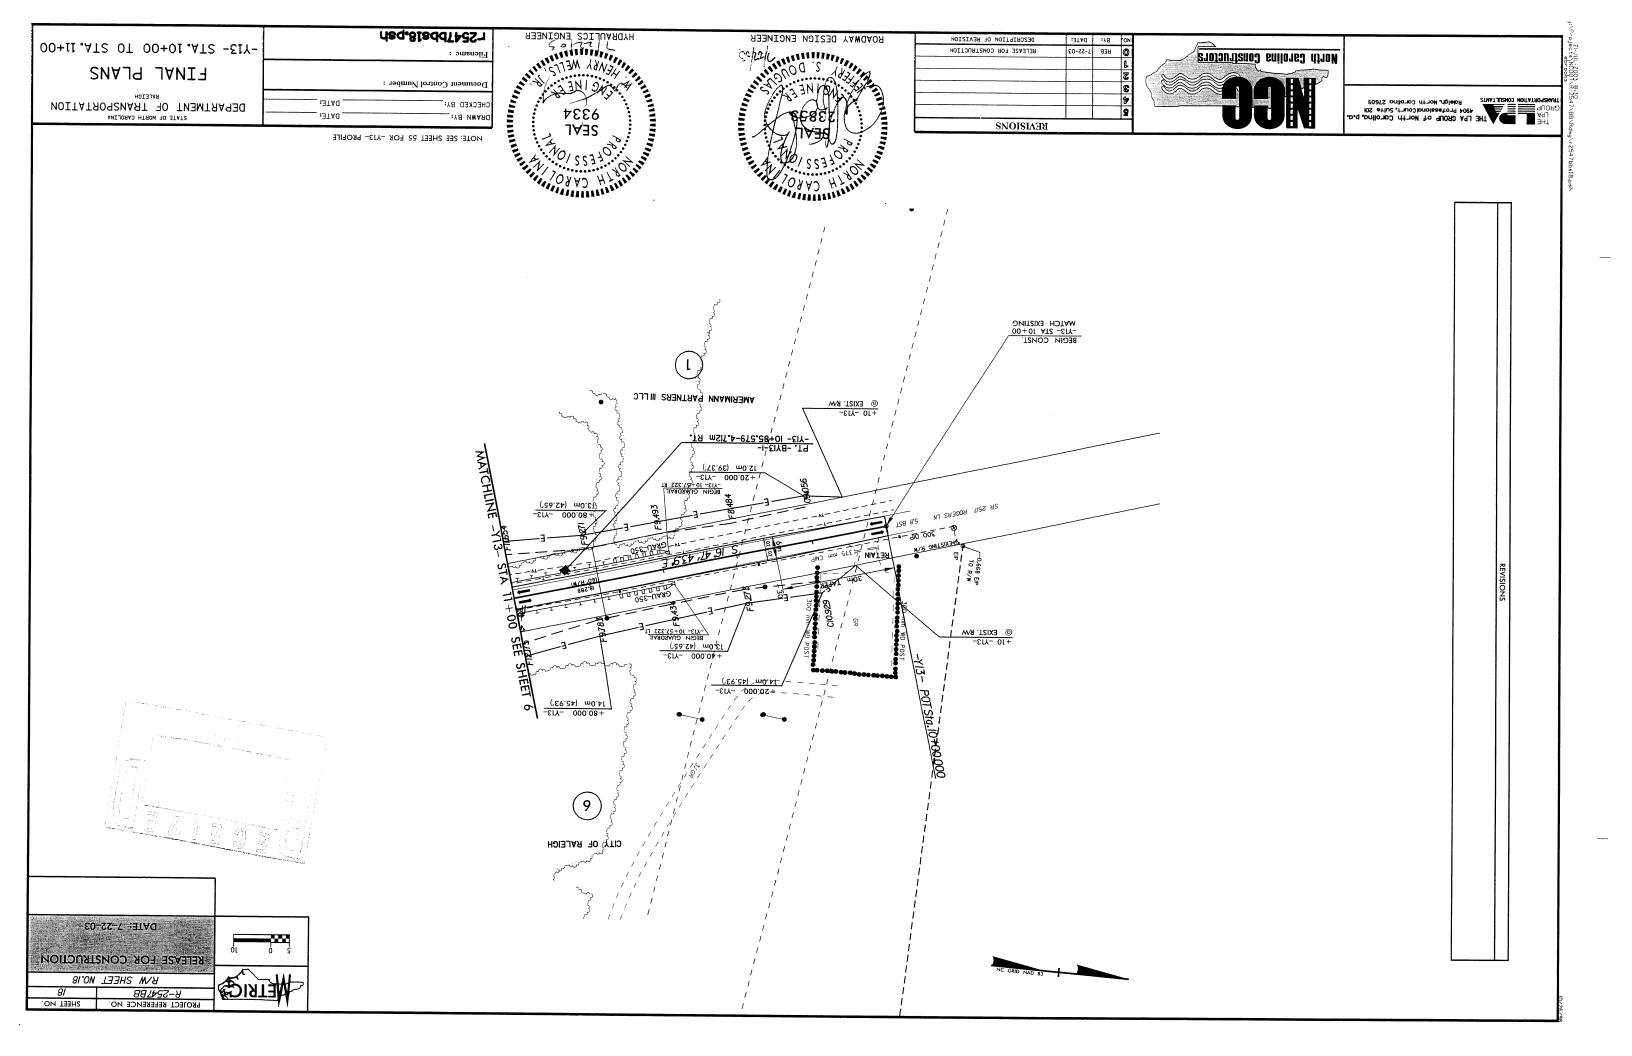


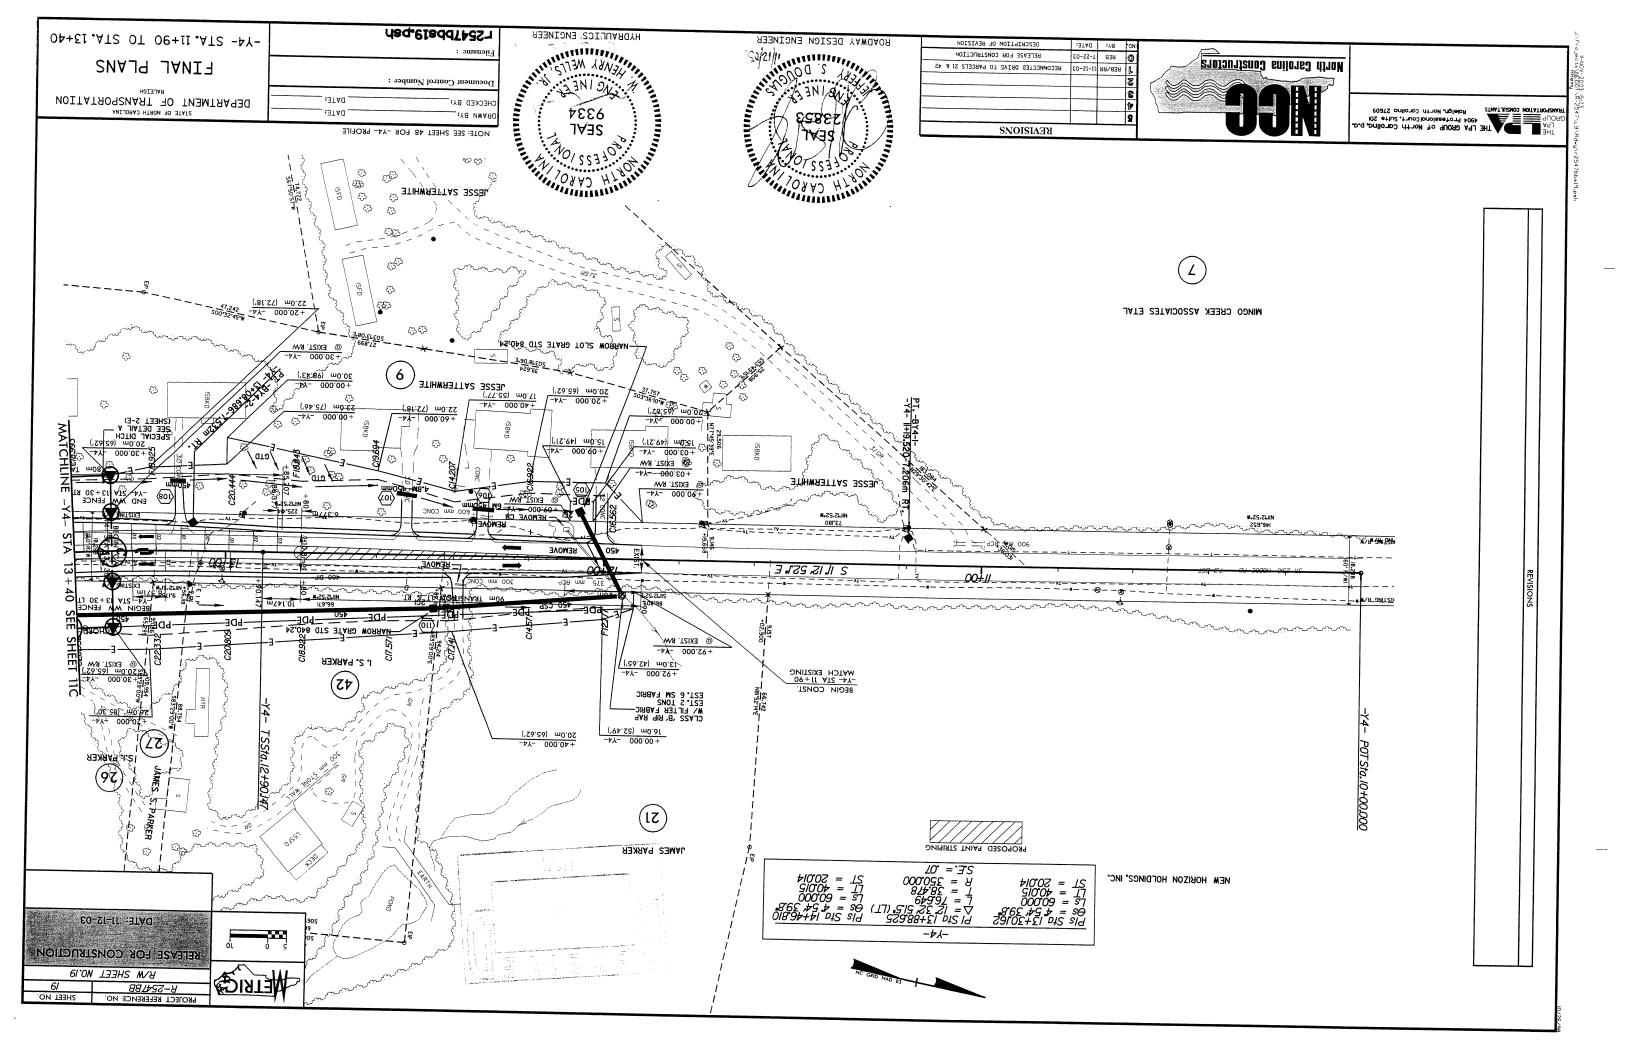


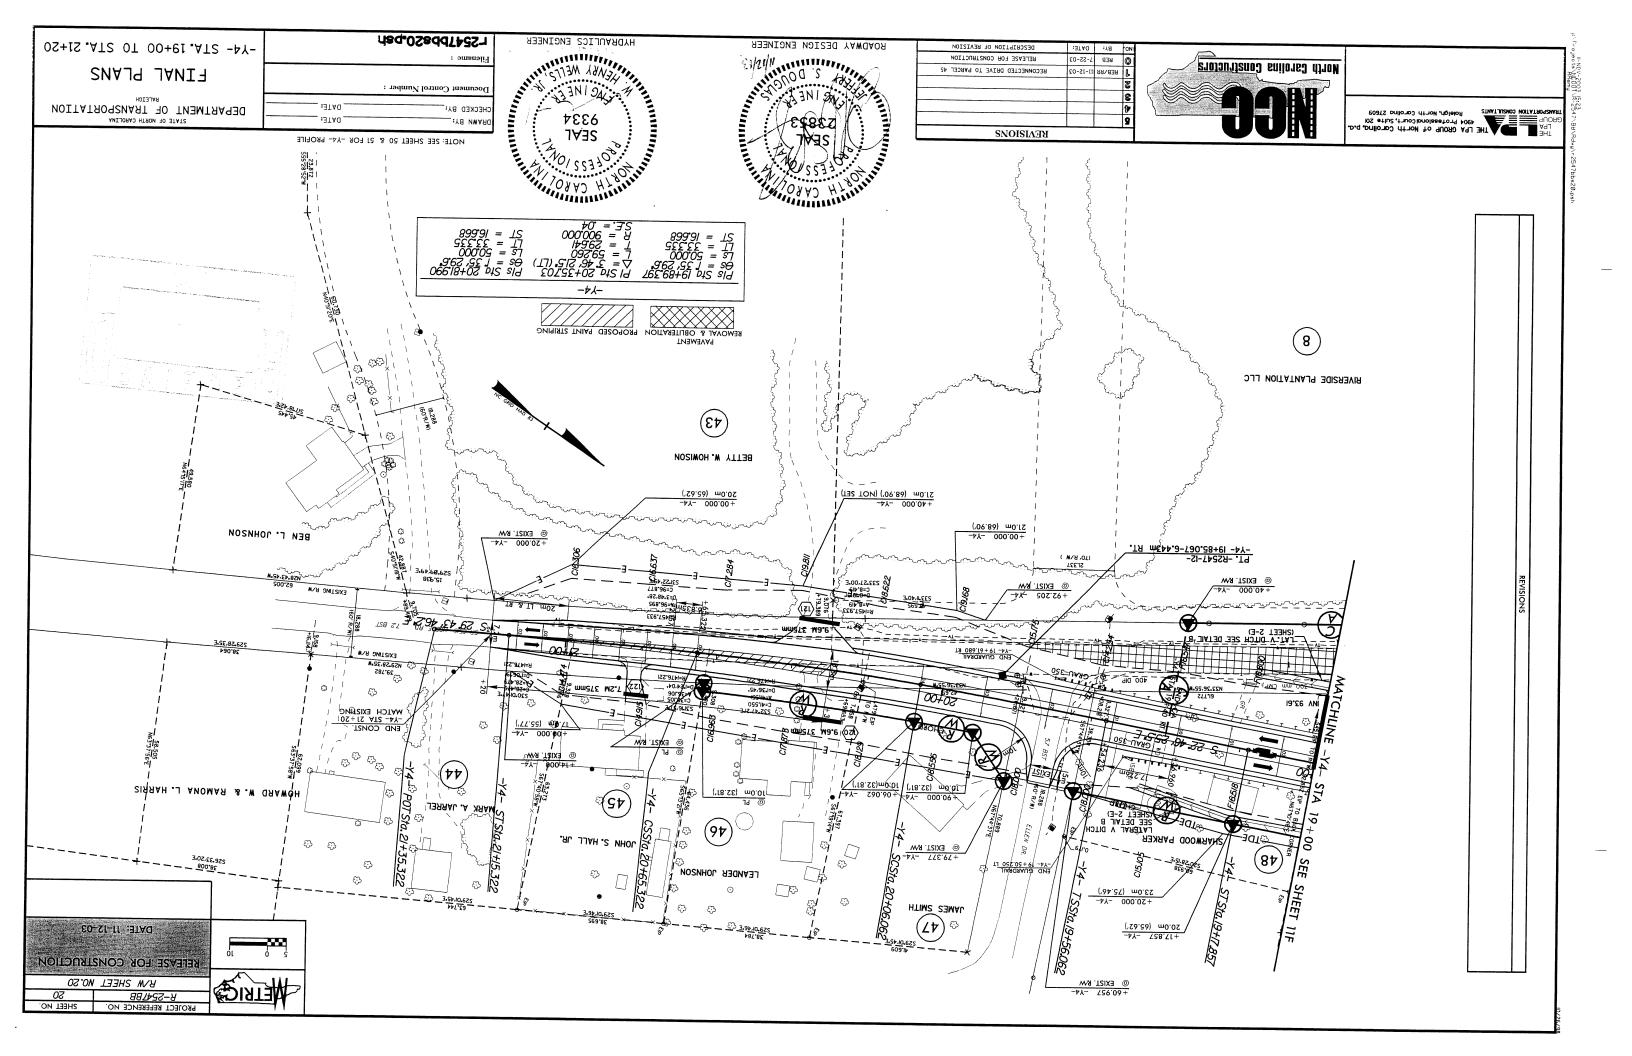


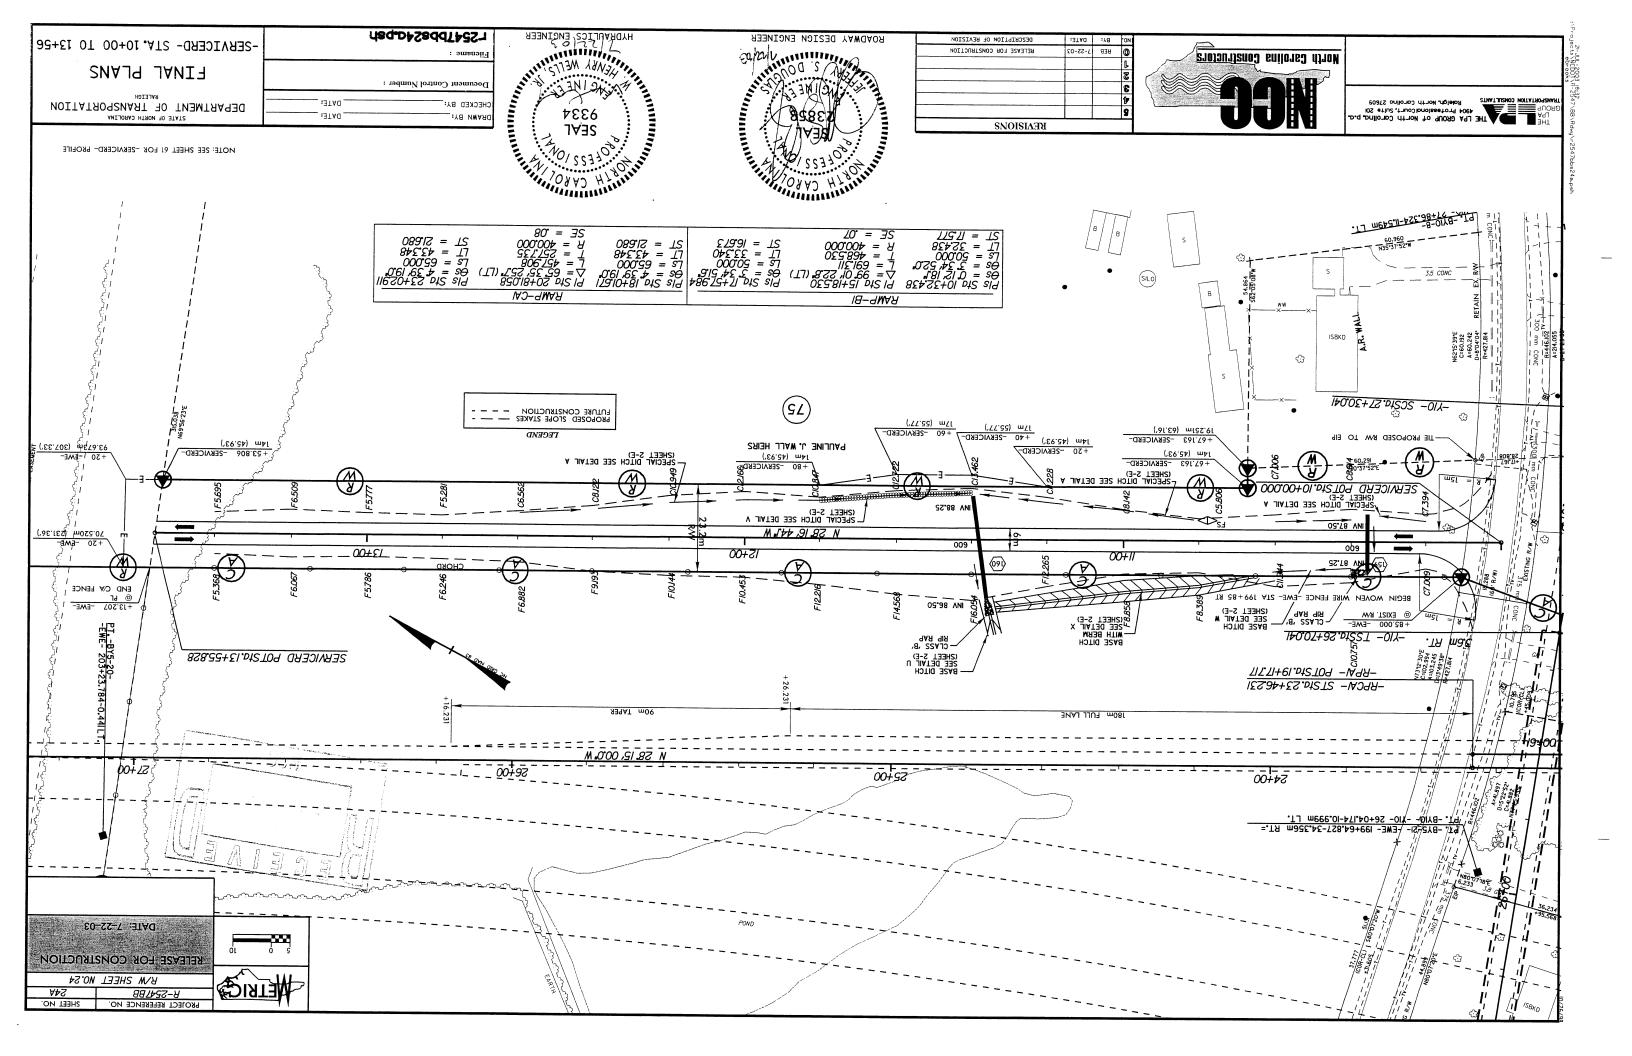


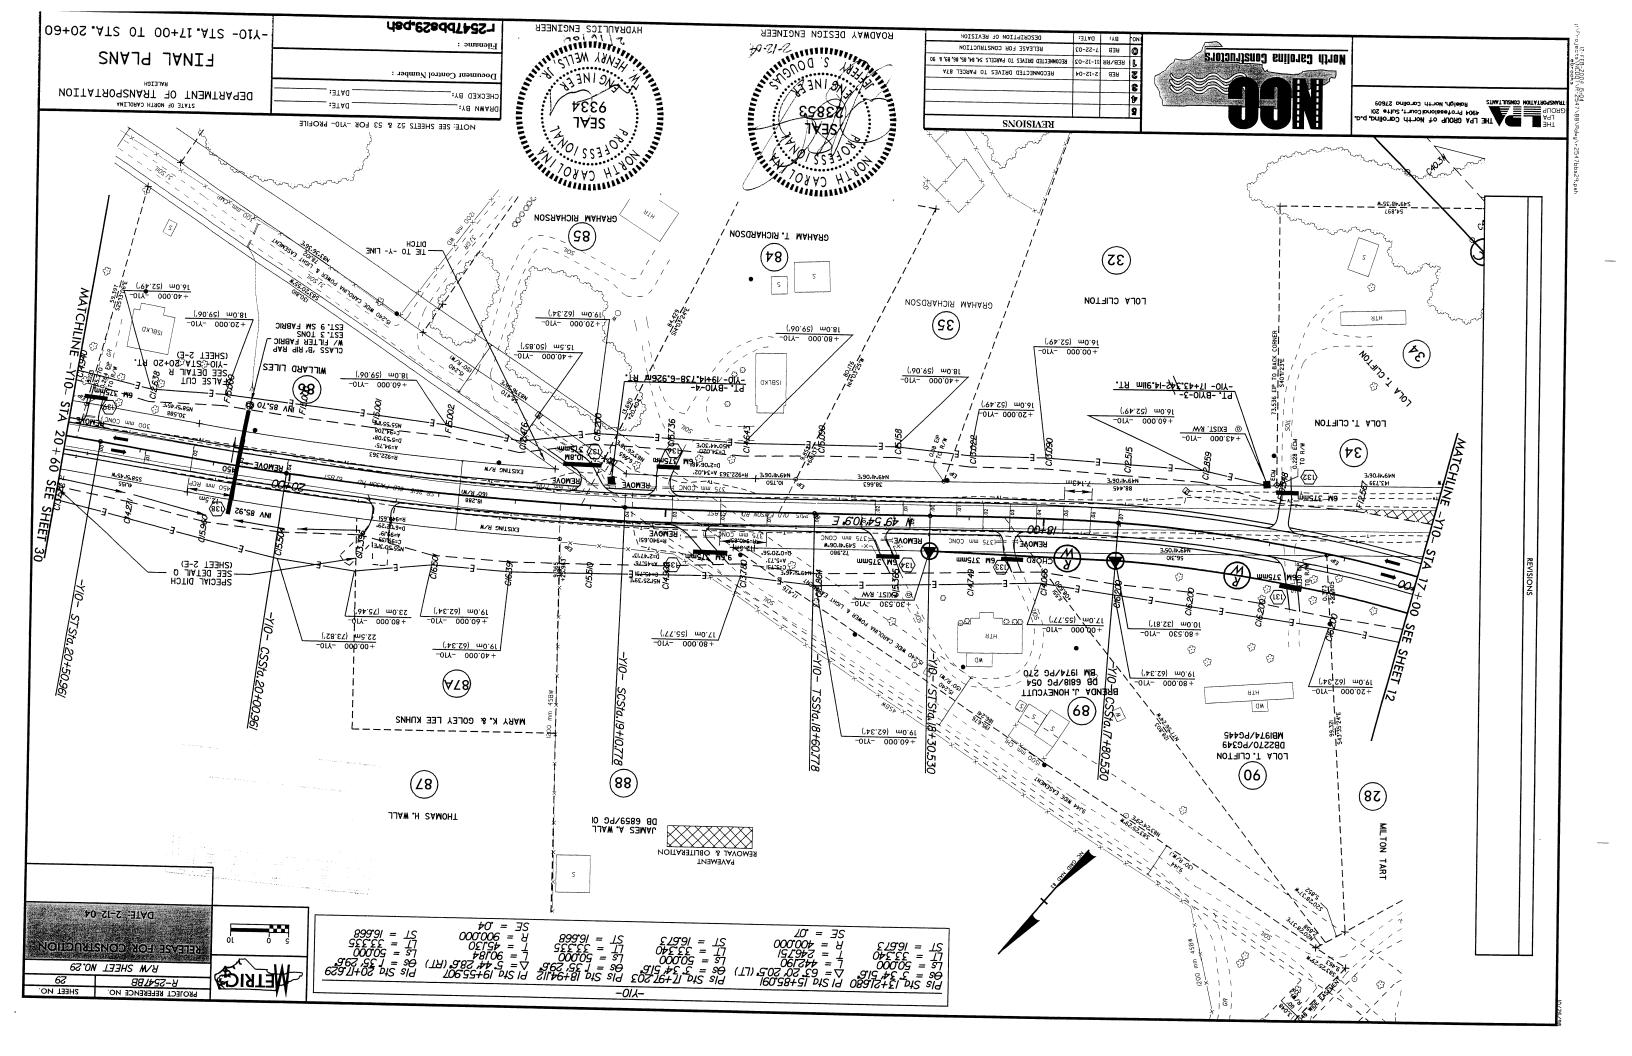

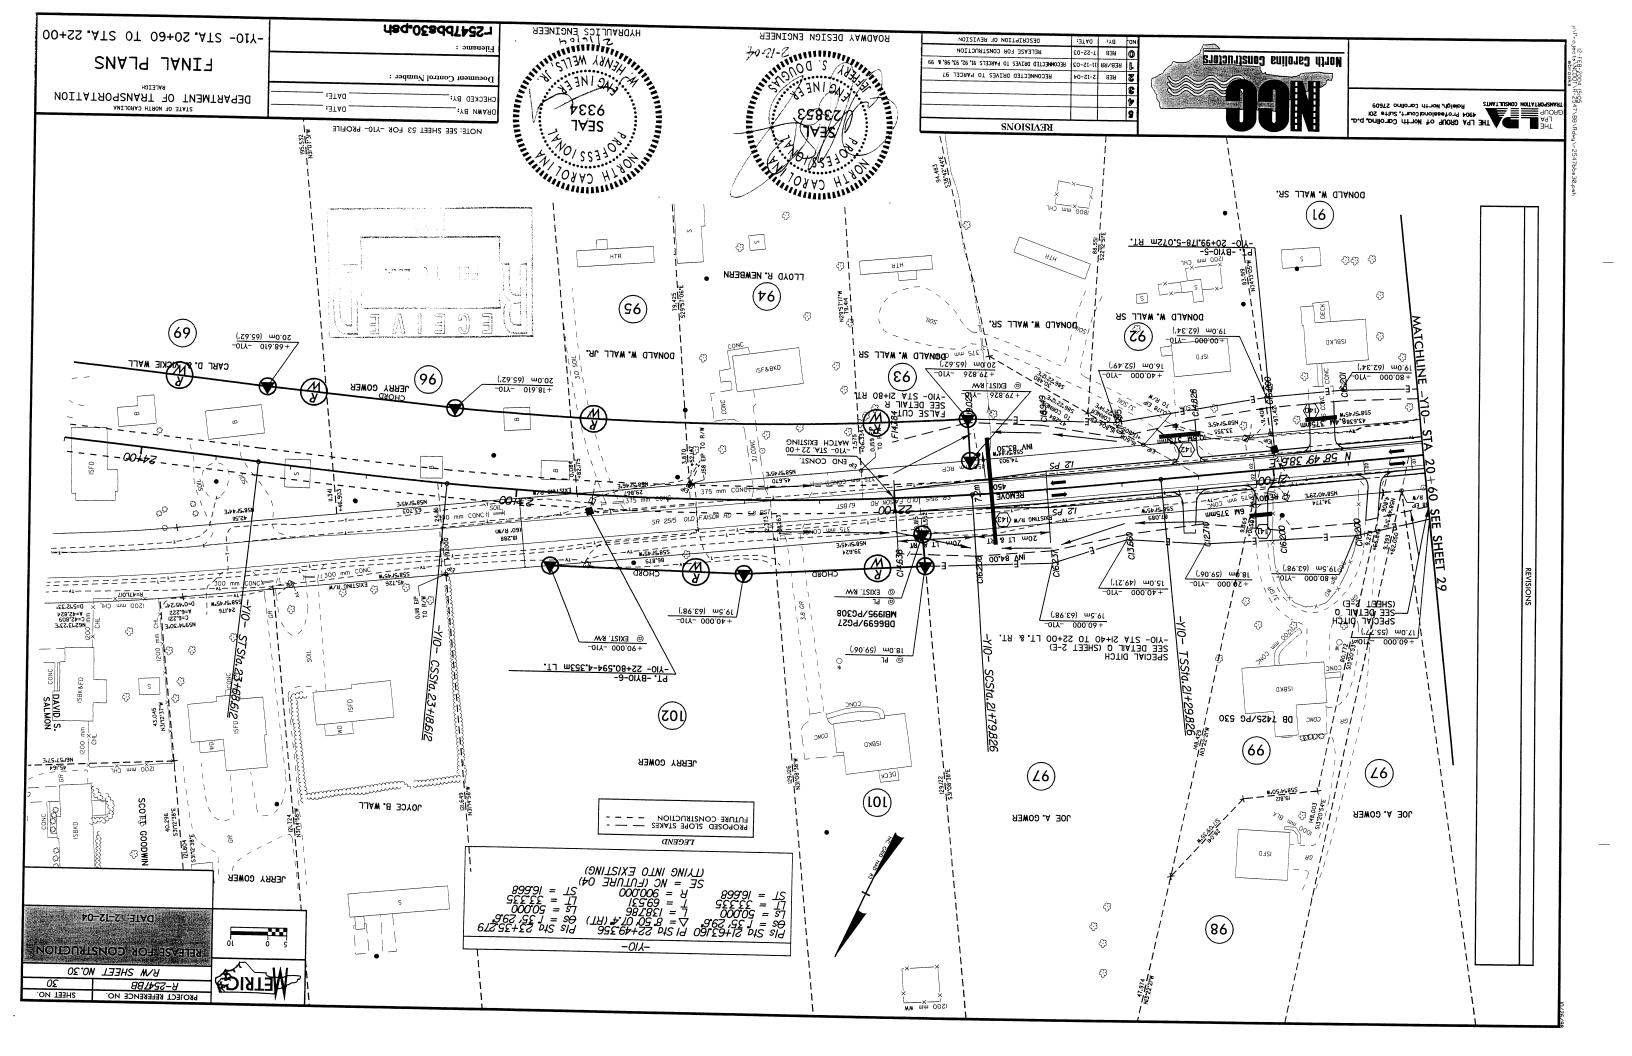

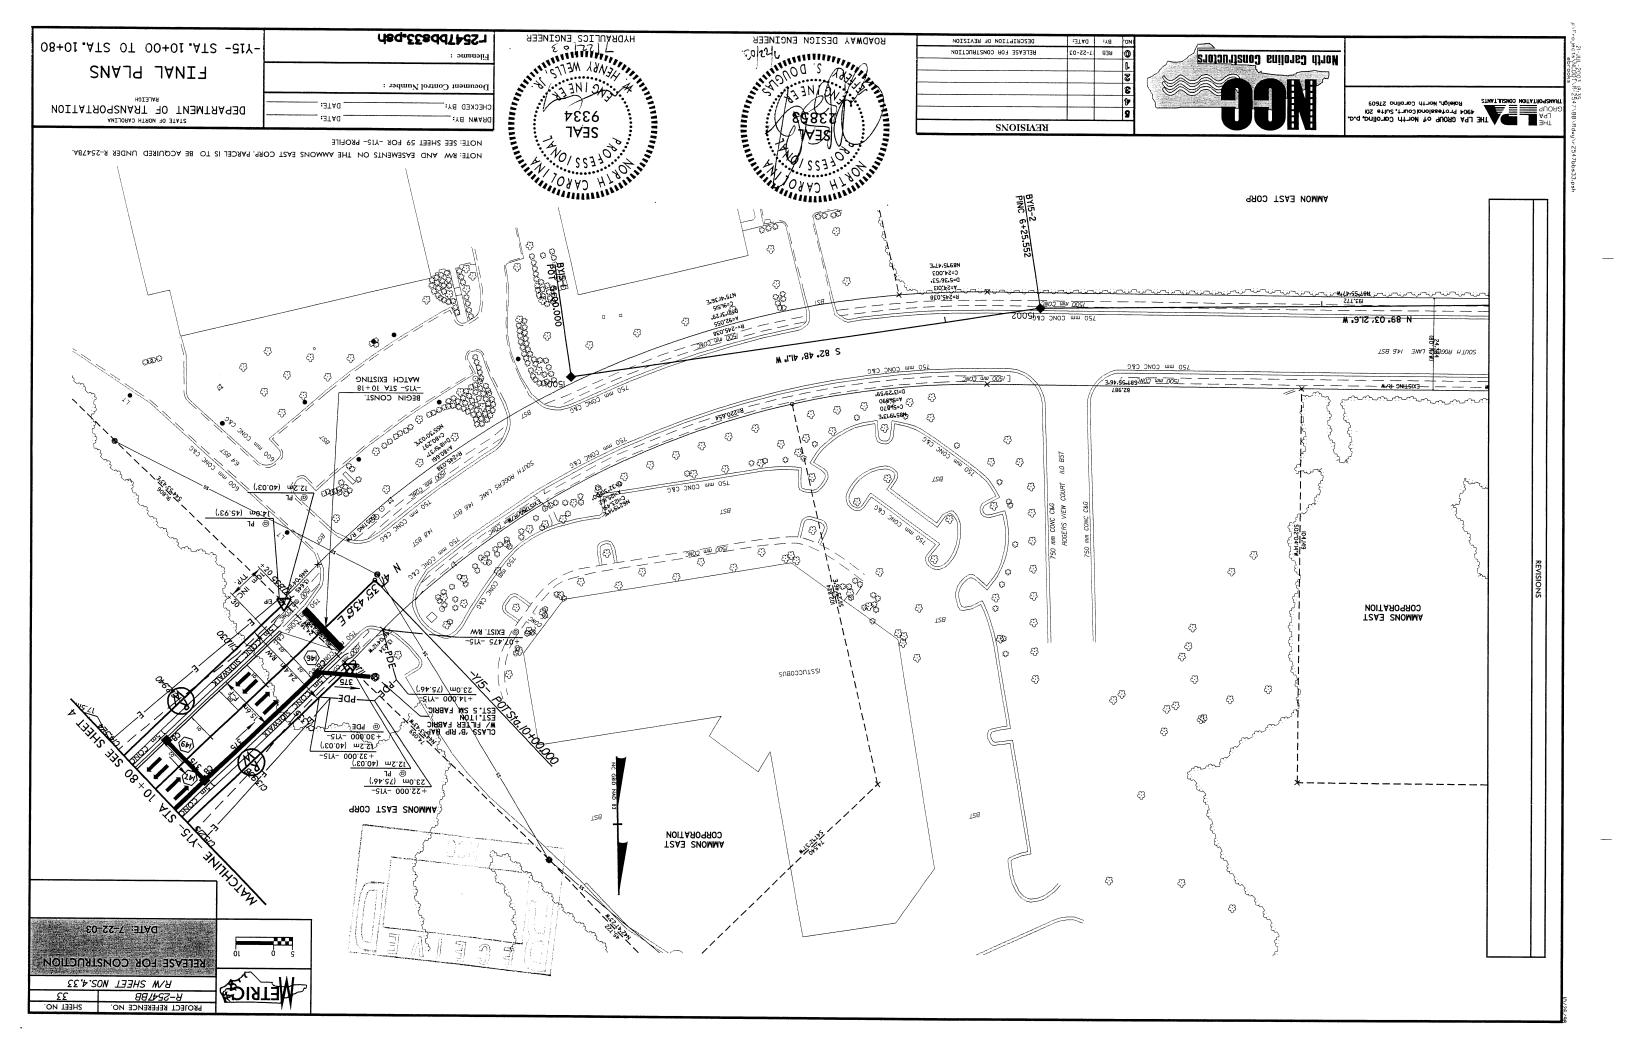

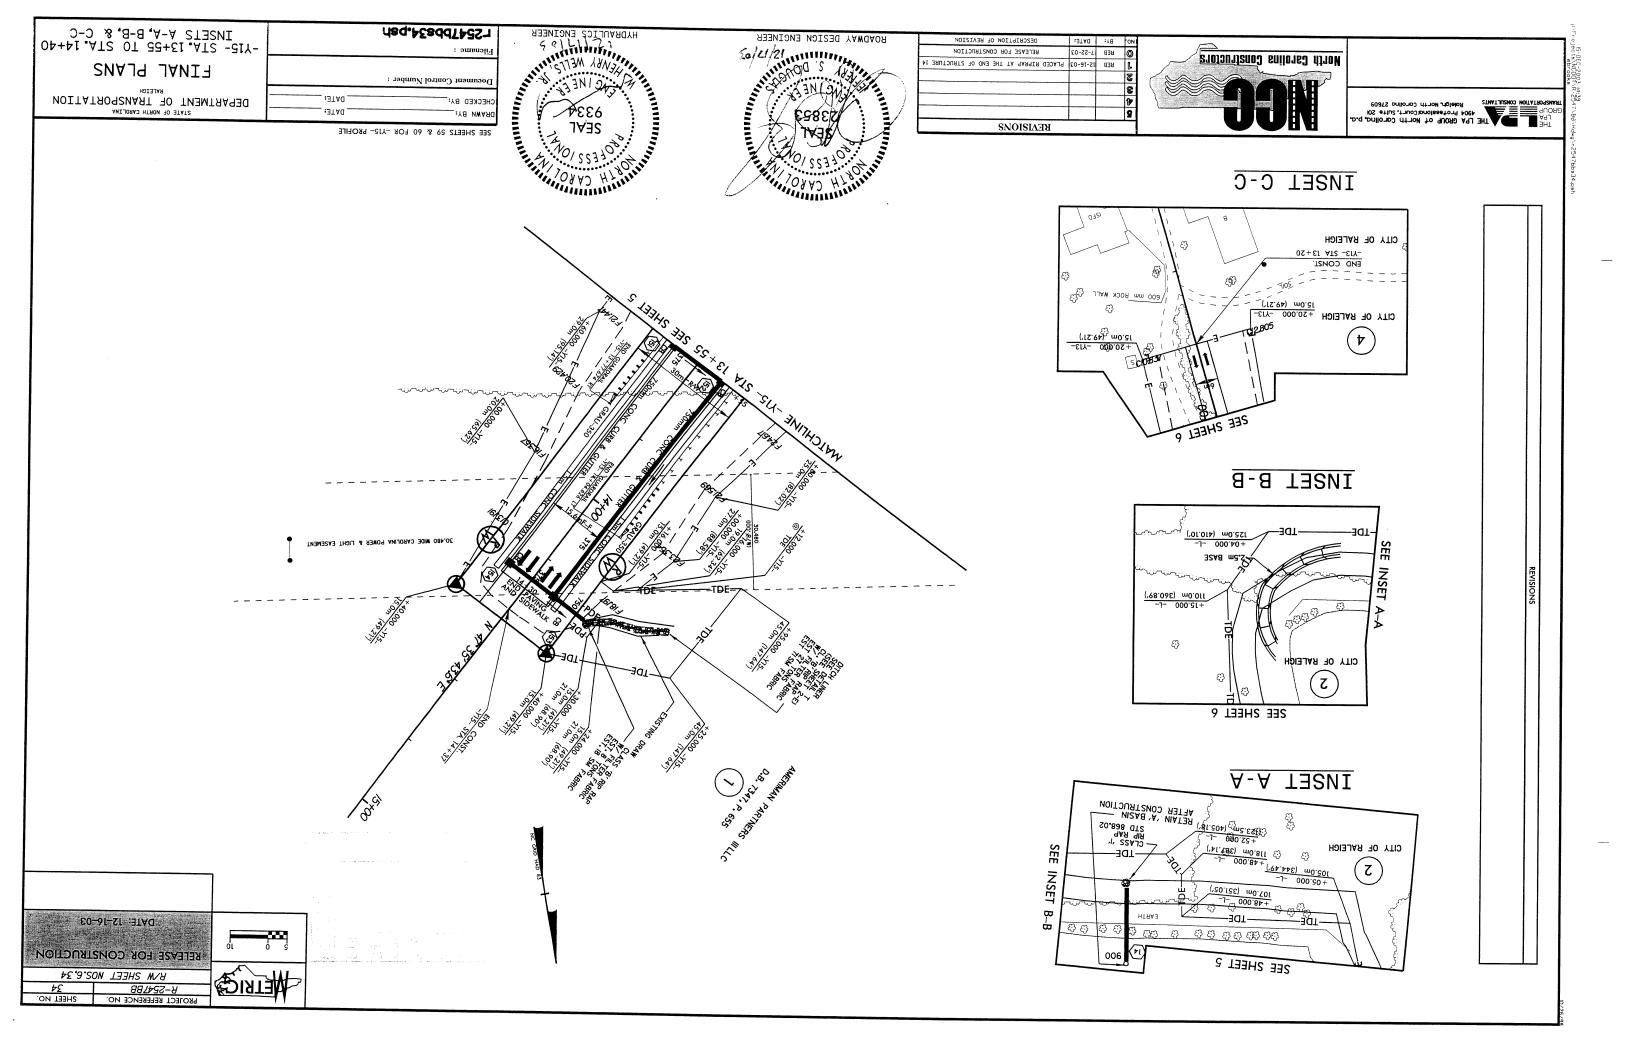

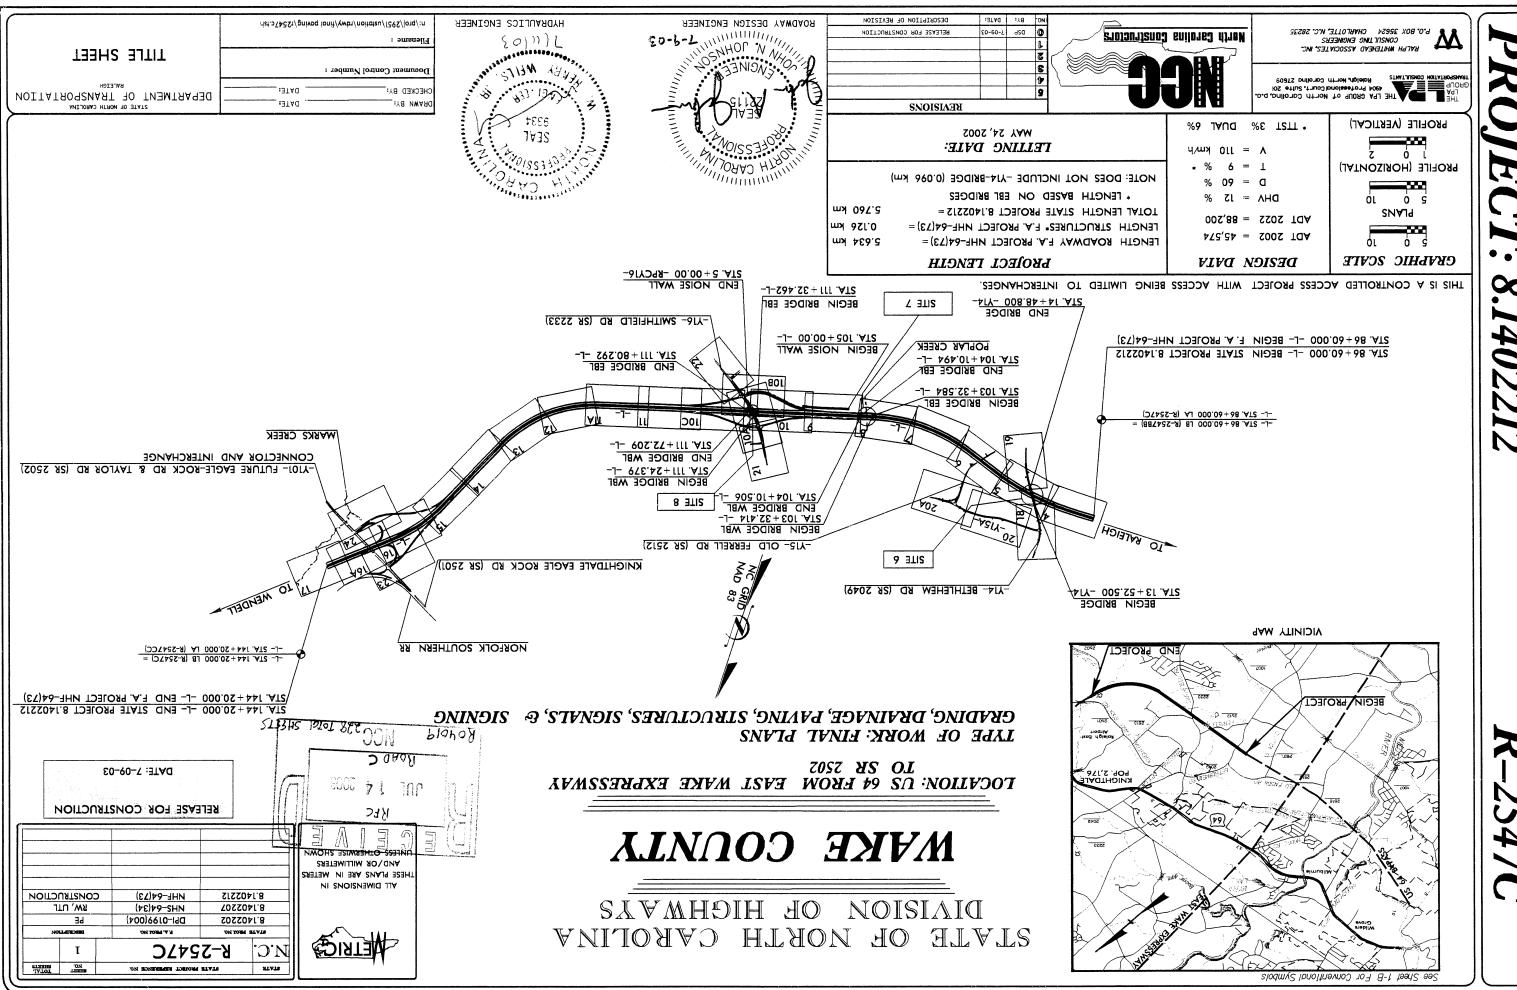

mus.viammus reving laniT.vwbr notiates 1262-1089. KEVISION SUMMARY
RAND STATE OF NORTH CAROLINA
DEPARTMENT OF TRANSPORTATION
RALEIGH _ :3TAQ _

_ :3TAQ _

CHECKED BA:

_:Y8 WWA90

| | ENCINEER | DEZICM | YAWQA OA |
|---|--------------|--------------|-----------------|
| | 1111111 | 400 .V | Nilly |
| 2 | ENCINEER NO. | NCINEE | 300 |
| | | | |
| | | n 23 | 08. |
| | | DRAD A | 180/1111 080 |
| | "// | $m_{\rm HH}$ | 1,, |

| KEAISIONS | | | |
|---|----------|-----|----|
| REVISED REV. SUM SHTS & SHT 2, 2A, 2B, 2C | DS-09-0 | JAL | 4 |
| REVISED REV. SUM SHTS & SHTS 2F,2G,2H,2I | 12-12-03 | нтэ | 9 |
| REVISED REV. SUMM. | 11-56-03 | нтэ | 9 |
| REVISED SHTS, 2F, REV. SUMM. | 10-23-03 | HTO | 9 |
| REVISED SHTS, IA,2G, 2H, REMOVED SHTS, 2J,2K,2L | | нтэ | 8 |
| REVISED SHEETS 2A, 21, & REV. SUMM. | 8-18-03 | нтэ | 2 |
| REVISED SHEETS IA & REV. SUMM. | 20-T1-T | | L |
| RELEASE FOR CONSTRUCTION | €0-60-T | яя | 0 |
| DESCRIPTION OF REVISION | :3TA0 | :۲8 | ON |



THE LPA GROUP of Worth Carolling, p.a. LPA GROUP of Worth Carolling, p.a. GROUP DESCOURT, Suite 201 TRANSPORTATION CONSULTATION CONSULT

| NOT INCLUDED IN 7-09-03 RELEASE FOR CONSTRUCTION | | | | | | | Ø8-28- Ø 3 | EØ-6Ø-70 | - MARANIO THIOF TABLE - 181Y- | - |
|--|--|---------------|---------------|----------|------------------|----------------------|-------------------|-------------|---|--------------|
| NOT INCLUDED IN 7-09-03 RELEASE FOR CONSTRUCTION | | | | | | | £Ø-8Z-8Ø | £Ø-6Ø-∠Ø | | - |
| NOT INCLUDED IN 7-09-03 RELEASE FOR CONSTRUCTION | | | | | | | £Ø-8Z-8Ø | £Ø-6Ø-∠Ø | - Y14 - SHEAR POINT DIAGRAM | _f |
| | | | | | | 12-12-03 | EØ-81-80 | £Ø-6Ø-∠Ø | PREFORMED SCOUR HOLE & LEVEL SPREADER DETAILS | I |
| | | | | | | 12-12-03 | £Ø-8Z-8Ø | £Ø-6Ø-∠Ø | CHANNEL RELOCATION DETAILS | 1 |
| | | | | | ₽ Ø-6Ø-ZØ | 12-12-03 | £0-82-80 | £Ø-6Ø-∠Ø | CHANNEL RELOCATION DETAILS | |
| | | | | | | 12-12-03 | 10-23-03 | £Ø-6Ø-∠Ø | DRAINAGE DETAILS | |
| | | | | | | | | £Ø-6Ø-∠Ø | TYPICAL SECTIONS | |
| | | | | | | | | £Ø-6Ø-∠Ø | TYPICAL SECTIONS | |
| | | | | | | | | £Ø-6Ø-∠Ø | TYPICAL SECTIONS | |
| | - | | | | | | +0-60- 20 | £Ø-6Ø-∠Ø | TYPICAL SECTIONS | |
| | | | | | | 1 0-60-20 | £Ø-18-Ø3 | £Ø-6Ø-∠Ø | TYPICAL SECTIONS | |
| | | | | | | | 70-60- 20 | £Ø-6Ø-∠Ø | TYPICAL SECTIONS | |
| | a de la companya de l | | | | | | | £Ø-6Ø-∠Ø | CONVENTIONAL SYMBOLS | |
| | | | | | | | | £Ø-6Ø-∠Ø | 2GAAGNAT2 | |
| | | | | | | £0-82-80 | £Ø-∠ĭ-∠Ø | £Ø-6Ø-∠Ø | INDEX, GENERAL NOTES | |
| | | | | | | | £Ø-∠I-∠Ø | E0-60-70 | INDEX OF SHEETS & REVISION SUMMARY | 6- |
| | | | | | | | £Ø-∠I-∠Ø | £0-60-Z0 | INDEX OF SHEETS & REVISION SUMMARRY | 8- |
| 50015 01 202508 | | | | | | 12-12-03 | 11-58-03 | EØ-60-70 | INDEX OF SHEETS & REVISION SUMMARY | L- |
| and the second s | | | | | | 11-26-03 | £Ø-∠1-∠Ø | EØ-6Ø-ZØ | INDEX OF SHEETS & REVISION SUMMARY | 9- |
| | | | | 10-23-03 | £0-82-80 | £0-81-80 | £Ø-71-7@ | EØ-6Ø-70 | INDEX OF SHEETS & REVISION SUMMARY | G- |
| | | | | | 11-26-03 | £0-82-80 | EØ-71-70 | 60-60-70 | INDEX OF SHEETS & REVISION SUMMARY | 7- |
| | | | | 11-56-03 | 10-23-03 | Ø8-28-Ø3 | £Ø-71-7Ø | £Ø-6Ø-∠Ø | INDEX OF SHEETS & REVISION SUMMARY | -3 |
| William and a matter | 1 0-60-20 | 12-12-03 | 11-26-03 | 10-23-03 | £0-82-80 | £0-81-80 | EØ-71-70 | £Ø-6Ø-∠Ø | INDEX OF SHEETS & REVISION SUMMARY | Z- |
| The service of the se | 40-60-Z0 | 12-12-03 | 11-56-03 | 10-23-03 | £0-82-80 | £0-81-80 | £Ø-71-7@ | EØ-6Ø-ZØ | INDEX OF SHEETS & REVISION SUMMARY | 1-0 |
| | | | | | | | | £Ø-6Ø-∠Ø | TITLE SHEET | |
| COWWENTS | \ BEAISION | e BEAIRION | 2 BEAIZION | #EAISION | 3 BEAISION | Z BEAISION | I KEAIRION | AFC DATE | SHEET TITLE | 13 |

DATE: 02-09-04 RELEASE FOR CONSTRUCTION

PROJECT REFERENCE NO SHEET NO PROJECT REPRESENCE NO PROJECT REPRESENCE NO PROJECT PRO

KEAISION 20MWARY

North Carolina Constructors

THE LPA GROUP of North Carolina, p.a. GROUP of North Carolina, p.a. And Profesional court, Sulte Soi Releigh, North Carolina 27609

| -0 | :۲8 | :3TA0 | DESCRIPTION OF REVISION |
|----|-----|----------|--|
| 0 | яя | £0-60-7 | RELEASE FOR CONSTRUCTION |
| 1 | | 7-17-03 | REVISED SHEETS 5, 13, 8, 14 |
| 1 | нтэ | 8-18-03 | REVISED SHEETS 10A, 10C, & 11 |
| 8 | CTH | 8-28-03 | ADDED SHTS. 2M & 2N, REV. SHTS. 3,3A, 5.7.8.9.10.10A.11.13.14. REV. SUMM. |
| 1 | нтэ | 10-23-03 | REVISED SHEETS 11 & REV. SUMM. |
| 9 | нтэ | II-5e-03 | REVISED SHEET 5, 8, 9, 10A, 10C,11 & REV. SUMM. |
| 1 | нтэ | 12-12-03 | REVISED SHEET 14, 16A, & REV. SUMM. |
| Τ. | 180 | 20-60-70 | HEATZED ZHEEL S O' 34' 14' 12' & HEA' ZOWM' |

| DESCRIPTION OF REVISION | :3TAO | :78 |
|---|----------|-----|
| RELEASE FOR CONSTRUCTION | 50-60-T | 88 |
| REVISED SHEETS 5, 13, 8, 14 | 7-17-03 | |
| REVISED SHEETS 10A, 10C, 8, 11 | 8-18-03 | нтэ |
| ADDED SHTS, 2M & 2N, REV, SHTS, 3,3A, 5,7,8,9,10,104,11,13,14, REV, SUMM, | 8-28-03 | CTH |
| REVISED SHEETS 11 & REV. SUMM. | 10-23-03 | нтэ |
| REVISED SHEET 5, 8, 9, 10A, 10C,11 & REV. SUMM. | 11-56-03 | нтэ |
| REVISED SHEET 14, 16A, & REV. SUMM. | 12-12-03 | нтэ |
| REVISED SHEET 2 0, 3A, 14, 15, & REV. SUMM. | 20-60-ZO | JAL |
| KEAISIONS | | |

| | ENCINEER | DEZICN | YAWGA(| DA |
|---|--|----------|--------|-----|
| | 117. | MILLIN | 117. | |
| | 111111 | HOL ,M | NULL. | |
| | ENCINEER IN THE INTERPRETATION OF THE INTERP | ZNIO | | 0 |
| | 3 8 | 3214101V | ₹ .′′ | I |
| | \tilde{z} : I |) | | đĩ |
| - | | SS115 | \/ :\ | 1 / |
| | | JIA 72 | V | 1 - |
| | | Ĵ | 14011 | Ξ, |
| | = V.1 | (F22) | 0,7 | Ž |
| | 1/2V/2 | 3/33/ | 190/1 | `, |
| | 1/1:10 | ソスタン と | 17,11, | |

| CINEER | n: proj 2951 USTATION RDWY Final Paving re |
|--------|--|
| 11 | ніјевине : |
| | Document Control Number: |
| | CHECKED BA: DA |
| | |

| | n: proj 2951 USTATION RDWY Final Paving rev aummary aum | | |
|---|---|--|--|
| KEVISION SUMMARY | Ейіелате : | | |
| INDEX OF SHEETS AND | оевителі Сопто Литрег : | | |
| DEPARTMENT OF TRANSPORTATION RALEIGH RALEIGH RALEIGH | CHECKED BY: DATE: DATE: | | |
| | | | |

| KENIZION ZNMWARY BND | | : эшвише | | 11111111111111111111111111111111111111 |
|--|-------|-------------------------|---|--|
| INDEX OF SHEETS | : : | Document Control Number | | W. WEINEE |
| STATE OF TRANSPORTATION DEPARTMENT OF TRANSPORTATION RALEIGH | :3TAQ | CHECKED BJ: | | SZI155 V |
| | | | _ | Z Z Z Z Z Z Z Z Z Z Z Z Z Z Z Z Z Z Z |
| | | | | THE CAROLINIA |
| | | | | |

| | | | | 1110947 11211 | | | | | |
|--|--------------------|---------------|------------------|---------------|-----------------|---------------|------------------|--|----------|
| | | | | | | | EØ-6Ø-ZØ | PLAN SHEET | ØZ |
| | | | | - | | | EØ-6Ø-ZØ | T33HS NAJ9 | 61 |
| | | | | | | | EØ-6Ø-ZØ | PLAN SHEET | 18 |
| | | | | | | | EØ-6Ø-ZØ | T33H2 NA_19 | Δī |
| | | | | | | 12-12-03 | EØ-6Ø-ZØ | T33HS NAJ9 | 164 |
| | | | | | | | EØ-6Ø-ZØ | PLAN SHEET | 91 |
| | | | | | 40-60-20 | 12-12-03 | EØ-6Ø-ZØ | T33HS NAJ9 | 12 |
| | | | ≯0-60- ZØ | 12-12-03 | £Ø-8Z-8Ø | £0-71-70 | EØ-6Ø-ZØ | PLAN SHEET | ÞΙ |
| | | | | | 80-82-80 | £0-71-70 | E0-60-40 | T33HS NA19 | 13 |
| | | | | | | | £0-60-Z0 | T33HS NAJ9 | IS |
| | | | | | | | £0-60-70 | . T33HS NAJ9 | AII |
| | | 12-12-03 | II-Se-03 | 10-23-03 | 88-28-03 | £Ø-81-8Ø | EØ-60-70 | T33HS NAJ9 | II |
| | | | | 12-12-03 | 11-56-03 | £Ø-81-8Ø | E0-60-70 | T33HS NAJ9 | JØC |
| | | | | | | | E0-60-70 | T33HS NAJ9 | 108 |
| | | | 12-12-03 | 11-26-03 | £Ø-8Z-8Ø | £Ø-81-8Ø | £0-60-70 | T33HS NAJ9 | ∀Øī |
| | | | | | | £Ø-8Z-8Ø | E0-60-70 | T33HS NAJ9 | ØI |
| | | | | | 11-56-03 | £Ø-8Z-8Ø | E0-60-70 | PLAN SHEET | 6 |
| | | | | 12-12-03 | 11-56-03 | £Ø-8Z-8Ø | E0-60-70 | PLAN SHEET | 8 |
| | | | | | 12-12-03 | £Ø-8Z-8Ø | £0-60-70 | PLAN SHEET | L |
| | | | | | | | £Ø-6Ø-7@ | T33HS NAJ9 | 9 |
| -30 600 acc -3 4 4 | | | | 11-56-03 | £0-8Z-80 | £Ø-71-7Ø | EØ-60-70 | PLAN SHEET | g |
| and the second s | | | | | | | EØ-6Ø-70 | PLAN SHEET | * |
| | | | | | ₩-60-ZØ | £Ø-8Z-8Ø | £0-60-70 | CUARDRAIL & GUIDERAIL SUMMARY | Aε |
| 2 | | | | | | £Ø-8Z-8Ø | £Ø-6Ø-7@ | YAAMMUS JIAAGAAUO | 3 |
| tation 2 | | | | | | | ≯ Ø-60-ZØ | DETAIL OF ROCK ENERGY DISSIPATOR | SO |
| | | | | | | £Ø-8Z-8Ø | | MEDIAN OBSTRUCTIONS MEDIAN OBSTRUCTIONS | NZ |
| a de Maria de la composição de la compos | | | | | | £Ø-8Z-8Ø | | DETAIL OF GUARDRAIL PROTECTION ON DUAL BRIDGE APPROACH MEDIAN COSTAIL OF GUARDRAIL PROTECTION ON | MZ |
| COMMENTS | E LAISION BEAISION | P BEVISION | # BEAISION | 3 BEAISION | S BEAISION | I BEAIRION | DATE DATE | SHEET TITLE | NO. |

| RUMMARY | KEAIZION |
|---------|-----------------|
| | |

| 70 | | |
|-------------|-----------------------|---------|
| NOITOURT | RELEASE FOR CONS | |
| | | 5 |
| Z-J_V3A | J2 ⊁ 5Z−8 | METRICA |
| :01: 122110 | 1011 801 901 101 1010 | |

| - | | |
|-----|--------------------------|------------------|
| 1 | | |
| 1 | <i>Ე</i> ᠘₩ <i>5</i> ℤ−₩ | ?- <i>3</i> -\J\ |
| 1 - | PROJECT REFERENCE NO. | SHEET NO |
| | | |

| | KELEASE FOR CONS | NOITOURT |
|---|-----------------------|-----------|
| | | |
| ľ | JJ+9Z−¥ | REV_C-3 |
| L | PROJECT REFERENCE NO. | SHEET NO. |

DATE: 11-26-03

REVISION SUMMARY
RAD

STATE OF HORTH CAROLINA
DEPARTMENT OF TRANSPORTATION
RALEIGH



KENIZION ZNWWYKK

| | | | | | | | | £0-60-40 | CBO22 SECIIONS | Σ-X |
|----------|---------------|---------------|---------|---------------|---------------|-----------------|----------|-------------------|---------------------|--------------|
| | | | | | | | | E0-60-70 | CKOSS SECTIONS | Z-X |
| | | | | | | | | EØ-60-40 | CBOSS SECTIONS | I-X |
| | | | | | | 08-28-03 | £0-71-70 | EØ-60-40 | CBOSS SECTION INDEX | ΙÞ |
| | | | | | | | | E Ø-60- 70 | PLAN SHEET | Øŧ |
| | | | | | | | | EØ-60-70 | PLAN SHEET | 36 |
| | | | | | | | | EØ-6Ø-70 | PLAN SHEET | 38 |
| | | | | | | | | EØ-6Ø-70 | PLAN SHEET | 37 |
| | | | | | | | | EØ-6Ø-70 | PLAN SHEET | 9E |
| | | | | | | | | EØ-6Ø-4Ø | PLAN SHEET | 32 |
| | | | | | | | | EØ-6Ø-∠Ø | PLAN SHEET | 34 |
| | | | | | | | | EØ-6Ø-70 | PLAN SHEET | 33 |
| | | | | | | | | EØ-6Ø-7Ø | PLAN SHEET | 32 |
| | | | | | | | | EØ-6Ø-70 | PLAN SHEET | 18 . |
| | | | | | | | | £Ø-6Ø-70 | PLAN SHEET | Ø٤ |
| | | | | | | | 10-23-03 | EØ-6Ø-ZØ | T33H2 NAJ9 | 62 |
| | | | | | | | | EØ-60-40 | FLAN SHEET | 82 |
| | | | | | | | | EØ-60-40 | T∃∃HS NALA | ZZ |
| | | | | | | | | E0-60-70 | PLAN SHEET | 92 |
| | | | | | · | | | £Ø-60-40 | FLAN SHEET | SZ |
| | | | | | | | | EØ-6Ø-ZØ | PLAN SHEET | 24 |
| | | | | | | | | E0-60-40 | PLAN SHEET | S3 |
| | | | | | | | | EØ-6Ø-ZØ | PLAN SHEET | 22 |
| | | | | | | | 11-26-03 | EØ-6Ø-7Ø | PLAN SHEET | 1Z |
| | | | | | | | | EØ-60-40 | PLAN SHEET | 902 |
| СОММЕИТS | ∆ BEVISION | e BEAISION | EVISION | # BEAISION | 3 BEAISION | S BEAISION | BEAISION | DATE DATE | SHEET TITLE | NO. SHEET |

| | ENCINEER | DEZICM | YAWQA | 40A |
|-------|--------------|--------|--------|-------|
| ξ0-N | -11 1111 | M JOH | 11/1/1 | |
| | 11/2051 | NCINE | | |
| 7/1/1 | | , | , in | 怕 |
| = | ~ yh | SS112 | ١ ا | IA |
| | V. | , | ~80° | 1111/ |
| 7. | | 0/SS3 | 1061 | |
| | ENGINEER NO. | JAAD A | 1801 | |

| 4 0Я | NOISI |
|-------------|--------|
| | UCTION |
| | I b |
| 12 N | d) |
| | 58 |
| | SI |
| | |
| Ī | |
| | |
| 1111 | |
| | |
| ./ | |

| | KEAISIONS | | | |
|------------------|-------------|----------|-----|----|
| | | | | 9 |
| SHEET SI | REVISED | 11-26-03 | нтэ | 9 |
| SHEET 29 | BEVISED | 10-23-03 | HTD | 8 |
| SHEET 41 | BEVISED | 8-28-03 | нтэ | 3 |
| SHEET 41 | BEAISED | £0-71-7 | | B |
| CONSTRUCTION | RELEASE FOR | £0-60-1 | яя | 0 |
| 4 OL BEAIZION | DESCRIPTION | :3TA0 | :Y8 | 10 |



| E LPA GROUP of North Carolina, p., 4904 Professional Caurt, Suits 201 Raleigh, North Carolina 27609 | THE A LANGE CONSULTANTS |
|---|-------------------------|
| | |

CHECKED BA: _ :3TAU _

PRAWN BY:_

m. proj. 2951. USTATION. RUWY Final Paving rev summary. sum

. •3TAO _

DATE: 12-12-03 RELEASE FOR CONSTRUCTION PASSATC REFER NO. SHEET NO.

KENIZION ZOMWYKK

| | | | T | T | T | T | T | | | |
|----------|----------|----------|----------|----------|----------|---------------------------|---------------------------|---------------------------|----------------|-------------|
| | | | | | | | | 11-26-03 | CBOSS SECTIONS | X-28B |
| | | | | | | | | 11-56-03 | CBOSS SECTIONS | ¥82-X |
| | | | | | | | | EØ-6 0 -2Ø | CROSS SECTIONS | 8Z-X |
| | | | | | | | | EØ-6 0 -2Ø | CBOSS SECTIONS | /Z-X |
| | | | | | | | | E0-60-40 | CBOSS SECTIONS | X-26 |
| | | | | | | | | E 0-60- 70 | CBOSS SECTIONS | X-25 |
| | | | | | | | | E 0-60- 70 | CKO22 SECTIONS | X-24 |
| | | | | | | | | E 0-60- 70 | CBOSS SECTIONS | X-23 |
| | | | | | | | | EØ-6Ø-ZØ | CBOSS SECTIONS | ZZ-X |
| | | | | | | 12-12-03 | Ø8-28-Ø3 | E0-60-70 | CROSS SECTIONS | IZ-X |
| | | | | | | | 88-28-03 | EØ-6Ø-ZØ | CROSS SECTIONS | X-20 |
| | | | | | | | 88-28-03 | E0-60-70 | CROSS SECTIONS | 61-X |
| | | | | | | | | EØ-6Ø-ZØ | CHOSS SECTIONS | 81-X |
| | | | | | | | | EØ-60-40 | CBOSS SECTIONS | Δ1-X |
| | | | | | | | | EØ-60-40 | CBOSS SECTIONS | 91-X |
| | | | | | | | | EØ-60-40 | CBOSS SECTIONS | ZI-X |
| | | | | | | | | EØ-60-40 | CROSS SECTIONS | X-14 |
| | | | | | | | | EØ-6Ø-4Ø | CBOSS SECTIONS | X-13 |
| | | | | | | | | E 0-60- 70 | CBOSS SECTIONS | ZI-X |
| | | | | | | | | E Ø-60- 4 Ø | CROSS SECTIONS | 11-X |
| | | | | | | | 88-82-8 0 | EØ-6 0 -40 | CBOSS SECTIONS | ØI-X |
| | | | | | | 11-56-03 | Ø8-28 - Ø3 | EØ-60-40 | CROSS SECTIONS | 6-X |
| | | | | | 11-56-03 | £0-82-80 | £Ø-71-70 | £Ø-6Ø-∠Ø | CBOSS SECTIONS | 8-X |
| | | | | | 11-56-03 | £ 0 -82-8 0 | £Ø-71-7Q | EØ-6 0 -4Ø | CROSS SECTIONS | L-X |
| | | | | | | | £ 0- 8Z- 80 | E0-60-40 | CBOSS SECTIONS | 9-X |
| | | | | | | | | EØ-6 0 -4Ø | CROSS SECTIONS | G-X |
| | | | | | | | | EØ-6Ø-∠Ø | CBOSS SECTIONS | ⋫ −X |
| | L | 9 | g | b | 3 | Z | Ţ | RFC DATE | | ON |
| COMMENTS | BEAISION | REVISION | REVISION | BEAISION | BEAISION | REVISION | BEAISION |) JHB | SHEET TITLE | SHEET |

| ROADWAY DESIGN ENGINEER |
|---|
| 80-51-51 WHOL W WALLY |
| RODWRY DESIGN ENGINEER SEALS
| |

| KEAISIONS | | |
|--|----------|-----|
| | | |
| REV. SHEET X-21 | 15-15-03 | 920 |
| REV. SHTS. X-7 & X-8, ADDED X-26A & X-28B | 11-56-03 | нтэ |
| REV. SHTS, X-6 THRU X-10, & X-19 THRU X-21 | 8-28-02 | нтэ |
| REVISED SHEETS X-7 & X-8 | E0-71-7 | |
| RELEASE FOR CONSTRUCTION | £0-60-7 | 88 |
| DESCRIPTION OF REVISION | :3TAQ | :Y8 |

| MEVISIONS | | | | | | | |
|--|----------|-----|-----|--|--|--|--|
| | | | 9 | | | | |
| REV. SHEET X-21 | 12-12-03 | 920 | 9 | | | | |
| REV. SHTS. X-7 & X-8, ADDED X-28A & X-28B | 11-56-03 | CTH | 8 | | | | |
| REV. SHTS, X-6 THRU X-10, & X-19 THRU X-21 | 8-28-03 | СТН | Z | | | | |
| BEVISED SHEETS X-7 & X-8 | E0-71-7 | | į. | | | | |
| RELEASE FOR CONSTRUCTION | £0-60-7 | 88 | 0 | | | | |
| DESCRIPTION OF REVISION | :3TAQ | :YB | 'ON | | | | |

| $\overline{}$ | 'ON | :78 | :3TAQ | DESCRIPTION OF REVISION |
|---------------|--------|-----|----------|--|
| SJ8131 | 0 | 88 | £0-60-7 | RELEASE FOR CONSTRUCTION |
| 200101 | B | | E0-71-7 | REVISED SHEETS X-7 & X-8 |
| | 2 | нтэ | 8-28-03 | REV. SHTS. X-6 THRU X-10.8 X-19 THRU X- |
| | 8 | нтэ | 11-56-03 | REV. SHTS. X-7 & X-8, ADDED X-28A & X-28 |
| | 9 | 4S0 | 12-12-03 | REV. SHEET X-21 |
| | 9 | | | |
| | \neg | | | VEVISIONS |

| :3TAQ | :Y8 | ON | |
|----------|-----|----|--------------------------------|
| £0-60-7 | 88 | 0 | North Carolina Constructors |
| E0-71-7 | | B | masterintone 1 pullosed disall |
| 8-28-03 | нтэ | 2 | |
| 11-56-03 | нтэ | 8 | |
| 12-12-03 | 920 | 9 | |
| | | 9 | |
| | | | |

| A BR | |
|------|--|
| JUN | THE PART OF THE LPA GROUP OF NOrth Carolina, p.a. 494 Actional court. Sultre 201 Action Court. Sultre 201 Action Court. Color Since Sultre 201 Action CONSULTANTS (Action CONSULTANTS) |

STATE OF HORTH CAROLINA
DEPARTMENT OF TRANSPORTATION
RALEIGH

NEVISION SUMMARY

REVISION SUMMARY

__ :3TAU _

_ :3TAQ _

SHIIHS

Filename:

снескер вк:

_:Y8 NWARU

REVISIONS

88-28-03

88-28-B3

88-28-Ø3

88-28-Ø3

08-58-03

08-18**-0**3

88-18-**0**3

68-18-Ø3

08-28-03

08-28-03

£0-8Z-80

88-28-03

88-28-03

08-58-03

11-56-03

REVISION

EØ-6Ø-70

EØ-6Ø-7Ø

£0-60-70

EØ-6Ø-7Ø

EØ-60-70

EØ-6Ø-LØ

E0-60-70

E0-60-70

£0-60-70

11-56-03

EØ-6Ø-7Ø

11-26-03

11-56-03

11-26-03

EØ-6Ø-ZØ

EØ-6Ø-7Ø

EØ-6Ø-70

£0-60-L0

E0-60-70

EØ-6Ø-7Ø

60-60-70

EØ-6Ø-70

EØ-60-70

EØ-6Ø-70

EØ-60-70

11-26-03

EØ-6Ø-7Ø

DATE

BEC

Morth Carolina Censtructors

CROSS SECTIONS

SHEET TITLE

THE LPA GROUP of North Carolina, p.a. 25019 at North Carolina, p.a. 25019 as 25019 a

Ø9-X

6**≯-**X

8Þ-X

∠•-X

9**≯**-X

SÞ-X

≯₽-X

X-43

Z**≯**-X

∀I⊅-X

I⊅-X

7Ø₽-X

8Ø≠-X

₩**Ø**₽-X

ØÞ-X

6£-X

8£-X

∠ε−x

9E-X

35-X

¥€-X

X-33

X-35

IE-X

ØE-X

₩5Z-X

6Z-X

ON.

SHEET

| | DESCRIPTION OF REVISION | :3TAO | :Y8 |
|-----|---|----------|-----|
| 1 | RELEASE FOR CONSTRUCTION | €0-60-T | яя |
| 1 | JA32 3TACHU | £0-11-7 | |
| 1 | REV. SHTS. X-41 THRU X-43 | 8-18-03 | нтэ |
| ı | REV. SHTS. X-32 THRU X-34, X-36 THRU X-40 REV. SHTS. X-45 THRU X-49 | 8-28-03 | нтэ |
| ı | | 10-23-01 | нтэ |
| | ADDED X-294, X-404, X-408, X-406, X-414 REV, X-29, X-40, X-41 REV, SUM, SHT, | 11-59-02 | нтэ |
| - 1 | | | |

| OF REVISION | DESCRIPTION | :3TAO | :Y8 |
|------------------------------|-------------------------|----------|-----|
| CONSTRUCTION | RELEASE FOR | €0-60-T | มม |
| SEAL | STA09U | £0-11-7 | |
| ξ₽-X UЯНТ | REV. SHTS. X-41 | 8-18-03 | нтэ |
| (-34, X-38 THRU X-40 (-49 | REV. SHTS. X-32 THRU I | 8-28-03 | нтэ |
| 09-> | REV. SHTS. X-47 THRU | 10-23-01 | нтэ |
| | REV. X-29, X-40, X-41 R | 11-59-02 | нтэ |

| | DESCRIPTION OF REVISION | :3TA |
|-----|---|-------|
| 1 | RELEASE FOR CONSTRUCTION | £0-60 |
| - 1 | JA32 3TA09U | £0−7 |
| | REV. SHTS. X-41 THRU X-43 | €0-8 |
| ı | REV. SHTS. X-32 THRU X-34, X-38 THRU X-40 REV. SHTS. X-45 THRU X-49 | 20-83 |
| | REV. SHTS. X-47 THRU X-50 | £0-£2 |
| | ADDED X-29A, X-40A, X-40B, X-40C, X-41A REV, X-29, X-40, X-41 REV, SUM, SHT, | 9-02 |
| | KEVISIONS | |

10-23-03

10-23-03

10-53-03

10-23-03

11-26-03

11-56-03

BEAISION

| n: proj 2951 USTATION RDWY Final Pavi | ROADWAY DESIGN ENGINEER |
|---------------------------------------|-------------------------|
| Filename : | 50-72-11 WINDER |
| Document Control Number: | NOW WEINER OF THE |
| CHECKED BX: | GI177 |

REVISION

REVISION

REVISION

REVISION

KENIZION ZUMMARY

REVISION

| INDEX OF SHEETS | : nedmuN lorino. |
|--------------------------------------|------------------|
| DEPARTMENT OF TRANSPORTATION RALEIGH | :3TAQ |
| | |

COMMENTS

DATE: 11-26-03

RELEASE FOR CONSTRUCTION

PROJECT REFERENCE NO.

S-2 V3A

SHEET NO.

| əlīʻi | CO-70-11 WILLIAM NOW WORK WORK WORK WORK WORK WORK WORK WO | , |
|-------|--|---|
| Doc | SOMO NON NON NON NON NON NON NON NON NON | |
| СНЕС | | M |
| ¥AЯ0 | | IE |
| | V ŠEVI / TY | 1 = |
| | | Ξ. |
| | SEESTON THE CAROLINITION OF THE CAROLINITION O | WITH THE STATE OF |
| | CAROLINI | 11 |
| | CAROLLIN | |
| | .,,,,,,,,,,,,,,,,,,,,,,,,,,,,,,,,,,,,,, | |

| | 50-92-1 | 11/1/1/1/1/1/1/1/1/1/1/1/1/1/1/1/1/1/1 | |
|---|---------|---|--|
| | | SLIZZ VILLE | |
| | 1111 | | |
| 1 | | | |
| | | IN SEAL OF | |
| | | SEALL CAROLLY | |
| | 111 | NYJOHAJ HTANINI | |
| | | 111111111111111111111111111111111111111 | |

| REVISION SUMMARY | | Filename : | 50-11-11-11-11-11-11-11-11-11-11-11-11-11 |
|--|------------|-------------------------|--|
| INDEX OF SHEETS AND | : 3: | Document Control Number | N NOHWAZINI |
| STATE OF HORTH CAROLINA DEPARTMENT OF TRANSPORTATION RALEIGH | :3TAQ:3TAQ | CHECKED BA: | E LANGUEZ ! E |
| | | | SEAL CAROLINITION OF THE C |
| | | | WINDORAS HISTORY |
| | | <u> </u> | |
| | | | |
| | | | |
| | | | |
| | | | |
| | | | |
| | | | |


E0-60-70

E0-60-70

EØ-6Ø-ZØ

EØ-6Ø-LØ

E**0-60-**70

EØ-6**Ø**-2Ø

E0-60-70

EØ-6Ø-ZØ

E**0-60-**70

EØ-6Ø-LØ

E0-60-70

E**0-60-**70

EØ-6Ø-7Ø

E**0-60-**40

EØ-6**Ø**-2Ø

E0-60-70

EØ-6**0**-4Ø

E0-60-70

E0-60-70

E**0-60-**70

E0-60-70

E**Ø-60**-4Ø

E**0-60-**70

E0-60-70

EQ-6Q-7Q

E**Ø-60-**ZØ

E**0-60-**70

E**0-60-**70

JTAO

BFC

CROSS SECTIONS

CROSS SECTIONS

CROSS SECTIONS

CBOSS SECTIONS

CROSS SECTIONS

CBOSS SECTIONS

CKOSS SECTIONS

CBOSS SECTIONS

CBOSS SECTIONS

CBOSS SECTIONS

CBOSS SECTIONS

CROSS SECTIONS

CBOSS SECTIONS

CBOSS SECTIONS

CBOSS SECTIONS

CKOSS SECTIONS

CBOSS SECTIONS

CROSS SECTIONS

CROSS SECTIONS

CBOSS SECTIONS

CROSS SECTIONS

CBOSS SECTIONS

SHEET TITLE

87-X

LL-X

9Z-X

GZ-X

≯∠-X

£7-X

ZZ-X

ĭ7-X

ØZ-X

69-X

89-X

∠9-X

99-X

99-X

⊅9-X

£9-X

Z9-X

19-X

Ø9-X

6**G**-X

8G-X

ZG-X

99-X

9**9-**X

⊅G-X

£2-X

X-25

IG-X

"ON

SHEET

| KEAISIONS | | | |
|-------------------------------|----------|-----------|----|
| | | | 9 |
| | | | 9 |
| | | | 8 |
| REVISED SUMMARY SHEET | 11-26-03 | нтэ | 2 |
| REVISED SHEETS X-62 THRU X-72 | E0-11-7 | | 0 |
| RELEASE FOR CONSTRUCTION | 50-60-7 | 88 | 0 |
| DESCRIPTION OF REVISION | 13TAG | 17.E | .0 |

01-11-03

60-11-70

EØ-11-4Ø3

EØ-11-LØ

67-17**-0**3

80-11-**0**3

6**0-11-70**3

67-17-**0**3

EØ-11-LØ

67-17**-0**3

80-11-**0**3

REVISION

REVISION

| | VENDIONS | | | |
|-----------|----------------------|----------|-----|-----|
| | | | | 9 |
| | | | | 9 |
| | | | | 8 |
| 133 | REVISED SUMMARY S | 11-26-03 | нтэ | Z |
| ST-X UAHT | WEAISED SHEELS X-05. | £0-11-7 | | B |
| NOITON | RELEASE FOR CONSTR | £0-60-7 | яя | 0 |
| NOISIA | DESCRIPTION OF RE | :3TAG | BAi | .01 |

| KEVISIONS | | | _ |
|-------------------------------|----------|-----|---|
| | | | 9 |
| | | | 1 |
| | | | 1 |
| REVISED SUMMARY SHEET | 11-26-03 | нтэ | 3 |
| REVISED SHEETS X-62 THRU X-72 | ₹0-11-7 | | |
| RELEASE FOR CONSTRUCTION | 50-60-7 | яя | 0 |
| DESCRIPTION OF REVISION | 13TAG | BYı | |

| DEZIGN ENCINEEK | |
|------------------|-----|
| -77-11 NOSNHOF W | NIN |
| NCINEE OF 12 | |
| | ` |
| SSILE | |
| 1,133 | |

| NCINEER |
|----------|
| E0-97-11 |
| |
| |
| بهبسية |

| me: | REVISION SUMMARY |
|----------------------|---------------------------------------|
| nent Control Number: | INDEX OF SHEETS |
| .9TAQ :Y8 G | DEPARTMENT OF TRANSPORTATION RALEIGH |

COMMENTS

DATE: 11-26-03

RELEASE FOR CONSTRUCTION

PROJECT REFERENCE NO.

9-JTA38

SHEET NO.

| FR | mus.vrammus.vor."hnivaq lam.T*YWGA*/OTTAT&J*1892*lorq"ın | |
|-------------------------------------|--|---|
| E0-97-11 | Filename : | |
| | Document Control Number: | |
| \hat{\hat{\hat{\hat{\hat{\hat{\hat{ | CHECKED BY: DATE: | |
| | | _ |

REVISION

BEVISION

REVISION

REVISION

KENIZION ZOMWYKK

REVISION

| YAWDAOA | 4 OF REVISION |
|--|------------------|
| V NATION | CONSTRUCTION |
| | ST-X URHT Sa-X S |
| 1/4/2/2 | T33H2 YAAM |
| VS ON E | |
| | |
| wite 1 | |
| 1 1 1 1 V | |
| , 1 ž | |
| √o. Ξ | |
| 414/1/11/11/11/11/11/11/11/11/11/11/11/1 | |
| (07,1) | |
| HTRIVII, | |
| | |


| | | | - | | |
|----------------------------|----------|-----|---------------|------------------------------|--|
| DESCRIPTION OF REVISION | 13TAG | BAt | ON | | |
| RELEASE FOR CONSTRUCTION | 7-09-03 | яя | 0 | North Carolina Constructors | |
| REVISED SHEETS X-62 THRU X | E0-11-7 | | B | pantanatonal cuilaged disali | |
| REVISED SUMMARY SHEET | 11-26-03 | нтэ | Z | | |
| | | | 8 | | |
| | | i | 7 | | TRANSPORTATION CONSILTANTS Releigh, North Corrolling 27609 |
| | | | 9 | | THE LPA GROUP OF North Carolina, p.a., |
| KEAISIONS | | | | | |
| | | | | | |

| | DATE: 12-12- | 60 |
|---------|-----------------------|-----------|
| | RELEASE FOR CON | NOITOURTS |
| | | |
| METRICS | B-2547C | L-J-VIA |
| | PROJECT REFERENCE NO. | SHEET NO. |

KENIZION ZOMWYKŁ

| | | | | | | | | £Ø-6 € -∠Ø | CBOSS SECTIONS | X-103 |
|--|---------------|---------------|---------------|----------|---------------|---------------|---------------|------------------------------------|----------------|---------------|
| | | | | | | | | EØ-6 9 -70 | CBO22 SECTIONS | X-102 |
| | | | | | | | | E0-6 6 -40 | CROSS SECTIONS | 101-X |
| | | | | | | | | EØ-6 8 -70 | CBOSS SECTIONS | 7-100 |
| | * | | | | | | | EØ-6 8 -4Ø | CBOSS SECTIONS | 66-X |
| | | | | | | | 11-26-03 | £ 0-68- 70 | CBOSS SECTIONS | 86-X |
| | | | | | | | | 17 -26-0 3 | CBOSS SECTIONS | 87e-x |
| | | | | | | | | 11-56-03 | CBOSS SECTIONS | ∀ ∠6-X |
| | | | | | | | 11-56-03 | £Ø-6 Ø -∠Ø | CBOSS SECTIONS | 79-X |
| | | | | | | | | EØ-6 Ø -2Ø | CBOSS SECTIONS | 96-X |
| | | · | | | | | | EØ-6 8 -2Ø | CBOSS SECTIONS | G6-X |
| | | | | | | | | EØ-6 ® -∠Ø | CBOSS SECTIONS | ≯6- X |
| | | | | | | | | £ Ø-6& -∠Ø | CBOSS SECTIONS | £6-X |
| | | | | | | | | £ 0-68- ∠ 0 | CBOSS SECTIONS | Z6-X |
| | | | | | | | | £ 0-68- ∠ 0 | CBOSS SECTIONS | 16-X |
| | | | | | | | | £ 0-68- ∠ 0 | CBOSS SECTIONS | Ø6-X |
| | | | | | | | | £ Ø−68− ∠Ø | CBOSS SECTIONS | 68-X |
| | | | | | | | | £Ø-6 % -∠Ø | CBOSS SECTIONS | 88-X |
| | | | | | | | 12-12-03 | £ 0-68- ∠ 0 | CBOSS SECTIONS | ∠8-X |
| | | | | | | | 12-12-03 | £ 0 -6 0 -∠ 0 | CBOSS SECTIONS | 98-X |
| | | | | | | | | £ Ø−6-8 -∠ Ø | CBOSS SECTIONS | ⊊8-X |
| | | | | | | | | EØ- 68- ∠Ø | CBOSS SECTIONS | ₱8-X |
| | | | | | | | | £ 0-68- ∠ 0 | CBOSS SECTIONS | X-83 |
| | | | | | | | | £Ø-6 8 -∠Ø | CBOSS SECTIONS | Z9-X |
| | | | | | | | | £Ø-6 8 -∠Ø | CROSS SECTIONS | I8-X |
| | | | | | | | | E Ø-6Ø- ∠Ø | CROSS SECTIONS | Ø8-X |
| for the months and the management of the second of the sec | | | | | | | | E 0-69- 70 | CBOSS SECTIONS | 6 <i>L</i> -X |
| COMMEN1S | \ KE√ISION | REVISION 6 | P BEAISION | HEAISION | 3 BEAISION | S KEAIRION | I KEAISION | 37€C DATE | SHEET TITLE | NO. |

| KEAISIONS | | | |
|--|----------|------------|-----|
| | | | 9 |
| | | | 9 |
| | | | 8 |
| REVISED SHEET X-86, X-87 | 15-15-03 | HTO | Z |
| ▼DDE D X-97A, X-97B, REV X-97, X-95 | 11-56-03 | нтэ | L |
| RELEASE FOR CONSTRUCTION | £0-60-7 | н в | 0 |
| DESCRIPTION OF REVISION | :3TAG | :78 | .OH |

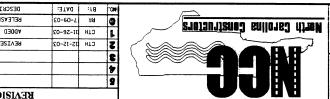

| 904 Professional Court, Suite 20: Raielgh, North Carolina 27609 | CHOLD CONSULTANTS | |
|--|-------------------|--|
| .PA GROUP of North Carolina, p.a. | 1 BHT AG (| |

STATE OF TRANSPORTATION
DEPARTMENT OF TRANSPORTATION
RALETON

INDEX OF SHEETS AND REVISION SUMMARY

Filename :


снескер вк:

_:Y8 NWARG

_ :3TAO _

_ PATE: _

DATE: 7-17-03 RELEASE FOR CONSTRUCTION PROJECT REFERENCE NO. SHEET NO.

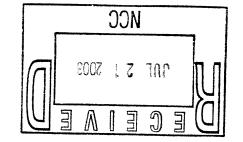

KENIZION ZUMMARY

| | | | | | | | | E 0-60- 70 | CBOSS SECTIONS | ZZI-X |
|----------|---------------|---------|----------|----------|---------------|---------------|---------------|-------------------|----------------|----------------|
| | | | | | | | | £0-60-70 | CBOSS SECTIONS | 9ZI-X |
| | | | | | | | | £0-60-70 | CROSS SECTIONS | X-125 |
| | | | | | | | | EØ-6Ø-7Ø | CBOSS SECTIONS | 7-124 |
| | | | | | | | | E0-60-70 | CBOSS SECTIONS | X-123 |
| | | | | | | | | EØ-6Ø-7Ø | CBOSS SECTIONS | X-122 |
| | | | | | | | | £0-60-40 | CBOSS SECTIONS | X-121 |
| | | | | | | | | £0-60-40 | CBOSS SECTIONS | ØZT-X |
| | | | | | | | | EQ-60-1Q | CBOSS SECTIONS | 911-X |
| | | | | | | | | £Ø-6Ø-7Ø | CBOSS SECTIONS | 811-X |
| | | | | | | | | EQ-60-1Q | CBOSS SECTIONS | ∠II-X |
| | | | | | | | | EØ-6Ø-4Ø | CBOSS SECTIONS | 911-X |
| | | | | | | | | EØ-60-70 | CBOSS SECTIONS | 211 - X |
| | | | | | | | | £0-60-40 | CBOSS SECTIONS | 711-X |
| | | | | | | | | EØ-6Ø-4Ø | CBOSS SECTIONS | X-113 |
| | | | | | | | | EØ-6Ø-4Ø | CBOSS SECTIONS | X-112 |
| | | | | | | | | EØ-6Ø-7Ø | CBOSS SECTIONS | 111-X |
| | | | | | | | | £Ø-6Ø-7Ø | CBOSS SECTIONS | ØII-X |
| | | | | | | | | £0-60-40 | CBOSS SECTIONS | 901−X |
| | | | | | | | | EØ-6Ø-7Ø | CBOSS SECTIONS | 8Ø1-X |
| | | | | | | | | EØ-6Ø-4Ø | CROSS SECTIONS | ∠Ø ⊺ -X |
| | | | | | | | | EØ-6Ø-7Ø | CROSS SECTIONS | 9 0 I-X |
| | | | | | | | | EØ-6Ø-4Ø | CBOSS SECTIONS | 901- X |
| | | | | | | | | EØ-6Ø-7Ø | CHOSS SECTIONS | 701-X |
| COMMENTS | ∆ BEAISION | EAISION | E AIZION | REVISION | 3 BEAISION | S BEAISION | I KEAIRION | RFC DATE | SHEET TITLE | NO. |

| NEER | SICH ENCI | BO YAWO | JA0A |
|----------|--------------------|--------------|--------------|
| 60-L1-L | ZIMHOU | N NI | '// - |
| III. | SINE | N3 170 | |
| <u>}</u> | SI 12 | z \/~ | I |
| | > NOISS | OKOLE Z | 1111111 |
| 111, | CAPOLINI SSION EAL | HTRO. | |

| BETEVEE FOR CONSTRUCTION | 7-09-03 | 98 :Y8 | .01 |
|--------------------------|---------|-----------|-----|
| 2435 3L400P | 70/21/2 | | Į, |
| | | | 2 |
| | | | 8 |
| | | | 9 |
| | | | 9 |
| KEAISIONS | | | |

EQ-6Q-7Q



THE LPA GROUP of Worth Corolling, p.g. LPA GROUP of Worth Corolling p.g. A904 Professional Court, Sulfe Sci Rodelgh, Worth Corolling 21609

STATE OF NORTH CAROLINA
DEPARTMENT OF TRANSPORTATION
RALEIGH

REVISION SUMMARY

mus.vrammms var'sning lania vWON-VOITATSU 1262 forq in

DATE:

Document Control Number :

CHECKED BA:

_:Y8 N**W**AЯQ

CROSS SECTIONS

X-128

| | RELEASE FOR CONS | |
|------------------|-----------------------|---------|
| Private And Name | | |
| 6-0-V3A | JJ\$9Z-Y | METRICS |
| SHEET NO. | PROJECT REFERENCE NO. | |

KENIZION ZUMMARY

| SON | | | | | | | | | | |
|-------------------|----------------|----------------------|---------------|---------------|---------------|---------------|---------------|-------------|----------------|----------------|
| VOII - | | | | | | | | | | |
| 2007 - 2 700 15 7 | | | | | | | | E0-60-70 | CROSS SECTIONS | 6 + 1-X |
| G 302 1.7 300 G | | | | | | | | £0-60-70 | CROSS SECTIONS | 8 + I-X |
| | | | | | | | | E0-60-70 | CROSS SECTIONS | 741-X |
| <u>Uecela EU</u> | | | | | | | | EØ-6Ø-7@ | CROSS SECTIONS | 9 + I-X |
| | | | | | | | | EØ-6Ø-70 | CROSS SECTIONS | 9₹ 1-X |
| | | | | | | | | £Ø-6Ø-7@ | CROSS SECTIONS | ⊅⊅ ₹-X |
| | | | · · | | | | | E0-60-70 | CROSS SECTIONS | X-143 |
| | | | | | | | | 60-60-70 | CROSS SECTIONS | X-142 |
| | | | | | | | | EQ-6Q-7Q | CROSS SECTIONS | X-14I |
| | | | | | | | | EQ-6Q-7Q | CROSS SECTIONS | 0+I-X |
| | | | | | | | | EØ-6Ø-7Ø | CBOSS SECTIONS | 9£1-X |
| | | | | | | | | EQ-6Q-7Q | CROSS SECTIONS | 8£1-X |
| | | | | | | | | E0-60-70 | CBOSS SECTIONS | ZEI-X |
| | | | | | | | | E0-60-70 | CROSS SECTIONS | 9E1-X |
| | | | | | | | | EØ-6Ø-70 | CROSS SECTIONS | 9EI-X |
| | | | | | | | | £0-60-70 | CROSS SECTIONS | X-134 |
| | | | | | | | | EØ-6Ø-70 | CBOSS SECTIONS | X-133 |
| | | | | | | | | EØ-6Ø-70 | CROSS SECTIONS | X-132 |
| | | | | | | | | EØ-6Ø-70 | CEOSS SECTIONS | 151-X |
| | | | | | | | | £Ø-6Ø-70 | CKOSS SECTIONS | Ø£1-X |
| | | | | | | | | EØ-6Ø-7Ø | CKOSS SECTIONS | 6ZI-X |
| COMMENTS | LEVISION TEVEN | BEVISION REVISION | 2 BEAISION | REVISION 4 | 3 BEAISION | S REVISION | I BEAISION | RFC DATE | SHEET TITLE | NO. |

ROADWAY DESIGN ENGINEER

| DESCRIPTION OF REVISION | :3TAG | :۲8 | ON. |
|--------------------------|-----------------|-----|-----|
| RELEASE FOR CONSTRUCTION | ₹0-60- <i>L</i> | яя | 0 |
| 3 010 416 5646 | CLIL | | L |
| | | | 2 |
| | | | 8 |
| | | | 9 |
| | | | 9 |
| KEAISIONS | | | |



THE LPA GROUP of North Caroling, p.g.,
LPA 1994 Protesional Court, Suite 201
Releigh, North Carolina 21609
RAMSPORTATION CONSULTANTS
Releigh, North Carolina 21609

REVISION SUMMARY STATE OF TRANSPORTATION

RALEIGH

RALEIGH

RALEIGH

ni*proj*295I*USTATION*RDWY*Final Paving*rev*sumary.sum

CHECKED BA:

_:Y8 NWARO

DATE:

_ :3TAQ _

ROADWAY DESIGN ENGINEER

CHOL N WILL

| | | | _ |
|---|---------|-----|-----|
| DESCRIPTION OF REVISION | :3TA0 | :YB | ON! |
| RELEASE FOR CONSTRUCTION | £0-60-₹ | DSP | 0 |
| MEAIZED INDEX OF SHEETS | €0-T1-T | ราค | L |
| MEAIZED INDEX OF SHEETS TO INCLUDE 2M, 2N | 8-28-03 | нтэ | Z |
| | | | 8 |
| | | | * |
| | | | 9 |
| KEVISIONS | | | |

| DESCRIPT | :3TA0 | :78 | ON! | |
|------------------|---------|-----|-----|---|
| BELEASE F | £0-60-₹ | 4SQ | 0 | |
| BEAISED | €0-T1-T | STr | L | / |
| MENIZED INDEX OF | 8-58-03 | нтэ | 3 | |
| | | | 8 | |
| | | | * | 1 |
| | | | 9 | |
| | | | - | ł |



P.O. BOX 35624 CHARLOTTE, N.C. 28235 RALPH INHITEHEAD ASSOCIATES, INC.

OR EXCAVATION APROACHING A BRIDGE.

USING THE RADII NOTED ON THE PLANS.

BE AS SHOWN ON THE PLANS.

AND DETAILS IN THE PLANS.

ON THE TYPICAL SECTIONS.

UNMITS ESTABUSHED BY METHOD III.

FOLLOWING THE CLEARING OPERATION.

LOCATIONS SHOWN ON THE PLANS.

PRIOR TO ADJUSTING THE GUARDRAIL LOCATIONS.

THE LPA GROUP OF NORTH COROITO, p.

CROSS-SECTION PRIOR TO SETTING OF THE SLOPE STAKES FOR THE EMBRAKMENT

THE DESIGN/BUILDER SHALL CHECK THE STRUCTURE END BENT PLANS, DETALS, AND

CONSTRUCTION. THE DESIGN/BUILDER SHOULD CONSULT WITH THE ENGINEER

THE GUARDRAL LOCATIONS SHOWN ON THE PLANS MAY BE ADJUSTED DURING

900000 RADII OR RADII AS SHOWN ON THE PLANS. LOCATIONS OF DRIVES WILL

ONDERDRANS SHALL BE CONSTRUCTED IN ACCORDANCE WITH STD. NO. 815.03.

BERM DITCHES SHALL BE CONSTRUCTED IN ACCORDANCE WITH STD. NO. 240.01 AT

THE DESIGN/BUILDER WILL BE REQUIRED TO DO ALL NECESSARY WORK TO PROVIDE

GRADE SHOULDER SLOPES AND SUBGRADE SHOULDER SLOPES ON NORMAL CROWN

ALL CURVES ON THIS PROJECT SHALL BE SUPERFLEVATED IN ACCORDANCE WITH

SUPERELEVATION IS TO BE REVOLVED ABOUT THE GRADE POINTS SHOWN

GRADE LINES MAY BE ADJUSTED AT THEIR BEGINNING AND ENDING AND AT

OR FUTURE SURFACING AT GRADE POINTS SHOWN ON THE TYPICAL SECTIONS.

THE GRADE LINES SHOWN DENOTE THE FINISHED ELEVATION OF THE PROPOSED

STRUCTURES IN ORDER TO SECURE A PROPER LIE-IN.

CLEARING ON THIS PROJECT SHALL BE PERFORMED TO THE

EBOSION CONTROL DEVICES SHALL BE INSTALLED IMMEDIATELY

ZONE UNTIL IMMEDIATELY PRIOR TO BEGINNING GRADING OPERATIONS.

CEEPHING OFFREIDONS (NOI GROBBING) SHALL BE ALLOWED IN THIS BUFFER

OR CENTER OF DEPRESSION)--AS SHOWN IN THE PERMIT DRAWINGS, ONLY

DEFINED AS A 50 FOOT (16 METER) BUFFER ZONE ON BOTH SIDES OF

OPERATIONS UNTIL IMMEDIATELY PRIOR TO BEGINNING GRADING OPERATIONS

DESIGN/BUILDER MAY PERFORM CLEARING OPERATIONS, BUT NOT GRUBBING

THIS ALSO REQUIRES SPECIAL PROCEDURES TO BE USED FOR SEEDING

AND GRADING OPERATIONS WITHIN THE AREA IDENTIFIED ON THE PLANS.

SPECIFICATIONS, THE "ENVIRONMENTALLY SENSITIVE AREA" SHALL BE

IN AREAS IDENTIFIED AS "ENVIRONMENTALLY SENSITIVE AREAS", THE

NSED FOR CLEARING AND GRUBBING, TEMPORARY STREAM CROSSINGS, AREA". THIS DESIGNATION REQUIRES SPECIAL PROCEDURES TO BE

THIS PROJECT IS LOCATED IN AN "ENVIRONMENTALLY SENSITIVE

CENERAL NOTES - METRIC

AND MULCHING AND STAGED SEEDING WITHIN THE PROJECT.

AS DESCRIBED IN SECTION 200, ARTICLE 200-1, IN THE STANDARD

THE STREAM (OR DEPRESSION), MEASURED FROM THE TOP OF STREAMBANK,

STREET RETURNS SHALL BE CONSTRUCTED IN ACCORDANCE WITH STD. NO. 848.04

DEINEWAYS SHALL BE CONSTRUCTED IN ACCORDANCE WITH STD. NO. 848.02 USING

SHOULDER DRAINS SHALL BE CONSTRUCTED IN ACCORDANCE WITH STD. NO. 816.02 OR 816.03

SUITABLE CONNECTIONS WITH ALL ROADS, STREETS, AND DRIVES ENTERING THIS PROJECT.

ULHIS MUIT WAKE SOBERETEVATED AND TANGENT PAVED SHOULDER DEPTHS CONSISTENT.

ZECTIONS, SHALL BE MANIANED LHROUGH SUPERLEVALED SECTIONS OF THE ROADMAY

ACCORDANCE WITH STD. NO. 560.01 OR 560.02. THE ALGEBRAIC DIFFERENCE, OF FINISHED

STD. NO. 225.04 USING THE RATE OF SUPERELEVATION AND RUNOFF SHOWN ON THE PLANS.

SHOULDER CONSTRUCTION ON HIGH SIDE OF SUPERELEVATED CURVES SHALL BE IN

€0-87-8

SEE SHEEL IB

INDEX' CEN' NOLES

FINAL PLANS

DEPARTMENT OF TRANSPORTATION

STATE OF NORTH CAROLINA

DRAWINGS" IS BEING PROVIDED TO THE CONTRACTOR. NOTE I: THE ENTIRE UST OF THE "ROADWAY STANDARD

neredy are considered a part of these plans: Dated January 15, 2002 are applicable to this project and by reference Highway Design Branch - N.C. Department of Transportation - Raleigh, N.C., The Following Roadway Standards as appear in Roadway Standard Drawings"

ROADWAY METRIC STANDARD DRAWINGS

| CHO22 SECTIONS | 6⊁I-X NYH⊥I-X |
|----------------------|----------------------|
| PROFILES | OF NAHT ZS |
| FINAL PLANS | 4 THRU S4 |
| YAAMMUS JIAAGAAN | AE UAHT E |
| D E L∀IT? | ZF THRU ZI,ZM,ZN |
| TYPICAL SECTIONS | 2 THRU SE |
| CONVENTIONAL SYMBOLS | 2/ |
| SQAAQNATS | 81 |
| NDEX,GENERAL NOTES | Αl |
| BENIZION ZONWAY | BEV_C-I THRU REV_C-9 |
| TITLE SHEET | 1 |
| 2HEE | ONEEL NO. |

NDEX OL SHEELS

-STATION +/- INDICATES VERTICAL SAG WHICH HAS TWO OUTLETS

-2547c. tsh

CHECKED BA:

FYB NWAR

ument Control Number :

DATE:

DATE:

3CAND NIM 52 NOTES: -IN CUT SECTIONS, OUTLET PIPES SHALL BE A IX GRADE INSTEAD OF A

OUTLETS AT 135+40 (SNI22); 136+80 (SNI25); 138+40 (SNI28); 139+60 (SNI31)) 09+651 01 85+451 MOH3

OUTLETS AT 90+64 (SNB): 92+40 (SNI4): 93+73 (SNI9): 95+90 (SNZ7) 06+96 01 49+68 MOH = OUTLETS AT 87+47 (SN2); 88+40 (SN3); 89+35 (SN7) 19+68 O1 15+18 MOH=

WAL INSIDE SHOULDER DRAINS

OUTLETS AT 140+70; 142+00 (SN134A); 142+80; 143+80 (SN135); 144+20 0Z+++50 123+621 MOH=

09+451;(SIINS) 02+451;05+551;04+251;07+151;(OIINS) 00+151;(70INS) 08+651 OUTLETS AT 123+00; 124+05 (SN96); 125+60 (SN98); 127+00 (SN101); 128+40 (SN104); FROM 122+00 TO 134+60 (Z6NS) 04+0ZI

OUTLETS AT 114+80 (SN79); 116+15 (SN83); 117+30; 118+00; 118+80 (SN87); 119+80; - HOM 114+80 TO 122+00

> OUTLETS AT 111+70; 111+82 (SN67); 112+90; 113+80 59++II O1 07+III MOA3

OUTLETS AT 108+70; 109+78 (SN54); 110+40 (SN61) FROM 108+70 TO III+I2

OUTLETS AT 104+43+/- (SN39), 105+30 (SN44), 106+70 (SN46), 107+65 (SN52), E++801 O1 SI++01 MOH+43 (25NS) 97+501:01+201

OUTLETS AT 95+00; 95+90 (SN24); 97+33 (SN28); 98+20; 99+00; 100+00; 101+20; FROM 94+28 TO 103+25

OUTLETS AT 86+60 CROM 86+60 TO 87+80

NBT ONLSIDE SHONIDER DRANS

(ZIINS) 00+1214(60INS) 08+621 OUTLETS AT 124+15 (SN97); 125+60 (SN100); 127+00 (SN103); 128+40 (SN106);

> FROM 122+00 TO 131+00 OUTLETS AT 120+70 (SN9))

FROM 120+70 TO 122+00 OUTLET AT 97+43 (SN29); 98+80 (SN31); 100+02 (SN34); 101+57 (SN35); 103+25 (SN36) FROM 95+88 TO 103+25

EBT INSIDE SHONTDEB DBAINS

(YEEINS) 99+1+1:09+0+1 122+09 (2NISI); 122+80; 129+80 (2NIS4); 121+80; 128+40 (2NISL); 120+80 OUTLETS AT 131+00(SNII); 132+00 (SNII4); 133+00; 133+80 (SNII7A); 134+20 (SNII7); FROM 130+10 TO 144+20

OUTLETS AT 115+15; 115+90; 116+60; 117+60 (SN85B); 118+50; 119+40 (SN89); 120+70 (SN93) FROM 115+15 TO 121+40

EBL OUTSIDE SHOULDER DRAINS CONT'D.

GENERAL NOTES - METRIC (CONT'D)

OUTLETS AT 111+95 (SN69); 113+00; 114+00 EROM III+95 TO II5+15

OUTLETS AT 108+45; 109+78 (SN56); 110+38 (SN58) -ROM 108+45 TO 111+34

OUTLETS AT 104+43+/- (SN41); 105+30 (SN45); 106+65 (SN48); 107+20 (SN49) SI+801 O I SI++OI WON-

OUTLETS AT 91+40;92+40 (SNIS); 93+10 (SNIS); 93+73 (SN20);94+70;95+90 (SN25) 06+96 O.L 29+68 WON =

> OUTLETS AT 86+60;87+50;88+40 (SN4);89+20; 29+68 01 09+98 WOH-

EBL OUTSIDE SHOULDER DRAIN

(NOTE: 'SN'=STRUCTURE NUMBER)

-RPCY16- STA, 4+40 TO 5+30

-L- STA, I2I+00 TO I22+00

01+68 01 09+88*V1S -7-

SLOPE TO BE USED. SEE RECOMMENDATIONS FOR ANTICIPATED LOCATIONS. ALL LOOSE ROCK IS ADEQUATELY REMOVED AND TO DETERMINE THE ALLOWABLE

STOPES AS SHOWN ON THE CROSS SECTIONS. SHOULD BE CONSTRUCTED AT A SLOPE OF ISHINN). THE EARTH CUT ABOVE

SHOULD BE CONSTRUCTED AT A SLOPE OF ISHINN). THE EARTH CUT ABOVE THE LOCATIONS OF SOFT WEATHERED ROCK AND HARD ROCK

-1- STA 126+20 TO 131+85

AT THE FOLLOWING LOCATIONS FOR SLOPE STABILITY. USE OF UNDERDRANS INDERDRAINS ARE RECOMMENDED AT LEAST AT THE TOE OF CUT SLOPES

91+16 01 94+0671S -7-

TOCATIONS OF GROUNDWATER WITHIN IS METERS OF SUBGRADE: EXPECTED TO BE PLACED AT THESE LOCATIONS. DESIGN SUBGRADE AT THE LOCATIONS LISTED BELOW, UNDERDRANS ARE

PIPES ACROSS EXISTING PONDS SHOULD BE CONDUCTED AS DIRECTED.

-RPCY16- STA.4+40 TO 5+30

UNDERCUT EXCAVATION FOR SUBGRADE STABILITY IS EXPECTED AT THE

FEATURES OR LOW-LYING AREAS.

GROUND). SIMILAR TOE OF SLOPE UNDERCUT MAY BE REQUIRED WHERE IS EXPECTED FROM STAISI+20 TO 132+00 (ONE METER BELOW EXISTING UNDERCUT/STABIUZATION FABRIC FOR SLOPE/EMBANKMENT STABIUTY

GENERAL--REVIEW THE ROADWAY FOUNDATION RECOMMENDATIONS FOR ROADWAY FOUNDATION RECOMMENDATIONS:

10 6

DATE: 8-28-03

RELEASE FOR CONSTRUCTION

77727-9 PROJECT REFERENCE NO. SHEET NO.



SHOULDER DRANS

-RPBY16- STA.2+50 TO 4+20

UNSUITABLE EXCAVATION MATERIAL IS PRESENT AT THE FOLLOWING LOCATIONS.

THE GEOTECHNICAL ENGINEER SHOULD OBSERVE ALL ROCK CUTS TO CONFIRM

SNOLIVOOT XOON IV

91+16 01 94+06 VIS -7-IN OTHER LOCATIONS SHOULD BE CONSTRUCTED AS DIRECTED.

05+0+1 OT 08+651 AT2 --1-

98+151 01 08+931 ¥1S -7-

00+96 01 00+96 VIS -7-

GROUNDWATER WAS IDENTIFIED ABOVE OR WITHIN 1.8 METERS OF THE

SEE RECOMMENDATIONS FOR LOCATION OF LIME/CEMENT. UNDERCUT ALONG CULVERT SUBGRADE STABILIZATION IS REQUIRED THROUGHOUT THE PROJECT.

-RPBY16- STA.2+50 TO 4+20

01+68 01 09+88 ♥ 15 -7- *SN01 1920 10 88+10

EMBANKMENTS EXTEND INTO PONDS (THAT WILL BE DRAINED), DRAINESE SPECIFIC RECOMMENDATIONS, INCLUDING THE FOLLOWING:

GENERAL NOTES - METRIC (CONT'D)

P.O. BOX 35624 CHARLOTTE, N.C. 28235 RALPH INHITEHEAD ASSOCIATES, INC.

THE LPA GROUP Of North Caroling, p.c

820.01 Funnel and Funnel Drain – 300mm Metal Funnel 60.03 Funnel Installation in Shoulder Berm Gutter

816.04 Markers for Drainage Structure and Concrete Pad

DIVISION 7 - CONCRETE PAVEMENTS AND SHOULDERS 70.001 Concrete Povement Joints - Construction and Contraction plants - Construction and Contraction bint Loyour - for Rigid Doweled Povement at Bridges 700.002 Exponsion Joint Loyour - for Rigid Doweled Promise Action 10 Provided Provi

DIVISION 5 - SUBGRÂDE, BASES AND SHOULDERS
560.01 Method of Shoulder Construction - High Side of Superelevated Curve - Method I 560.02 Method of Shoulder Construction - High Side of Superelevated Curve - Method II

70.04 Percilei Pipe End Section - Prefabricated Steel Section for 400mm to 800mm Pipe 330.05 Cross Pipe End Section - Prefabricated Steel Section for 450mm to 800mm Pipe

300.03 Method of Structural Plate Pipe and Pipe Arch Installation – Method 'N' 300.03 Method of Structural Plate Pipe and Pipe Arch Installation – Method 'S' 310.02 Parallel Pipe End Section – Precast Concrete Section for 375mm to 500mm Pipe 310.


816.01 Concrete Pads – for Shoulder Drain Installation 816.02 Aggregate Shoulder Drain 816.03 Geocomposite Shoulder Drain

806.02 Granite Right-of-Way Marker niord brills and Blind Drain S15.03 Pipe Underdrain and Blind Drain

710.01 Concrete Povement - Station Marking

Bnitzix3 of tnemevo9 besogot9 gniy7 60.007

stnemevo9 tloriqsA - sqrit2 eldmu8 belliM f0.233 Ashhali Wearing Surface on Approach Slab (0.05 Personal Tepanics)

DIVISION 6 - ASPHALT BASES AND PAVEMENTS

30.005 A borthem – notifullation legit to borthem 10.005 B' B' borthem – notifullation eqif to borthem 20.005

225.09 Guide for Shoulder and Ditch Transition at Grade Separations

DIVISION X - EARTHWORK

200.03 Method of Clearing – Method III












200.09 Earth Berm Median Pier Protection

ROADWAY METRIC STANARD DRAWINGS

240.01 Guide for Berm Ditch Construction

DIVISION 4 - MAJOR STRUCTURES

310.10 Driveway Pipe Construction

DIAISION 3 - HILE CULVERTS

DIVISION 2 - EARTHWORK

STD.NO. TITLE

700.03 Dowel Assembly
700.04 Concrete Pavement Header Board

806.01 Concrete Right-of-Way Marker DIAISION 8 - INCIDENTALS

720.01 Concrete Shoulders

ROTTH CREOINS CONSTRUCTORS

:3TAO :YB .OV EO-60-7 420 (0) 9

DESCRIPTION OF REVISION METERASE FOR CONSTRUCTION KEAISIONS

ROADWAY DESIGN ENGINEER 50-9-7 WHILLIAM NOHOT W WILL SWEINE

876.03 Guide for Rip Rap at Pipe Outlets 876.03 Drainage Ditches with Class 'A' Rip Rap 876.04 Drainage Ditches with Class 'B' Rip Rap 86-0.4 Barbed Wire Fence with Wood Posts (2 - 7 Strand 86-0.05 Glore Screen - Chain Link Fabrio Guardrail Mounted 876.01 Rip Rap in Channels Sex.0.3 structure Anchor Units debt of the Condens of Standard) in Lieu of Standard) web Co.0.3 structure Anchor Units (Beg. October 2002 Let Use Detail in Lieu of Standard) Co.0.3 Woven Wire Fence – with Wood Post Sew Co.0.3 who wan Wire Fence – with Steel Post Sew Co.0.3 with Wood Sex (Sex Co.0.3) with Wood Sex (Se So. Souardrail Installation 862.07 Guardrail Placement B57.01 Precast Reinforced Concrete Barrier - 1.0m Single Faced HBOJI Guide for Berm Drainage Outlet - 600mm and 800mm pipe
BS2.01 Concrete Islands
BS2.02 Concrete Mountable Median - for Use with Rigid or Flexiple Pavement
BS2.04 Method for Placement of Drop Inlets in Consead Median - Leiring 450mm
BS2.05 Median for Placement of Drop Inlets in Concrete Bass.06 Median Use with 450mm
BS2.07 Median for Placement of Drop Inlets in Concrete Islands
BS2.08 Method for Placement of Drop Inlets in Concrete Islands
BS2.01 Median Construction - With Cuth and Gutter
BS2.01 Concrete Median Trop of Median - Height
BS4.02 Double Faced Concrete Bornier - Types 'It, 'II' and 'IX'
BS4.03 Double Faced Concrete Bornier - Types I', 'II' and 'IX'
BS4.03 Concrete Median Transition Barrier - Location of Overhead Assembly
BS5.01 Precast Reinforced Concrete Bornier - 1.0m Single Faced 850.01 Concrete Paved Ditches
850.10 Concrete Paved Ditches Dulinge Outlet - 400mm and 450mm Pipe
850.11 Guide for Berm Drainage Outlet - 600mm and 800mm Pipe
850.17 Concrete Islands 848.02 Driveway Turnout - Radius Type 848.03 Driveway Turnout - Drop Curb Type 848.03 Driveway Turnout - Drop Curb Type 848.03 A Street Turnout 846.02 Expressway Gutter Transition for Drop Inlet 846.01 Concrete Curb, Gutter and Curb & Gutter 844.01 Concrete Steps 844.02 Brick Masonry Steps 842.01 Concrete and Brick Retaining Walls - with No Surcharge 842.02 Concrete and Brick Retaining Walls - with Sloping Surcharge 842.03 Concrete and Brick Retaining Walls - with 0.6m Surcharge 842.03 Concrete and Brick Retaining Walls - with 0.6m Surcharge 840.77 Concrete and Brick Pipe Plug 840.72 Pipe Collar Page 23 Precest Manhole with Masonry Base – 300mm thru 1050mm Pipe 140 A Manhole Frame and Cover 244 Manhole Frame and Cover 250 Manhole Frame Styl. 250 Precince Steps Ab. 1.5 process of principle or Brick of principle or Brick of principle or Brick of process of 26.048 of principle or 18.04.048 of principle or 18.04.048 of principle or 18.048 of pr remore but State Value of the state of the s 840.31 Concrete Junction Box – 300mm thru 1650mm Pipe 840.32 Brick Junction Box – 300mm thru 1650mm Pipe 838.75 Notes for Reinforced Brick Endwalls – Std. Dwg.s 838.51 htm 838.70
838.80 Precast Endwalls – 300mm thru 1800mm Pipe 90° Skew
840.00 Concrete Basin – 300mm thru 1350mm Pipe
840.03 Frame, Grates and Hood – for Use an Standard Catch Basin
840.03 Frame, Grates and Hood – for Use an Standard Catch Basin
840.03 Frame, Carch Basin with Single and Multiple Pipes – 300mm thru 1350mm Pipe
840.04 Concrete Catch Basin with Single and Multiple Pipes – 300mm thru 1200mm Pipe
840.05 Frame States and Hood – for Use an Standard Catch Basin
840.17 Concrete Drop Inlet - 300mm thru 750mm Pipe
840.18 Grates Basin with Single and Multiple Pipes – 300mm thru 1800mm Pipe
840.17 Concrete Median Drop Inlet Type "V – 300mm thru 900mm Pipe
840.25 Brick Median Drop Inlet Type "Y – 300mm thru 900mm Pipe

John Precast Concrete Sanitary Sewer Manhole DIVISION 15 – UTILITIES

DIVISION 15 – UTILITIES

125.20 Frecast Sonitory Sewer Manholes – 1.2m Diameter Outside Drop

125.20 Frecast Sonitory Sewer Drop Manhole – 1.2m Diameter Outside Drop

125.20 Frecast Sonitory Sewer Drop Manhole – 1.2m Diameter

125.2.03 Frecast Concrete Sonitory Sewer Manhole

125.2.04 Frecast Concrete Sonitory Sewer Manhole

125.2.05 Frecast Concrete Sonitory Sewer Manhole

125.3.05 Frecast Concrete Sonitory Sewer Manhole gnithgid asoqrebar 10.5141 sexed notionut lastrice Boxes 1409.01 Electrical Duct stiuorio Teeder Circuits Mos. 07 Light Control System No.001 Light Standard Luminaires

AND NO.01 Electric Service Pole and Lateral

AND NO.01 Electric Service Pole and Lateral noitabruo | brabrate | 10.301

HYDRAULICS ENGINEER

12-20-22 Hocemen or Collect workers
12-20-22 Hocemen or Collect workers
12-20-22 Hoskible Delineator Epacing
12-20-22 Hoskible Delineator Interchanges
12-20-20 Hoskible Delineator Interchanges
12-20 1264.02 Placement of Object Markers 1262.01 Guardrail End Delineation sasyon Inamentale Raised Pavement Markers 10.53.01 Showplowple Raised Broth Guordang 10.1821 Specing The Part of Part

1250.01 Povement Marker Spacing 1251.01 Raised Pavement Markers – Permonent and Temporary 1251.01 Raised Pavement Markers 1205,11 Pavement Markings – Railroad Crossings 1205,12 Pavement Markings – Bridges 1205.10 Pavement Markings - School Areas M brow bron slodmy2 - serich Markman transmers 80.30Sr shrolst betried - serich Markman 400.30Sr special booth 2 - serich Markman or 2005 1205.05 Povement Morlángs - Tinu Lane Drops 1205.07 Povement Morlángs - Plato Lane Drops 1205.07 Povement Morlángs - Padestrian Crosswolks 1908.00 Povement Morlángs - Padestrian Properties and Morlángs 20.50ST personal Markings - Interchanges 20.50ST
20.50 1205.07 Pavement Markings – Line Types and Offsets Roadways 72.05.07 Pavement Markings – Divided and Undivided Roadways

1264.01 Object Markers

1160.01 Temporary Crash Cushion – Reflective End Treatment
1165.01 Truck Mounted Impact Artenuator – Delineation
1170.01 Portable Concrete Barrier (Beg. October 2002 Let Use Detail in Lieu of Standard) aneggoli 10.0211 1145.01 Barricades - Type I, II, III and Permanent 135.01 Cones

1101.05 Warming Signs for Blasting Areas 1101.07 Rolling Road Block Operation (Temporary Road Closure) 1101.17 Iraffic Control Design Tolles

DIAISION 6 - SIGNING

noitabnuoi bna - latsabei naintsabei 10.557 1742.01 Metal Pole Foundations selog loteM 10.01 1733.01 Delineator Markers - Marker Installation NS.01 Inductive Detective Loops 173.01 Teiber-Optic Cable – Spare Cable Storag 1730.02 Fiber-Optic Cable – Conduit Installation 1733.01 Delineator Markers – Marker Lestallation

1752.01 Controllers and Cabinets - Power, Ground and Auxiliary

1751.01 Controllers and Cabinets - Electrical Service Grounding 1751.02 Controllers and Cabinets - Electrical Service Details

16 - EROSION CONTROL AND ROADSIDE DEVELOPMENT

DATE: 7-09-03

RELEASE FOR CONSTRUCTION

D1+97-8 PROJECT REFERENCE NO. SHEET NO.

SORAGWATS

ENAL PLANS

RALEIGH

DEPARTMENT OF TRANSPORTATION

STATE OF WORTH CAROLINA

METRICE!

DIAISION 13 - PAVEMENT MARKINGS, MARKERS AND DELINEATION 721.01 Guy Assemblies 2) Solo Junction Boxes 2) Solo Wood Poles Position of the control of the contr Timbo O Stationary Work Zone Signs – Mounting Height & Lateral Clearance Info.03 England Work Zone Signs – Mounting Height & Lateral Clearance Info.02 Percent Forms Class Special Detail in Lieu of Standard)
1730.01 Pruss (Uses Special Detail in Lieu of Standard)
1730.07 Druns (Uses Special Detail in Lieu of Standard) 1636.01 Rock Silt Screen
DIVISION 17 - Signate and Traffic Management Systems
and Inable John Systems
April Inable Version Heads 1939'0) Bock Sill Scheen 1939'0) Bock Sill Sediment I cab J. Abe . B. 1939'03 Lembounk fock Sediment I cab J. Abe . B. 1939'03 Lembounk fock Sediment Dom J. Abe . B. 1939'03 Lembounk fock Sill Cleck I Abe . B. 1939'03 Lembounk fock Sill Cleck I Abe . B. 1632.03 Rock Inlet Sediment Trap Type 'C' 1633.01 Temporary Rock Silt Check Type 'A' 1630.03 Temporary Silt Ditch 1630.04 Stilling Basin For Pumped Effluent 1630.02 Silt Basin Type '8' 8' 1630.02 Silt Basin Type '8' 1622.01 Guide for Temporary Berms and Slope Drains 1605.01 Temperary Silt Fence 1605.01 Special Sediment Control Fence

12547c. tsh

Joenment Control Number 1

DATE: _

: amanau

нескев в∴∹

- :YB NWAR

1101.04 Temporary Shoulder Closures Sessess A shick Zone Vehicle Accesses 1101.02 Temporary Lane Closures 1101.03 Temporary Road Closures 1101.01 Work Zone Advance Warning Signs VOJ.:VO Wood Jign Forp Popular Sign Support and Anchorage 903.

901.20 VHB Tope Construction - for Type 'B' Signs
901.10 Type 'K' Signs - Welded Stud Construction
901.10 Type 'K' Signs - Welded Stud Construction
by reference hereby are considered a part of these plans: The following Roadway Standards appear in "Roadway Standard Drawings" Highway Design Branch— A.C. Department of Transportation—Roleigh, N.C. Dated January 15, 2002 are applicable to this project

REV.06-17-02

| | Filename: | 7 | | |
|--|--|----------------------------|---|---|
| | | | CONVENTIONAL SLAM | |
| | Document Contro | Number : | <u> </u> | |
| | CHECKED BA: | :3TAQ;3TAQ;3TAQ;3TAQ; | STATE OF NORTH CAROI DEPARTMENT OF TRAN RALEIGH | ITATAO92NAAT |
| | | Standard Gauge | | +++ |
| Existing Endangered Plant Boundaries | —— 843 —— | Vineyard RAILR | | 0 |
| Existing Endangered Animal Boundaries | | | \$ \$\$\$\$\$ | ଷ୍ଟ ଷ୍ଟ |
| Proposed Wetland Boundaries | МГВ | Woods Line | | سنند |
| Existing Wetland Boundaries | MFB | | | |
| Fence Line | | Single Shrub | 9 | |
| Parcel Number | (9) - | Single Tree | m | |
| Property Number | (SZI) | NECELI | | |
| requirement Monument | M23 · | esuoH thgiJ | \$ | |
| Ргорену Соглег | | Trail, Footpath | | |
| Exist. Iron Pin | 45 ⊙ | Footbridge | | |
| Property Line Symbol | <u> </u> | TievluD | | > |
| Property Line | | Ferry | | |
| Reservation Line | | | \(\ \ \ \ \ \ \ \ \ \ \ \ \ \ \ \ \ \ |)二二 |
| Township Line City Line | | egbing | | |
| County Line | | Paved Walk | | |
| State Line | | Guard Post | d3 O | |
| BOUNDARIES & PROPER | | Right of Way Symbol | | |
| End of Information | | The spinor book in aginate | | |
| Abanda According to UN Record | | Change in Road Surface | | |
| U/G Test Hole (S.U.E.*) | • | , , , , , | | |
| Exist. Water Meter | 0 | ADOGO Zingus | | |
| Designated Fiber Optics Cable (5.U.E.*) | 0101 | loo9 gnimmiw2 | V/////// | |
| Recorded Fiber Optics Cable | | Small Mine | * | |
| Designated Television Cable (5.U.E.*) | | | ^ | |
| Unknown Utility (S.U.E.*) Recorded Television Cable | | ngiZ | 8 | |
| Designated UC Telephone Conduit (S.U.E.*) | | Dam | | *************************************** |
| Recorded UV Telephone Conduity (* 1717) | | Cemetery | <u></u> | |
| Designated Telephone Cable (S.U.E.*) | | Park | | _ |
| Recorded Telephone Cable | | School | ٠٠٠٠٠٠٠٠٠ | |
| Designated Power Line (5.U.E.*) | | Church | Ŧ | |
| Recorded Power Line | | Gas Pump Yent or U/G Tank | φο Σ | |
| Storm Sewer | s | eto-2 | ^ ^ | |
| Designated Gas Line (S.U.E.*) | | Area Outline | F.1 | / |
| Recorded Gas Line | | Foundations | | - |
| Designated Sanitary Sewer Force Main(S.U.E.* | ·*.3 | sgnibliu8 | | L |
| Sanitary Sewer Torce Main Recorded Sanitary Sewer Force Main | | | OTHER CULTURE | |
| Designated Water Line (*J.U.2.*) | | MCC | | |
| Recorded Water Line | - I | | | |
| T-: TataM Paksone | Section 1984 | | DATE: 7 | TE: 7-17-03 |
| | A contract of | | | |
| | The state of the s | | RELEASE FOR CO | TOUSTRUCT |
| | oran } | 111 111 | N 하는 등 하는 경기 (1985) 1985 1985 1985 1985 1985 1985 1985 1985 | |
| | | IN E SME | ** | |

DIAISION OF HIGHWAYS STATE OF NORTH CAROLINA

CONVENTIONAL SYMBOLS

| si-si- | Utility Power Line Connects to Traffic Signal Lines Cut Into the Pavement |
|-------------|---|
| \otimes | Television or Radio Tower |
| ⅎ | Fiber Optic Splice Box |
| 5 | Traffic Signal Innction Box |
| Ø | Water Tank With Legs |
| Ô | Tank; Water, Gas, Oil |
| © © | Storm Sewer Manhole |
| • | Sanitary Sewer Manhole |
| Z | Power Transformer |
| ① | Telephone Manhole |
| • | Gas Meter |
| | Gas Valve |
| | aspla Hiw eloq |
| \boxtimes | Power Line Tower |
| • | H-Frame Pole |
| ¤ | Light Pole |
| (A) | Water Manhole |
| • | Telephone Booth |
| a | Power Manhole |
| \oplus | Sewer Clean Out |
| \otimes | Exist, Water Valve |
| Q | AziQ etilleto2 |
| \$ | Hydrant |
| 0 | Cable TV Pedestal |
| I | Telephone Pedestal |
| ~ | Prop. Joint Use Pole |
| + | Exist. 10int Use Pole |
| -0- | Prop. Telephone Pole |
| • | Exist. Telephone Pole |
| P | Prop. Power Pole |
| • | Exist. Power Pole |
| • | Exist. Pole |
| | CLITILES |
| | Paved Ditch Gutter |
| GB | Drainage Boxes |
| > | ≺ · · · · · · · · · · · · · · · · · · · |
| | Pipe Culvert |

WINOK

*S.U.E = SUBSURFACE UTILITY ENGINEER

ROADS & RELATED ITEMS

Edge of Pavement

| Prop. States Cut Prop. Slope Stakes Cut Prop. Slope Stakes Fill Prop. Meachair Ramp Prop. Cut For Future Wheelchair Ramp Prop. Cut For Future Wheelchair Ramp Exist. Cable Guiderail Prop. Cable Guiderail Exist. 









| | | Prop. Slope States Cut |

ROADWAY DESIGN ENGINEER

| KEAISIONS | | | | |
|--------------------------|---------|-----|----|-----|
| | | | 9 | |
| | | | 9 | Ì |
| | | | 8 | ' |
| | | | 2 | l (|
| MENISED SEVE | E0-11-7 | ราก | L | l |
| RELEASE FOR CONSTRUCTION | ₹0-60-1 | DSP | 0 | Ì |
| DESCRIPTION OF REVISION | :3TAG | :48 | ON | |



CONC MM


CONC


and End Wall

SIKUCTURES

Bridge Wing Wall, Head Wall

RALPH WHITEHEAD ASSOCIATES, WC. CONSULTING ENGINEERS
P.O. BOX 35624 CHARILOTTE, N.C. 28235

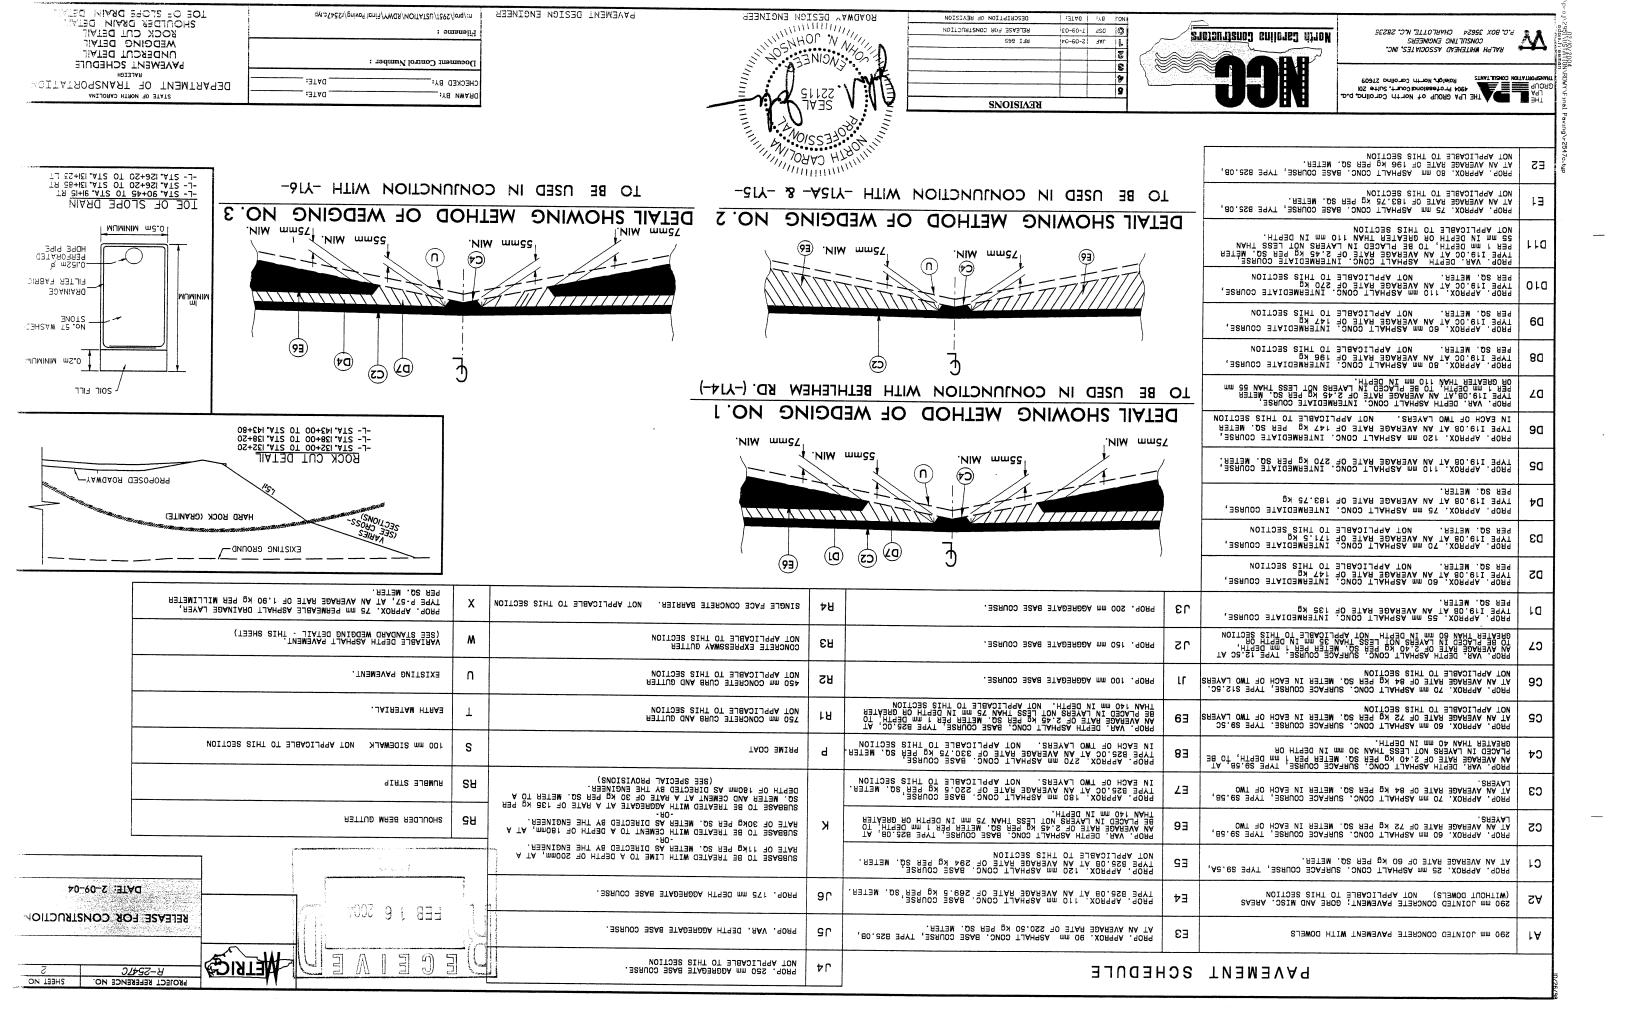

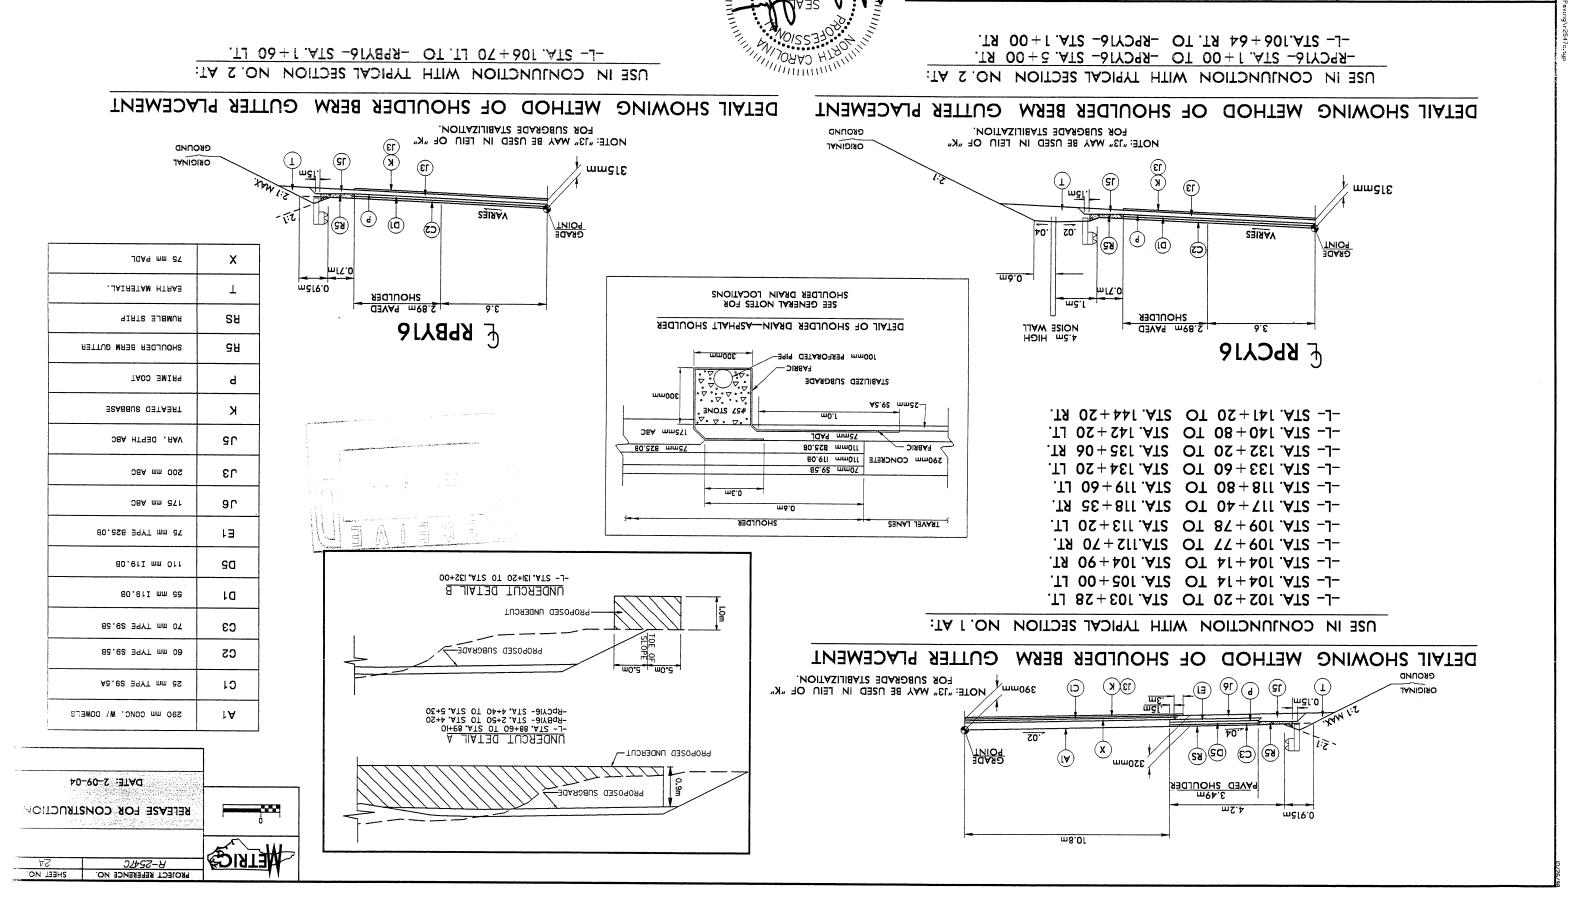

ROADWAY DESIGN ENGINEER

CNHOL W NOTH

DESCRIBLION OF MENTSION

RELEASE FOR CONSTRUCTION

EXTEND SHOULDER BERM GUTTER

BEI PER

KEAISIONS

:3TA0 | ::: 6 | LON

£0-60-1 ds0 (0)

J C1H 8-18-02

3 JAF 2-09-04

Morth Carollea Constructor

P.O. BOX 35624 CHARLOTTE, N.C. 28235

RALPH WHITEHEAD ASSOCIATES, INC.

THE LPA GROUP of North Carolina, p.,

PAVEMENT DESIGN ENCINEER

Egt. DTAG&1/pnivp9 lbnii7/YWQ8/MOITAT2U/f29S/jorg/:n

HECKED BAS

DRAWN BY:_

:3TAQ

DATE:


TYPICAL SECTIONS


FINAL PLANS


RALEIGH


DEPARTMENT OF TRANSPORTATIO


STATE OF NORTH CAROLINA

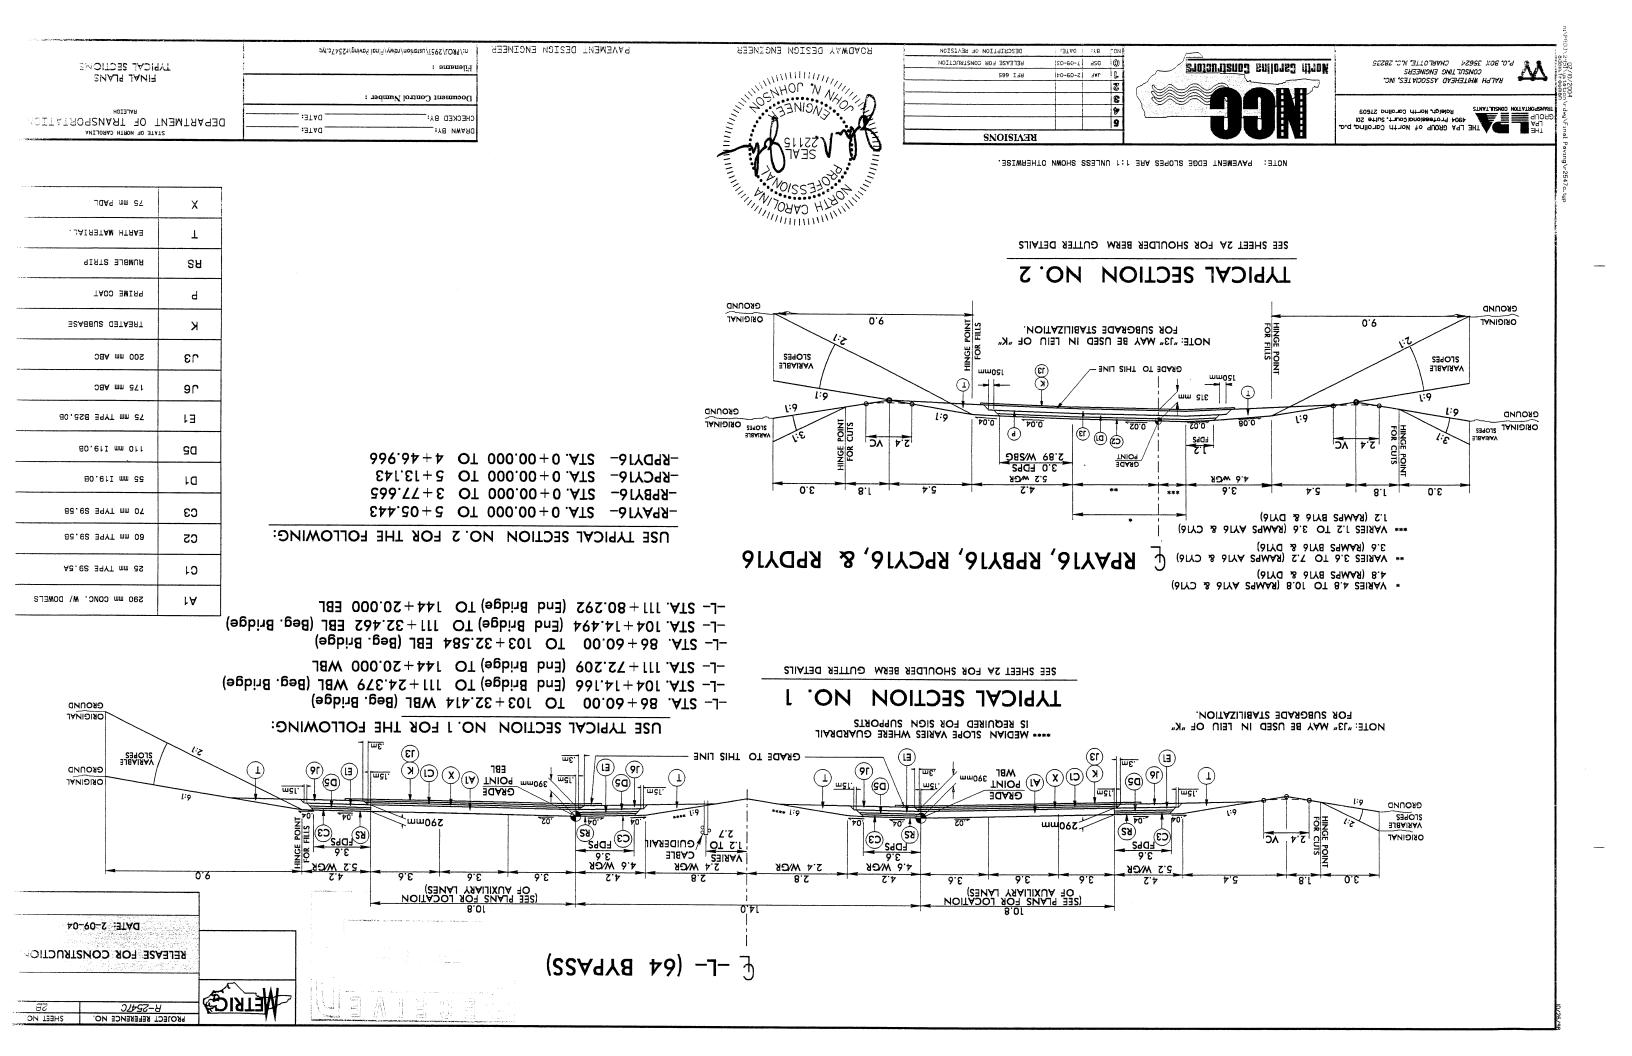


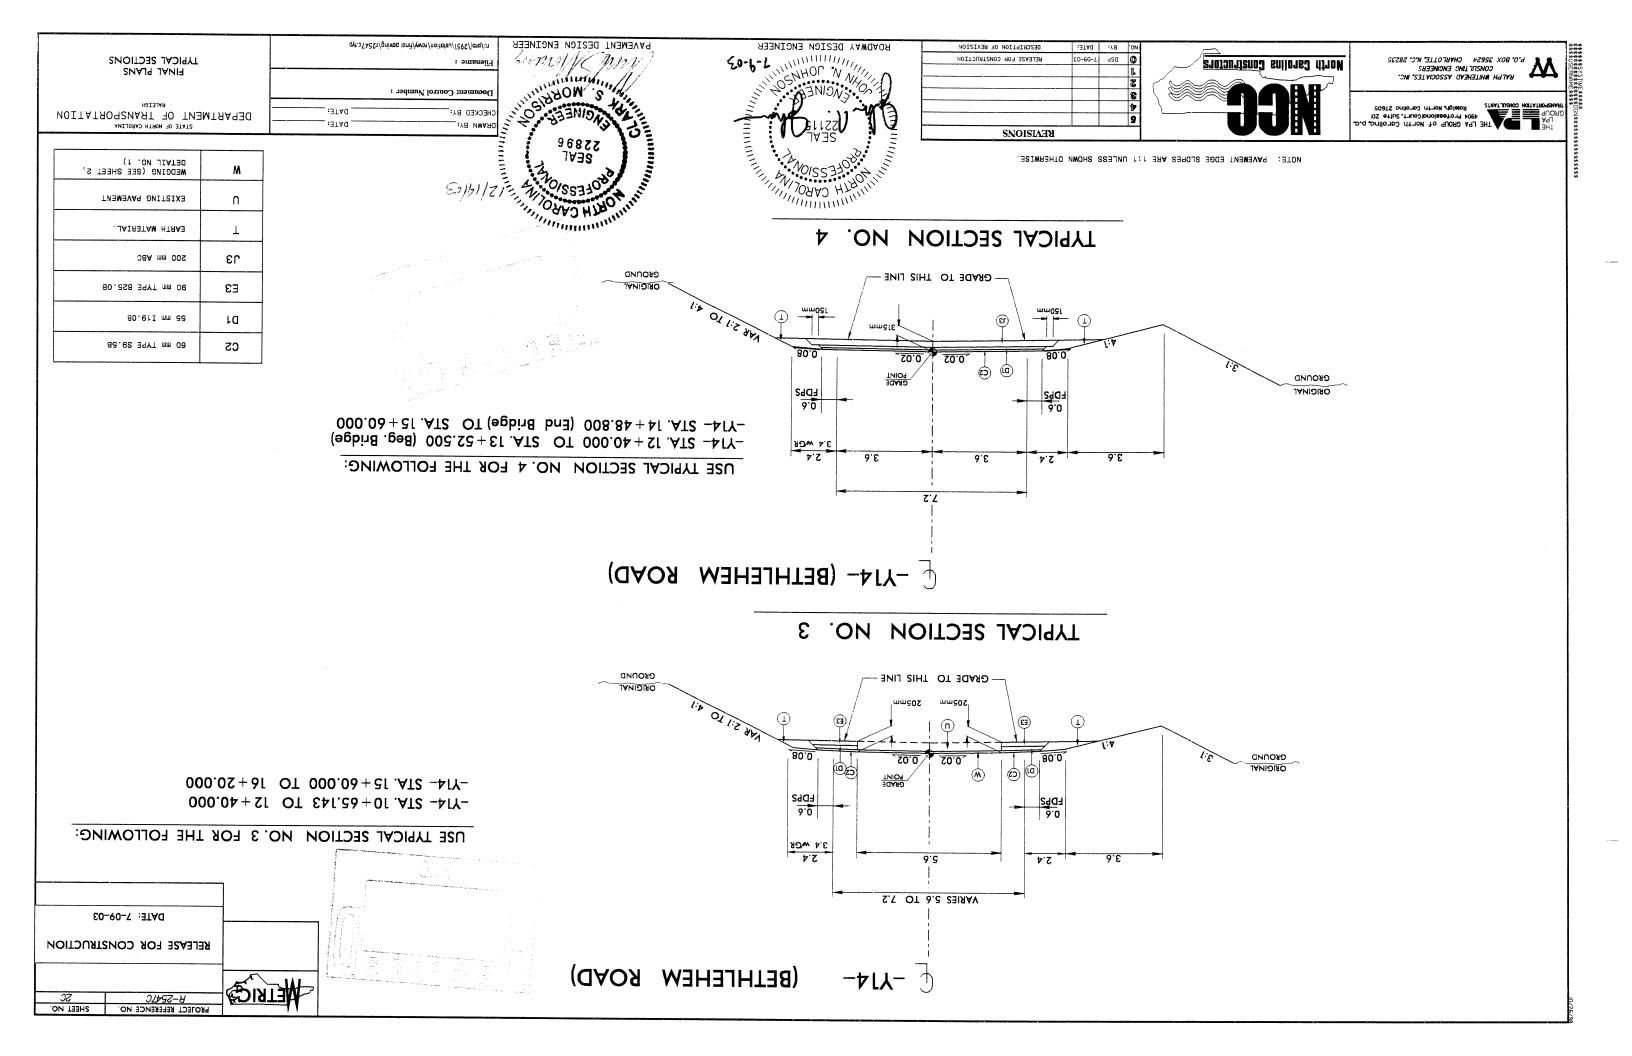

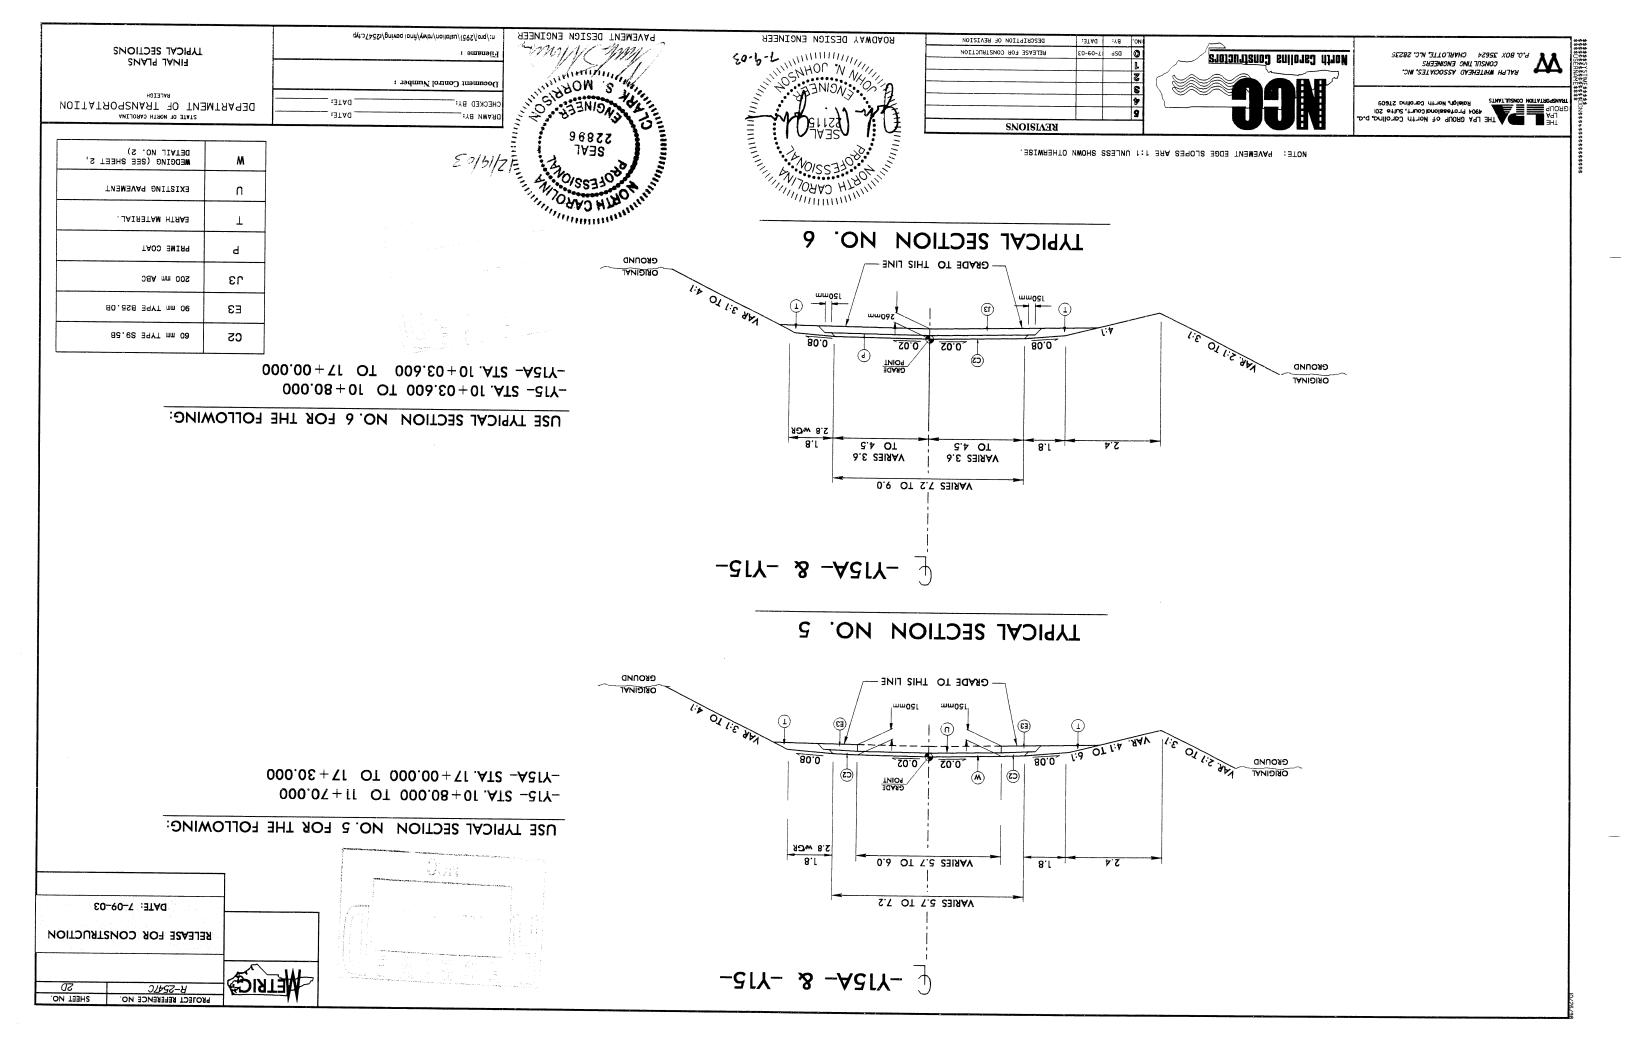

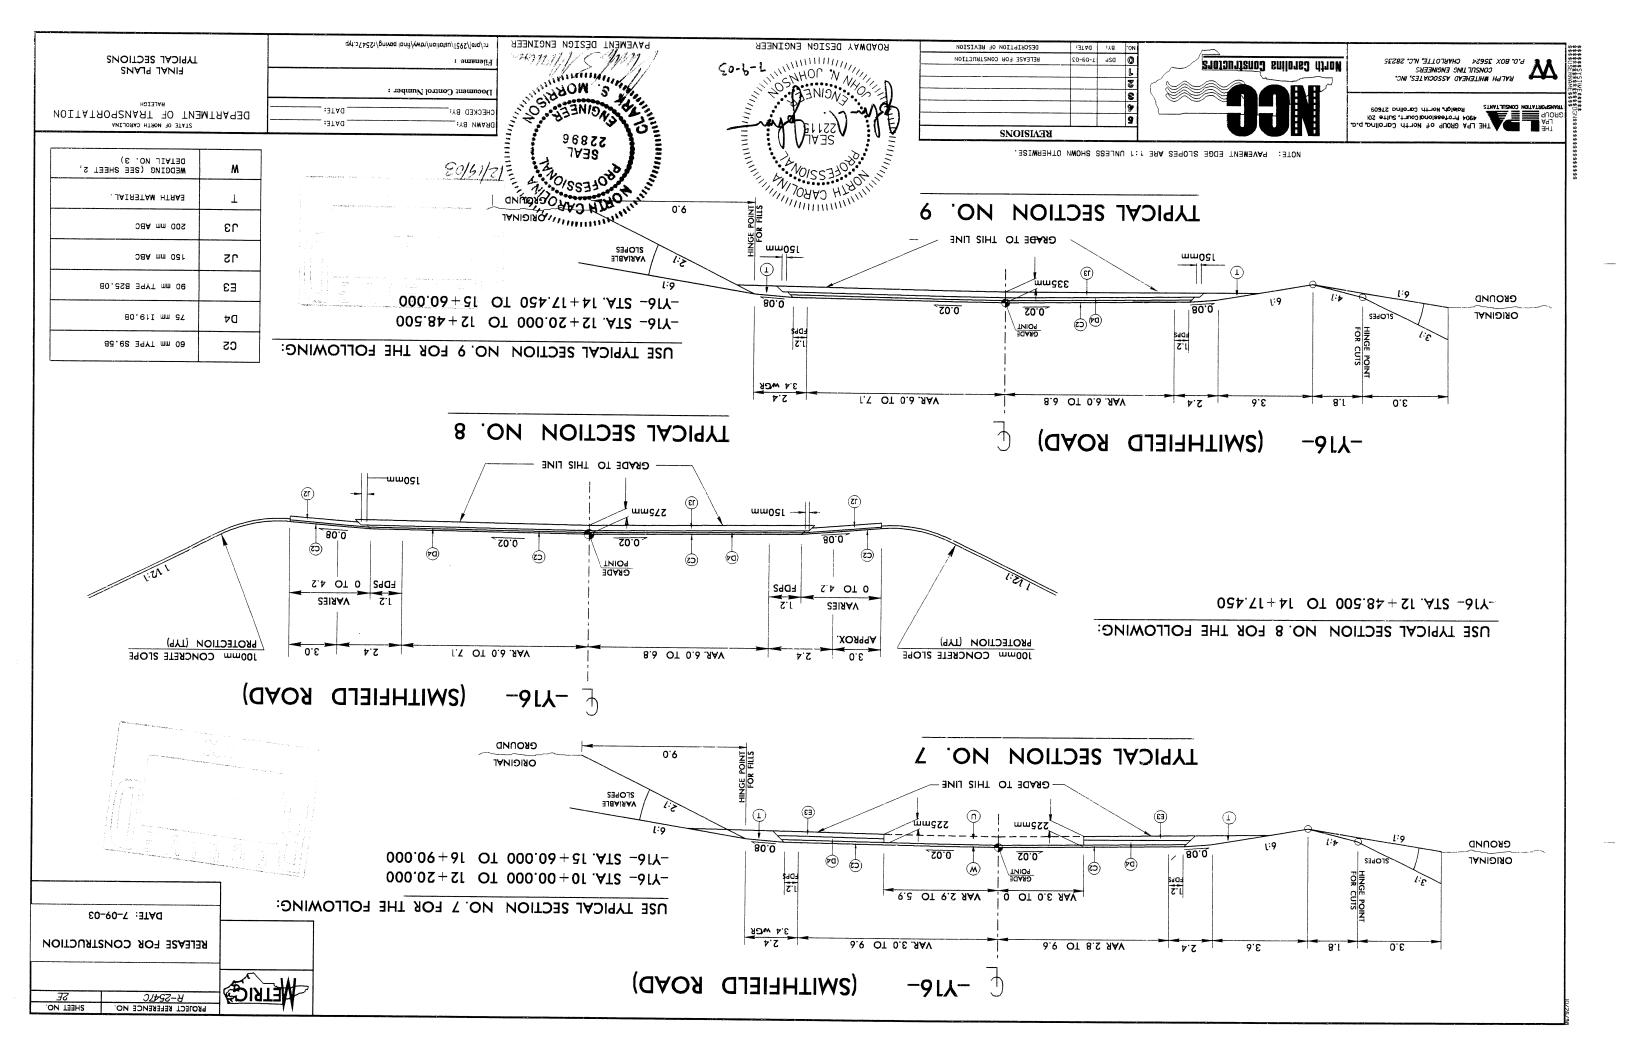

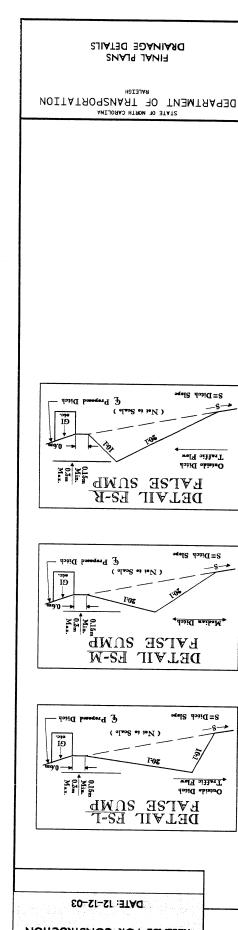

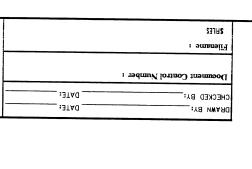

7 N.W.S. Elev. = 88.5

= 9.0

Min. D = 0.4i Min. D = 4.45 B = 1.51 B = 1.51

Fill Slepe

_Ebv.= 89.1

52

TR 09+98 - OF+98 ATE -1-

≖0.5

DELVIL

-L- STA. 98+20 - 98+50 RT

Reck Fill T. Elev. 79.200

Earth Fill

(9100S 03 30N)

PILL IN POND

Class 'B' Rip Ra


(POS 03 30N)

BOCK BILL

DELVIL 24


17 27+141 - 81+141 ATS -1-

T1 28+011 - 09+011 AT2 -1-

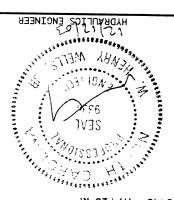

| HYDRAULICS ENGINEER |
|---------------------|
| 119+18 - 119+20 Ki |
| |



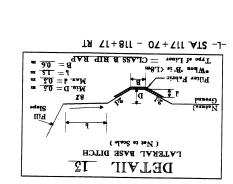


-L- STA. 132 + 20 - 132 + 32 RT


Type of Liner = CLASS TRIP RAP


(Net to Scope)


Special Cut base ditch


DETAIL 12

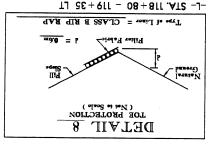

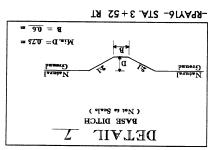

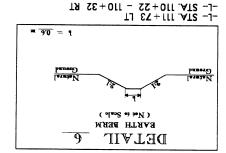

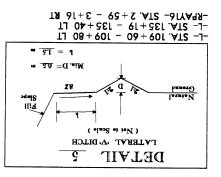

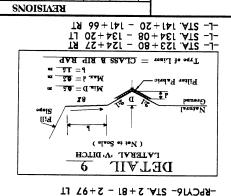

€0-60-7 q≥0

S C1H IS-15-03


9


DESCRIPTION OF REVISION

RELEASE FOR CONSTRUCTION

REVISED DET. 23

T CTH 10-23-03 REVISED STA. LIMITS FOR DETAILS 13 AND 14

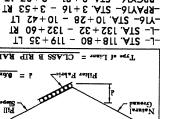

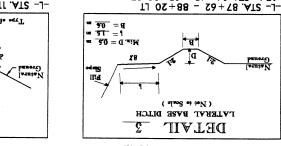

Merth Carelina Constructors

Win D= 0.6 m

-RPDY16- STA. 4+56 - 4+80 RT TR 20+4 - 88+E .ATZ -61789A-TA 1-6 - 6++ ATS -617A9A-11 24+61 - 04+21 ATS -61Y-TA 05+41 - 78+51 ATZ -214-TJ 8E+ PL - ZB+ EL "YIS -9LA-TJ 00+ZI - 08+II "YIS -9IX-TA 00+11 - 08+01 ATS -A2TY-TA +0+ 61 - 05+ 21 .ATS -+1Y-TA 07+11 - 72+11 AT2 -41Y-11 09+0pl - 02+0pl "YIS -1--L- STA. 138+40 - 140+00 RT -L- STA. 93+60 - 93+74 RT -L- STA. 89+35 - 90+50 LT TJ 08+88 - 02+88 .ATZ -J-

P.O. BOX 35624 CHARLOTTE, N.C. 28235

RALPH WHITEHEAD ASSOCIATES, INC.

Rainigh, North Carolina 21609 THE LPA GROUP of North Carolina p.c

-RPCY16- STA. 2+37 RT 11 ET + 141 .ATZ -1-

(oteos os son)

·A· DLLCH


DELVIL

-RPAY16- STA. 2+59 - 3+59 LT


TJ 89+2 - 27+1 ATZ -21899-


-Y15A- STA, 11 + 00 - 11 + 40 RT


TA 02+31 - 34+45 - 15+20 RT

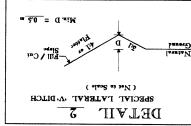


11 00+81 ATS -AEM-TJ SY+E ATZ -SIYA9A-TJ ET + EQ .ATZ -J-11 02 + 78 ATZ -1-

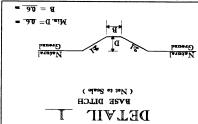


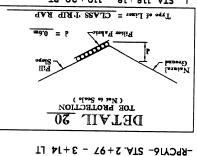


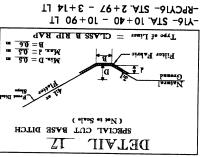



-L- STA. 141+66 - 142+18 RT

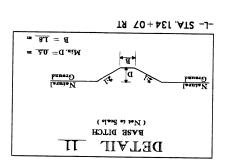

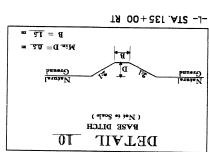

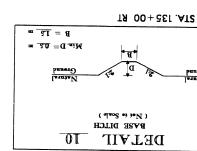

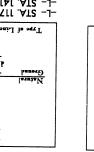


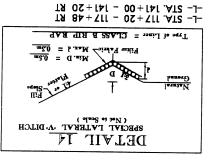

(olao2 e3 30N)


TYLEBYT BYSE DILCH

DETAIL IS

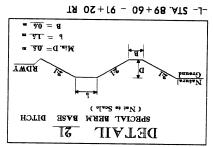

LATERAL BASE DITCH

DELVIL

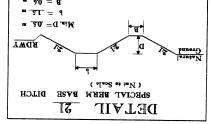


m <u>20</u> = 0 aiM m <u>21</u> = 4 m <u>6.0</u> = 8


DKYINYCE DELVITS

DIVISION OF HIGHWAYS STATE OF NORTH CAROLINA

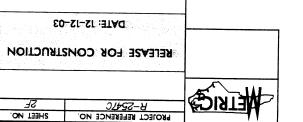

2= Dice P 21030

Traffic Flow


S=Dicch Slepe


S= Dice Spic

Traffic Flow


DELVIE SHEEL NYLNEYF ZIEEVW DEZIGN

LT = T = 09 + I2I NOILYLS

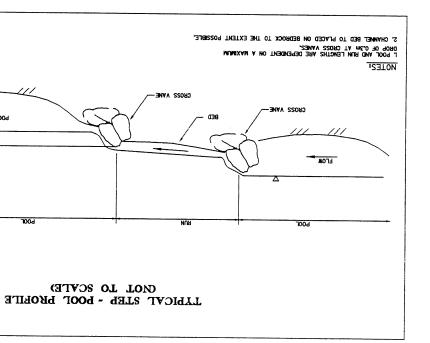


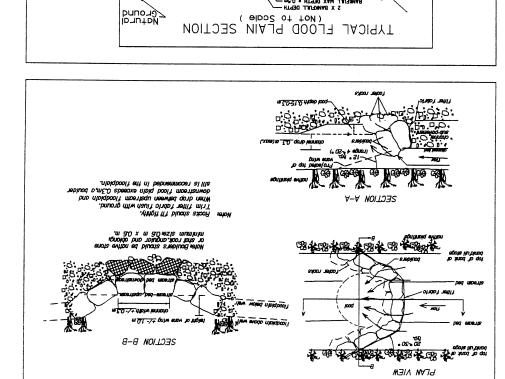

CHOSS VANE ROCK WEIR DETAIL

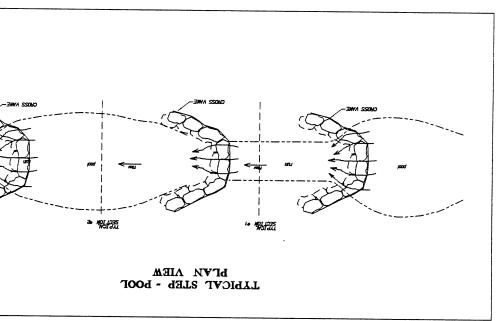

CNOT TO SCALE)

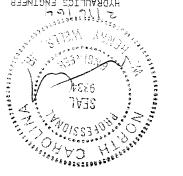


| ен | BALEI |
|----------------|-----------------|
| RANSPORTATION. | DEPARTMENT OF T |
| H CAROLINA | STATE OF WORT |

DATE: 02-09-04

RELEASE FOR CONSTRUCTIO

|---|---|
| SNALP LANF | Воситепт Сопич Литрет : |
| DEPARTMENT OF TRANSPO RALEIGH RALEIGH | CHECKED BY: DATE: |

| CNICITATIVE | | | |
|------------------------------|----------|------|-----|
| | | | 9 |
| · | | | P |
| | | | 8 |
| REVISED DETAILS | ⊅0-60-ZD | ∃AL | 2 |
| REVISED DETAILS | 8-58-02 | нтэ | J. |
| RELEASE FOR CONSTRUCTION | 20-60-7 | dS0 | Ø |
| DESCRIBLION OF REVISION | 1 DATE: | : 78 | -ON |

CHANNEL DETAIL
PROPOSED TYPICAL SECTION #2

| DESCRIBLION OF REVISION | :3TAG I | :18 | -ON F | |
|--------------------------|-------------|-----|-------|-------------------------------|
| RELEASE FOR CONSTRUCTION | 120-60-1 | dS0 | 0 | PIGIGE CRUCK BUSINESS |
| REVISED DETAILS | 8-58-02 | CTH | L. | <u>erojjurieno</u> 3 saliots: |
| REVISED DETAILS | Þ0-60-ZD | ∃AL | 3 | |
| | | | 8 | |
| | | | 9 | |
| | | | 9 | |
| 01101011 | | | | TO THE |


SEE CHANNEL DETAILS

PROPOSED TYPICAL SECTION #1


CHANNEL DETAIL

| JON | OLLE" N°C" SBSBE CINEEUS |
|-----|-----------------------------|
| 77 | SOCIATES, INC. |
| ,- | |


THE LPA GROUP OF NORTH COROIING, p.g.
4904 Professional Court, Sulfe 203
fration consultants Reside, North Coroling 21609

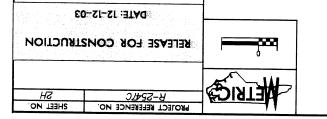



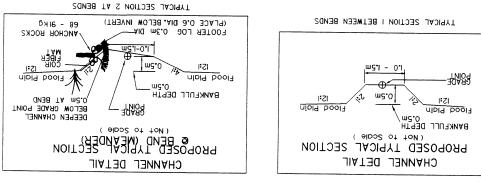

SEE CHANNEL DETAILS Fill Slobe Flood Pldin Ground (Albos of toN) NOTULO TYPICAL FLOOD PLAIN SECTION

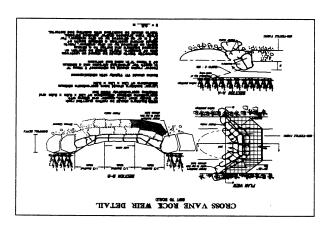

NUMBER OF LOW STAGE CHECK DAMS TO BE DETERMINED ON SITE NUMBER OF ROOTWADS INSTALLED TO BE DETERMINED ON SITE

ROOTWADS TO BE SPACED 4x DIAMETER OF ROOT BASE

FOOTER LOG ANCHOR ROCK TO BE PLACED ON THE DOWNSTREAM END OF EACH FOOTER LOG SO THAT IT IS LEANING ACAINST THE LOG ON THE SIDE AWAY FROM THE CHANNEL.

WHEN BECKFILLING OVER AND RROUND FOOTER LOGS, ROOTWAD LOGS AND ANCHOR ROCKS FIRMLY SECURE ALL COMPONENTS INCLUDING LOINTS, CONNECTIONS AND GAPS.

PLANTINGS SHOULD BE PLACED ABOVE BANKFULL DEPTH

CHYNNET BFYN NIEM

FIBER TAM

FOOTER LOG

(0.3m - 0.45m DIA.) (3.0m - 3.6m LENGTH)

ANCHOR ROCKS

| \$FILE\$ | AULICS ENGINEER |
|-----------------------|--------------------|
| Filename : | (3/1/2) |
| Document Control Numb | WETTS . REST |
| CHECKED BJ: | |
| | SEAL 5 48 9334 , S |
| | T. WOISSION |

| | KEAISIONS | | | |
|-------------|--------------------------|----------|-----|---|
| | | | | ! |
| | | | | 1 |
| | | | | 1 |
| | REVISED DETAILS | 15-15-02 | нтэ | 1 |
| į | REVISED DETAILS | 8-58-02 | нтэ | T |
| | RELEASE FOR CONSTRUCTION | 7-09-03 | dS0 | 1 |
| ROADWAY DES | DESCRIPTION OF REVISION | :3TAG | :Y8 | Ŧ |



P.O. BOX 35624 CHARLOTTE, N.C. 28235 RALPH WHITEHEAD ASSOCIATES, INC.

DEPARTMENT OF TRANSPORTATION

CHANNEL RELOCATION DETAILS

FINAL PLANS

STATE OF MORTH CAROLINA

DATE:

DATE:

ICH ENCINEER

P.O. BOX 35624 CHARLOTTE, N.C. 28235 RALPH WHITEHEAD ASSOCIATES, INC.

THE LPA GROUP of North Caroling, p.o. 43904 Protessional Court, Suite 201 Protessional Court, Suite 201 Protessional Court Carolina 21609

North Carolina Constructors

| DESCRIPTION OF REVISION | :3TAG | ÷kB | 1.01 |
|-------------------------------------|----------|-----|------|
| RELEASE FOR CONSTRUCTION | 7-09-03 | 450 | 0 |
| REVISED LEVEL SPREADER DETAIL | 8-18-03 | ₩LO | 1 |
| REVISED PREFORMED SCOUR HOLE DETAIL | 15-15-02 | ato | Z |
| | | | 8 |
| | | | * |
| | | | 9 |

| | KEVISIONS | | | |
|---|-------------------------------------|----------|------|----|
| L | | | | 9 |
| L | | | | 9 |
| L | | | | 8 |
| L | REVISED PREFORMED SCOUR HOLE DETAIL | 12-12-03 | BITO | 2 |
| L | REVISED LEVEL SPREADER DETAIL | 8-18-03 | #10 | 8 |
| | RELEASE FOR CONSTRUCTION | 20-60-7 | 4SQ | 0 |
| L | DESCRIPTION OF REVISION | :3TAO | ±Y.B | .0 |

| MONDANA DESIGN ENCINEER | DESCRIPTION OF REVISION |
|-------------------------|-------------------------------------|
| | RELEASE FOR CONSTRUCTION |
| | REVISED LEVEL SPREADER DETAIL |
| | SEATZED PREFORMED SCOUR HOLE DETAIL |
| | |
| | |
| | |
| | KEAISIONS |

| | \$HITE? | HADBAULICS ENGINEER |
|---------------------------------------|--------------------------|--|
| DETAILS | ніјелате : | 20/11/21 |
| SNAJ9 JANIF | | STATES AND AUG. |
| | Document Control Aumber: | |
| DEPARTMENT OF TRANSPORTATION RALEIGH | CHECKED BX: DATE: | 8 . 10 10 10 10 10 10 10 10 10 10 10 10 10 |
| DEPAPERATE OF TRANSPORTATION | DRAWN BY: DATE: | |
| | | 6334 |
| | | SEVI SEVI |
| | | 10100310H3. |
| | | |


DATE: 12-12-03


RELEASE FOR CONSTRUCTION


SHEET NO.


91422–8


PROJECT REFERENCE NO.

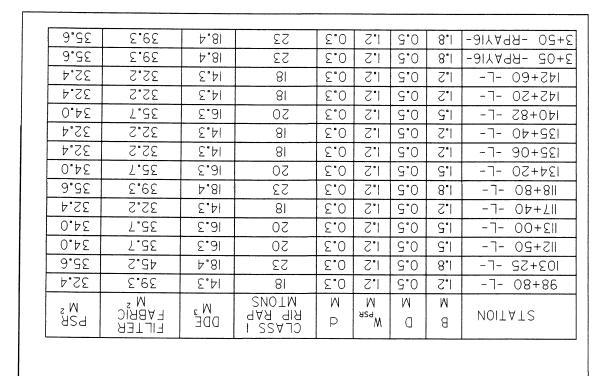


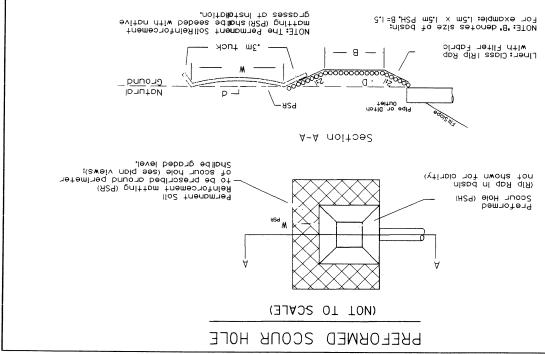

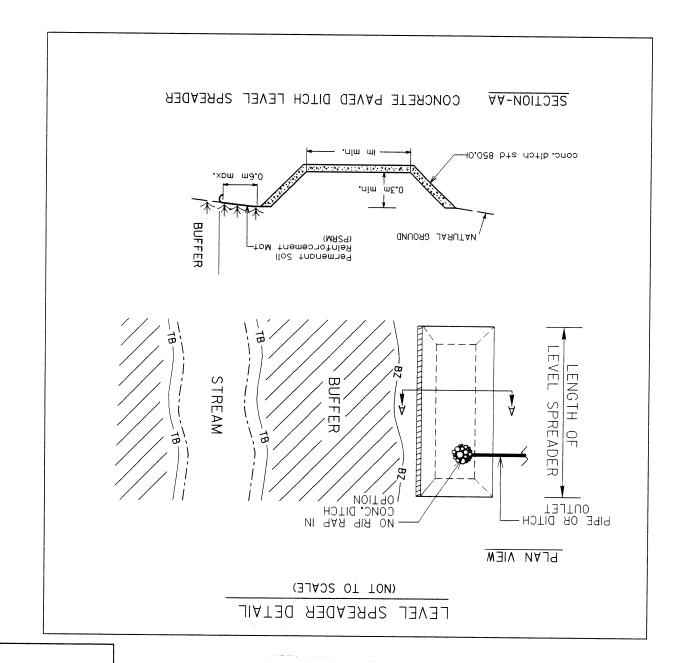

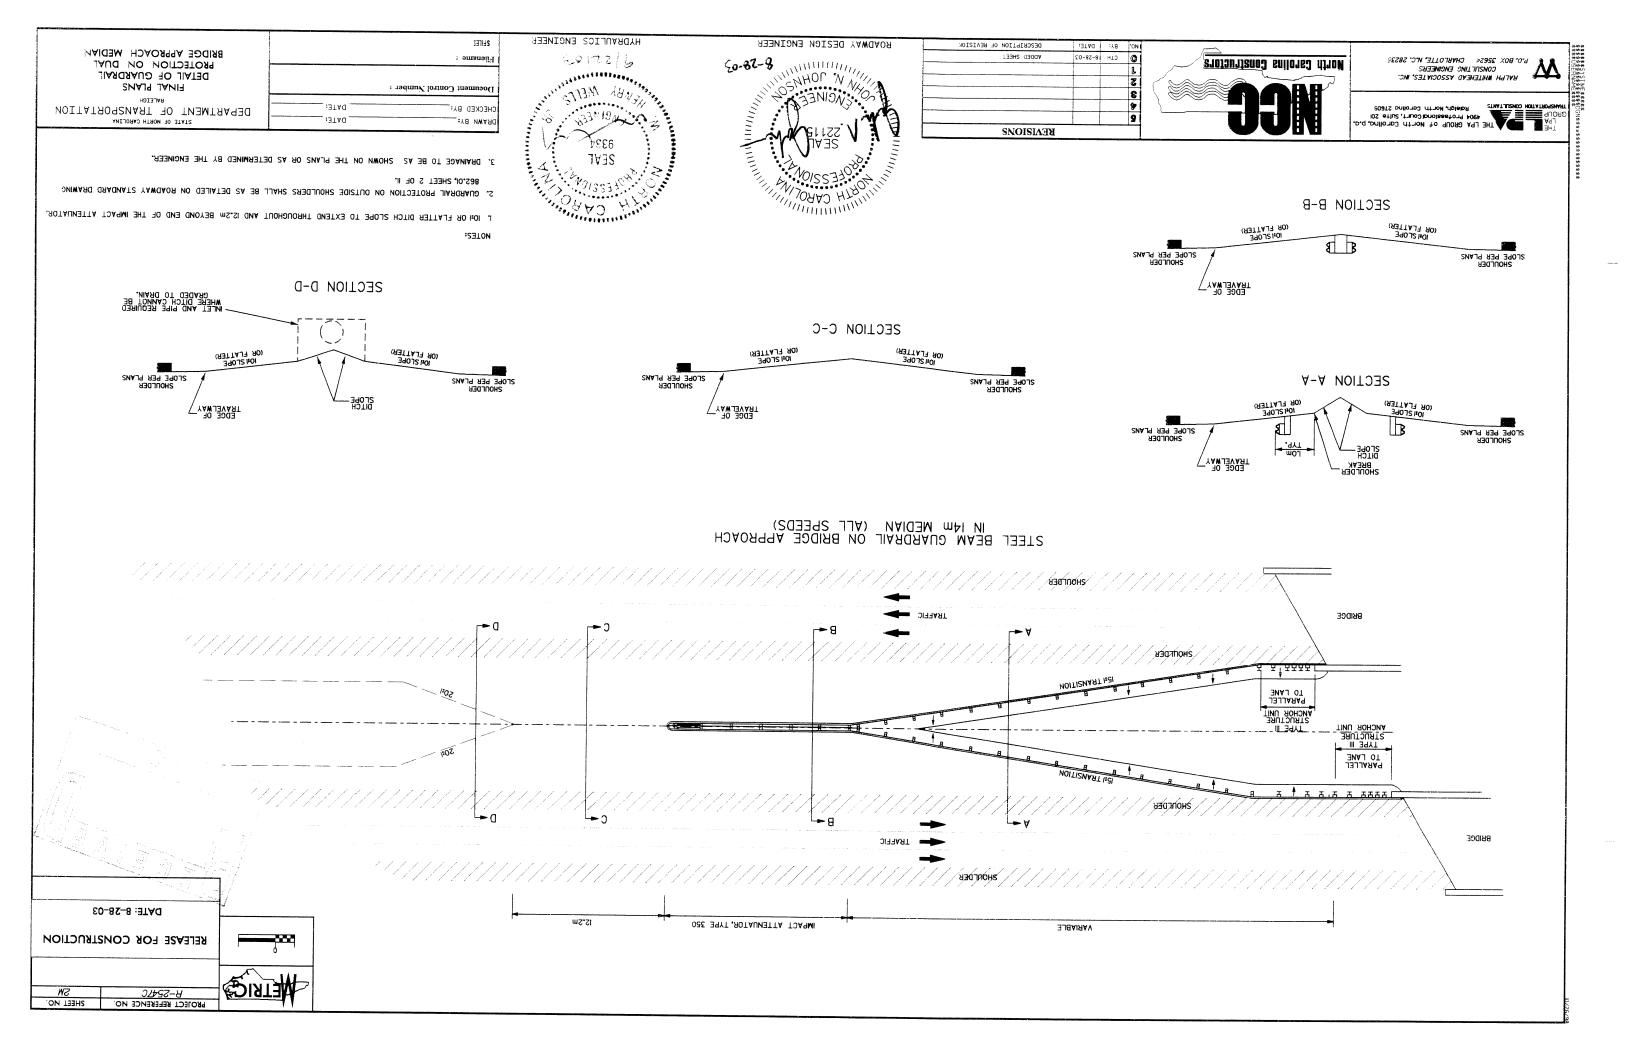

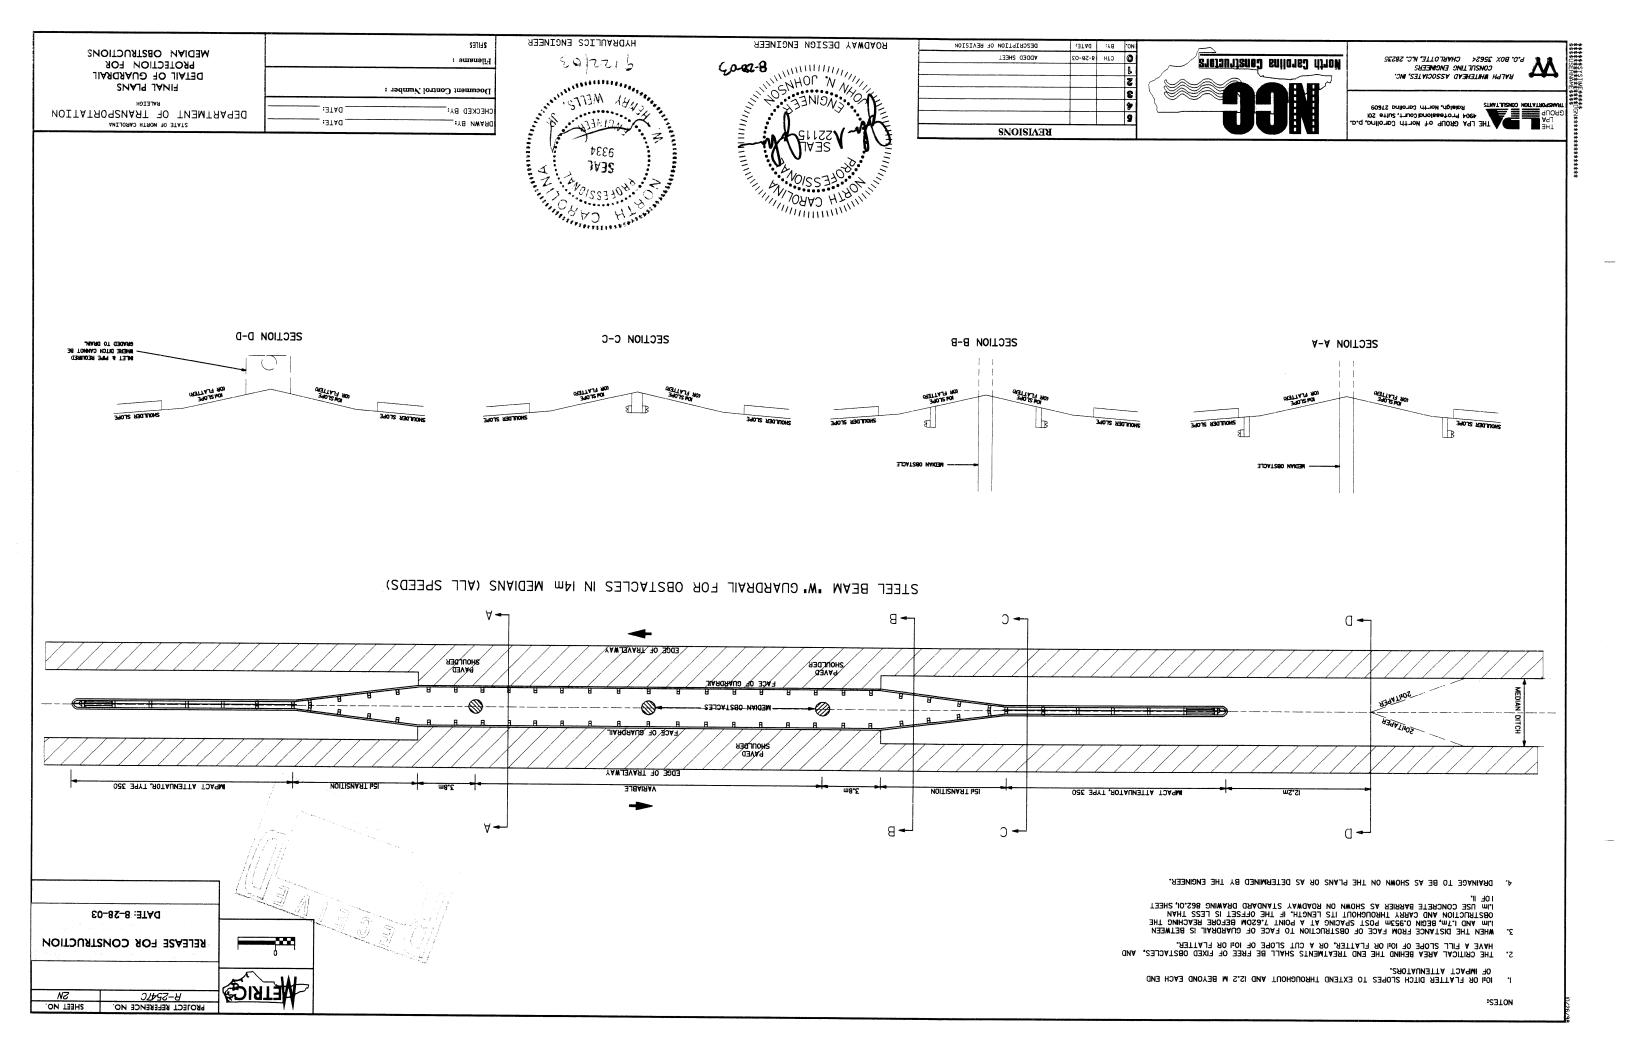

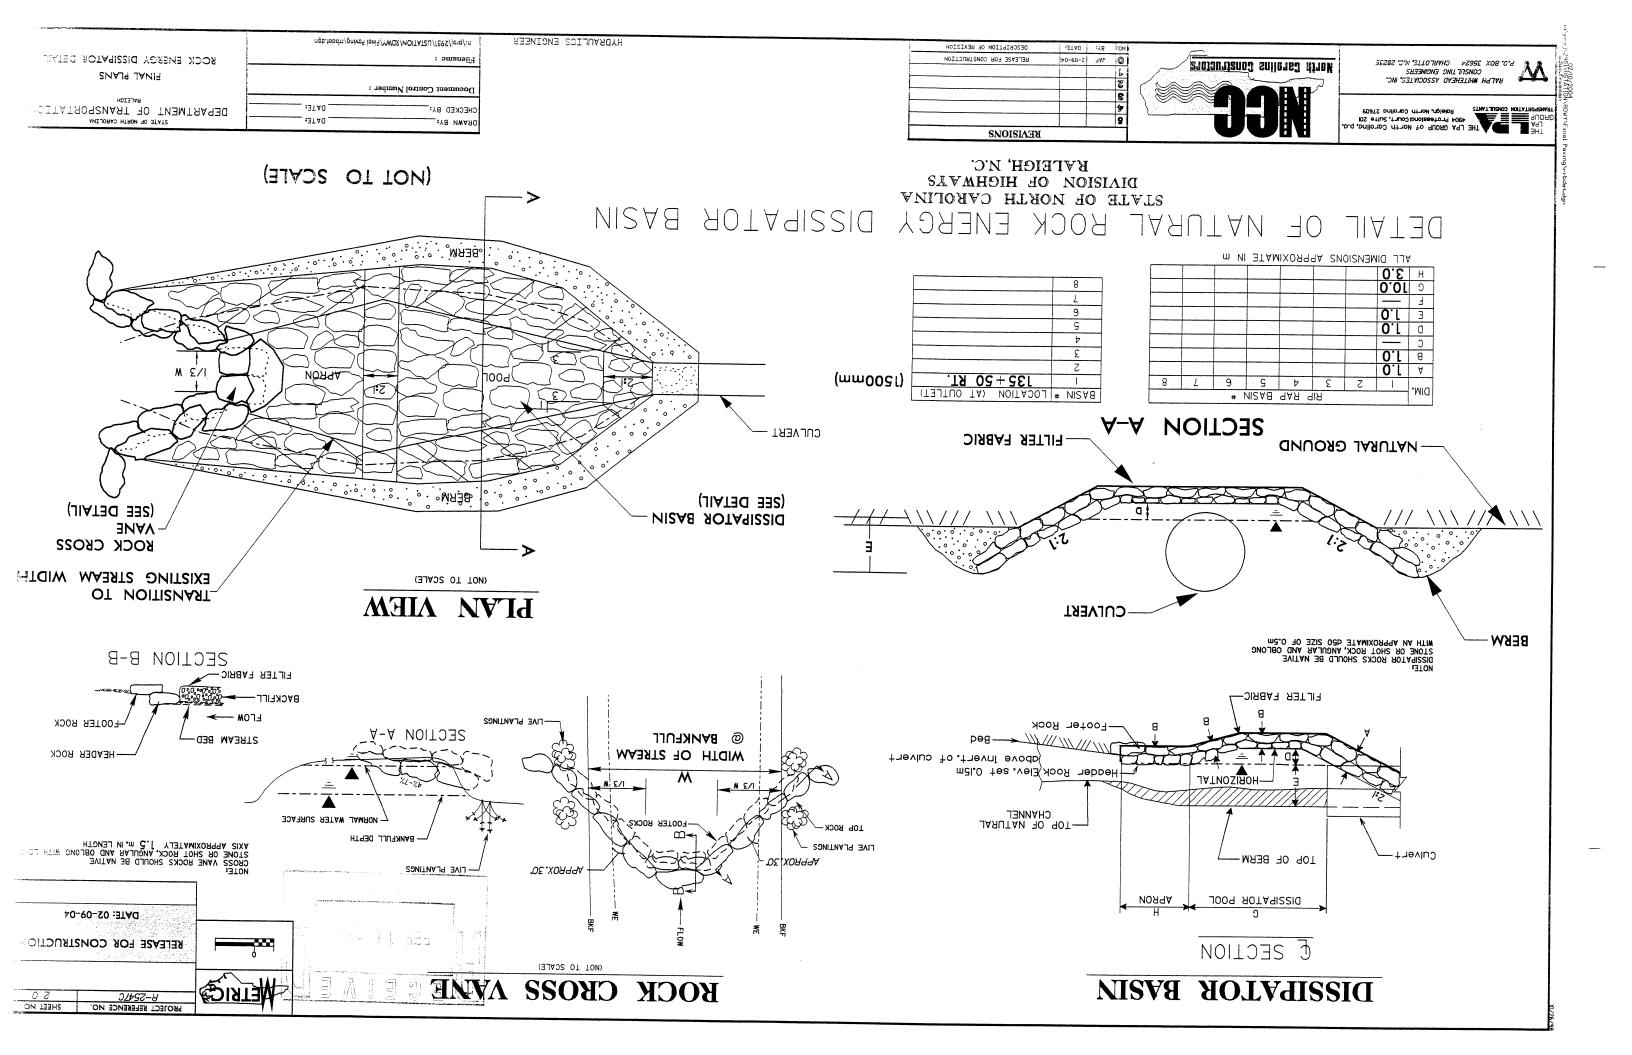

BRIDGE (MEDIAN) 4.6 274.74 274.74 0.7 4.2 116 + 03.000 102.550 783 TJ 247.45 + 6II 826.7£ + 211 BKIDGE 201.87 183 TR 112 + 70.935 058.29+111 BRIDGE (WEDIYN) 4.8 274.74 699.87 + III 979.95 RT WBL 112 + 49.082 699'84 + 111 BRIDGE (WEDIYM) ۵.٤ 374.74 8.4 8.5 111+82.284 150.52 183 TJ 312.35.315 111 + 82.284 6.0 952.2I 2.2 8.4 021.89 + 111 113 + 26.234 711.821 LT WBL 113 + 26.234 021.88 + 111 BRIDGE (WEDIYN) 3.4 111 + 22.387 268.25 RT WBL 786.22+111 567.69 + OLL BRIDGE (MEDIAN) **4.**£ 274.74 6.4 6.E 111 + 25.886 18.E 165.62 LT EBL 388.25+FIF 827.22 + OII BRIDGE 362.73 + 90f 048.ff+1ff 305.42I 048.11+111 262.73 + 901 BKIDGE 6.0 15.239 055.65+111 109 + 34.621 2.2 | 5.4 201.929 183 TA 055.55+111 109 + 34.621 SKIMM 30 OT TSYAR 5.0 3.6 4.000.4 2+55.269 255.269 5 + 55.269 000.00+0 3.6 4.6 906.62 + 60f 961.19 + 601 34.290 906.95 + 901 LT WBL 961.19 + 501 000.00+0 312.4 3.E 210.10+2 201,102 210.10+2 000.00+0 - aryong 6.0 **601.BII** 183 TR 016.20 + 701 108.78 + 201 BRIDGE (MEDIAN), SIGN (MEDIAN) 4.€ 3.4 3.5 012.41+401 000.04 + 40.0 277.065 BRIDGE (WEDIYN)' SIGN (WEDIYN) 012.41+401 277.075 183 TJ 240.20 + 70f 104 + 14.210 952.21 2.2 8.4 104+14.210 105 + 26.000 295.21T LT WBL 105+26.604 104+14.210 BRIDGE 98 4.6 5.2 000.09 + 40F 012.41+401 201.87 J83 TA 104+14.210 BKIDGE 365.ZII 18M 11 103 + 28.49 260.51 + 201 SIGN (WEDIYN) 6.0 15.239 3.6 4.6 000.04+101 671.72 LT WBL 671.79 + for 000.04+101 SIGN (MEDIAN) 5.0 6£Z,či 000.04+f0f 9.4 3.6 183 TR 128.28+001 BRIDGE (WEDIAN), SIGN (MEDIAN) 00.04+99 103 + 29.120 3.5 440.395 RT WBL 103 + 29.12 327.88+89 SIGN (WEDIVN)' BRIDGE (WEDIVN) 274.74 103+29.120 00.04+99 9.₽ 3.6 18.E 450.352 183 TJ 103 + 29.12 829.A7+89 €.0 15.239 5.2 103+29.120 948.52+96 **≯**72.978 183 TR 96 + 52.846 103 + 29.12 BRIDGE PIER (MEDIAN) 860.81 20.f 30.1 0E.SI 0E.SI 0.7 &&&.4 18.5 966.04 RT WBL 494.54+19 420.77+09 BRIDGE HER (WEDIYN) Z 30.f 30.f 12.30 0E.SI 0.7 888.4 445.344 18.€ SIGN 53.339 JB3 TR 90 + 30,000 199.97 + 98
 END
 TRAILING
 GRAU M CAT-1
 EA G NG APPROACH TRAILING RARRIER EOF FACED CURVED IX 39YT **MIDTH** THOIANTS REMARKS CONCRETE TYPE 350 TRAILING **HDAO899A** DOUBLE 4OHS FROM SHOUL LOCATION ATTENUATOR TSIQ SURVEY **LATOT** THIO9 THARRAW W = TOTAL WIDTH OF FLARE FROM BEGINNING OF TAPER TO END OF GUARDRAIL. FLAKE LENGTH = DISTANCE FROM LAST SECTION OF PARALLEL GUARDRAIL TO END OF GUARDRAIL. GUARDRAIL SUMMARY TOTAL SHOULDER WIDTH = DISTANCE FROM EDGE OF TRAVEL LANE TO SHOULDER BREAK POINT. "N" = DISTANCE FROM EDGE OF LANE TO FACE OF GUARDRAIL. DATE: 8-28-03 RELEASE FOR CONSTRUCTION DIAISION OF HIGHWAYS

STATE OF NORTH CAROLINA

5.0

۵.٤

BRIDGE (WEDIAN)

R-2547C

PROJECT KEPEKENCE NO.

SHEEL NO.

652.21

274.74 274.74

5.2

9·Þ

0.7 | 2.4

172.97 + 811

\$10.25 + 8IT

000.60 + 611

000.21+711

HECKED BA

DATE: 05/15/03 OMPUTED BY: __IBL

120 + 05.000 LT WBL

183 TR

118+35,014

710.01¢

102.550

172.97 + 811

000.21+711

COMPUTED BY: JBL

W = TOTAL WIDTH OF FLARE FROM BEGINNING OF TAPER TO END OF GUARDRAIL.

"N" = DISTANCE FROM EDGE OF LANE TO FACE OF GUARDRAIL.

FLARE LENGTH = DISTANCE FROM LAST SECTION OF PARALLEL GUARDRAIL TO END OF GUARDRAIL.

TOTAL SHOULDER WIDTH = DISTANCE FROM EDGE OF TRAVEL LANE TO SHOULDER BREAK POINT.

TERMINAL

TYPEIII

[-TAD

05E-M

GRAU-350

20@5.715 =

= 809. F@£S

=0£4.ff@8

29@15.24=

LESS ANCHOR DEDUCTIONS:

M 252.1824 YAS 246.f624 JATOT

967.5-

-114.300

218.Eb-

044.FQ-

956.6525

JATOT



| | NGLE FACED | | A9MI | S | ANCHOR | | | | | M | нтоиз | FLARE LI | JATOT | "N" | TNIO9 TI | NARRAW | | LENGTH | | 1,1011,201 | 713 6143 | V13 234 | SURVEY |
|--|-----------------|----------|----------|--------------|--------|----------|-------|-------|--|-----------------|-----------------|----------------|----------|--------------|-----------------|-----------------|-----------------|----------------|-----------------|------------|--------------|--------------|---------|
| БЕМА КК2 | CONCRETE | 320 | TYPE : | TERMINAL END | | ATT I-TA | 20 CY | | TRAILING END | APPROACH END | DNIJIA9T GN3 | HDAOR9A GMB | HTGIW | FROM FROM | TRAILING END | APPROACH END | FACED POUBLE | COBAED 2HOb | THOIANT2 | LOCATION | END 214. | BEG. STA. | TINE |
| | f0.528 .QT2 | DN 4 | EV C | SECTION | WOD | " | 100 | | CNIZ | 0.3 | | 15.239 | 5.2 | 9.4 | 122 + 20.000 | | <u> </u> | - | 53.339 | RT EBL | 122 + 20.000 | 199.99 + 121 | -1- |
| SIGN | | ++ | ++ | | + | | _ | | | 6:0 | | (0710 | | | | | | | | | | | |
| 14313 | | + | +++ | | - | L | _ | L | | €.0 | | 15.239 | 5.2 | ð.4 | 000.27+≯2f | | | | 955.53 | LT WBL | 125 + 28.339 | 124 + 75.000 | -1- |
| SIGN | | | \dashv | | | | | | | | | | 711.5 | | | | <u> </u> | 1 | 1 | 103.10 | 300 08 761 | 700 01 1 001 | + |
| | | | | | | l | | ı | | €.0 | | 15.239 | 002.8 | 4.2 | 134+82.000 | 966.61+261 | - | | ≯09.89 Z | RT EBL | 134 + 42,000 | 965.51 + 251 | + |
| | | | 11 | | + | | - | | | | | 15.239 | SII.2 | 5.4 | 133.42 + 881 | 136 + 45.000 | ļ | | 285.749 | 18W TJ | 136 + 45.000 | 133.45 + 551 | -1- |
| | _ | \dashv | +++ | | + | | | | | £.0 | L | (07:0) | CITIC | | | 000155-1-001 | | | | | | | |
| TIES INTO SECTION C-C | | | + | | | L | | L | | ε.0 | | 15.239 | SIT.2 | 2.4 | 000.08 + 0≯ſ | 457.24+ SAI | | | 467.23F | 18W TJ | 142 + 45.734 | 000.08 + 041 | -1- |
| | | | | | | | | | | | | 265 31 | 1 911 9 | 1 67 | 792 06 + 771 | 000 98 7 071 | 1 | | 325.754 | RT EBL | 144+20.754 | 000.89+041 | -1- |
| | | +++ | ++ | | | | _ | | | £.0 | ļ | 15.239 | SII.2 | ₹.4 | 427.02+44r | 000.29+0br | | | +C/:C7C | | | | |
| | | ++ | ++ | | - | | | | | | ļ | | | | | | | | | | | | 1 |
| | | \dashv | ++ | | | | | | | | | | | | | | | | 1 | | | + | |
| | | | | | | | | | | | 000 31 | | 1 , , | 1 12 | 13 + 21 340 | 12 + 50 021 | | | 954.19 | 17 | 098.12+81 | 12 + 59.921 | - bM - |
| BRIDGE 2 TANE /2 WAY | | ++ | ++ | | - | | | | 6.0 | | 15.239 | | 4.€ | 2.4 | 095,13+51 | 126.92 + 21 | <u> </u> | | (0) | | | | |
| AVA & AVA E STAN | | ++ | ++ | | | l | | L | | €.0 | | 15.239 | 3.4 | 2.4 | 011.82+41 | 690'6l+Sl | | | 69.09 | 11 | 690'6l+9l | 011.82+41 | - pU - |
| BRIDGE 2 LANE /2 WAY | | | | | | | | | | | | 1 | + | | | 177 03 - 01 | | | 018 08 | | 13+43 280 | 12+59.467 | - plA - |
| BRIDGE 2 TANE /2 WAY | | | | | | L | _ | L | | €.0 | | 952.21 | 3.4 | 2,4 | 13+43.280 | 194.92+21 | | | 918.58 | RT | 13+43.280 | 105:46 1.71 | + |
| NTM 0/2141 0/2000 | | ++ | ++ | | + | L | | - ' | £.0 | - | 15.239 | | 3.4 | 2.4 | 15+20.334 | 028.94+47 | | | 484.07 | TA | 15+20.334 | 28.94+41 | - 7以 - |
| BRIDGE 2 TANE /2 WAY | | | \dashv | | | | | | | | | | | | | | | | | | | | |
| | | | | | | | | | | | | - | + | | | | | | | | + | | + |
| | | | \top | | + | | | | | + | | | + | - | | | | | | | | | |
| | | -++ | ++ | | +-+ | | | | | | | | | <u> </u> | | | | | | | | | |
| | | | | | | | | | | | | | | | | | | | | | | | |

CABLE GUIDERAIL SUMMARY

| | 20 | 4265,000 | JATOT | | |
|---------------------|----------------|-----------|----------------|--------------|-------|
| | | 000.22.1- | =009.7@02 | | |
| | | | | | |
| | | | OR DEDUCTIONS: | LESS ANCH | |
| | | | | | |
| | | | | | |
| | | | | | |
| | | | | | |
| | | | | | |
| | | | | | |
| | | | | | |
| | | 000.7144 | JATOT | | |
| | | | | | |
| | ζ | 000.872 | 144+20.000 | 141 + 42.000 | -1- |
| | | | | | |
| | 8 | 2391.000 | 000.29+0hr | 000.47 + ∂IT | -1- |
| | | | | | |
| | 2 | 277.000 | 115 + 32.000 | 112 + 55.000 | - 7 - |
| | | | | | |
| | 7 | 354.000 | 000.02 + 011 | 000.89 + 80f | -1- |
| | | | | | |
| | Þ | 000.027 | 000.69+86 | 000.94+19 | - 1 - |
| & DETAIL 865.D01 | | | | | |
| 10.238 GTZ - NAIGEM | 7 | 397.000 | 000.72+09 | 000.05 + 88 | -1- |
| KEMARKS | VACHORS | LENGTH | END STA. | BEG. STA. | TINE |

CONTINUED)

DATE: 02-09-04


RELEASE FOR CONSTRUCTION


PROJECT REFERENCE NO. SHEET NO.


K-2547C


76 8 73 70


36 8 53 50

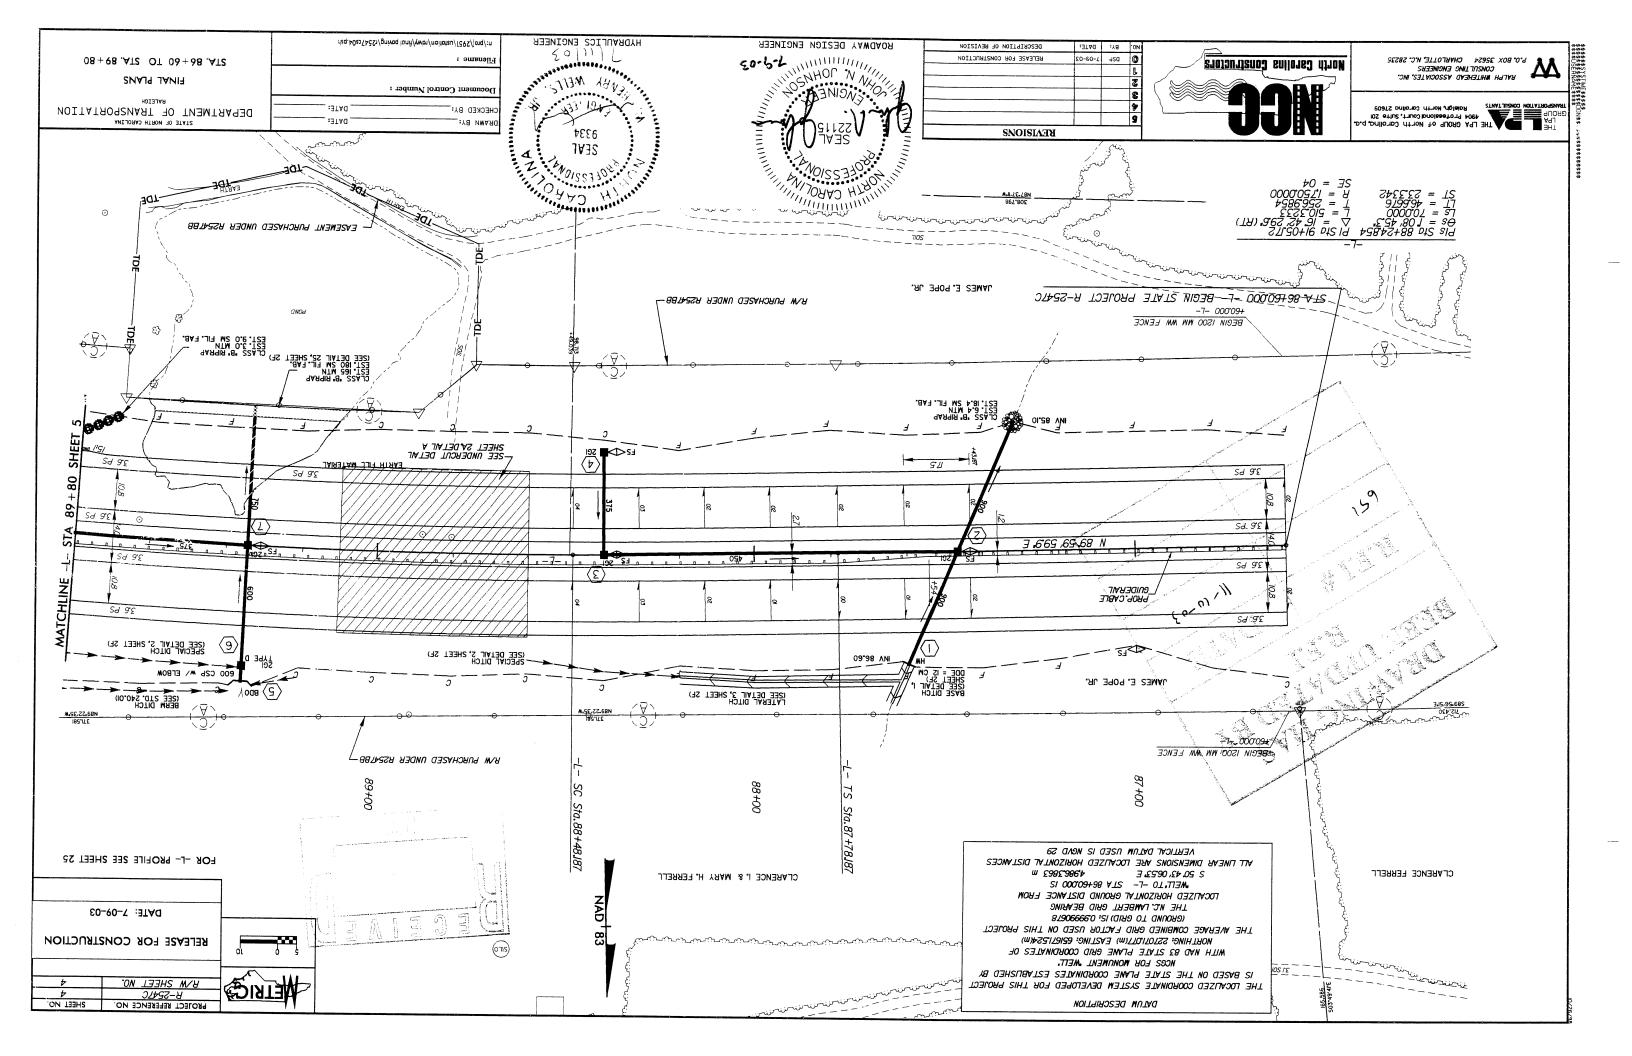


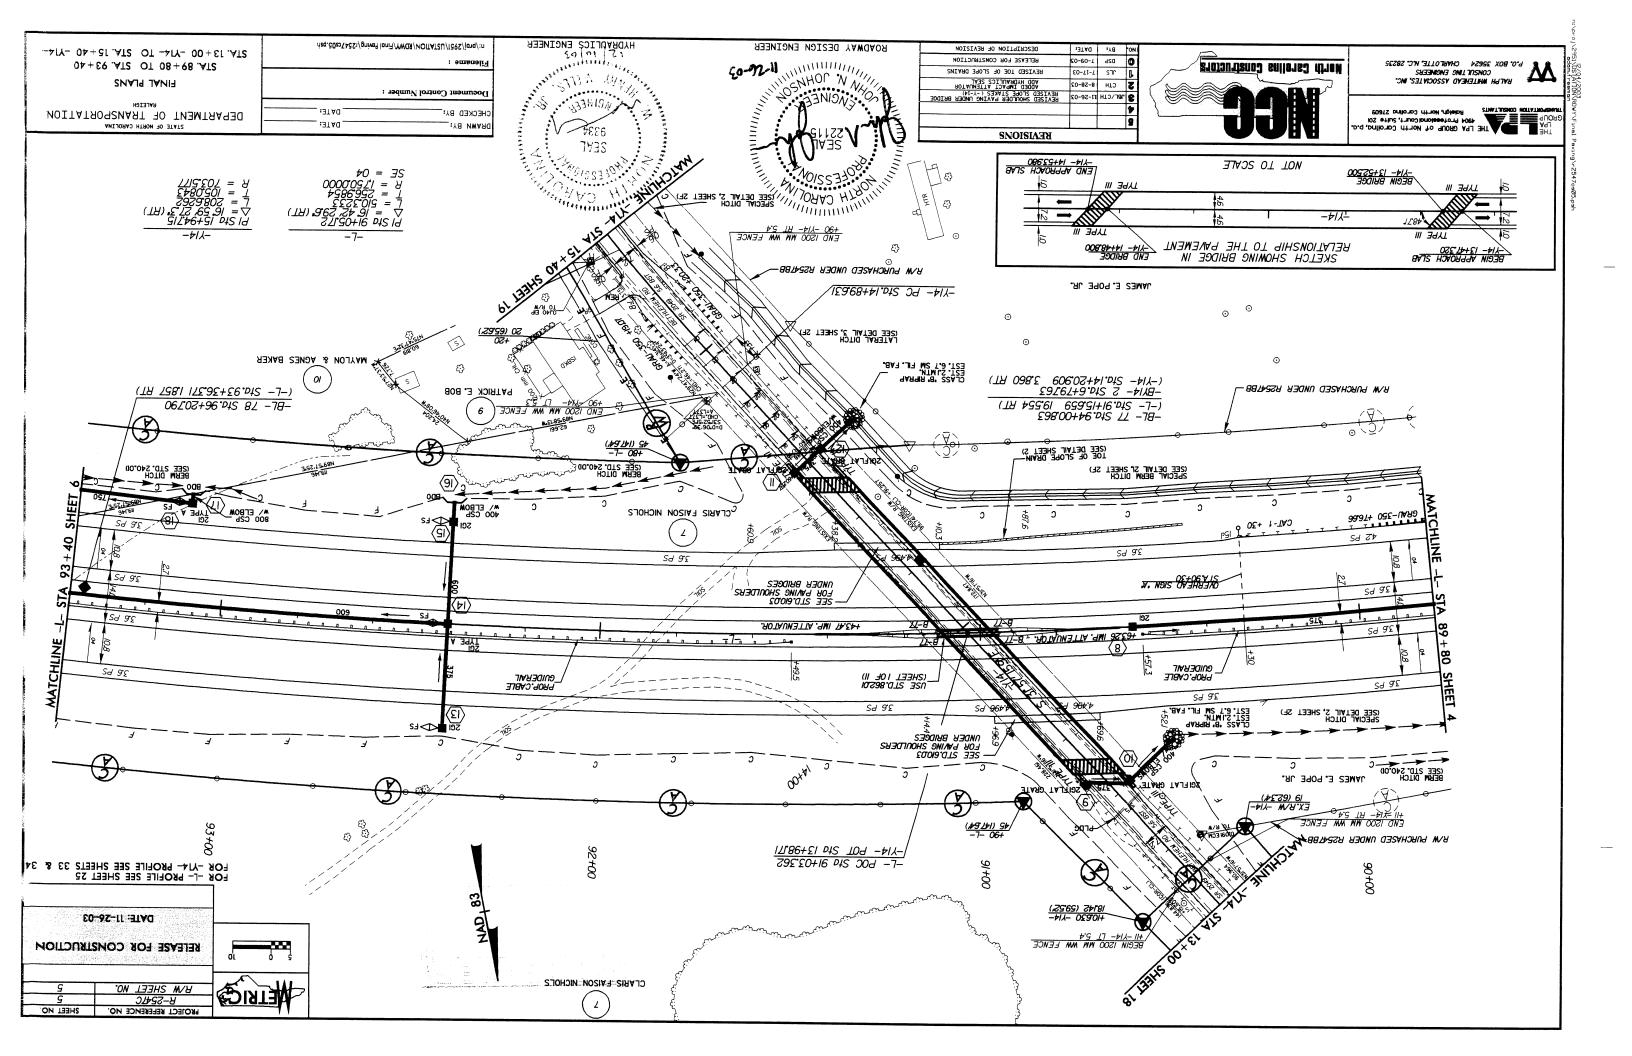


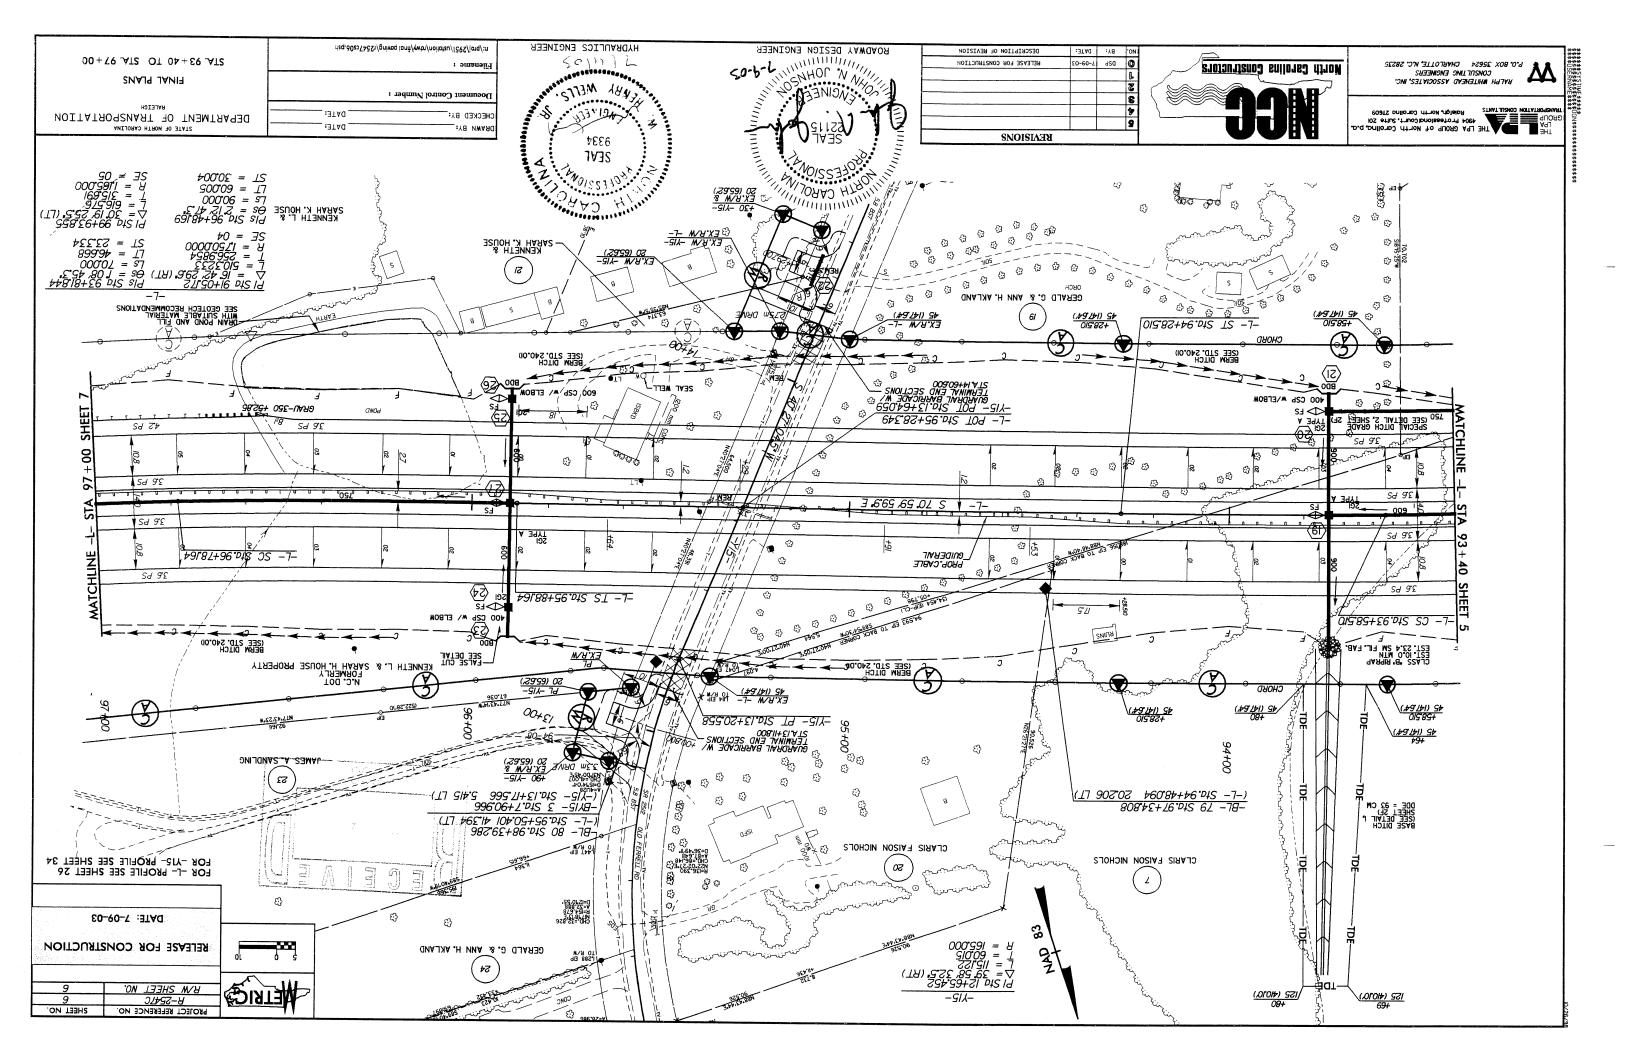


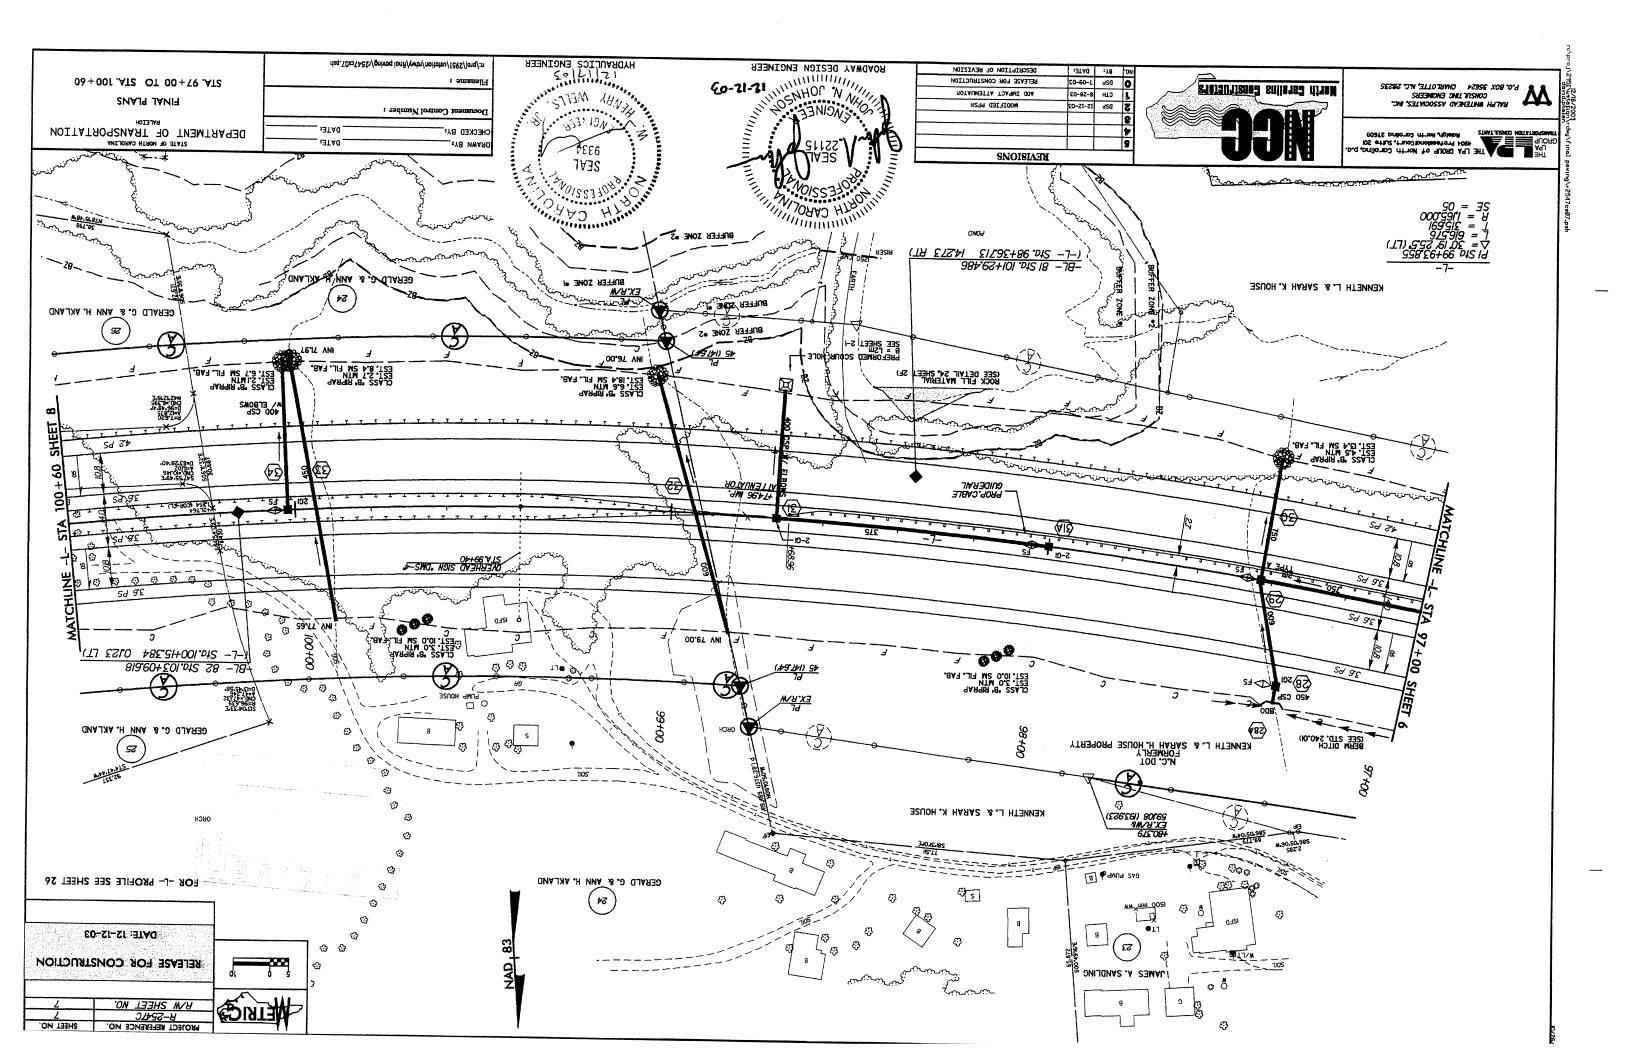


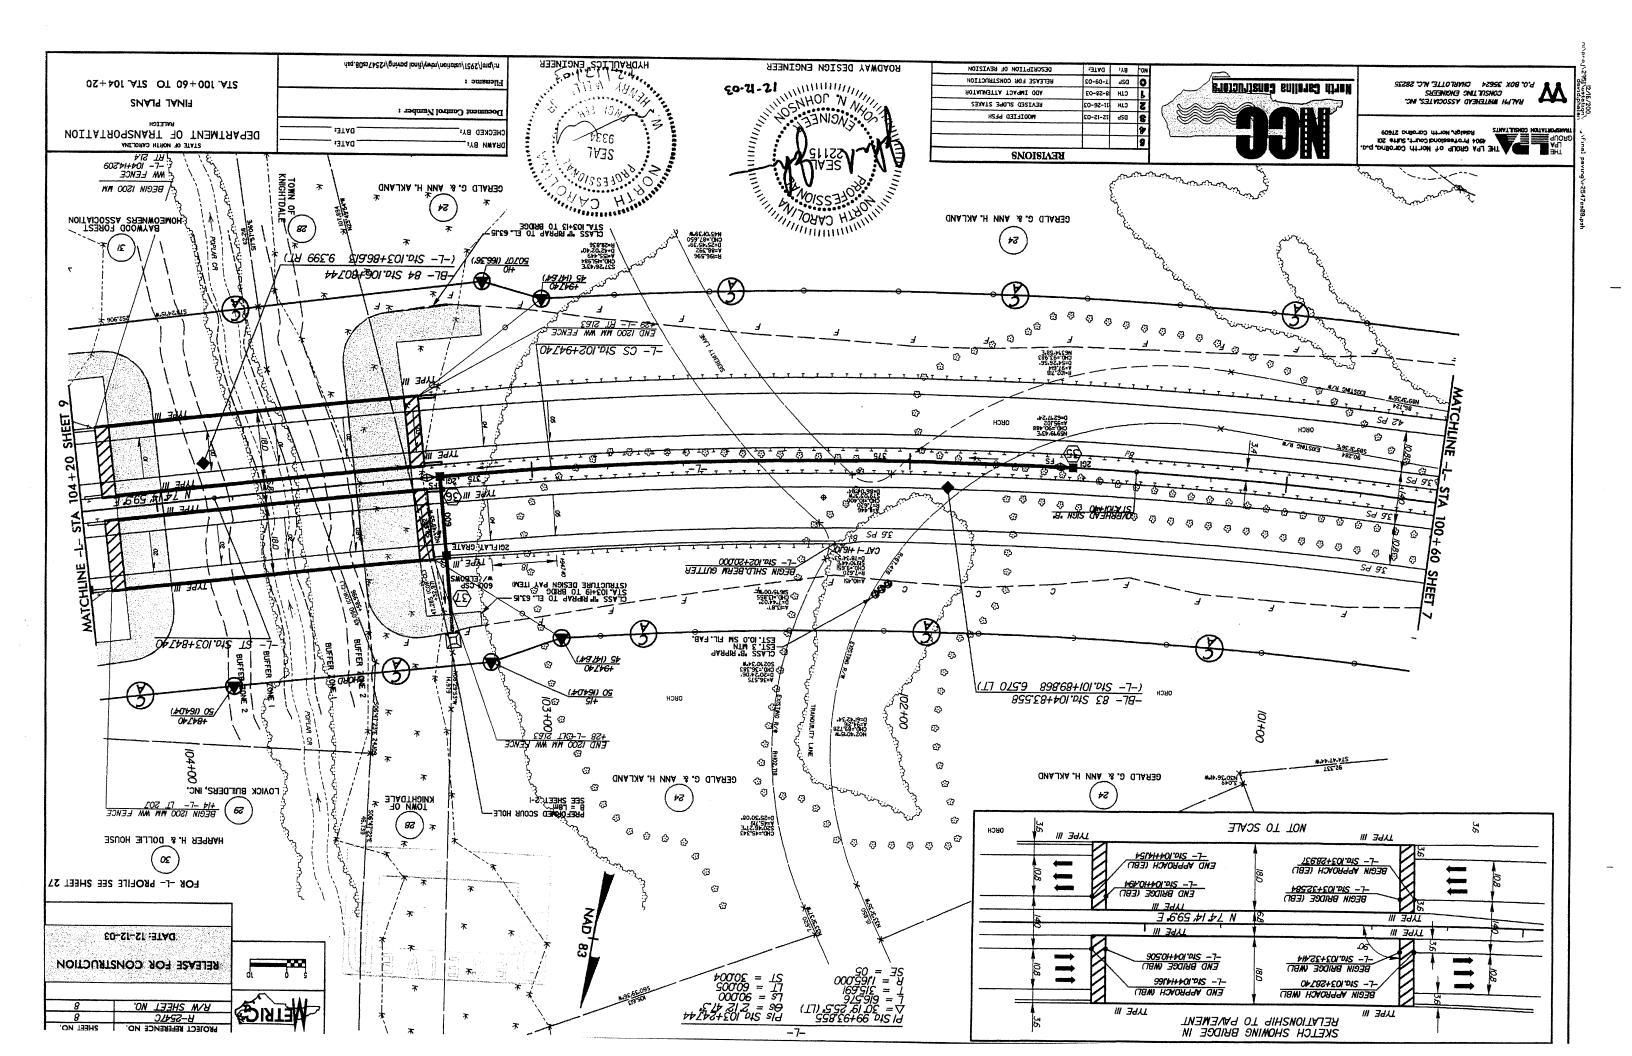


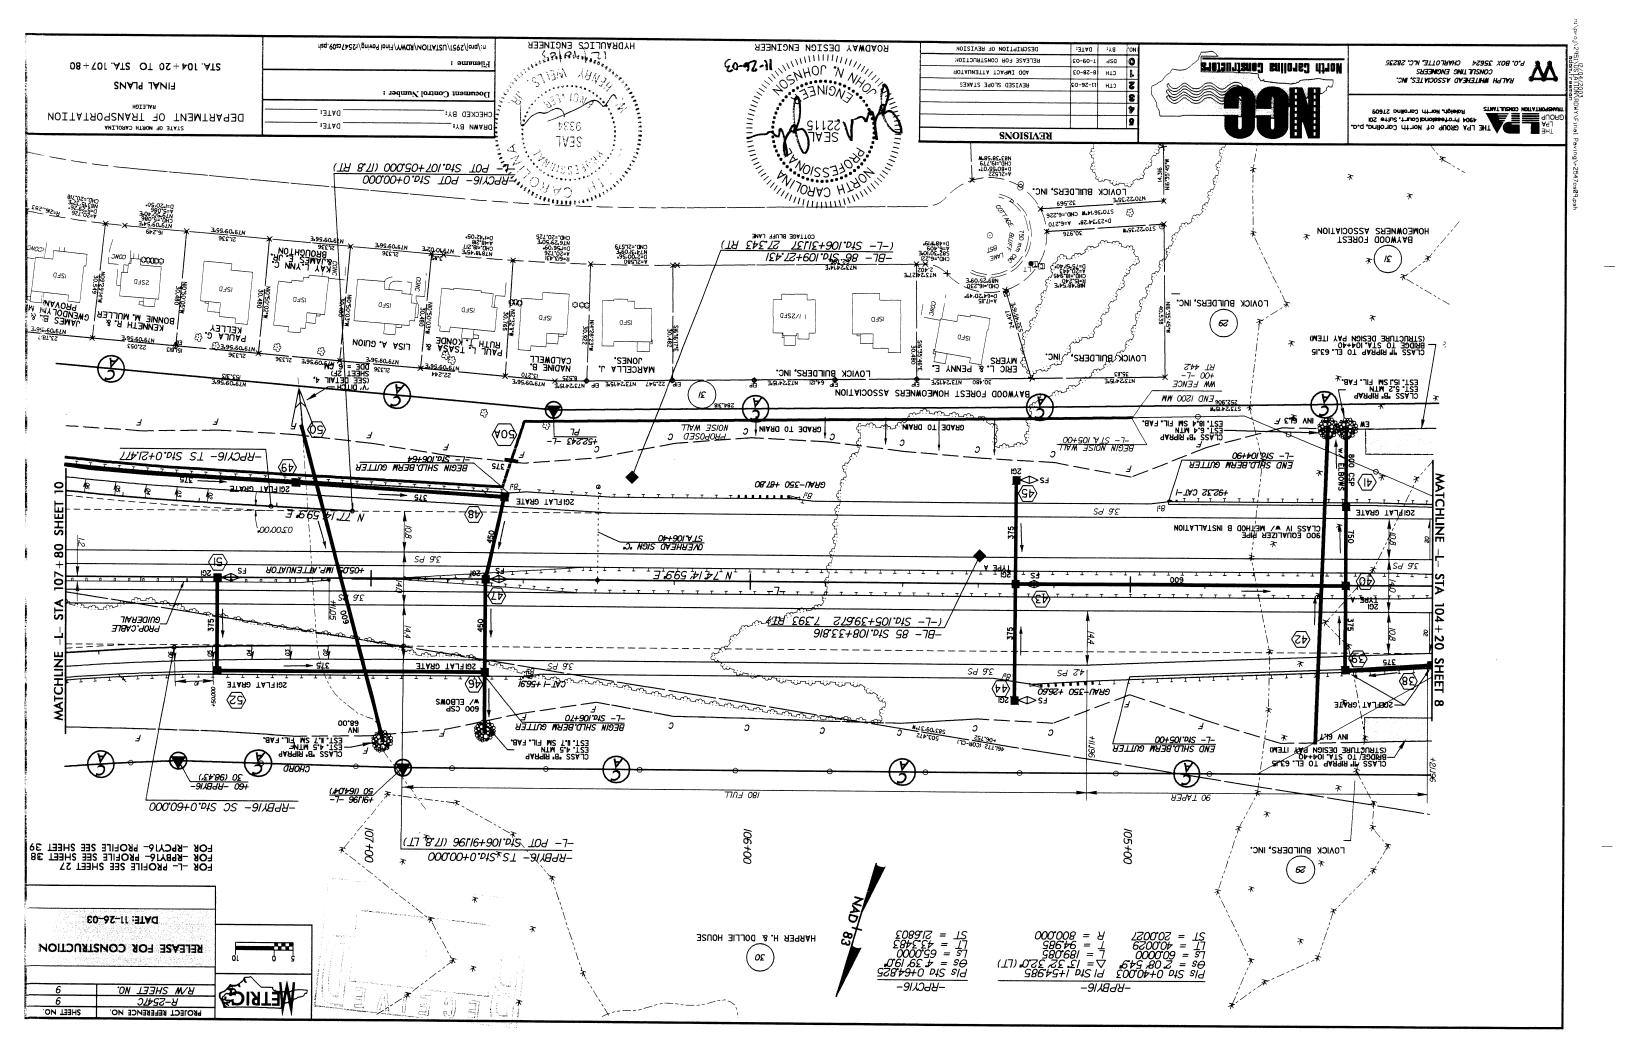


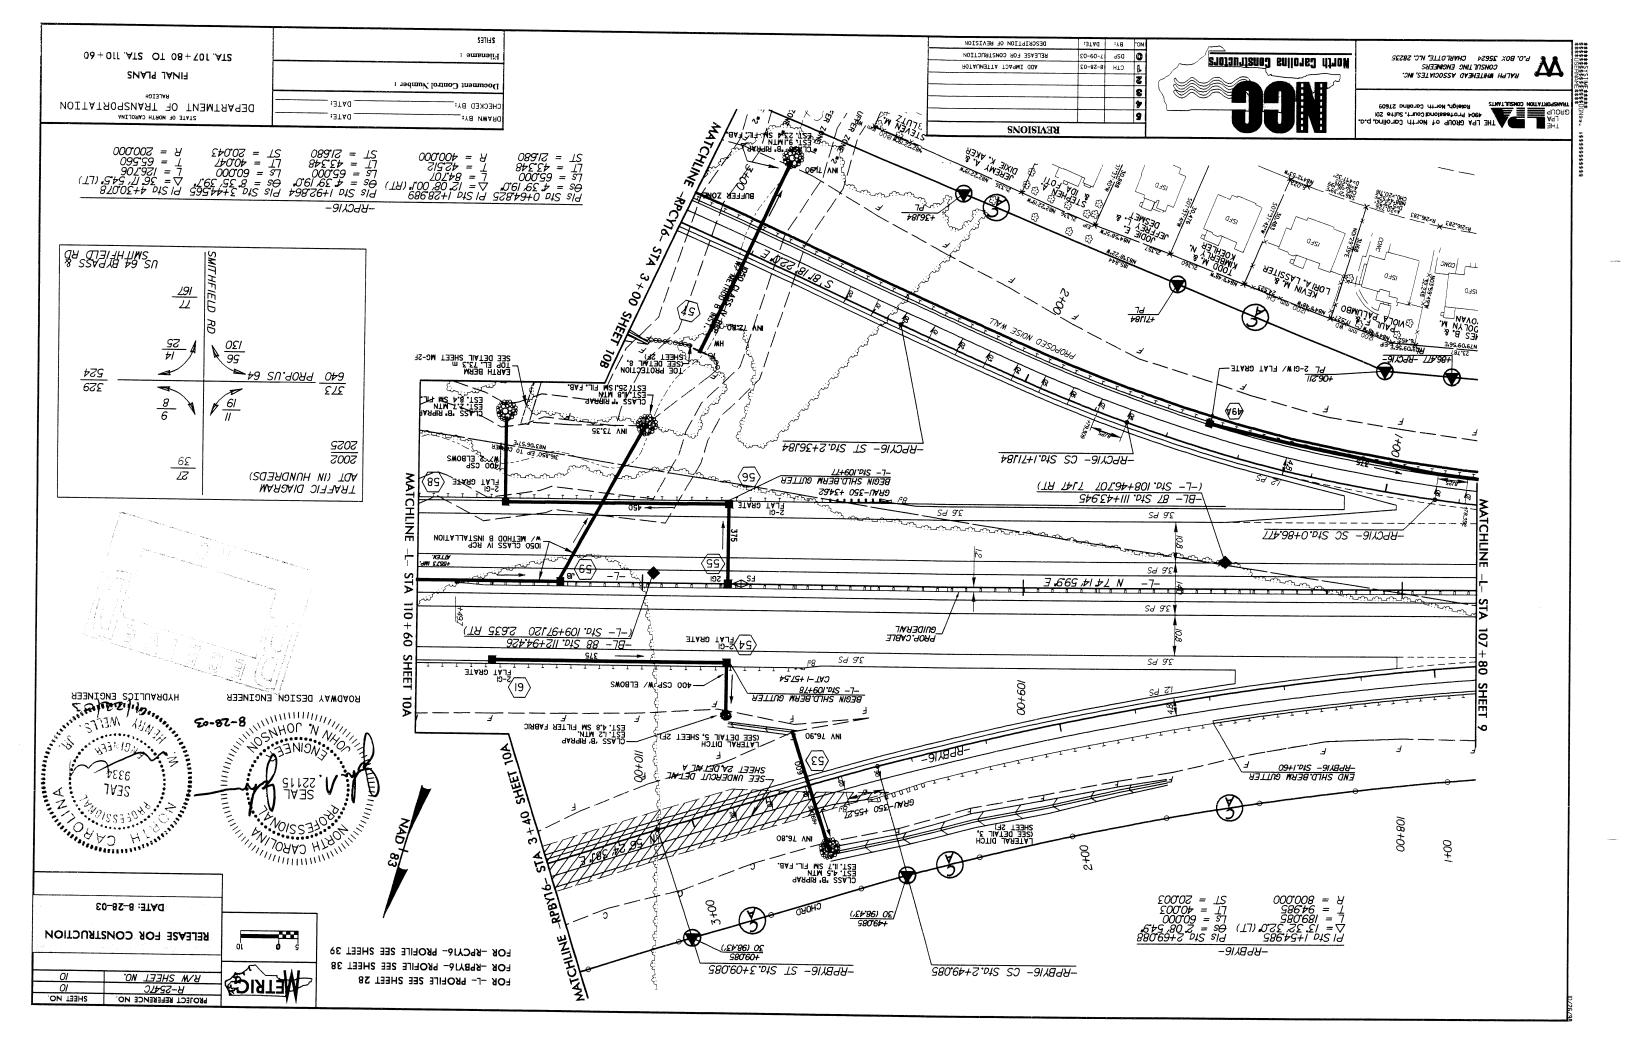


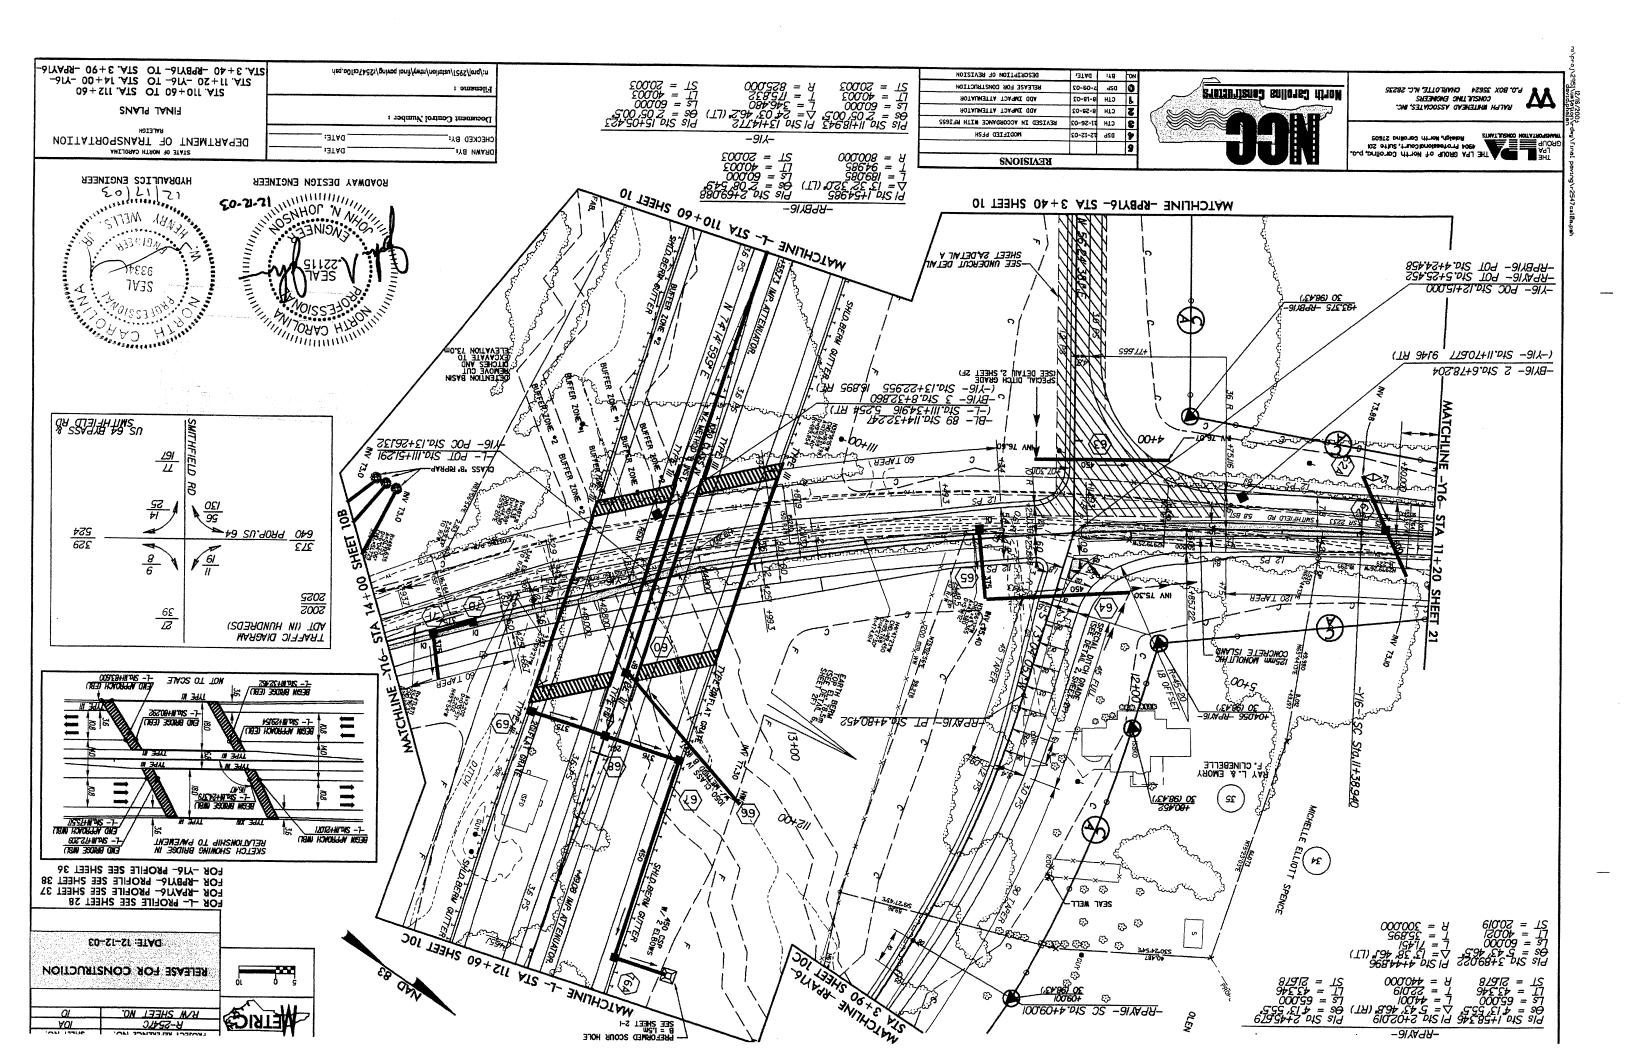


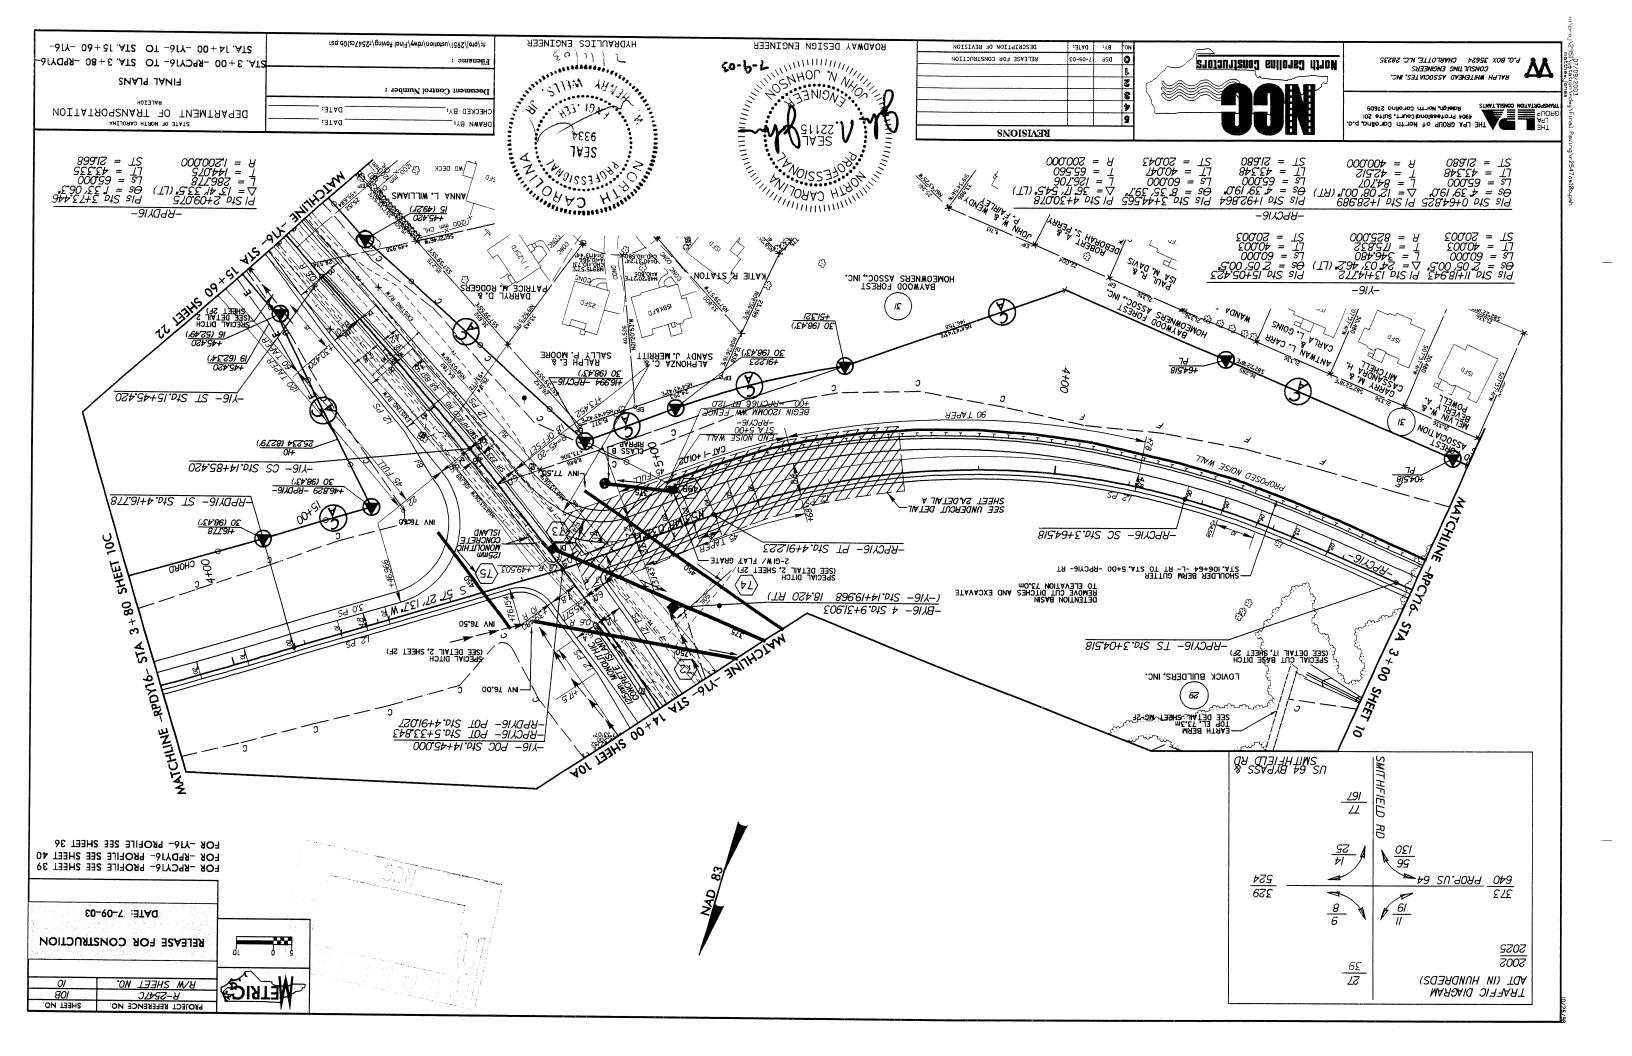


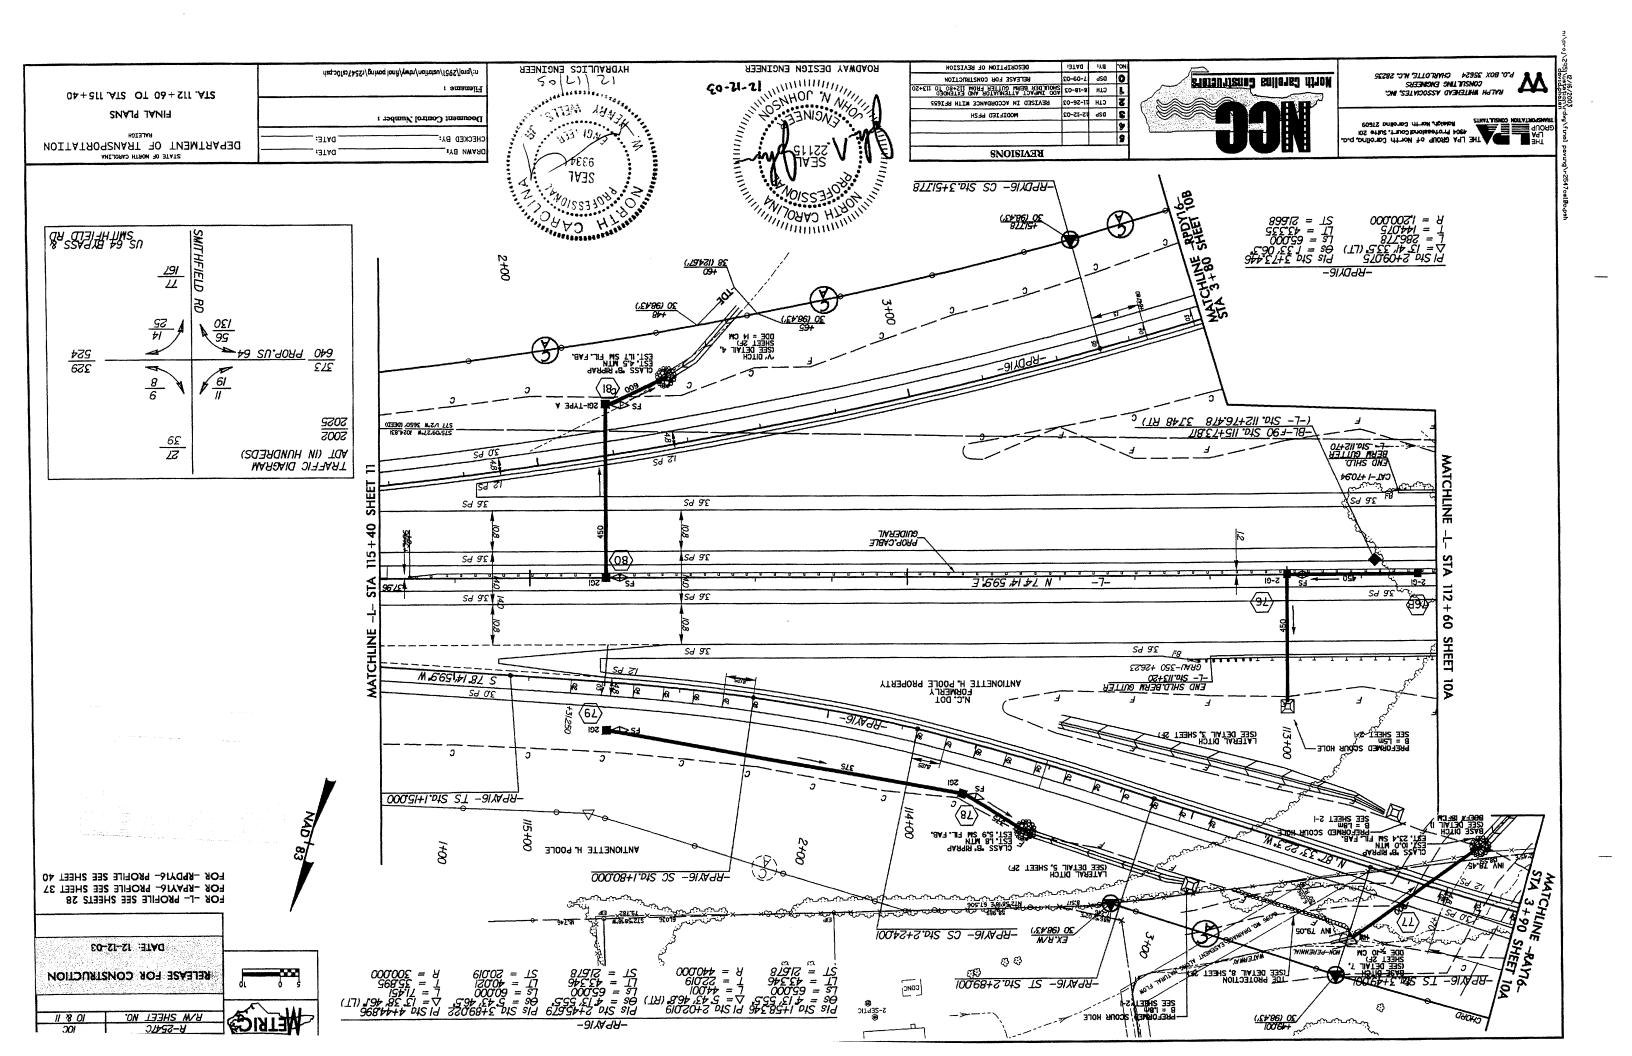


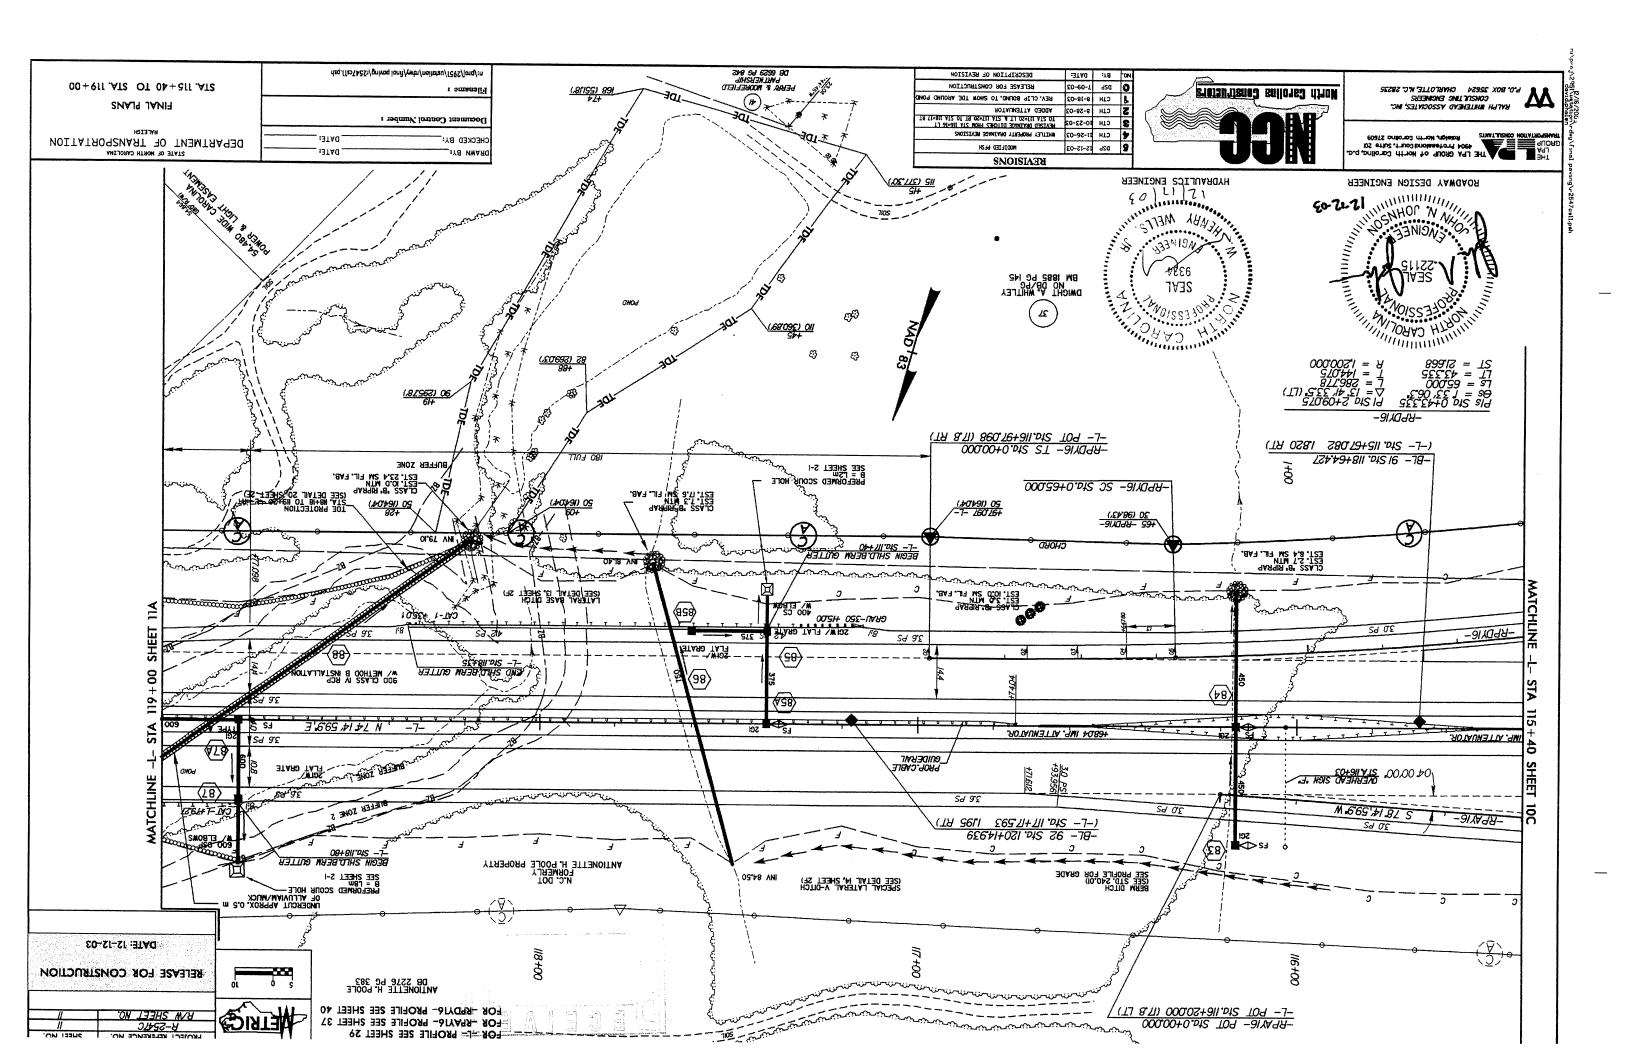


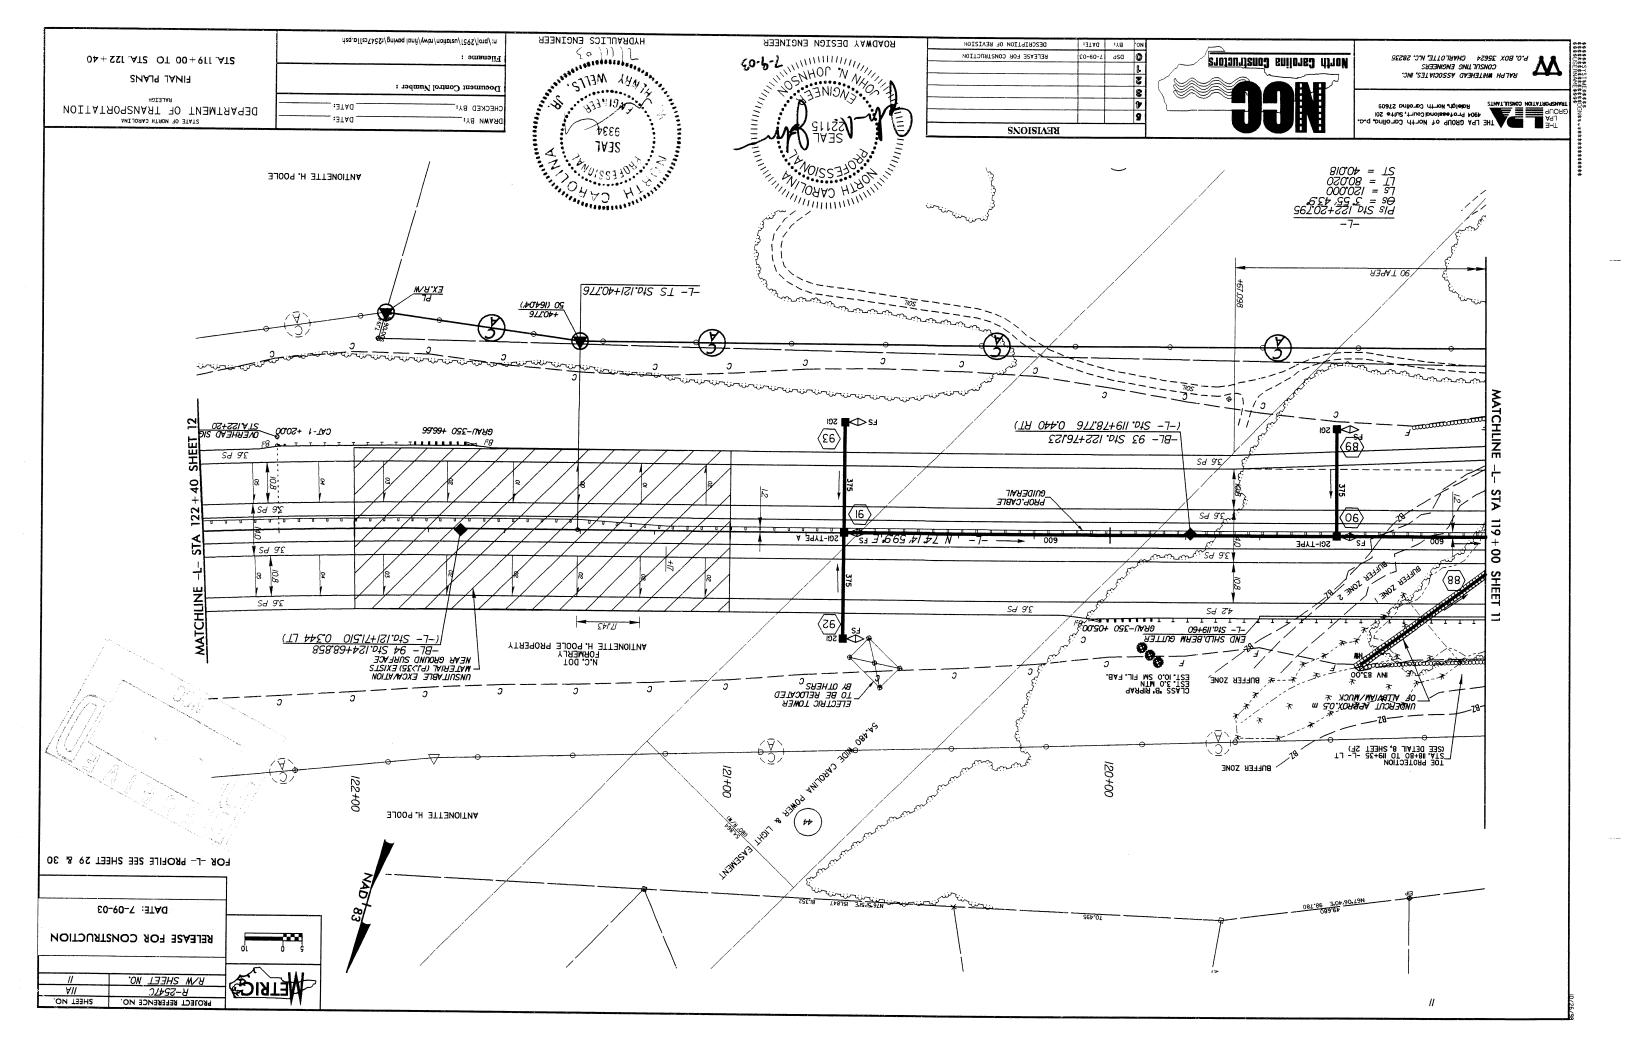


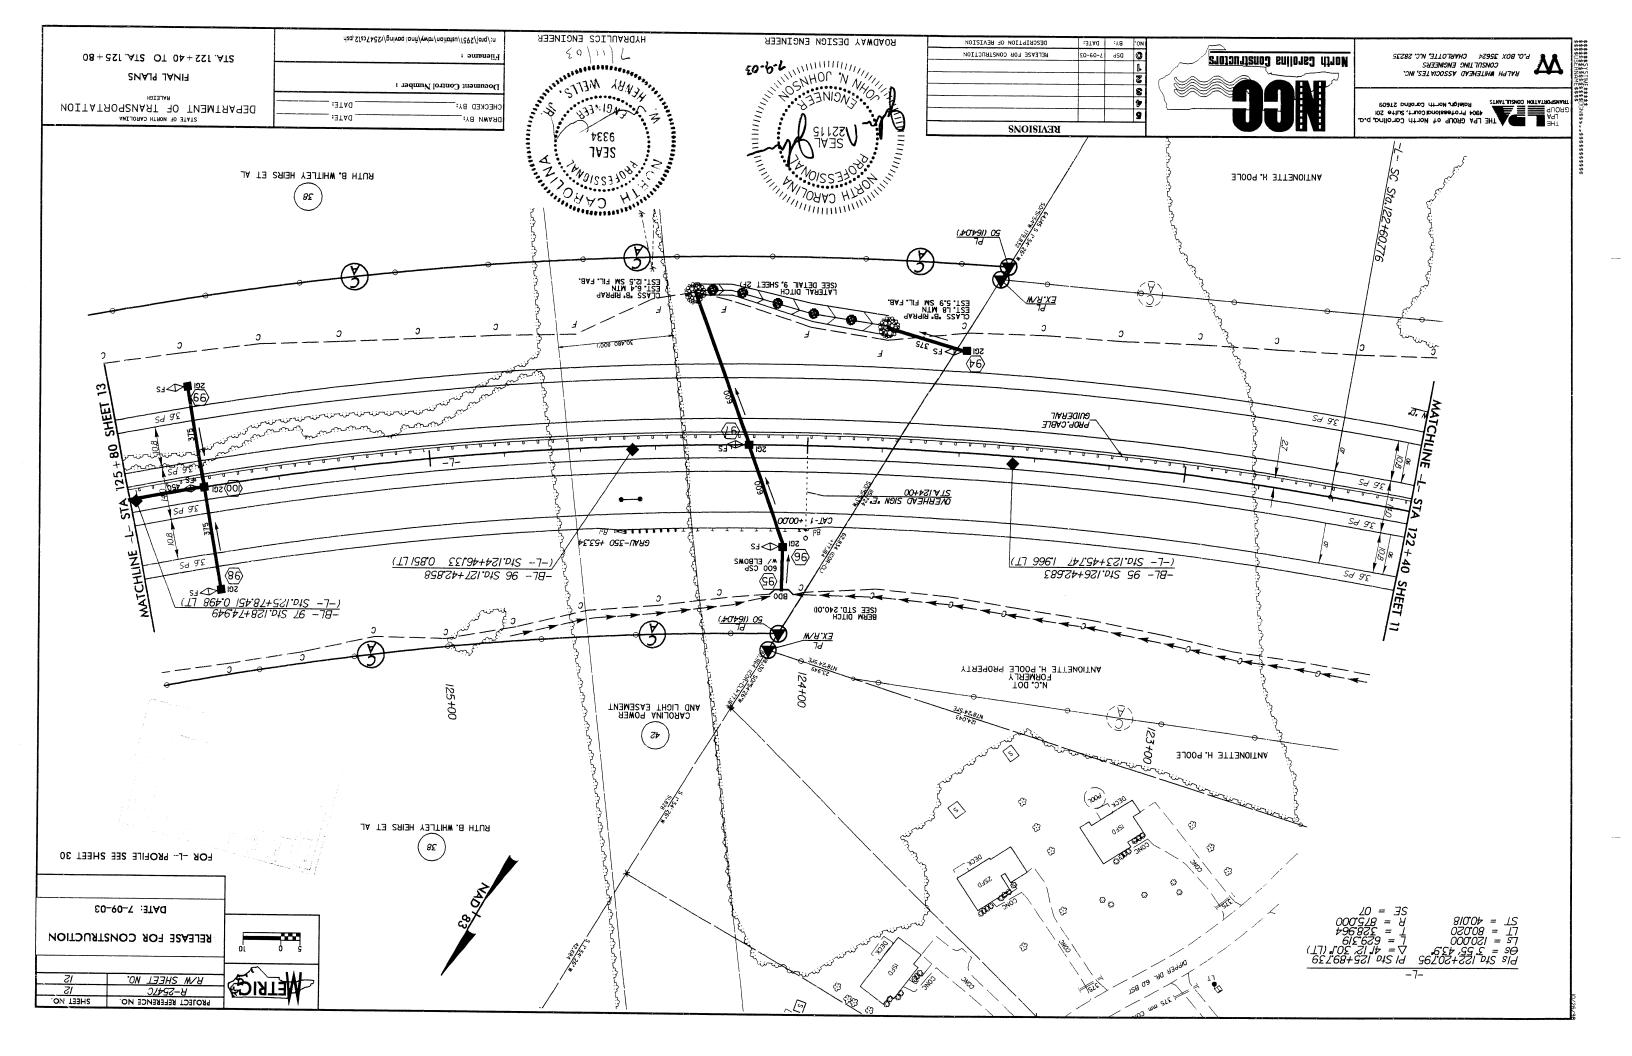


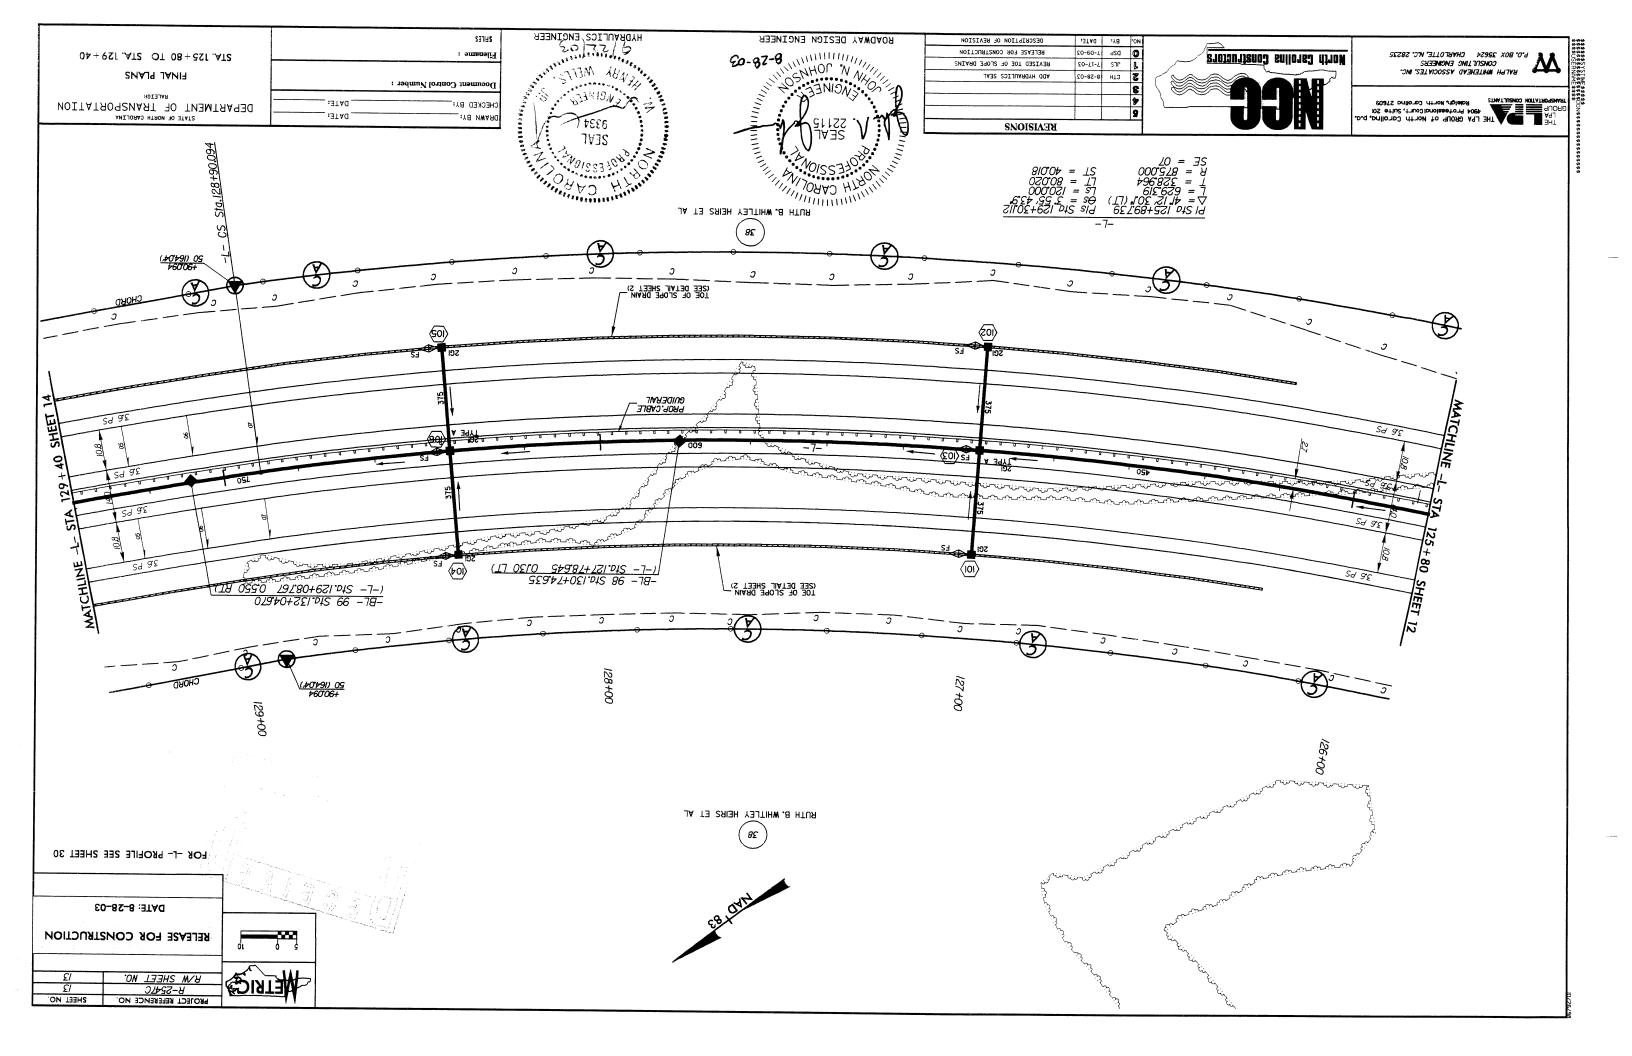


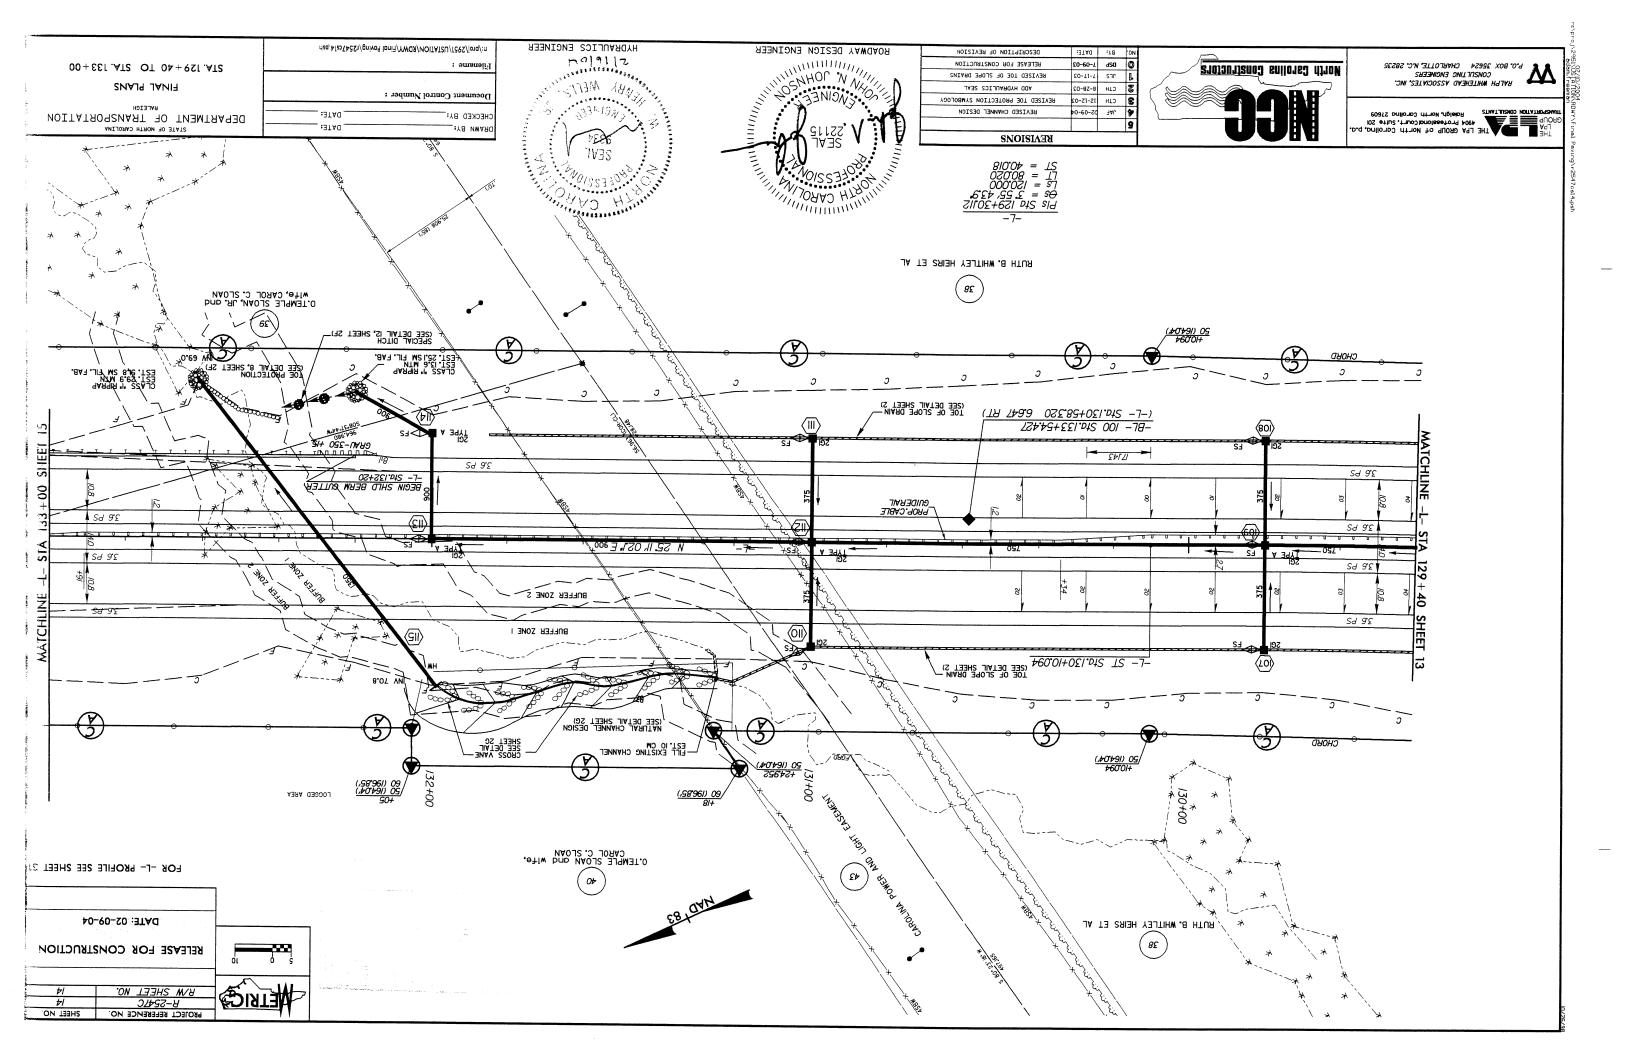


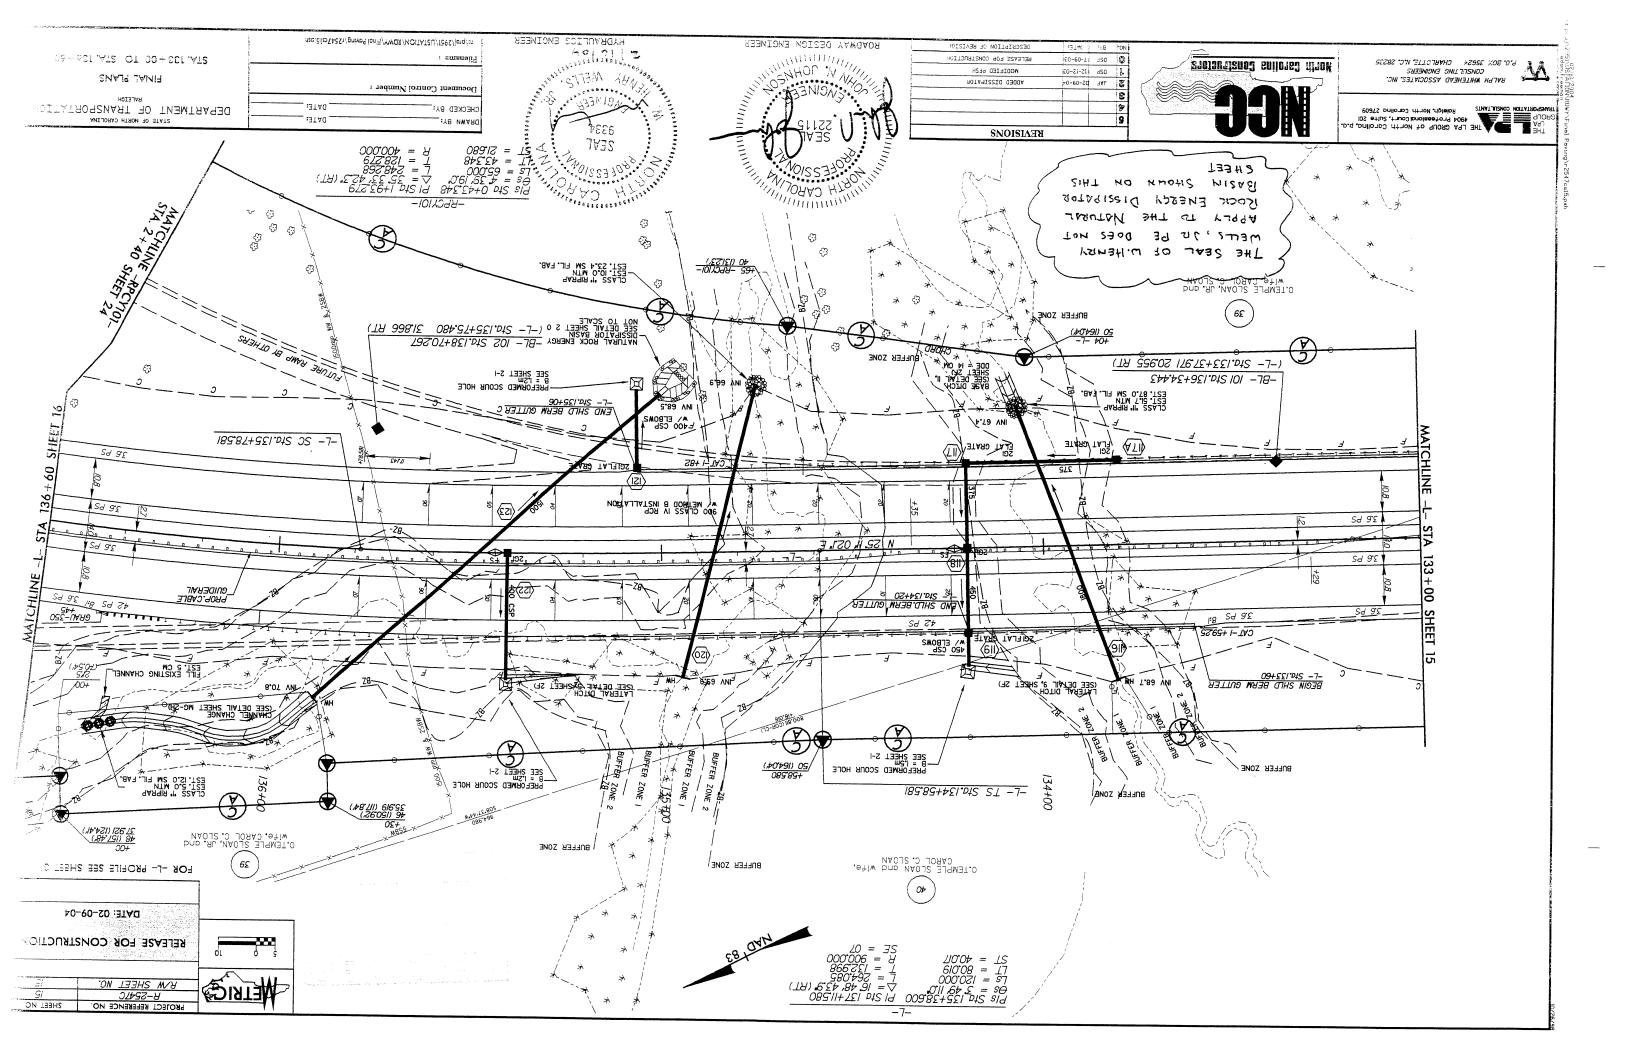


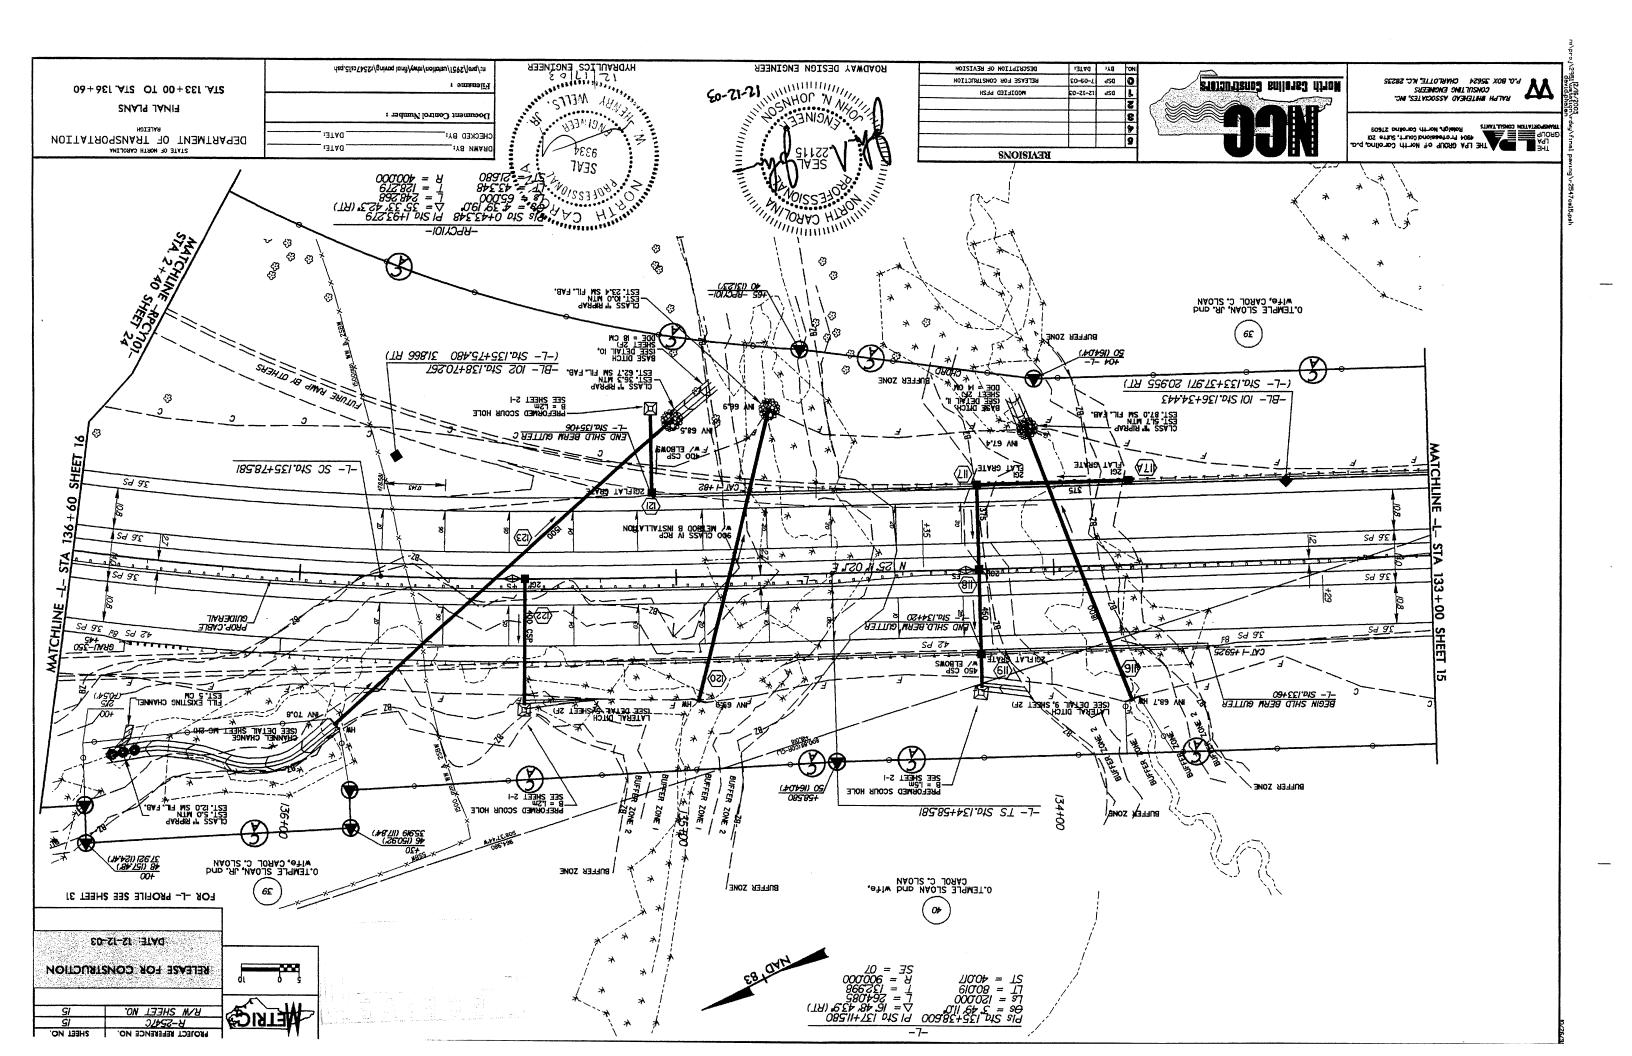


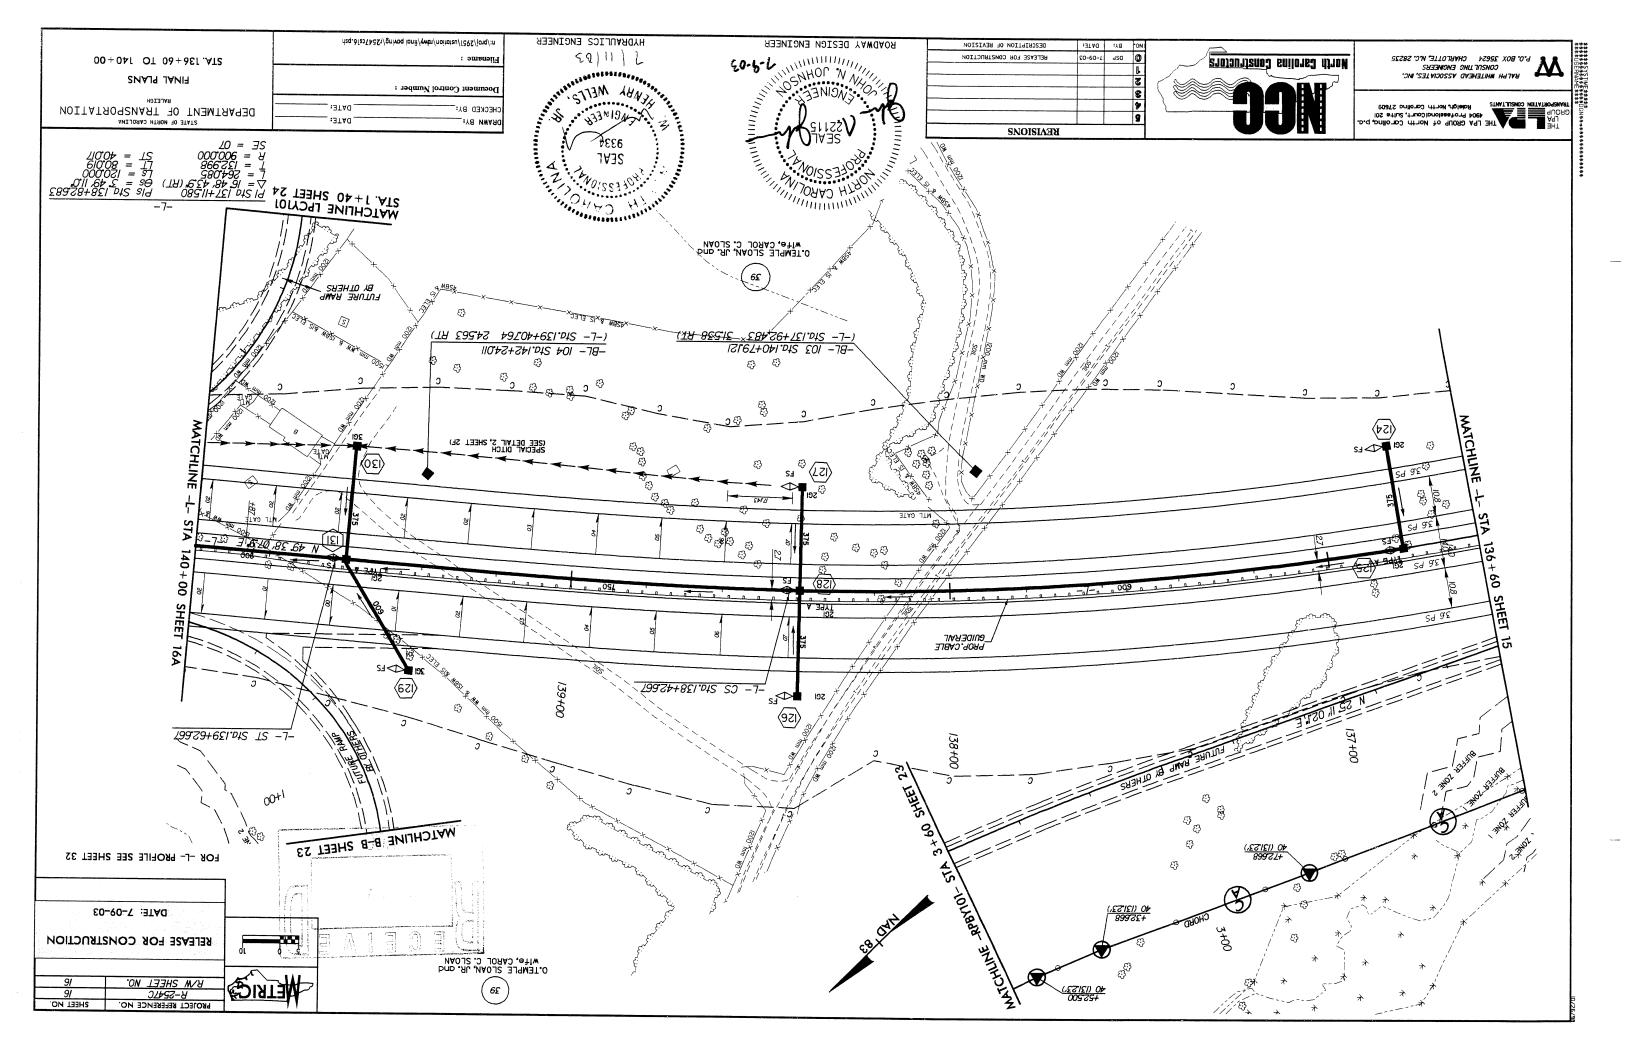


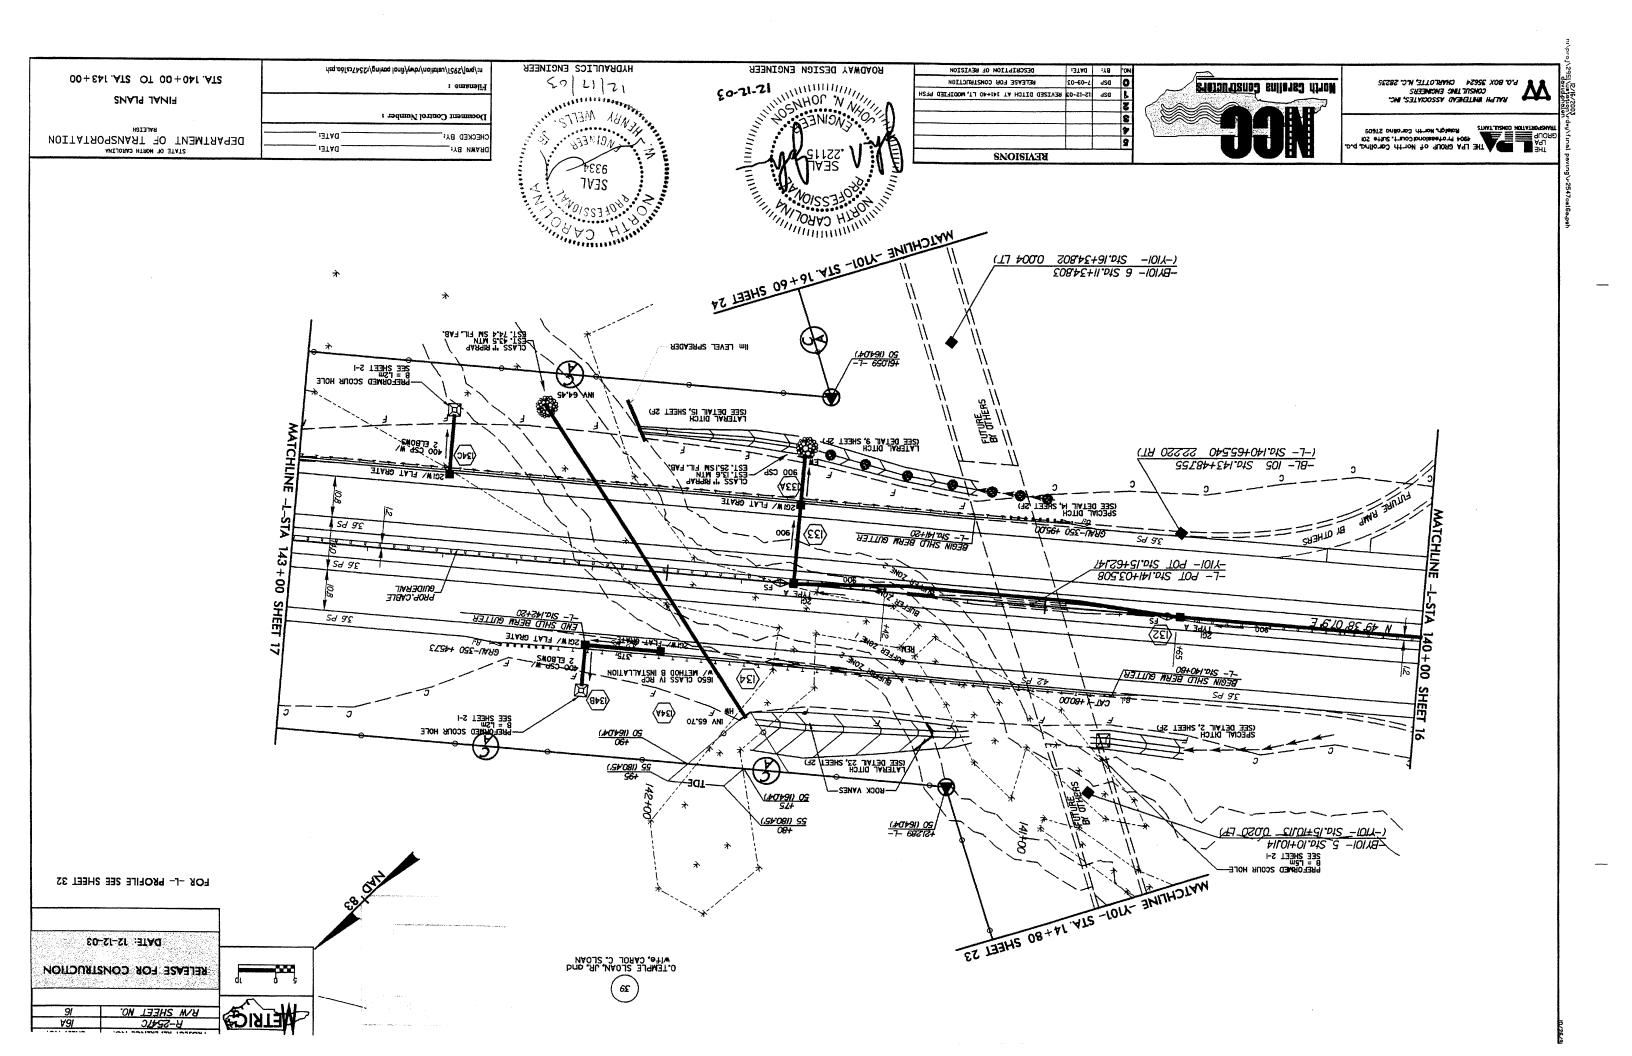


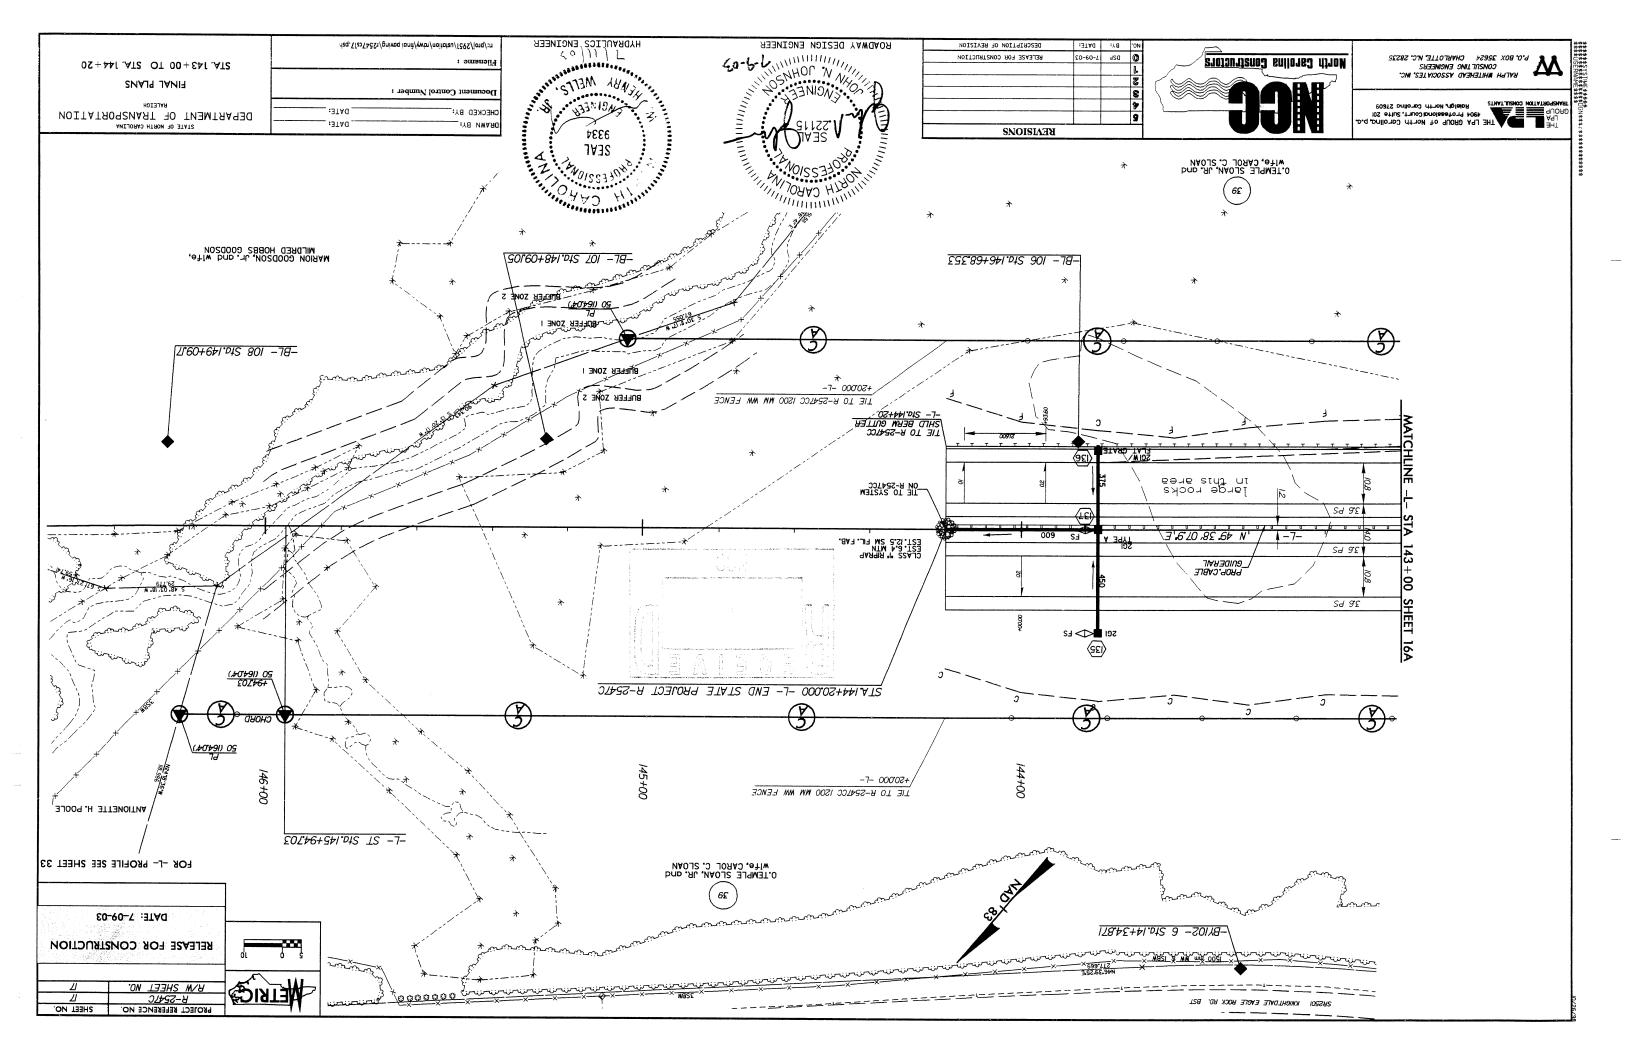


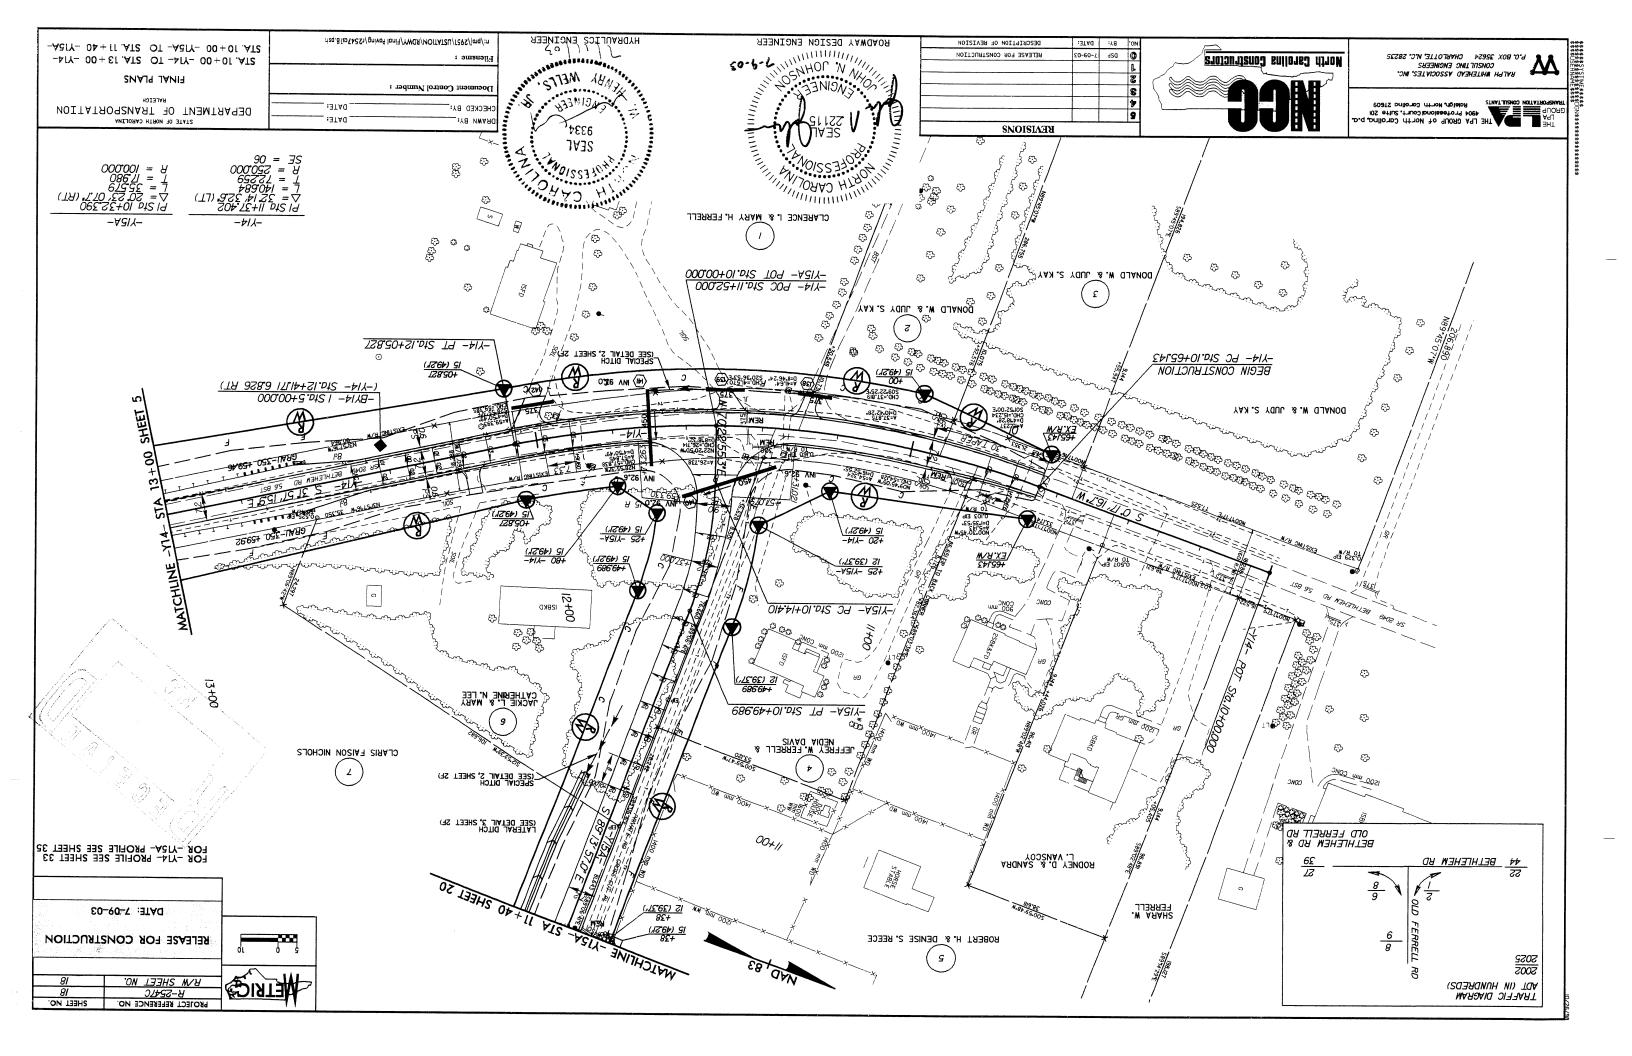


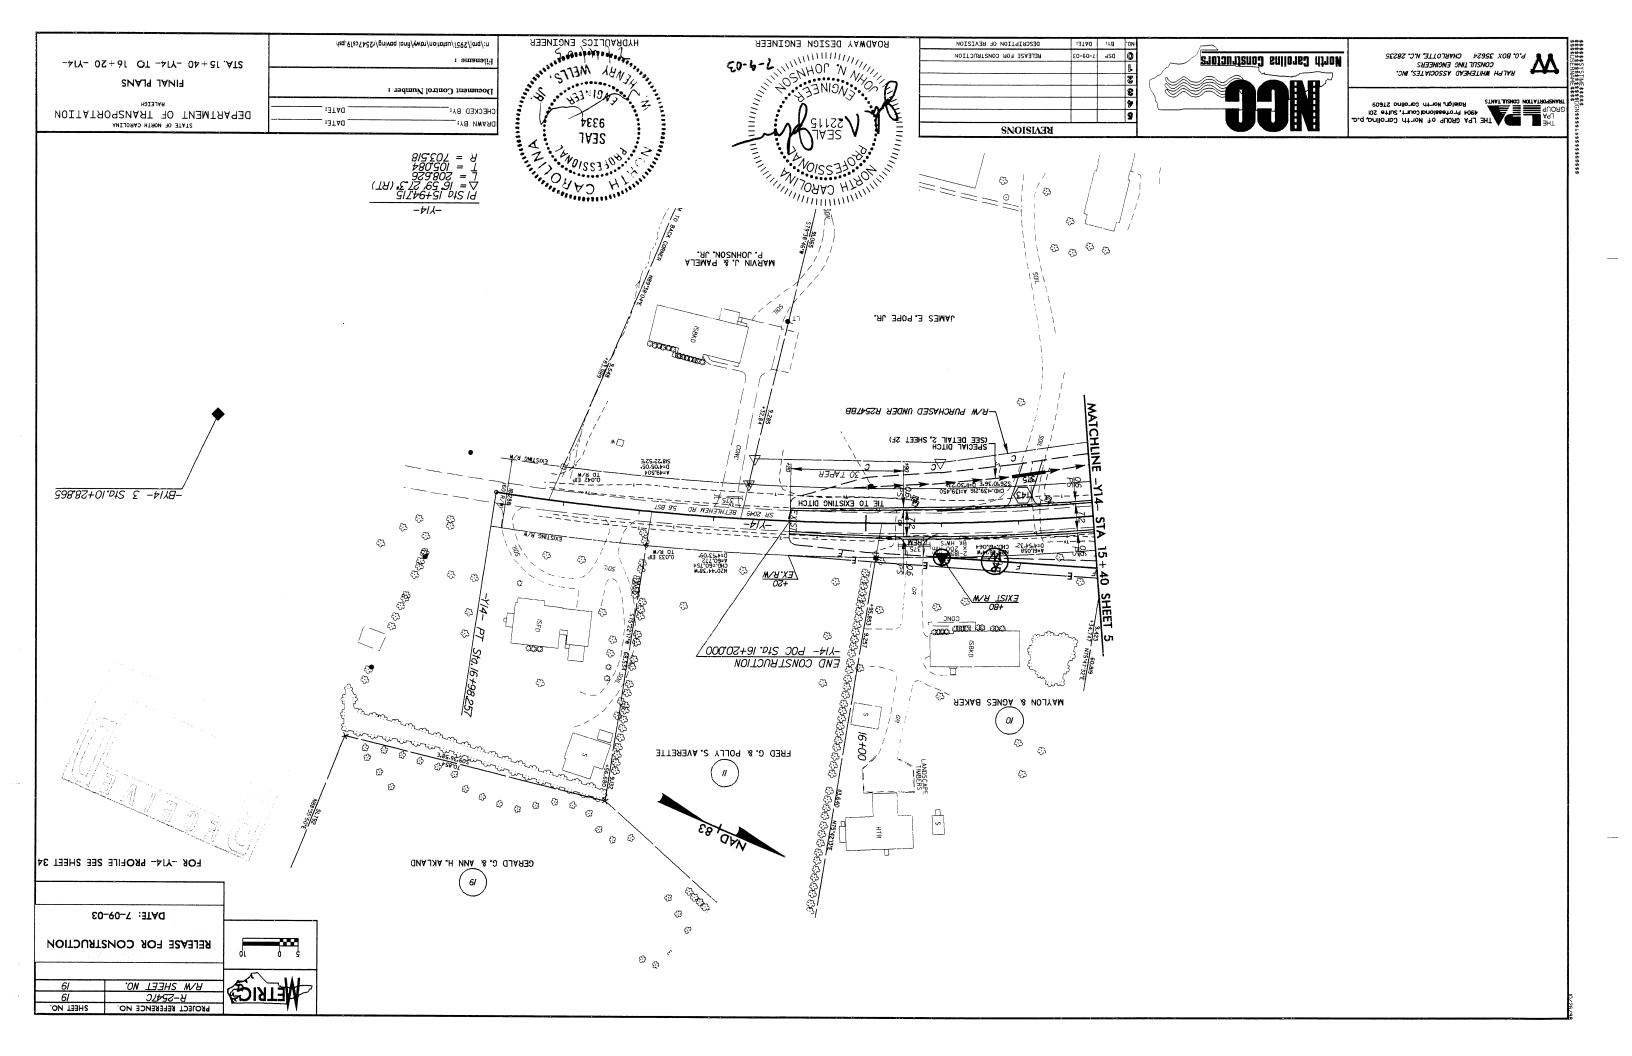


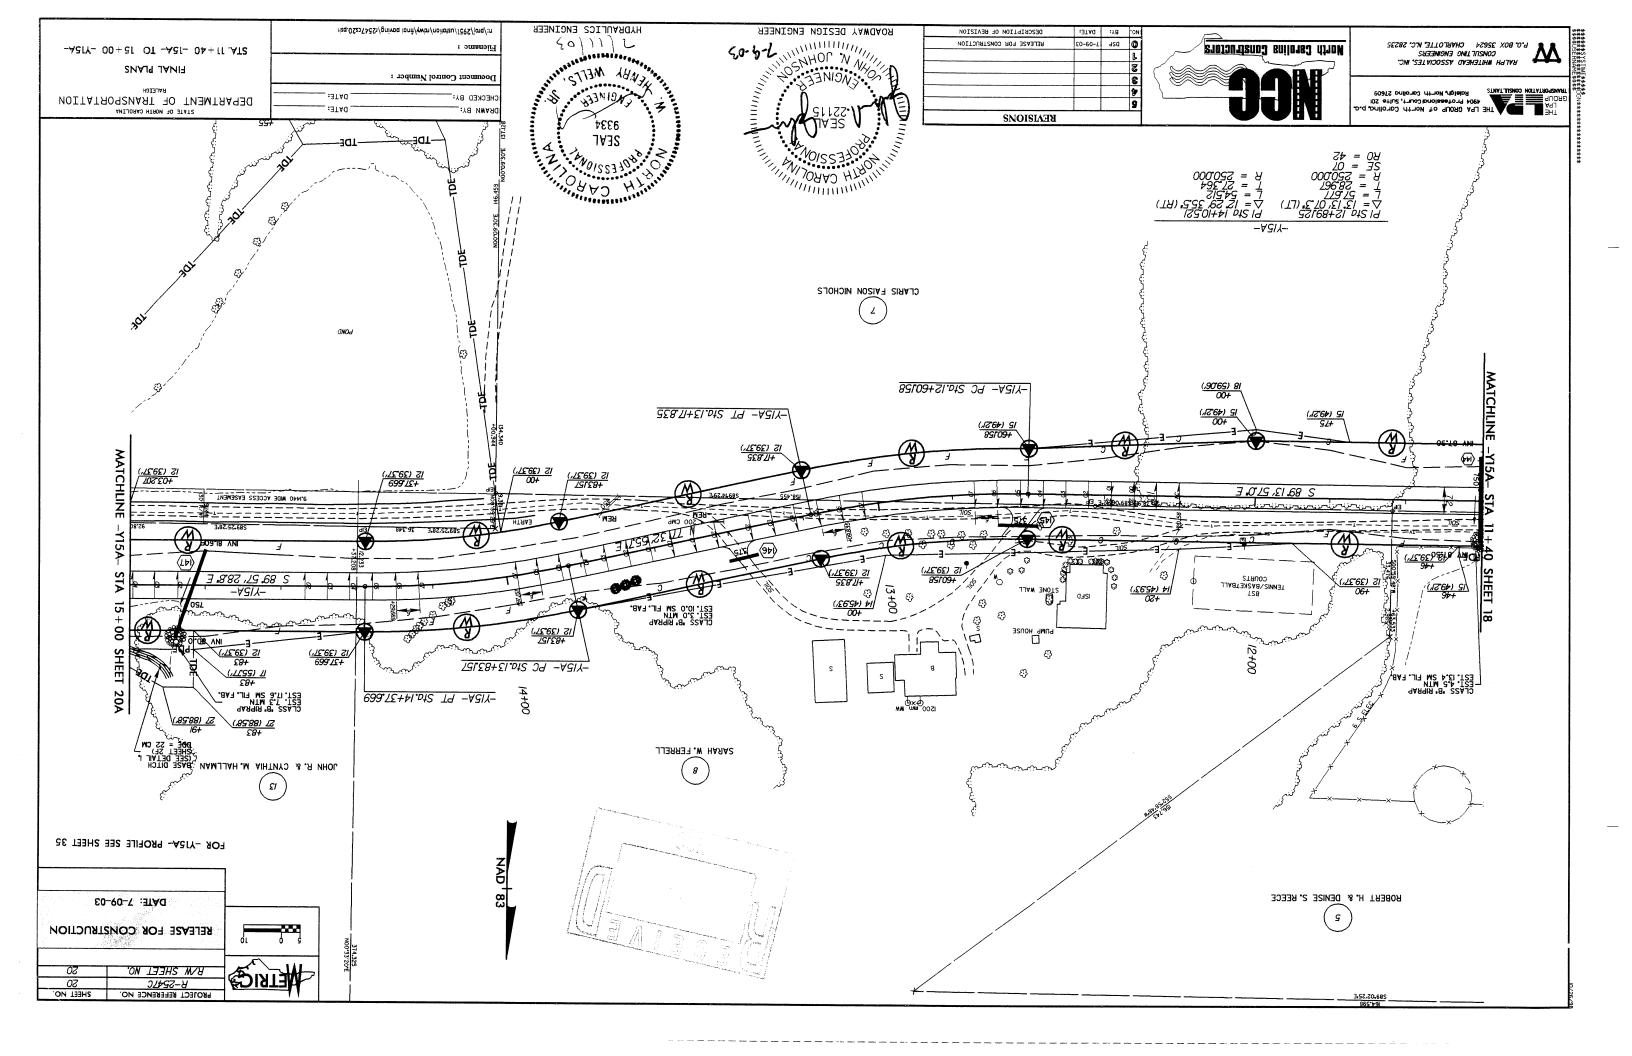


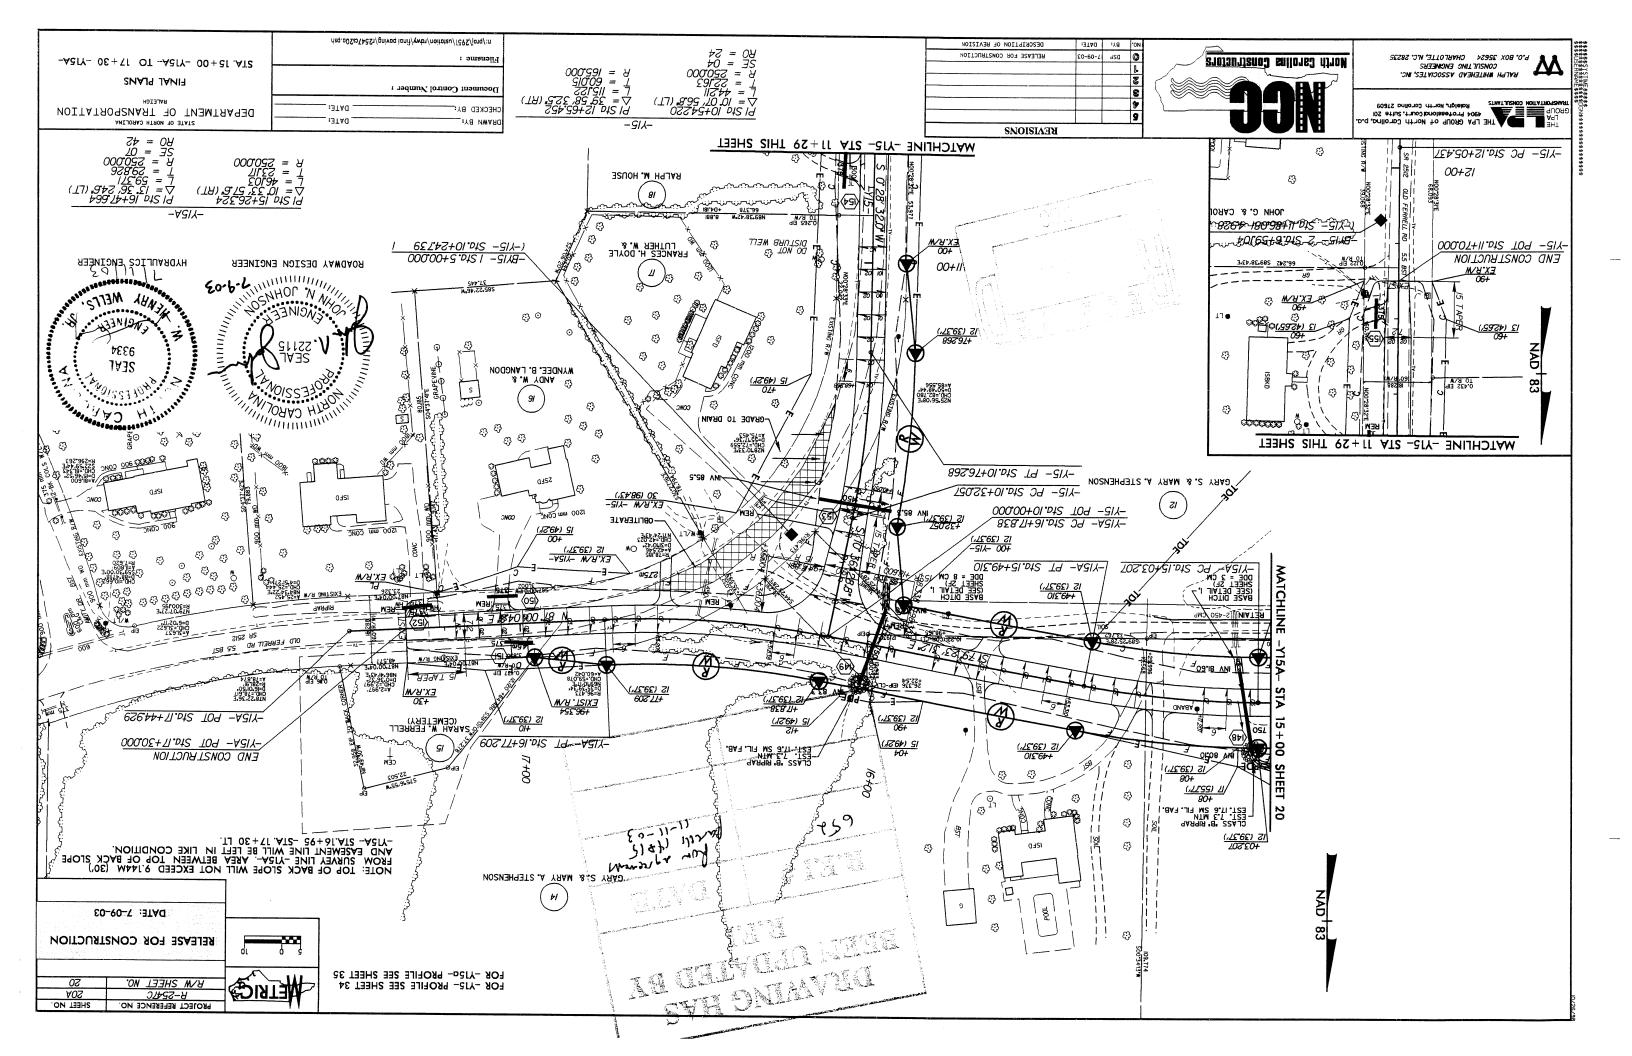


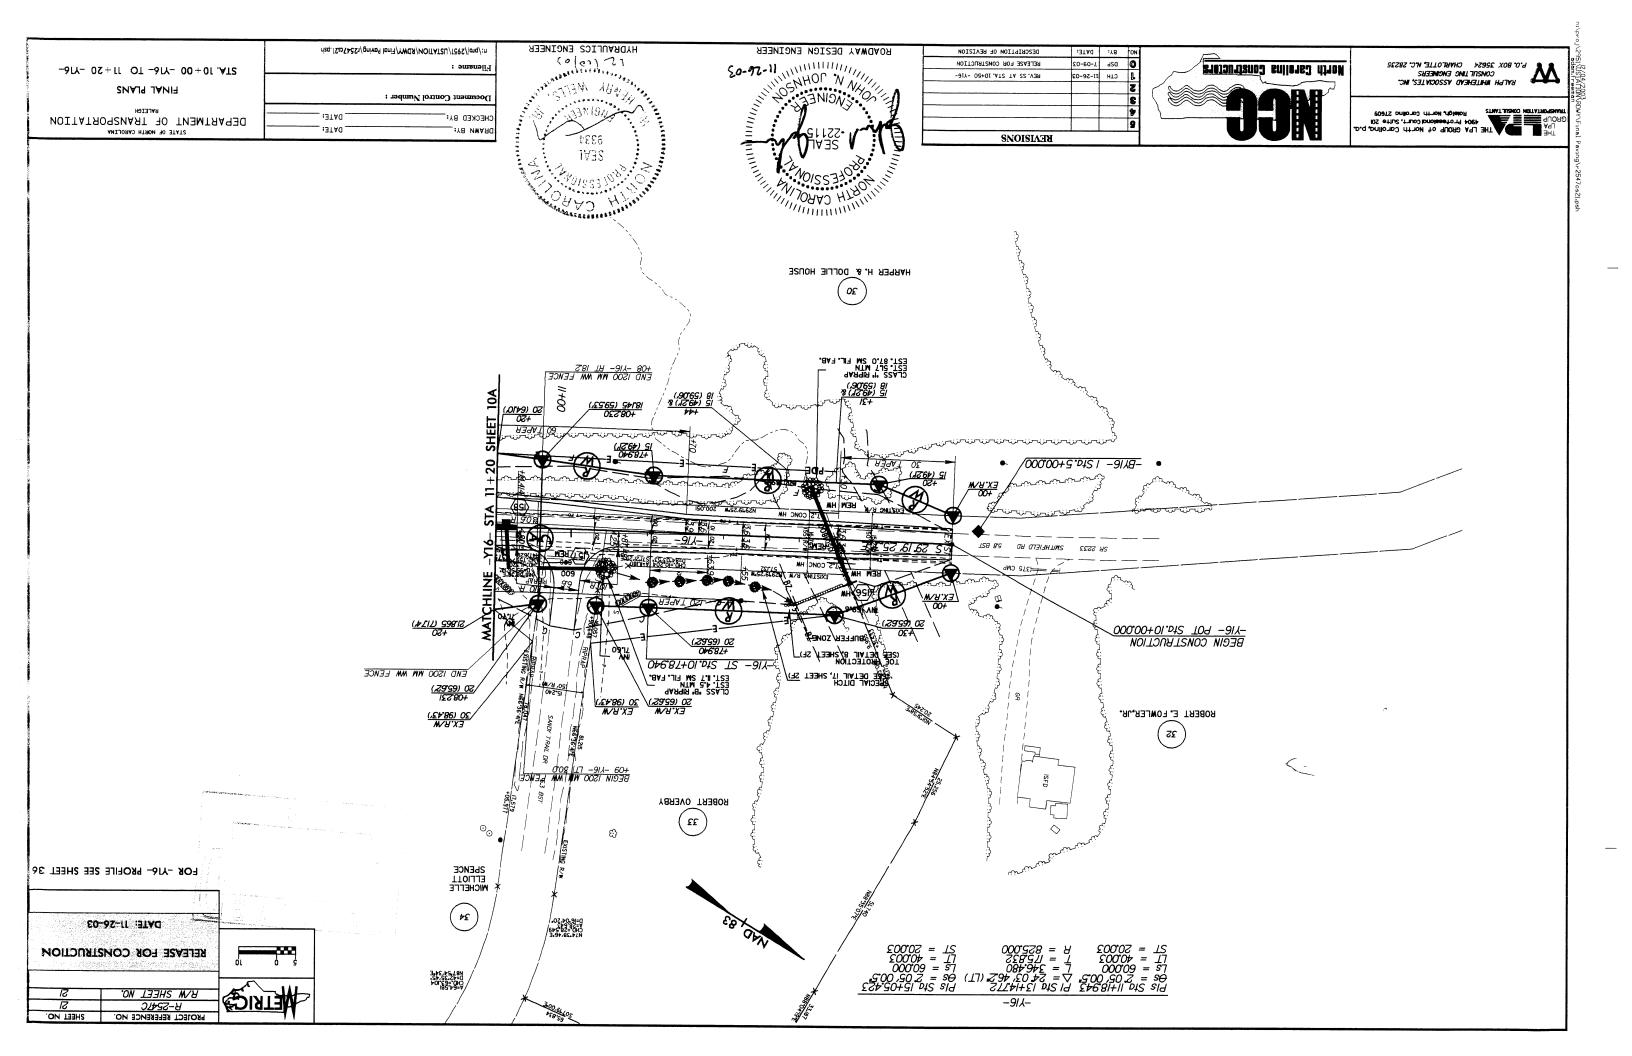

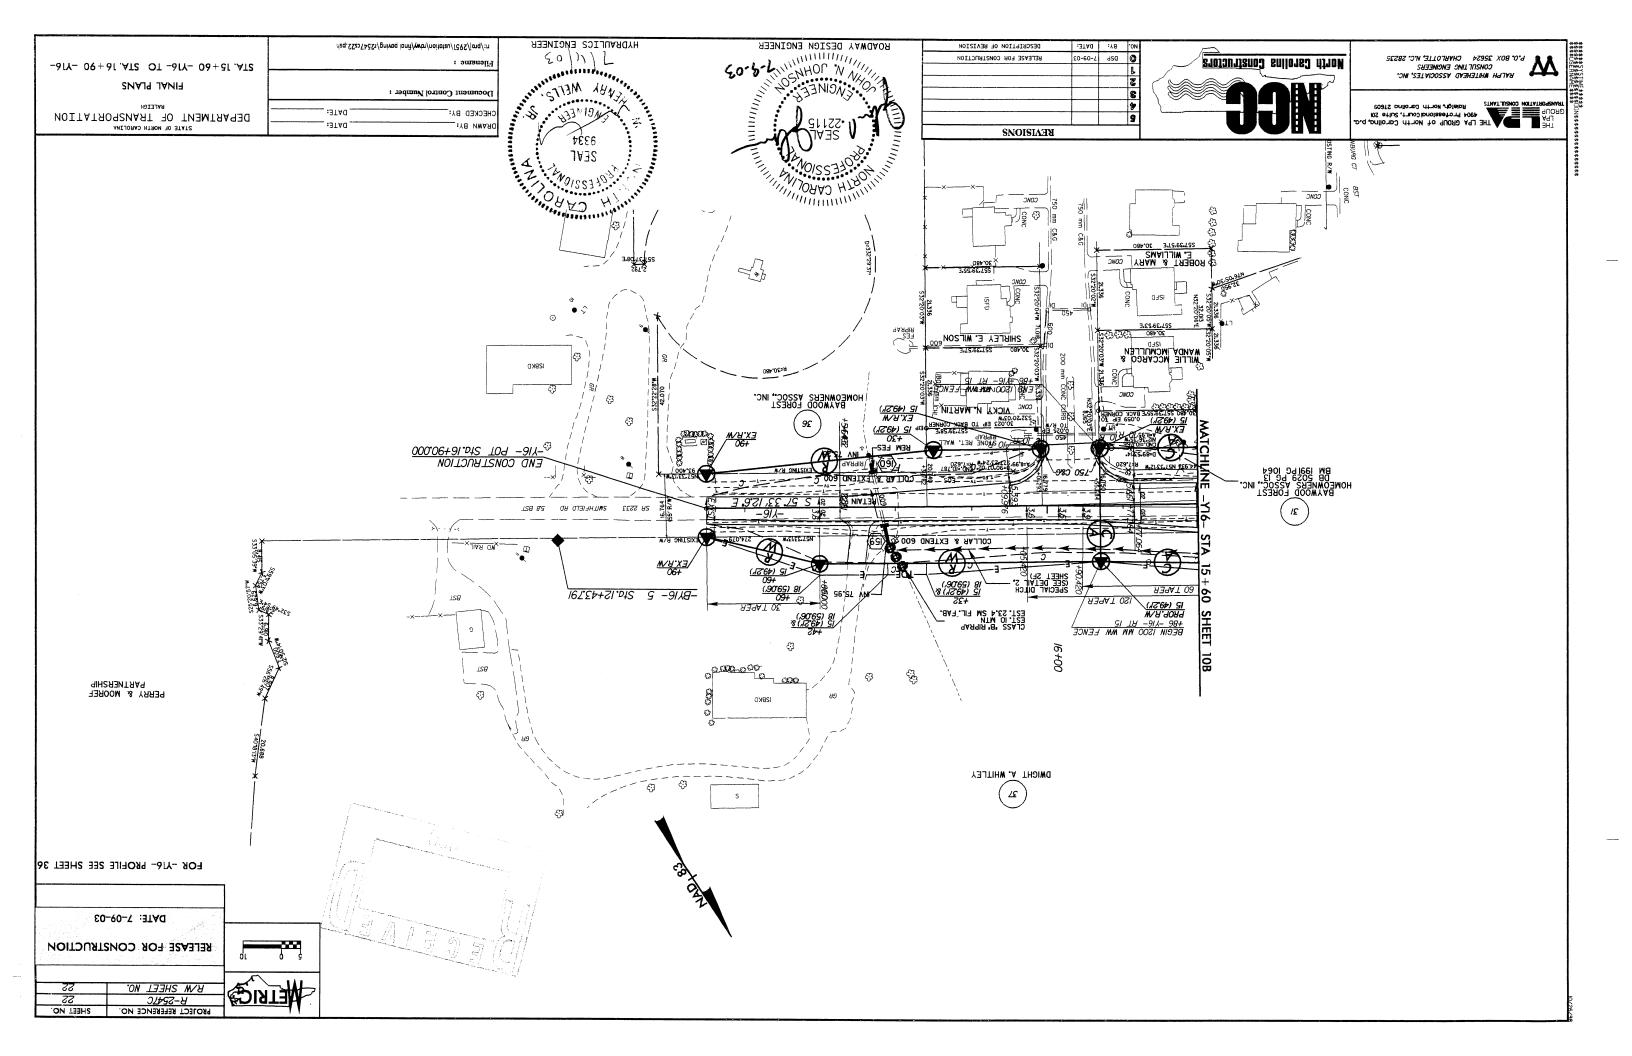

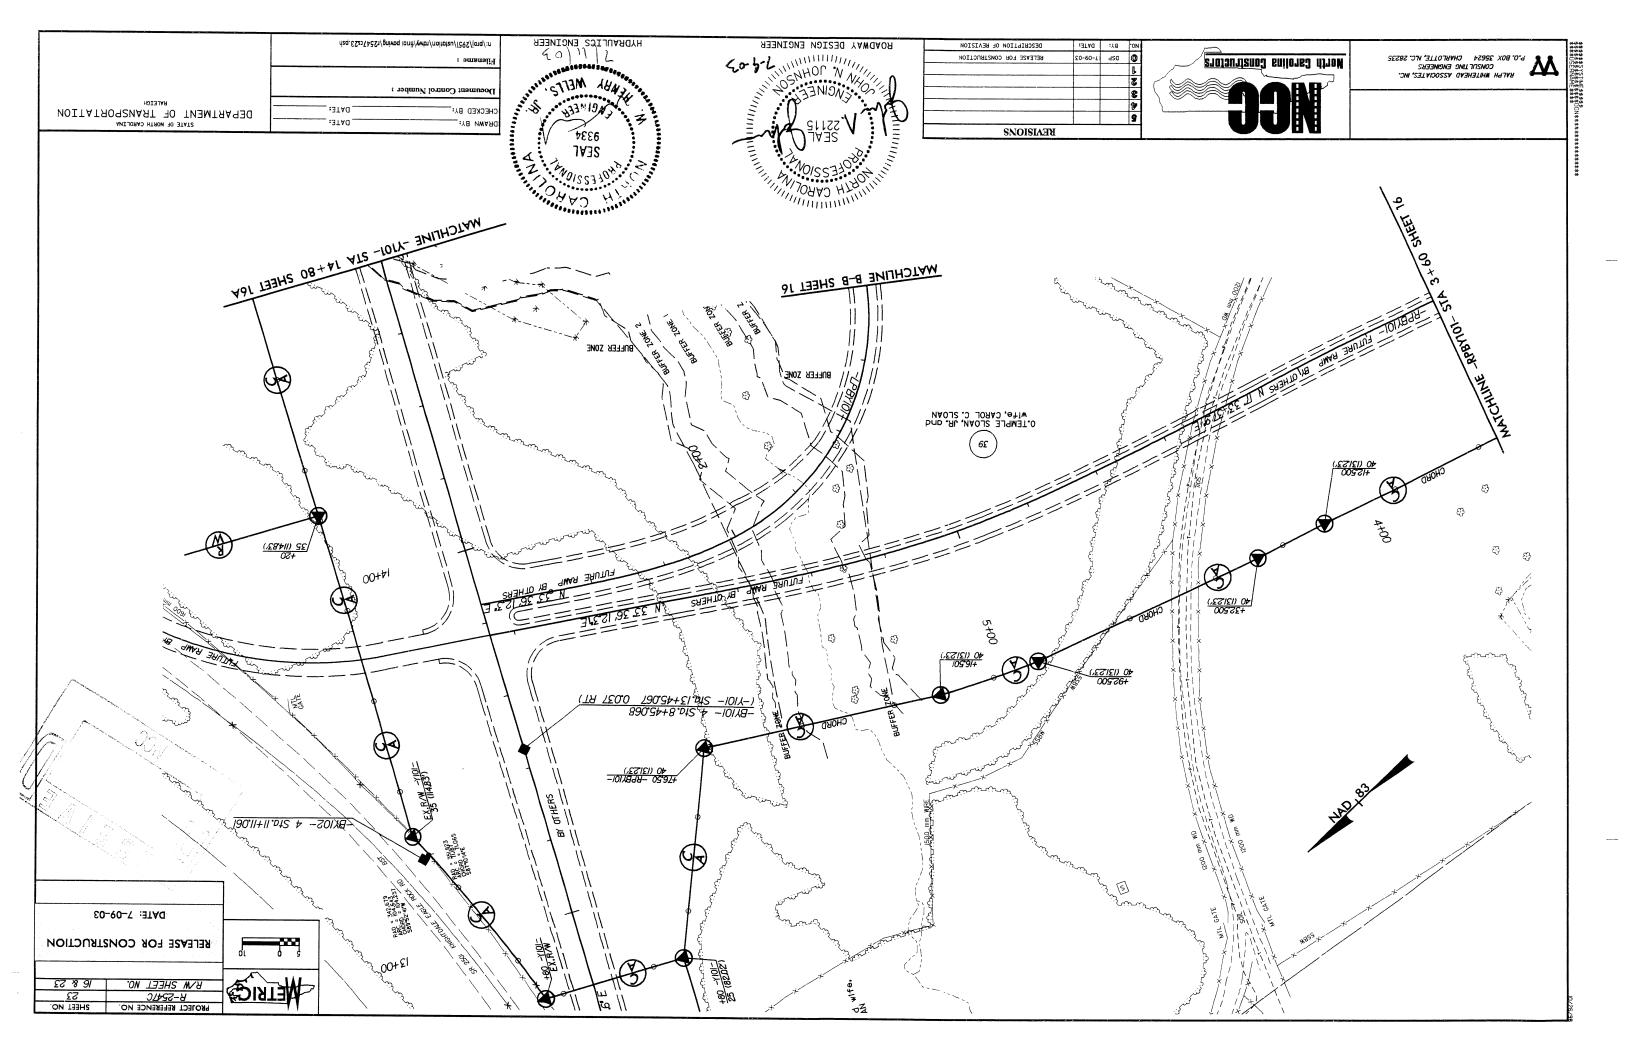

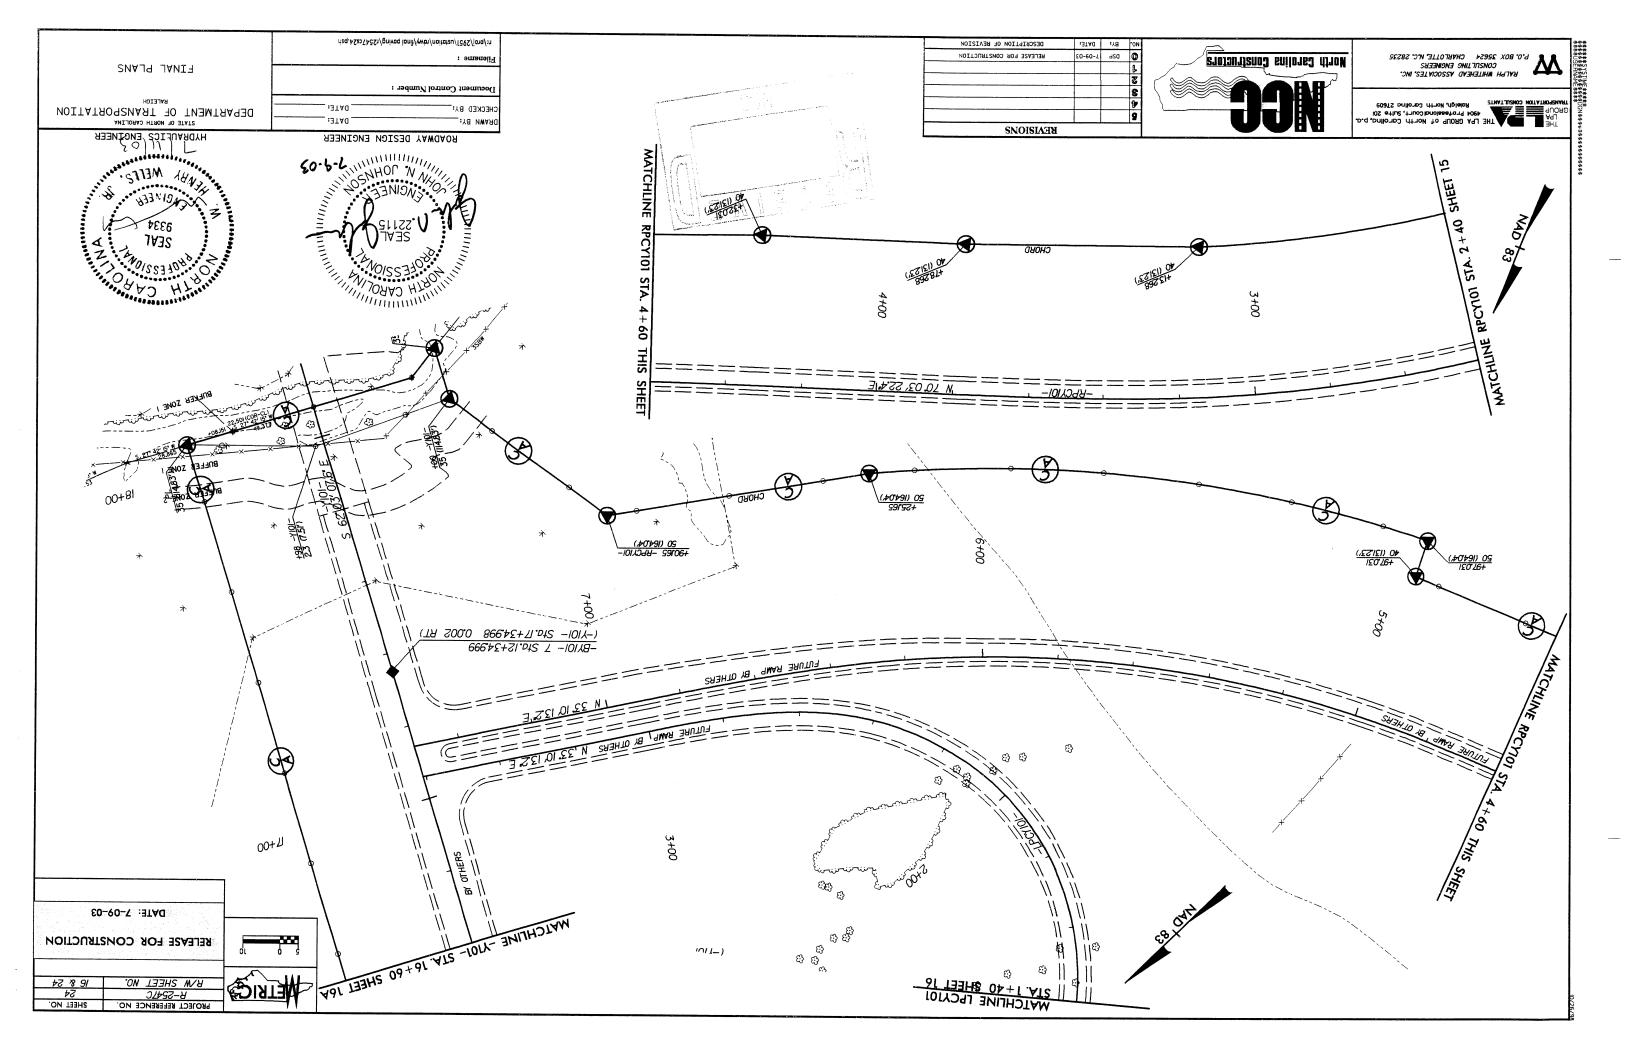

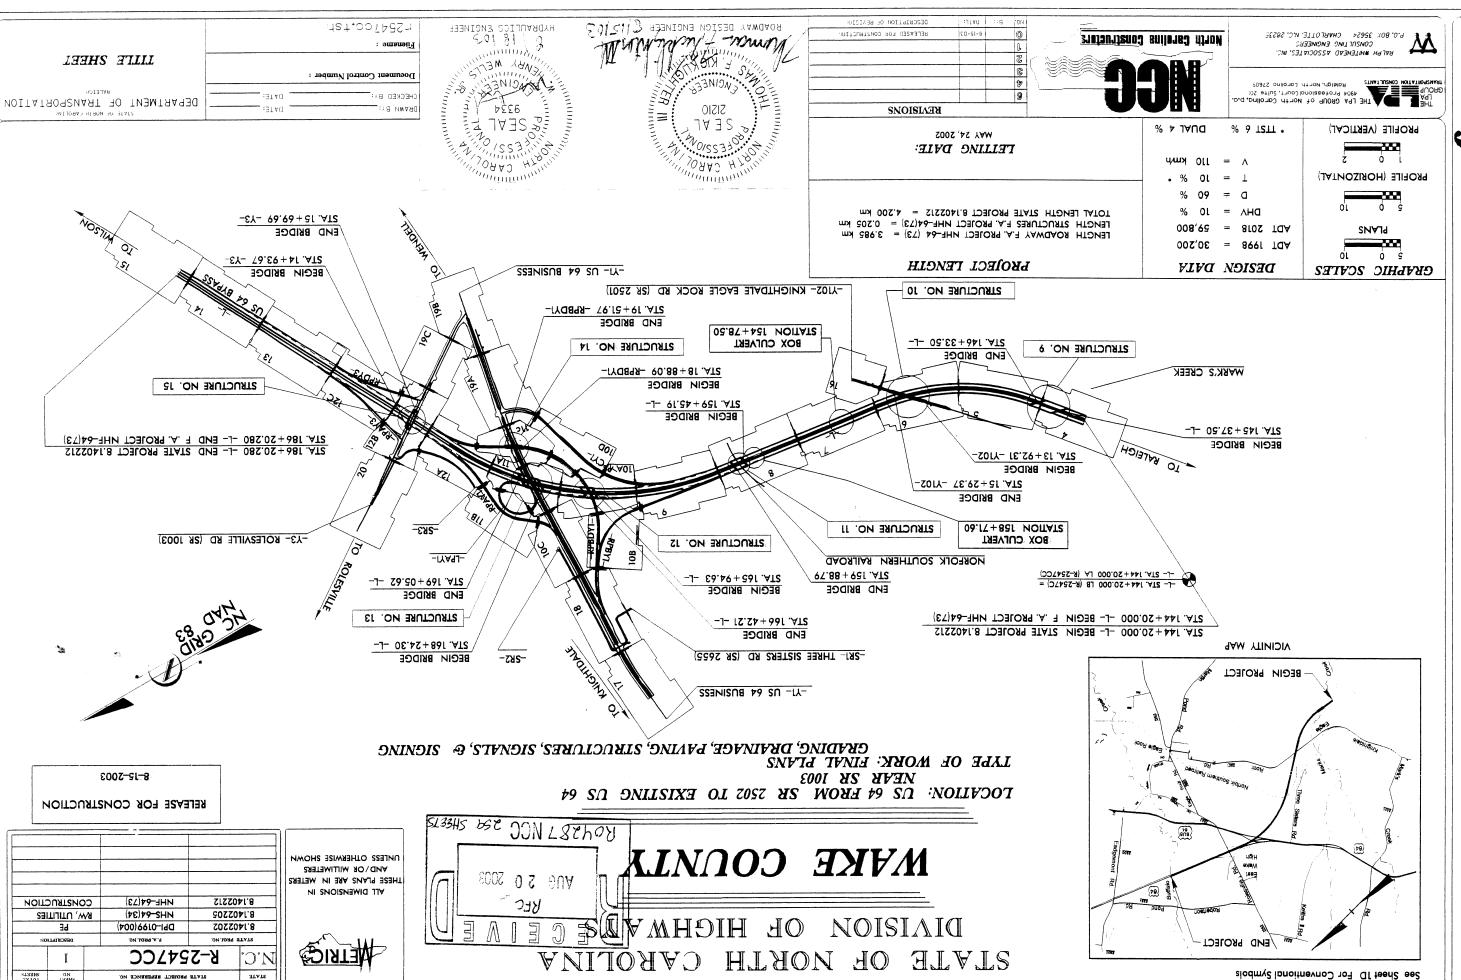

00

See Sheet 1 A For Index of Sheets

| | | | YAAI | WWNS | NOI | KEAIZ |
|------------------|--|--|------|------|-----|-------|
| * DVIE: 05-10-50 | | | | | | |

yild Jedia VICOOT VI-25-II YOO day Var Burmony sur

_ :3TA0 _

_ :3TAG _

Occument Control Number:

Filename:

CHECKED BA:

-:YB NWARO

| | | | | | | | 08-52-03 | 08-12-03 | TYPICALS | SH |
|------------------|-------------|---------------|---------------|----------------------|-----------------------|--------------------|---------------|-------------------|------------------------------------|-----------|
| | | | | | | | 08-52-03 | 08-12-03 | TYPICALS TYPICALS | SG |
| | | | | | | | 08-52-03 | 08-12 - 03 | SJA⊃I¶YT | SF |
| | | | | | ₽Ø-0I-ZØ | 12-01-03 | 08-52-03 | 08-12-03 | SJADIGYT | SE |
| | | | | 12-01-03 | 11-14-03 | 10-01-03 | 08-S2-03 | 08-12 - 03 | SJA7ITYT | SD |
| | | | | | | \$2-10 - 04 | 08-52-03 | 08-12 - 03 | SJANICALS | SC |
| | | | | 02-10-0 4 | 12-01-03 | 11-14-03 | 08-52-03 | EØ-12-8Ø | SJAJIYT | SB |
| | | | | P0-10-04 | 12-01-03 | 11-14-03 | Ø8-52-Ø3 | EØ-9I-8Ø | SJANITY | ₽Z |
| | | | | | 40-10-04 | 11-14-03 | Ø8-52-Ø3 | £Ø-9I-8Ø | TYPICALS | 7 |
| | | | | | | | | EØ-9I-8Ø | CONVENTIONAL SYMBOLS | Ωī |
| | | | | | | | | 08-12-03 | INDEX, GEN. NOTES, STDS | ıc |
| | | | | | | | | £Ø-91-8Ø | INDEX, GEN, NOTES, STDS | 18 |
| | | | | | | | | EØ-91-8Ø | INDEX, GEN. NOTES, STDS | AI |
| | | | | | | | 10-01 | 08-12-03 | INDEX OF SHEETS & REVISION SUMMARY | BEV_CC-11 |
| | | | | | | 11-14-03 | 10-01 | £0-51-80 | INDEX OF SHEETS & REVISION SUMMARY | REV_CC-1Ø |
| | | | | | | 11-14-03 | 10-01 | £0-51-80 | INDEX OF SHEETS & REVISION SUMMARY | REV_CC-9 |
| | | | | | | | | 60-51-80 | INDEX OF SHEETS & REVISION SUMMARY | REV_CC-8 |
| 1173H3 5 1A 1300 | | | | | | 11-14-03 | 10-01 | EØ-12-8Ø | INDEX OF SHEETS & REVISION SUMMARY | REV_CC-7 |
| 406,340 | | | | 11-14-03 | 10-01-03 | 60-01-6 | 60-22-80 | £Ø-51-8Ø | INDEX OF SHEETS & REVISION SUMMARY | REV_CC-6 |
| | | | | | - 11-11-83 | | 11-14-03 | 60-51-80 | INDEX OF SHEETS & REVISION SUMMARY | BEV_CC-5 |
| | | | | | 11-14-03 | 10-01 | 60-52-80 | EØ-51-8Ø | INDEX OF SHEETS & REVISION SUMMARY | REV_CC-4 |
| | | | | 12-16-03 | 11-14-03 | 10-01-03 | 60-52-80 | EØ-51-8Ø | INDEX OF SHEETS & REVISION SUMMARY | BEV_CC-3 |
| | 02-10-04 | 12-16-03 | 12-1-03 | 11-14-03 | 10-01-03 | 60-01-6 | £Ø-5Z-8Ø | 60-15-80 | INDEX OF SHEETS & REVISION SUMMARY | BEA-CC-2 |
| | | 40-01-20 | IS-16-Ø3 | 12-1-03 | 11-14-03 | 10-01-03 | £Ø-9Z-8Ø | £Ø-51-8Ø | INDEX OF SHEETS & REVISION SUMMARY | REV_CC-1 |
| | | | | | | | | 08-12-03 | TITLE SHEET | Ţ |
| СОММЕИТЅ | NO SEVISION | e BEAI2ION | 2 BEAIRION | REVISION | 3 BEAI2ION | S VEAISION | I BEAISION | OAR ∃TAO | SHEET TITLE | SHEET NO. |

| | ROADWAY DESIGN ENGINEER |
|-----------|--|
| 70/01/5.M | BODDWAY DESIGN ENGINEER SIZIO
| | MINIMU. |

| | KEAISIONS | | | T |
|---------|---------------------------|----------|-----|-----|
| | ADDED REVISION DATES | DS-10-03 | | 9 |
| L | ADDED REVISION DATES | 15-16-03 | | 8 |
| | ADDED REVISION DATES | 12-01-03 | | 1 |
| | ADDED REVISION DATES | 11-14-03 | | 8 |
| | ADDED REVISION DATES | 10-01-03 | | 2 |
| <u></u> | ADDED REVISION DATES | 8-52-03 | | D. |
| | RELEASED FOR CONSTRUCTION | 6-15-03 | | 0 |
| _ | DESCRIPTION OF REVISION | :3TAO | :78 | ON. |



THE CAROLIN OF NOrth Corolling, p.g. GROUP Of North Corolling, p.g. GROUP OF Worth Corolling 27609
TRANSPORTATION CONSULTANTS

REMAINSPORTATION CONSULTANTS

KEIEVZE ŁOK CONZIENCLION

REVISION SUMMARY

STATE OF HORTH CAROLINA
DEPARTMENT OF TRANSPORTATION
RALEIGH

PROJECT REFERENCE NO. SHEET NO.

KENIZION ZNWWYKK

| | | | | | | | | | | ~ |
|--|----------|----------|----------|-----------|-------------|----------|-------------------|----------------------|--|----------|
| | | | | | | 12-16-03 | Ø8-S2 - Ø3 | 08-12-03 | PLAN SHEET | IIB |
| | | | | \$Ø-01-ZØ | 11-14-03 | 10-01-03 | Ø8-52-03 | 08-12-03 | PLAN SHEET | AII |
| | | | | | | 12-16-03 | 08-52-03 | 08-12-03 | PLAN SHEET | 10E |
| | | | | | 40-10-0d | 12-16-03 | Ø8-55-Ø3 | 08-12-03 | PLAN SHEET | OØI |
| | | | | | | | Ø8-52-Ø3 | £0-91-80 | PLAN SHEET | 10C |
| | | | | | | | 08-22-03 | 08-12-03 | T33H2 NAJ9 | 108 |
| | | | | 12-16-03 | 11-14-03 | 10-01 | Ø8-S2-Ø3 | 08-12-03 | T33H2 NAJ9 | AQI |
| | | | | | | 69-01-60 | Ø8-S2-Ø3 | 08-12-03 | T33H2 NAJ9 | б |
| | | | | | | 12-16-03 | Ø8-S2-Ø3 | 08-12-03 | CULVERT DETAIL CONSTRUCTION SEQUENCE | (DET) |
| | | | | | 12-1-03 | 11-14-03 | Ø8-22-Ø3 | 08-12-03 | FI∃∃HS N∀7d | 8 |
| | | | | | | 12-16-03 | 08-52-03 | 08-12-03 | CULVERT DETAIL CONSTRUCTION SEQUENCE | (130) Z |
| | | | | | | 12-16-03 | 08-52-03 | 08-12-03 | T33HS NAJ9 | L |
| | | | | | 12-16-03 | 12-1-03 | Ø8-52-Ø3 | 08-12-03 | T3∃HS NAJ9 | 9 |
| | | | | 12-16-03 | 12-1-03 | 11-14-03 | 80-52-80 | 08-12-03 | T33HS NAJ9 | g |
| | | | | | 12-16-03 | 11-14-Ø3 | £Ø-5Z-8Ø | £Ø-12-8Ø | F∃∃HS NAJ9 | 7 |
| | | | | | | | | £Ø-31-8Ø | CUIDERAIL SUMMARY | 31 |
| | | | | | | | 10-01-03 | £Ø-91-8Ø | YAAMMUS JIAAQAANO | 31 |
| | | | | | | | | 08-12-03 | YAAMMUS JIAAQAAUD | ЗН |
| | | | | | | | 12-16-03 | 08-12-03 | DITCH DETAILS | 3 |
| | | | | | | | | 08-12-03 | CUARDRAIL PROTECTION FOR MEDIAN OBSTRUCTIONS DETAIL | ۹2 |
| | | | | | | | | 08-12-03 | CUARDRAIL PROTECTION FOR DUAL BRIDGE APPROACH DETAIL | S |
| Day (Marie) Committee (| | | | | | | 08-52-03 | 08-12-03 | MODIFIED CONCRETE FLUME DETAIL | NZ |
| A submission of the Control of the C | | | | | 12-16-03 | 10-01 | Ø8-52-Ø3 | 08-12-03 | PREFORMED SCOUR HOLE & LEVEL SPREADER DETAIL | MZ |
| 1 | | | | | | | Ø8-52-Ø3 | 08-12-03 | NDISƏG MASARL STREAM DESIGN | |
| | | | | | | | Ø8-52-03 | 08-12-03 | NATURAL STREAM DESIGN | |
| | | | | | | | Ø8-25-Ø3 | 08-12-03 | -Y102 DETOUR- PLAN SHEET | LZ |
| And the second s | | | | | | | Q8-S2-Q3 | 08-12-03 08-12-03 | -YIØS DETOUR- PLAN SHEET | SI |
| Communication of the Communica | L | 9 | 9 | b | 3 | 2 | J | DATE | TO IN IG -GHOTAL SMIV- | *0N |
| COMMENTS | REVISION | REVISION | BEAISION | BEAISION | BEAISION | BEAISION | REVISION | RFC | SHEET TITLE | SHEET |

ROADWAY DESIGN ENGINEER

10-01-03

15-16-03

| E REVISION | IO MOITAI | DEZCE | | :3TAQ | :YB | 10 |
|-------------|---|---|--|---|--|----------|
| ONSTRUCTION | O ROR C | RELEAS | | 8-12-03 | | 0 |
| S3TAO I | BEVISION | 0300A | | 8-52-03 | | B |
| OATE (SHEE | REVISION | ADDED | | 50-01-6 | | 2 |
| Z3TAO I | BEAIZION | 0300A | | 10-01-03 | | 8 |
| SELAG I | REVISION | 0300A | | 11-14-03 | | 1 |
| SETAO 1 | REVISION | 0300A | | 15-1-03 | | 9 |
| S3TAG I | REVISION | 030 0A | | 15-16-03 | | 8 |
| S3TAG I | REVISION | 0300A | | 05-10-0¢ | | 1 |


KEAISIONS

08-52-03

Rorth Carolina Constructors

THE LPA GROUP of North Corolling. P. A304 Professional Court, Suite 201 RAMEPORTATION CONSILEMITS ROBEIGN. North Corolling 21609

IIC

DEPARTMENT OF TRANSPORTATION

PALEIGH

RALEIGH

FDATE: 02-10-2004

RELEASE FOR CONSTRUCTION

B−2547CC REFERENCE NO. SHEET NO.

METRICE!

KEVISION SUMMARY

. BATE:

:3TAO.

Filename:

снескер ву:

-:YB WWARD

88-12-03

PLAN SHEET

enstructures constructors

THE LPA GROUP Of North Carolina, p.a.

HEADUP HOST TREEL AND STORES AND THE LPA GROUP OF NORTH CAROLING STRUCT TREASPORTATION CONSULTANTS

Releigh, North Caroling 27609

| KEAISIONS | | | |
|---------------------------|----------|------|----------|
| | | | © |
| ADDED REVISION DATES | 15-16-03 | | চি |
| ADDED REVISION DATES | 11-14-03 | | 3 |
| ADDED REVISION DATES | 10-01-03 | | 2 |
| ADDED REVISION DATES | 8-52-03 | | L |
| RELEASED FOR CONSTRUCTION | 8-12-02 | | 0 |
| DESCRIBLION OF REVISION | :3TAG | 17.8 | •ON |

| 50/91/21, | ROADWAY DESIGN ENGINEER | |
|--------------|---|---|
| 27/11/21 /20 | on lif Tomumar ! | _ |
| THE MAN VIEW | A LOW TOWN | |
| ML HIIV | STANDING STANDING | _ |
| 7 1 1 1 | NOINE STATE | |
| 3 | 三 <u> </u> | |
| - | == | |

| WITS KIDWARTS 149 J | Filename: |
|---------------------|-------------------------|
| : | Document Control Number |
| :3TAQ | CHECKED BA: |

| | yiVto Jects WCDOTV 25AT vccV dwyv en summoty sum |
|--|--|
| KENIZION ZOMMARY | Element : |
| INDEX OF SHEETS | Document Control Number: |
| DEPARTMENT OF TRANSPORTATION RALET OF TRANSPORTATION | CHECKED BX: DATE: |

| | | | | | | | 08-S2-03 | 08-12-03 | PR0F1LE | ØE |
|----------|---------------|---------------|---------------|---------------|--|---------------|---------------------------|-------------------|-------------|-----------------|
| | | | | | | | £Ø-SZ-8Ø | 08-12-03 | PROFILE | 62 |
| | | | | | | | £Ø-9Z-8Ø | 08-12-03 | PROFILE | 82 |
| | | | | | | | £0-9Z-80 | 08-12-03 | PROFILE | 72 |
| | | | | | | | £ 0- 9Z-8 0 | EØ-9I-8Ø | PROFILE | 9Z |
| | | | | | | | £ 0 -9Z-8 0 | EØ-9I-8Ø | PR0FILE | S2 |
| | | | | | | | £ 0- 9Z-8 0 | 08-12-03 | PR0F1LE | ∀⊅ Z. |
| | | | | | | | 88-S2- 0 3 | 08-12-03 | PR0F1LE | 54 |
| | | | | | | | £Ø-5Z-8Ø | 08-12-03 | PROFILE | Z3 ∀ |
| | | | | | | | 80-SZ-80 | 08-12-03 | PROFILE | 23 |
| | | | | | | | £Ø-9Z-8Ø | 08-12-03 | PROFILE | ZZ |
| | | | | | | | £0-5Z-80 | 08-12-03 | PROFILE | IZ |
| | | | | | | | £ 0- 9Z-8 0 | 08-12-03 | T33HS NAJ9 | ØZ |
| | | | | | | 11-14-03 | £Ø-SZ-8Ø | EØ-9I-8Ø | T33HS NAJ9 | J6I |
| | | | | | | | EØ-5Z-8Ø | 08-12 - 03 | FLAN SHEET | 861 |
| | | | | | | 11-14-03 | EØ-9Z-8Ø | EØ-9I-8Ø | T33HS MAJ9 | 461 |
| | | | | | | | EØ-9Z-8Ø | 08-12-03 | T3JHS MAJ4 | 18 |
| | | | | | | | 89-52-80 | 80-12-03 | T33H2 NAJ9 | ΔĬ |
| | | | | | The state of the s | | 80-52-80 | £Ø-9I-8Ø | FLAN SHEET | 91 |
| | | | | | | 15-16-03 | 08-52-03 | 08-12-03 | PLAN SHEET | 91 |
| | | | | | | 12-16-03 | £0-SZ-80 | £Ø-91-8Ø | PLAN SHEET | ÞĪ |
| | | | | | | 15-16-03 | 08-52-03 | 08-12-03 | T33HS NAJ9 | 13 |
| | | | | | | | 08-52-83 | £Ø-9I-8Ø | T∃∃HS NAJ9 | ISC |
| | | | | | 11-14-03 | 10-01-03 | £Ø-5Z-8Ø | £Ø-9I-8Ø | FLAN SHEET | 128 |
| | | | | | | | £0-9Z-80 | £0-9I-80 | T33H2 NAJ9 | ASI |
| COWWENTS | Z VEVISION | e BEAISION | ₽ BEAISION | ∀ BEAISION | 3 BEAIRION | S BEAIRION | FVISION I | PFC DATE | 371IL 133HS | NO. |

KEAISION SAWWYKK

DATE: 12-16-2003 RELEASE FOR CONSTRUCTION PROJECT REFERENCE NO. SHEET NO. SHE



THE PART OF THE LPA GROUP Of Worth Corolling p.o. GROUP OF Worth Corolling 27609

Releigh, Worth Corolling 27609

Releigh, Worth Corolling 27609

STOJOUTISMOO GONSTUCTOTS

| | | g | |
|----------|---------------------|------------------------|---|
| | | 1 | |
| 11-14-03 | | 8 | |
| 10-01-03 | | 2 | |
| 8-25-03 | | ß | |
| 20-51-8 | | 0 | |
| :3TAO | 11.9 | .ON | |

| Ξ = ! | 01212 : = = | KEAISIONS |
|---------------------|--|------------------------------------|
| <i>≟</i> ⊅ : | 1000 | |
| | SOUNCINEE | 36-x 88-x x8-x daddy / 8-x das1v3d |
| | | BEAIZED X-S \ VODED X-SVX-SB*X-SC |
| | HIN I OUT | ADDED REVISION DATES |
| Cinarana M / A | THE THE PARTY OF T | ADDED REVISION DATES |
| 1 | 1.00000000 | BELEASED FOR CONSTRUCTION: |
| ENCINEER | ROADWAY DESIGN E | DESCRIBLION OF REVISION |

| wnskiowa | YAPTO JACISANCDOTV -2547/octvomyvav.sum |
|----------|---|
| | Ніспятьс : |
| | |
| | Document Control Number: |

| INDEX OF SHEETS AND | |
|------------------------------|--|
| DEPARTMENT OF TRANSPORTATION | |

| | with comments with the | 240/342-2/1007MAINGINGAX | | |
|--|------------------------|--------------------------|-------------|----------------------|
| KEVISION SUMMARY | | Ейепате : | 50/6/11 | Townson A Thirty Man |
| INDEX OF SHEETS | et : | Document Control Numb | 67, VI 11 | WEINER WEINER |
| DEPARTMENT OF TRANSPORTA STATE OF NORTH CAROLINA RALETCH | .3TAQ .3TA() | CHECKED BJ: DBVMN BJ: | | OIZIZ VO/SE300 A |
| | | | | "THINITIAL |

| | | | | | | | 10-01-03 | 08-12-03 | CBOSS SECTIONS | 6-X |
|--|---------------|---------------|---------------------------------------|---------------|---|---------------|-------------------|-------------|---------------------|--------------|
| | | | | | | | | 08-12-03 | CBOSS SECTIONS | 8-X |
| | | | | | | | | 08-12-03 | CBOSS SECTIONS | ∠-X |
| | | | | | i | | | 08-12-03 | CBOSS SECTIONS | 9-X |
| | | | | - | | | | 08-12-03 | CBOSS SECTIONS | G-X |
| | | | : | | | | 08-52-03 | 08-12-03 | CBOSS SECTIONS | 炒 −X |
| | | | · · · · · · · · · · · · · · · · · · · | | | | | 08-12-03 | CBOSS SECTIONS | X-3 |
| | | | | | | | | 11-14-03 | CBOSS SECTIONS | X-2C |
| | | | | | | | | 11-14-03 | CROSS SECTIONS | X-28 |
| | | | | | | | | 11-14-03 | CBOSS SECTIONS | AS-X |
| | | | | | | | 11-14-03 | 08-12-03 | CROSS SECTIONS | Z-X |
| | | | | | | | | 12-03 | CBOSS SECTIONS | I-X |
| | | | | | | | | 08-12-03 | CBOSS SECLION INDEX | 94 |
| | | | | | | | 08-S2-03 | 08-12-03 | PROFILE | ÞÞ |
| | | | | | | | 08-22 - 03 | 08-12-03 | PROFILE | 43 |
| | | | | | 1 | | 88-25-03 | 08-12-03 | PROFILE | 74 |
| | | | | | | ! | £Ø-S2-80 | 80-12-03 | PROFILE | ĪÞ |
| | | | | | | | £0-9Z-80 | 80-12-03 | PROFILE | 0 † |
| | | | | | | | 08-52-03 | 08-12-03 | PR0F1LE | 68 |
| | | | | | | | 08-25-03 | 60-51-80 | PROFILE | 38 |
| | | | | | le de la companya de | | 89-52-80 | 08-12-03 | PROFILE | 2٤ |
| A CONTRACTOR OF THE CONTRACTOR | | | | | | | 08-52-03 | 08-12-03 | PROFILE | 49€ |
| The date of register comments control for consistent states? | | | | | | | 08-52-03 | 08-12-03 | PROFILE | 36 |
| | | | | | | £ | 08-S2-03 | EØ-9I-80 | PROFILE | 32 |
| | | | | | · | | 08-52-03 | 08-12-03 | PR0F1LE | 34 |
| | | | | | *** | | 08-52-03 | 08-12-03 | PROFILE | 33 |
| | | | | | | | £Ø-5Z-8Ø | 88-12-03 | PROFILE | 35 |
| A MAN AND AND AND AND AND AND AND AND AND A | | | | | 1 | | £Ø-5Z-8Ø | £0-91-80 | PROFILE | 31 |
| COMMENTS | Z KEAI2ION | e BEAISION | 2 BEAISION | # BEVISION | 3 BEAISION | S BEAISION | I BEAISION | DAR ETAO | SHEET TITLE | NO. SHEET |

KEAISION 20MWARK

| | · |
|--------------------------|--------------|
| DATE: 11-14-2003 | |
| RELEASE FOR CONSTRUCTION | |
| | |
| 4-77-17H 7714CZ-4 | WALL BILLING |

PROJECT REFERENCE NO. SHEET NO.

KELIZION ZIMWYKI

| DATE: 11-14-2003 | | | | | MOIS | KEAI | | | | |
|--|----------|----------|---------------|--|---|--|--|--------------------|----------------|--------------|
| COMMENTS | REVISION | BEAISION | P BEAISION | d BEAIZION | 3 BEAISION | S BEAISION | I BEAI210N | STA 3TAQ | SHEET TITLE | NO. |
| | | | | | | and particular and a second and | | 80-12-03 | CROSS SECTIONS | Ø1-X |
| | | | | | | | | 08-12-03 | CROSS SECTIONS | 11-X |
| and the first of the second se | | | | | | | | 80-12-03 | CBOSS SECTIONS | SI-X |
| | | | | | | | | : : 0-91-80 | CBOSS SECTIONS | £I-X |
| | | | | 17 | 4 1 1 M | | | | CROSS SECTIONS | ⊅ [-X |
| | | | | | | • | | EØ-12-80 | CROSS SECTIONS | 9I-X |
| | | | • | | | | | EØ-GI-8Ø | CBOSS SECTIONS | 9I-X |
| | | | | | | | | £ 0 -51-80 | CBOSS SECTIONS | |
| | | | | - 1 ··· · · · · · · · · · · · · · · · · | ÷ · | | : | 80-91-80 | CROSS SECTIONS | 8I-X |
| | | | | | | | , | 80-91-80 | CBOSS SECTIONS | 6I-X |
| | | | | in the second se | | | • | £0-91-80 | CBOSS SECTIONS | ØZ-X |
| | | | | | | | i · | 60-51-80 | CROSS SECTIONS | IZ-X |
| and the second s | | | | | | • | for the second of the second o | 08-12-03 | CROSS SECTIONS | ZZ-X |
| | | | | | | | | £0-9I-80 | CROSS SECTIONS | X-23 |
| | | | | • | • · · · · · · · · · · · · · · · · · · · | • | | 11-14-03 | CBOSS SECTIONS | A£S-X |
| | | : | | *** | | | | 11-14-03 | CBOSS SECTIONS | X-23B |
| | | | | | | | | 11-14-03 | CROSS SECTIONS | X-23C |
| | | i | | | | | | 11-14-03 | CBOSS SECTIONS | Z-Z3D |
| | | | | | 1 | | | 11-14-03 | CBO22 SEC11ONS | X-23E |
| | | | | | | | 11-14-03 | £0-91-80 | CROSS SECTIONS | |
| | | | | | | | | £0-91-80 | CROSS SECTIONS | 27-X |
| | | | | | | | | £0-91-80 | CROSS SECTIONS | 9Z-X |
| | | | | • | 1 | | | £0-9I-80 | CROSS SECTIONS | ZZ-X |
| | | | | 1 | | | | : : :0-91-80 | CBOSS SECTIONS | 8Z-X |

Eoft Do I

| , BOADWAY DESIGN ENGINEER | |
|--|---|
| MINITED TO THE STATE OF THE STA | |
| TO A TOWN SON WINDS | |
| ming Shirt | |
| NOINE CONTRACTOR | |
| 11184.8 | - |
| 1 / 三书: 01717 注言 | - |
| E OIZIZ F E | |
| = : . 7 \ 7 \ . : = | L |
| 5 · 1 · 1 · 2 · 2 · 5 | |

| DESCRIBITION OF BEALSTON | :3140 | 114 | 100 |
|-------------------------------------|----------|-----|-----|
| BETEVARN BOB CONZIBULITOR | 8-15-03 | | 0 |
| MDDED V-DBMIX-SBMIX-SBC1X-SBD1V-SBE | 11-14-03 | | ß |
| | | | 3 |
| | | | 3 |
| | | | 箩 |
| | | | G |
| KEAISIONS | | | |

| Stolina Constructors | 9440 |
|---|------|
| (A A A A A A A A A A A A A A A A A A A | H |
| JUR | |

| LPA GROUP of North Carolina, p.a. 4904 Professional Court, Suite 201 Raleigh, North Carolina 27609 | |
|--|--|

BN

CBOSS SECTIONS

CBOSS SECTIONS

CBOSS SECTIONS

CROSS SECTIONS

CBOSS SECTIONS

CBOSS SECTIONS

80-12-03

EØ-9I-8Ø

89-12-03 89-12-03

60-21-80

89-11-80

≯£-X

££-X ZE-X

18-X

Ø€-X

6Z-X

RELEASE FOR CONSTRUCTION

P-2547CC REFERENCE NO. SHEET NO.

DEPARTMENT OF TRANSPORTATION

North Carolina Constructors

| DESCRIBIION OF REVISION | :BIA() | 178 | •01 |
|----------------------------------|----------|-----|-----|
| RELEASED FOR CONSTRUCTION | 8-15-03 | | 0 |
| ADDED REVISION DATES | E0-22-8 | | 0 |
| ADDED REVISION DATES (X-37) | 8-10-03 | | 3 |
| ADDED REVISION DATES (X-49) | 10-01-03 | | 8 |
| REVISED X-36 AND X-39E AND X-39E | EO-41-11 | | Û |
| | | | g |
| | | | |

| BEAISIONS | | | |
|---|----------|-----|--|
| | | | |
| REVISED X-36 AND X-39C AND X-39ETHRUY-39E | 20-41-II | | |
| PDDEN REVISION DATES (X-49. | 10-01-03 | | |
| (YE-X) SƏTAO MOISIVƏR GƏDDA | 9-10-03 | | |
| ADDED REVISION DATES | 8-25-03 | | |
| RELEASED FOR CONSTRUCTION | 8-15-03 | | |
| DESCRIPTION OF REVISION | :3140 | :78 | |

| | BOADWAY DESIGN ENGINEER |
|--------------|-------------------------|
| E0/41/11 Lor | and the second |
| the my the | NCINEE |
| # 1119 | EE OIZIZ EE |
| | ₹ ZYASS |

| P10]0038MCD0TV254TvcVv | YAPPO JOCK SANCEOOTV -2547 VOCA | wnskiowa |
|------------------------|---------------------------------|----------|
| ume : | Filename : | |
| ament compos tagen | | |
| d | Document Control Numi | |
| | Dogument Control Number | :3TAO |

| ВЕЛІГІОМ РОММАВЬ | і јелише : |
|---------------------------------------|-------------------------|
| INDEX OF SHEETS | оспиен: Сопиој Литрет : |
| DEPARTMENT OF TRANSPORTATION RALEIGH | NAM BY: DATE: |

| RELEASE FOR CONSTRUCTION DATE: 11-14-2003 | 9 | G | b FEVISION | 3 BEAIZION | S BEAISION | 08-52-03 I BENIZION | PFC DATE 08-15-03 | CROSS SECTIONS | X-3∑ NO. X-3∑ |
|--|---|--|--|---------------|--|--|-------------------|----------------|---------------------|
| | | | | | | | 11-14-03 | CBOSS SECTIONS | X-35A |
| COMMEN1S | | | | | | | 11-14-03 | CBOSS SECTIONS | X-32B |
| | | | | | | | 11-14-03 | CBOSS SECTIONS | X-32C |
| | | The state of the State of the s | The state of the s | | 11-14-03 | 89-SZ-80 | 08-12-03 | CBOSS SECTIONS | 9E-X |
| | | The second secon | | | | 60-01-60 | 08-12-03 | CROSS SECTIONS | X-37 |
| | | | | | MARK | | 08-12-03 | CBOSS SECTIONS | 8E-X |
| | A7 (\$6.00) and a 4.00 (\$1.00) and \$1.00 (\$1.00) | A STATE OF THE STA | | | any an | | 08-12-03 | CBO22 SECTIONS | 9£-X |
| | | A STATE OF THE STA | 1/4/00 | | mag commercial and an arrangement of the second | | 11-14-03 | CBO22 SECTIONS | APE-X |
| | - | A CONTRACTOR OF THE PARTY OF TH | | | | | 11-14-03 | CBO22 SECTIONS | X-39B |
| | AND DESCRIPTION OF THE PROPERTY OF THE PROPERT | The second secon | Maria (A | | | | 11-14-03 | CBOSS SECTIONS | X-39C |
| | | Authorities of the control of the co | | | garangenorous com a service de la companya de la co | | 11-14-03 | CBO22 SECTIONS | 06E-X |
| | | | 11 11 11 11 11 11 11 11 11 11 11 11 11 | | | | 11-14-03 | CBOSS SECTIONS | X-39E |
| | | | | | | 11-14-03 | 88-12-03 | CBOSS SECTIONS | Ø≠-X |
| | and the second of the second o | | | | | | 80-12-80 | CBOSS SECTIONS | Į ≯- X |
| | THE STREET | | | | pa - 1200 | | EØ-9I-80 | CBOSS SECTIONS | Z+-X |
| | | (0.00 0.000) | | | | | 89-12-83 | CBOSS SECTIONS | X-43 |
| | The same of the sa | | | | The second secon | | 08-12-03 | CBOSS SECTIONS | ▶† -X |
| | | | ************************************** | | | | 88-12-03 | CBOSS SECTIONS | S ≯- X |
| | A STATE OF THE PARTY OF THE PAR | | | | | | £0-51-80 | CROSS SECTIONS | 9 † -X |
| | A 1 1 1 1 1 1 1 1 1 1 1 1 1 1 1 1 1 1 1 | Age and agency and a second se | | | | A 1 (1986) N 101 (111 111 111 111 111 111 111 111 11 | £0-12-03 | CBOSS SECTIONS | ∠ <i>p</i> -X |
| | * (*********************************** | THE RESERVE THE PROPERTY OF TH | | | The same states and the same states are same states are same states and the same states are sa | | 08-12-03 | CBOSS SECTIONS | 8 t -X |
| | Mark Commence of the Mark Commence | The state of the s | | | | 10-01-03 | 08-12-03 | CROSS SECTIONS | 6 4- X |
| | | 118 (188) 1 · · · · · · · · · · · · · · · · · · | the state of the s | | 779. NO. 100. | 08-12-03 | CROSS SECTIONS | ØG-X |
| | | | | ORMAN | | | 08-12-03 | CBOSS SECTIONS | ĬĞ-X |
| | | | The second section of the section of the sect | | | | 08-12-03 | CBOSS SECTIONS | X-52 |
| | | Mark 198 | | | | | 08-12-03 | CBOSS SECTIONS | F2-X |
| | | | | | | | 08-12-03 | CBOSS SECTIONS | ₽⊆ -X |
| | | and the second s | | | | | 08-12-03 | CBOSS SECTIONS | X-22 |
| | | | | | | | 08-12-03 | CBOSS SECTIONS | 9 2 -X |
| | | | | | | | 08-12-03 | CBOSS SECTIONS | ∠g-X |
| | | | | | | | 08-12-03 | CBOSS SECTIONS | X-58 |
| | | | | | | | 08-12-03 | CBOSS SECTIONS | 6 G -X |

KENIZION ZNWWYKŁ

North Carelina Constructors

88-12-03

J∓A ∃TAO

CBOSS SECTIONS

SHEET TITLE

Ø9-X

SHEET NO.

| DESCRIBLION OF REVISION | :3140 | ::8 | ON. |
|--------------------------------------|----------|-----|-----|
| RELEASED FOR CONSTRUCTION | 8-12-03 | | 0 |
| SEVISION DATES | £0-10-01 | | B |
| ADDED X-63A, X-63B X-63C / REV. X-83 | 11-14-03 | | 8 |
| | | | 8 |
| | | | P |
| | | | g |

| KEAISIONS | | | |
|------------------------------------|----------|-----|-----|
| | | | g |
| | | | b |
| | | | 3 |
| 88-X VBB \ DE8-X 888-X 488-X GBODA | 11-14-03 | | 2 |
| SETAG MOISIVER GEORGE | 10-01-03 | | ß |
| RELEASED FOR CONSTRUCTION | 8-12-03 | | 0 |
| DESCRIBITION OF REVISION | :3TAO | ::8 | ON. |

| -n Line / 11 | си ЕИСІИЕЕВ | SOADWAY DESI |
|--------------|-----------------|--------------|
| 91/0/11 | a hama 11 | mun. |
| -Tall 13 | While he had | Ulling / |
| ALL , | A James And | X I SIL |
| i | I / Significant | NON: |
| | E. A. 1. 932 | " × • • • • |
| | 7 | سكري |

| Ейепятье : | |
|--------------------------|--|
| Document Control Number: | |

| K-very jacks/NCDOT v-2547/ccv dwy/vev_s | mus, y damins, ve v ywt | |
|---|-------------------------|------------------------------|
| Ейеляте : | | REVISION SUMMARY |
| | | INDEX OF SHEETS AND |
| Document Control Number: | : 19 | |
| CHECKED BA: | :9TAQ | BALETICH |
| THE NWAR | :3TAU | DEPARTMENT OF TRANSPORTATION |

| ED/11/11 , | ENCINEER | DEZICH | ROADWAY | |
|------------|----------|-----------|---|---|
| holder We | Just 2 | | my | _ |
| ALL 7 9, | Co | F KID | Shi | |
| / / 2 | EM. 8 | NCINEE | > 0= | |
| | . P | SISIO | 于言 | |
| - | | SEAl | ZD = ================================== | |
| | 12 | O18837 | 180/11 | |
| | 1////0 | AAD H | Talle | |
| | .,,,, | 111111111 | | |

| 9/1/2/ | ROADWAY DESIGN ENGINEER | |
|--------|---|--|
| All | KING F KIRCHING WANTED | |
| | WOUNEE STATES | |
| | SISIO SISIO | |
| | TA 3 S OF EASING WITH CAROL WITH | |
| | WINDARD HIMM | |
| | | |

| | | 7/1/1/08 | A) H H H H H H H H H H | | | | | |
|--|---------------------------------------|----------|--|----------|----------|----------------------|----------------|--------------|
| | · | | | | | 08-12-03 | CBOSS SECTIONS | †8-X |
| | | i | | 11-14-03 | 10-03 | 08-12-03 | CROSS SECTIONS | X-83 |
| | | | | | 10-01-03 | 08-12-03 | CBOSS SECTIONS | Z8-X |
| | | | · · · · · · · · · · · · · · · · · · · | | 10-01 | 08-12-03 | CBOSS SECTIONS | 18-X |
| | | | | A | 10-01-03 | 08-12-03 | CROSS SECTIONS | Ø8-X |
| ; ; | | | | | | 80-12-03 | CROSS SECTIONS | 6Z-X |
| | | | | | | £0-9I-80 | CROSS SECTIONS | 8Z-X |
| | | | | | | 08-12-03 | CBOSS SECTIONS | ∠∠-X |
| | | | | | | 08-12-03 | CBOSS SECTIONS | 9∠-X |
| | | | | | | 08-12-03 | CBOSS SECTIONS | GZ-X |
| | | | | | | 80-12-03 | CROSS SECTIONS | <i></i> ⊅∠-X |
| | | | The second secon | | | 08-12-03 | CBOSS SECTIONS | X-73 |
| • | | | The second secon | | | 80-12-03 | CROSS SECTIONS | ZZ-X |
| | | | | | | 08-12-03 | CBOSS SECTIONS | ΙΔ-X |
| | | | | | | 08-12-03 | CBOSS SECTIONS | 0Z-X |
| | | | | | | £ 0 -12-03 | CBOSS SECTIONS | 69-X |
| | · · · · · · · · · · · · · · · · · · · | | | | | 08-12-03 | CBOSS SECTIONS | 89-X |
| | | | | | | 08-12-03 | CBOSS SECTIONS | ۷9-X |
| | | | | | | 08-12-03 | CROSS SECTIONS | 99-X |
| | | | | - | | 80-12-03 | CROSS SECTIONS | 99-X |
| | | | | | | 08-12-03 | CROSS SECTIONS | ₩ 19-X |
| | | | | | | 11-14-03 | CBOSS SECTIONS | X-63C |
| And the second s | | | 1 (88) 11 - 1 | | | 11-14-03 | CROSS SECTIONS | X-63B |
| | | | | | | 11-10-93 | CROSS SECTIONS | ₩29-X |
| | | | | | | 80-19-03 | CROSS SECTIONS | |
| en en en en en en en en en en en en en e | | | | | | 08 1E 03 08-12-03 | CROSS SECTIONS | F9-X |
| | | | | | | 08-12-03 08-12-03 | | Z9-X |
| The second secon | | | | | | MR-1E-M2 | CROSS SECTIONS | 19-X |

| SIN | СОММЕ |
|--------------------------|-------|
| | |
| DATE: 11-14-2003 | |
| RELEASE FOR CONSTRUCTION | |
| | |

PROJECT REFERENCE NO.

SHEET NO.

| TAAMMUS NO | KEAIZI |
|------------|--------|
|------------|--------|

3 BEAISION

S BEAISION

I BEAIZION

BEVISION

e Beaision

2 BE∧ISION


) BEAISION

DATE: 8-15-2003 RELEASE FOR CONSTRUCTION PROJECT REFERENCE NO. SHEET NO.

INDEX OF SHEETS AND REVISION SUMMARY

DEPARTMENT OF TRANSPORTATION

RALEIGH

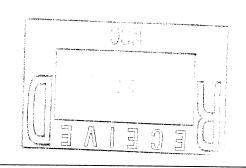

| _ | |
|---------|----------|
| YAAMMUS | KEAIZION |

| COMMENTS | REVISION | REVISION | BEAISION | REVISION 4 | 3 BEAISION | S SEAISION | I BEAISION | RFC DATE | SHEET TITLE | NO. |
|--|----------|----------|-------------|---------------|---------------|---------------|---------------|-------------|----------------|----------------------------|
| | L | 9 | S | | | | | 60-51-80 | CB022 SEC110NS | 98-X |
| | | | | | | | | 08-12-03 | CROSS SECTIONS | 98-X |
| en en en en en en en en en en en en en e | | | | | | | | 08-12-03 | CROSS SECTIONS | ∠8-X |
| | | | | | | | | 08-12-03 | CROSS SECTIONS | 88-X |
| | | + | | | | | | 08-12-03 | CROSS SECTIONS | 68-X |
| | | | | | | | | 08-12-03 | CROSS SECTIONS | 06-X |
| | | | | | | | | 08-12-03 | CROSS SECTIONS | I6-X |
| | | | | | | | | 88-12-03 | CROSS SECTIONS | Z6-X |
| | | | _ | | | | | 08-12-03 | CBOSS SECTIONS | £6-X |
| | | | | | | | | EØ-SI-80 | CROSS SECTIONS | ≯ 6-X |
| | | | | | | | | 08-12-03 | CBOSS SECTIONS | ⊆6-X |
| | | | | | | | | 08-12-03 | CHOSS SECTIONS | 96-X |
| | | | , Fried Add | | | | | EØ-91-80 | CROSS SECTIONS | ∠6-X |
| | | | | | | | | 80-91-80 | CBOSS SECTIONS | 86-X |
| | | | | | | | | E0-91-80 | CROSS SECTIONS | 66-X |
| | | | | | | | | 80-12-03 | CROSS SECTIONS | 001-X |
| | | | | | | | | 08-12-03 | CROSS SECTIONS | 1Ø1-X |
| | | | | | | | | 08-12-03 | CROSS SECTIONS | X-102 |
| | | | | | | | | 08-12-03 | CROSS SECTIONS | X-103 |
| | | | | | | | | 08-12-03 | CROSS SECTIONS | ≯ ØI-X |
| | | | | | | | | 08-12-03 | CROSS SECTIONS | 901-X |
| | | | | | | | | 12-03 | CBOSS SECTIONS | (∀) ⊆ Ø I -X |
| | | | | | | | | 08-12-03 | CBOSS SECTIONS | X-1 0 2(B) |
| | | | | | | | | 08-12-03 | CBOSS SECTIONS | X-102(C) |
| The second secon | | | | | | | | 08-12-03 | CROSS SECTIONS | 9 0 1-x |

| | | - |
|--|--|---|
| | | |
| | | |
YAPPO JECHSUNCDOTV -254T/CCV dwyv en "summony, sum

– 131 AU –

Filename :

CHECKED BA:

_:YB WWA90

ROADWAY DESIGN ENGINEER

| DESCRIBITION OF REVISION | :3TAG | :۲8 | .ON |
|---------------------------|---------|-----|-----|
| RELEASED FOR CONSTRUCTION | 8-15-03 | | 0 |
| | | | В |
| | | | 8 |
| | | | 8 |
| | | | Ð |
| | | | © |

| KEAISIONS | | | | |
|----------------|---------|-----|----------|--------------------------------|
| | | | © | |
| | | | Ð | |
| | | | 3 | |
| | | | 2 | |
| | | | ß | iorth Carelina Constructors |
| RELEASED FOR C | 8-15-03 | | 0 | S 10130 DOUGO DULLE IDO ID ISI |
| DESCRIPTION O | :3TAG | :78 | .ON | |

| nanthiistonail cullancii dinail | |
|---------------------------------|--|
| DON | THE LPA (RROUP of North Corollnd, p.d., 4904 Professional Court, Suite 201 LTANTS Raisiph, North Carolina 276.09 |
| | |

ATJUSNOS NOTATROGRAMAT

ATJUSNOS NOTATROGRAMAT

O DE CARTON O DE C

entitation confered their

THE LPA GROUP Of NOrth Corollno, p.o.

GROUP
TRANSPORTATION CONSULTANTS
Releigh, North Corollno 27609
RANSPORTATION CONSULTANTS

| SNOISIAT | a a | | |
|---------------------------|----------|-----|----------|
| | | | © |
| | | | b |
| REVISED SHEET x-117 | 15-01-02 | | 3 |
| ADDED X-128B AND X-128B | 11-14-03 | | 2 |
| ADDED REVISION DATES | 10-01-03 | | [L |
| RELEASED FOR CONSTRUCTION | 8-12-03 | | 0 |
| DESCEIBIION OF BEVISION | :3TAG | 9.8 | .OM |

| | ROADWAY DESIGN ENGINEER |
|---------|--------------------------|
| ا صادام | / Minor for marching por |
| E9/1/2) | THE KICKSOLL PLANT |
| | WOINE E. |
| | OIZIZ TE |

| | mus, y tommus, ve v (wo v 20/1 h25- v 10/ |
|--------------------------------------|---|
| NEVISION SUMMARY | |
| INDEX OF SHEETS | |
| | entrol Number : |
| DEPARTMENT OF TRANSPORTATION RALEIGH | :3TAQ |
| STATE OF WORTH CAROLINA | :3TAQ |

HECKED BA:

DRAWN BY:

| | | | | ′/ | NORAD HENNIN | | | | | |
|----------|--|----------|---------------|---------------|---------------|---------------|--|-------------|----------------|----------------|
| | | | | | | | | 08-12-03 | CKOSS SECTIONS | X-131 |
| | | | | | | | | 08-12-03 | CBOSS SECTIONS | 0EI-X |
| | | | | | | | 11-14-03 | 08-12-03 | CBOSS SECTIONS | 6ZI-X |
| | | | | | | | | 11-14-03 | CBOSS SECTIONS | X-128B |
| | | | | | | | | 11-14-03 | CBOSS SECTIONS | A82I-X |
| | | | | | | | i | 08-12-03 | CROSS SECTIONS | X-128 |
| | | | | | | | W.F.L. | 08-12-03 | CROSS SECTIONS | /ZI-X |
| | | | | | | | | 08-12-03 | CHOSS SECTIONS | 77-126 |
| | New Administration of the Control of | | | | | | | 08-12-03 | CBOSS SECTIONS | 9ZI-X |
| | | | | | | | THE STATE OF THE S | 08-12-03 | CROSS SECTIONS | X-124 |
| | | | | | | | | 08-12-03 | CBOSS SECTIONS | X-123 |
| | | | | | | | 10-01-03 | 08-12-03 | CBOSS SECTIONS | X-IZS |
| | | | 7 | | | | 10-01 | 08-12-03 | CBOSS SECTIONS | X-121 |
| | | | | | | | | 08-12-03 | CROSS SECTIONS | ØZ1-X |
| | | | : | | | | Maria . | 08-12-03 | CBOSS SECTIONS | 911-X |
| | | | | | | | | 08-12-03 | CROSS SECTIONS | 8II-X |
| | | | | | | | 12-01-03 | 08-12-03 | CROSS SECTIONS | Δ11-X |
| | | | | | | | | 08-12-03 | CHOSS SECTIONS | 9II-X |
| | | | | | | | | 08-12-03 | CROSS SECTIONS | SII-X |
| | | | | | | | | 08-12-03 | CROSS SECTIONS | ÞII-X |
| | | | | | | | | 08-12-03 | CKOSS SECTIONS | X-113 |
| | | | | | | | | 08-12-03 | CROSS SECTIONS | ZII-X |
| | | | | | | | | 08-12-03 | CROSS SECTIONS | III-X |
| | | | | | | | | EØ-9I-8Ø | CROSS SECTIONS | Ø11-X |
| | | | | | | | | 08-12-03 | CROSS SECTIONS | 601-X |
| | | | | | | | | EØ-9I-8Ø | CB022 SECTIONS | 8 0 I-X |
| | | | | | | | | EØ-9I-8Ø | CB022 SECTIONS | ∠01-X |
| СОММЕИТЅ | REVISION | BEVISION | 2 BEAISION | # BEVISION | 3 BEAISION | S BEAISION | I BEAISION | PRC ∃TAO | SHEET TITLE | SHEET NO. |

BEAISION SAWWYBL

DATE: 12-01-2003 RELEASE FOR CONSTRUCTION

PROJECT REFERENCE NO. SHEET NO.

KEAISIOM SAMWYKI

| DATE: 71-14-2003 | REVISION | BEAISION | BEAIZION | KE A I Z I O N | KEAISION | REVISION | REVISION | JAR ∃TAO | SHEET TITLE | SHEET |
|--|-----------|---------------------------------------|-----------------------|------------------------------|---|---------------------------------------|----------|-------------|----------------|----------------|
| COWMENTS | <u></u> Δ | 9 | 9 | Þ | 3 | Z | Į į | 08-12-03 | CROSS SECTIONS | NO. |
| | | | • | | | | | 80-91-80 | CBOSS SECTIONS | X-134 |
| | • | | | · | | · · | | 08-12-03 | CBOSS SECTIONS | X-133 |
| | | | | | | | | EØ-G1-80 | CROSS SECTIONS | X-135 |
| | | | | | | | | 80-91-80 | CROSS SECTIONS | X-133 |
| | | | | • | : • | | | E0-G1-80 | CBOSS SECTIONS | 4£1-X |
| A continuous company of the continuous company of the continuous company of the continuous company of the continuous company of the continuous company of the continuous company of the continuous company of the continuous company of the continuous contin | | t t | | | | | | 08-12-03 | CBOSS SECTIONS | |
| And the second of | | | | | | # | | 08-12-03 | CBOSS SECTIONS | 7.13e |
| | | · · · · · · · · · · · · · · · · · · · | | ! ! | | | | 11-14-03 | CBOSS SECTIONS | A361-X |
| | | | | | | | | 11-14-03 | CBOSS SECTIONS | X-136B |
| | | • | | | | | | 08-12-03 | CROSS SECTIONS | X-137 |
| | | | | - | | | | 08-12-03 | CROSS SECTIONS | X-138 |
| | ! ! | | | | | 4 | | 08-12-03 | CROSS SECTIONS | X-136 |
| | | | | | | | | 89-12-03 | CROSS SECTIONS | 0 †I -X |
| | | | · · · · · · | 1 1 4 mars | | | · • | 60-21-80 | CBOSS SECTIONS | [+I-X |
| | | 1 | 1 1 1 1 1 | | - | | | 08-12-03 | CROSS SECTIONS | X-142 |
| | | | | | | | | 08-12-03 | CROSS SECTIONS | X-143 |
| | | | 1 | | | | | 08-12-03 | CROSS SECTIONS | 7 t t T - X |
| | 1 | | | | | | | 08-12-03 | CROSS SECTIONS | ⊆ †I-X |
| | | | | | | | | 08-12-03 | CROSS SECTIONS | 9 † I-X |
| | | 1 | | | | | * | 08-12-03 | CBOSS SECTIONS | ∠ ≯ I-X |
| | | | | | | | | 08-12-03 | CROSS SECTIONS | 8 ∳ I-X |
| | | | | | | | | 08-12-03 | CBOSS SECTIONS | 6 † I-X |
| | | | | | | | | 80-91-80 | CROSS SECTIONS | 7-150 |
| | | | | | • · · · · · · · · · · · · · · · · · · · | | | 19-91-80 | CROSS SECTIONS | ISI-X |
| | | | | | | • • • • • • • • • • • • • • • • • • • | | £0-91-80 | CROSS SECTIONS | Z91-X |
| | * : | | | | * *** ! | • • | | EØ-91-8Ø | CROSS SECTIONS | X-123 |
| | : | | | • | | | | £0-91-80 | CROSS SECTIONS | +91-X |
| | | | | | | , | | 80-91-80 | CBOSS SECTIONS | 991-X |

BOADWAY DESIGN ENGINEER

YYPTO Jects MCDOTV -2547 xxx dwyver summary sum:

-:YB NWARG

- DATE:

KEVISION SUMMARY
INDEX OF SHEETS

DEPARTMENT OF TRANSPORTATION

OF ARRUPT

OF TRANSPORTATION

RELEASE FOR CONSTRUCTION

PROJECT REFERENCE NO. SHEET NO.

REVISIONS

RETAISIONS

RETAISIONS

RETAISIONS

RETAISIONS

RETAISIONS

£0-91-80

THE CATOlino, D.O. GROUP Of WOrth Corolino, p.o. GROUP AND THE LAST STORES AND THE COROLING STORES AND

991-X

CBOSS SECTIONS

DEPARTMENT OF TRANSPORTATION KEAISIONS _:YB NWARG _ :BTAO_ CBOSS SECTIONS X-163 89-12-03 CROSS SECTIONS X-162 CBOSS SECTIONS 191-X 60-21-80 091-X CBOSS SECTIONS 80-91-80 CROSS SECTIONS 69I-X 89-11-80 891-X CROSS SECTIONS 89-15-03 89-11-80 CROSS SECTIONS ∠91-X .ON DATE DATE **BEVISION** REVISION REVISION REVISION SHEET TITLE SHEET BENIZION BEAIZION **BEVISION** COMMENTS DATE: 10-01-2003 KENIZION ZOMWYKZ RELEASE FOR CONSTRUCTION

BOADWAY DESIGN ENGINEER

APO JACKOTO TO -254700 days de summony sum

CHECKED BA:

_ :BTAG

INDEX OF SHEETS AND REVISION SUMMARY

HEV_CC-II

8-5242CC

PROJECT REFERENCE NO. SHEET NO.

DESCRIBLION OF REVISION

REFE∀2ED LOW CONSIBUCTION

10-01-03 BEVISED ORDER AND DELETED ×-156

HO. BY: DATE:

North Carelina Constructors THE LPA GROUP of North Corollna, p.o. QHO Of North Corollna, p.o. QHO PROFESSIONAL COROLLNA COROLLARIS SOL REALPRATATION CONSULTANTS

ß 2 & F

0 87: DATE: (S)

DESCRIPTION OF REVISION BELEASED FOR CONSTRUCTION

KEAISIONS

KOYDWAY DESIGN ENCINEER

DEPARTMENT OF TRANSPORTATION STATE OF MORTH CAROLINA

INDEX'0EN'NOLES'SLDS

SEE SHEEL IB LHBN IC

IS BEING PROVIDED TO THE CONTRACTOR. NOTE: THE ENTIRE LIST OF THE "ROADWAY STANDARD DRAWINGS"

hereby are considered a part of these plans: The following Roadway Standards as they appear in "Roadway Standard Drawings"

ROADWAY METRIC STANDARD DRAWINGS

X-I THRU X-163_____CROSS SECTIONS 42 CHORS INDEX OF SHEETS SITHRU 44_____FINAL GRADING PROFILES (NOTE:: 10,11,12,19 Not Used) 4 THIN 20_____A 3H THRU 3J______GUARDRAIL SUMMARY SHEET DITCH DETAIL SHEE! 20 THRU SP.....GHEBAIL DETAIL SHEET SK THRU ZM. CHANNEL DETAILS AUOT30 SOIY.____ ID.....TYPICAL SECTIONS

2 THRU 2H.....TYPICAL SECTIONS INDEX, GENERAL NOTES BEV_CC_ITHRU REV_CC_M__ "HENIZION ZNWWARK SHEEL TITLE SHEET SHEEL INDEX OF SHEETS

EBON 218/146+62 (END BRIDGE) 10 218/120+40 (2N 14): 218/140: 218/158+45 (2N 15) EBC INSIDE SHONCDER DRAIN

OAAJ H.

WYORA J W

OUTLET AT STA.170+00 (SN 121); STA.171+00 (SN 133B); STA.172+00 FROM STA,169+28 (END BRIDGE) TO STA,172+24

OUTLET AT STA.166+66 (SN 73); STA.167+40 (SN 74) LHOW SIA 166+55 (END BRIDGE) TO SIA 168+43 (BEGIN BRIDGE)

> OUTLET AT STA 164+20; STA 165+00 (SN 7!) FROM STA,164+00 TO STA,166+07 (BEGIN BRIDGE)

OUTLET AT STA 160+00 (SN 48); STA 160+80 (SN 50); STA 161+70 (SN 54); STA 162+70 FROM STA.159+94 (END BRIDGE) TO STA.163+70

> 001LET AT STA 153+62; STA 157+60 (SN 30); STA 155+60; STA156+80 (SN 36); STA 157+60 (SN 40); STA 158+40 (SN 41) EBOW SIFIESTES TO SIF. 159+50 (BEGIN BRIDGE)

> > 0UTLET AT STA.144+83 FROM STA, 144+20 TO STA, 144+89 (BEGIN BRIDGE)

EBL OUTSIDE SHOULDER DRAIN

(NOTE: 'SN' = STRUCTURE NUMBER) SHOULDER DRAINS:

SHOULDER DRANS SHALL BE CONSTRUCTED IN ACCORDANCE WITH STO NO BIGIOS OF BIGIOS/

ALL LOOSE ROCK IS ADEQUATELY REMOVED AND TO DETERMINE THE THE GEOTECHNICAL ENGINEER SHOULD OBSERVE ALL ROCK CUTS TO CONFIRM

> SHOULD BE CONSTRUCTED AT A SLOPE OF LS(H):I(V). THE LOCATIONS OF SOFT WEATHERED ROCK AND HARD ROCK

> > AT ROCK LOCATIONS:

08+281 OT 01+181,AT2 -J-UNDERDRAINS WILL BE REQUIRED AT THE TOE OF THE CUT SLOPES ON

06+EI OT 07+SIATZ -IYUB9A- 01+EBI OT 07+081 ATZ -1-02+21 01 07+01.ATZ -1789A- 02+24 01 07+741.ATZ -1-

LOCATIONS OF GROUNDWATER WITHIN I.8 METERS OF SUBGRADE:

DESIGN SUBGRADE AT THE LOCATIONS LISTED BELOW. UNDERDRAINS ARE EXPECTED TO BE PLACED AT THESE LOCATIONS. GROUNDWATER WAS IDENTIFIED ABOVE OR WITHIN I.8 METERS OF THE

> BE CONDUCTED AS DIRECTED. UNDERCUT ALONG CULVERT PIPES ACROSS EXISTING PONDS SHOULD

> SEE RECOMMENDATIONS FOR LOCATION OF LIME/CEMENT. SUBGRADE STABILIZATION IS REQUIRED THROUGHOUT THE PROJECT.

> > -LPAYI- STA, II+90 TO I2+10 -SA2- STA, I0+00 TO I3+10 -RPAY3-STA, II+00 TO I2+20 0++91 01 06++1,ATS -1YA9A-

UNDERCUT EXCAVATION IS EXPECTED IN THE FOLLOWING AREAS:

09+9+1,AT2 OT 07+4+1,AT2

UNDERCUT OR STABIUZATION FABRIC SHOULD BE USED AT -L-

SPECIFIC RECOMMENDATIONS, INCLUDING THE FOLLOWING: GENERAL--REVIEW THE ROADWAY FOUNDATION RECOMMENDATIONS FOR ROADWAY FOUNDATION RECOMMENDATIONS:

YIVPROJECTS WCDOTV-2547 VCCVOMYV2547 CCIADSh

DVIE: HECKED BA: :31AO -:YB NWARC

Dated January 15, 2002 are applicable to this project and by reference Highway Design Branch - N.C. Department of Transportation - Raleigh, N.C.,

FROM STA.169+02 (END BRIDGE) TO STA.172+20 OUTLET AT STA.170+10; STA.171+00 (SN 133A); STA.172+20 (SN 133)

(27 NS) O4+731.AT2;(ST NS) SC+331.AT2 TA FROM STA.166+41 (END BRIDGE) TO STA.168+22 (BEGIN BRIDGE) OUTLET

(70 NS) 08+401.ATZ ;0S+401.ATZ ;(82 NZ) 0S+E01.ATZ :07+S31.ATS:(SB NS) 07+181.ATS:(18 NS) 08+031.ATS:(74 NS) 49+921.ATS FROM STA159+88 (END BRIDCE) TO STA165+93 (BEGIN BRIDGE) OUTLET AT

MBC INSIDE SHOULDER DRAIN

FROM STA.159+83 (END BRIDGE) TO STA.160+20 OUTLET AT STA.159+90 (SN 46)

OUTLET AT STAIGT+00 (SN 10); STAIGH+00; STAIGH+00; STAIGO+00; STAIGO+00; STAIGH+00; STAIGS+00; STAI FROM STA.146+90 (END BRIDGE) TO STA.159+39 (BEGIN BRIDGE)

COLTEL AT STA 145+22 (SN7)

WBL OUTSIDE SHOULDER DRAIN

SHOULDER DRAINS (CONT'D):

8-15-2003

CONSTRUCTION RELEASE FOR CONSTRUCTION

B-2547CC PROJECT REFERENCE NO. SHEET NO. WEIKICS!

CENERAL NOTES - METRIC (CONT'D)

-00N

UTILITIES SHOWN ON PLANS ARE NOT GUARANTEED TO BE ACCURATE LOCATIONS. TO BE ADJUSTED BASED ON EXISTING FIELD CONDITIONS. ARE FROM EXISTING GROUND SURVEYS, EXACT PIPE LOCATIONS MAY NEED

STATIONS AND OFFSETS FOR PIPES ON THE DRAINAGE SUMMARY SHEETS

OR EXCAVATION APROACHING A BRIDGE. PRIOR TO SETTING OF THE SLOPE STAKES FOR THE EMBANKMENT THE STRUCTURE END BENT PLANS, DETAILS, AND CROSS SECTIONS SHALL BE CHECKED

> CONSTRUCTION WITH APPROVAL BY THE ENGINEER PRIOR TO ADJUSTMENTS. THE GUARDRAIL LOCATIONS SHOWN ON THE PLANS MAY BE ADJUSTED DURING

USING THE RADII NOTED ON THE PLANS. STREET RETURNS SHALL BE CONSTRUCTED IN ACCORDANCE WITH STD, NO. 848.04

BE AS SHOWN ON THE PLANS. 900mm RADII OR RADII AS SHOWN ON THE PLANS. LOCATIONS OF DRIVES WILL DRIVEWAYS SHALL BE CONSTRUCTED IN ACCORDANCE WITH STD. NO. 848.02 USING

UNDERDRANS SHALL BE CONSTRUCTED IN ACCORDANCE WITH STD. NO. 815.03.

TOCATIONS SHOWN ON THE PLANS.

KOIGIĞU* NOLTN COLOIING 27609

THE LPA GROUP of North Carolina, p.o. 0404 Professional Court, Sulte 201
Professional Court, Sulte 201
Professional Court, Sulte 201
Professional Court Carolina 27609

BERM DITCHES SHALL BE CONSTRUCTED IN ACCORDANCE WITH STD. NO. 240.01 AT

CONNECTIONS WITH ALL ROADS, STREETS, AND DRIVES ENTERING THIS PROJECT. THE DESIGN-BUILDER WILL BE REQUIRED TO DO ALL NECESSARY WORK TO PROVIDE SUITABLE

(THIS WILL MAKE SUPERELEVATED AND TANGENT PAYED SHOULDER DEPTHS CONSISTENT). SECTIONS, SHALL BE MAINTAINED THROUGH SUPERELEVATED SECTIONS OF THE ROADWAY CRADE SHOULDER SLOPES AND SUBGRADE SHOULDER SLOPES ON NORMAL CROWN ACCORDANCE WITH STD. NO. 560.01 OR 560.02. THE ALGEBRAIC DIFFERENCE, OF FINISHED SHOULDER CONSTRUCTION ON HIGH SIDE OF SUPERELEVATED CURVES SHALL BE IN

ON THE TYPICAL SECTIONS. SUPERELEVATION IS TO BE REVOLVED ABOUT THE GRADE POINTS SHOWN STD. NO. 225.04 USING THE RATE OF SUPERELEVATION AND RUNOFF SHOWN ON THE PLANS.

ALL CURVES ON THIS PROJECT SHALL BE SUPERELEVATED IN ACCORDANCE WITH STRUCTURES IN ORDER TO SECURE A PROPER TIE-IN.

CRADE LINES MAY BE ADJUSTED AT THEIR BEGINNING AND ENDING AND AT OR FUTURE SURFACING AT GRADE POINTS SHOWN ON THE TYPICAL SECTIONS. THE GRADE LINES SHOWN DENOTE THE FINISHED ELEVATION OF THE PROPOSED

> LIMITS ESTABLISHED BY METHOD III. CLEARING ON THIS PROJECT SHALL BE PERFORMED TO THE

FOLLOWING THE CLEARING OPERATION. EROSION CONTROL DEVICES SHALL BE INSTALLED IMMEDIATELY ZONE UNTIL IMMEDIATELY PRIOR TO BEGINNING GRADING OPERATIONS. CLEARING OPERATIONS (NOT GRUBBING) SHALL BE ALLOWED IN THIS BUFFER THE STREAM (OR DEPRESSION), MEASURED FROM THE TOP OF STREAMBANK. DEFINED AS A 50 FOOT (16 METER) BUFFER ZONE ON BOTH SIDES OF SPECIFICATIONS, THE "ENVIRONMENTALLY SENSITIVE AREA" SHALL BE AS DESCRIBED IN SECTION 200, ARTICLE 200-1, IN THE STANDARD OPERATIONS UNTIL IMMEDIATELY PRIOR TO BEGINNING GRADING OPERATIONS DESIGN-BUILDER MAY PERFORM CLEARING OPERATIONS, BUT NOT GRUBBING IN AREAS IDENTIFIED AS "ENVIRONMENTALLY SENSITIVE AREAS", THE

THIS ALSO REQUIRES SPECIAL PROCEDURES TO BE USED FOR SEEDING AND MULCHING AND STAGED SEEDING WITHIN THE PROJECT. AREA". THIS DESIGNATION REQUIRES SPECIAL PROCEDURES TO BE USED FOR CLEARING AND GRUBBING. TEMPORARY STREAM CROSSINGS, AND GRADING WITHIN THE AREA IDENTIFIED ON THE PLANS. THIS PROJECT IS LOCATED IN AN "ENVIRONMENTALLY SENSITIVE

THE WORD ENGINEER SHALL MEAN NCDOT REPRESENTATIVE

CENERAL NOTES - METRIC

Raleigh, North Carolina 27609

HE LPA GROUP of North Corollno, p.c.
4904 Professional Court, Sulte 201
GROUP
Releich, North Carolina 27869

2

North Carolina Constructors

KEAISIONS

Aplica Pipe Collar

840.71 Concrete and Brick Pipe Plug

840.66 Drainage Structure Steps

840.54 Manhole Frame and Cover

840.45 Precast Drainage Structure

840.37 Steel Grate and Frame

\$40.30 Driveway Drop Inlet

840.41Spring Box - Concrete or Brick

840.33 Angled Vane Crates and Frames

840.29 Frames and Narrow Slot Flat Grates

840.24 Frames and Narrow Slot Sag Grates

840.22 Frames and Wide Slot Sag Crates

840.20 Frames and Wide Slot Flat Grates

840.53 Precast Manhole with Masonry Base - 300mm thru 1050mm Pipe

840.36 Traffic Bearing Drop Inlet - for Steel(840.37) Double Frame and Grates

840.35 Traffic Bearing Drop Inlet - for Cast Iron Double Frame and Grates

840.34 Traffic Bearing Junction Box - for Use with Pipes 1050mm and Under

840.52 Precast Manhole - 1200mm,1500mm and 1800mm Diameter

840.51 Brick Manhole - 300mm thru 900mm Pipe

840.46 Traffic Bearing Precast Drainage Structure

840.32 Brick Junction Box - 300mm thru 1650mm Pipe

840.25 Anchorage for Frames - Brick or Concrete

840.15 Brick Drop Inlet - 300mm thru 750mm Pipe

840.14 Concrete Drop Inlet - 300mm thru 750mm Pipe

840.31Concrete Junction Box - 300mm thru 1650mm Pipe

840.28 Brick Median Drop Inlet Type 'D' - 300mm thru 900mm Pipe

840.27 Brick Median Drop Inlet Type 'B' - 300mm thru 900mm Pipe

840.26 Brick Median Drop Inlet Type 'A' - 300mm thru 1800mm Pipe

840.19 Concrete Median Drop Inlet Type 'D' - 300mm thru 900mm Pipe

840.18 Concrete Median Drop Inlet Type '8' - 300mm thru 900mm Pipe

840,17 Concrete Median Drop Inlet Type $^{\prime}$ Y $^{\prime}$ 500mm thru 1800mm Pipe

840.16 Drop inlet Frame and Grates - for use with 5td. Dwg.s 840.19 and 840.15

840.05 Brick Catch Basin with Single and Multiple Pipes - 300mm thru I200mm Pipe

838.07 Conc. Endwall for Sngl & DblPipe Clvrt-1016mmx787mm thru 1676mmx1295mm Arch 90°5kew 838*|| Brick Endwall for Single and Double Pipe Culverts - 375mm thru 1200mm Pipe 90°Skew 838,10 Concrete Endwall for Outfall - 100mm, 150mm or 200mm Pipe 838.08 Conc. 'L' Endwall for Single Pipe Clurt - 1016mmx787mm thru 1676mmx1295mm Pipe Arch 838.06 Concrete 'L' Endwall for Single Pipe Clvrt - 432mmx330mm thru 1803mmx1194mm Pipe Arch

838.05 Concrete 'L' Endwall for Single Pipe Culverts - 375mm thru 1200mm Pipe 838.04 Conc. Endwall for Sngl& DblPipe Clvr+-432mmx330mm thru 1803mmx1194mm Arch 90°Skew

838°05 Couckete Eugmanland Sinice Cate - 312mm thru 900mm 90°5kew 838.01 Conc. Endwall for Single and Double Pipe Culverts - 375mm thru 1200mm Pipe 90°Skew

820.04 Drain Installation in Shoulder Berm Gutter

820.01Funneland FunnelDrain - 300mm MetalFunnel 816.04 Markers for Drainage Structure and Concrete Pad

816.03 Geocomposite Shoulder Drain niord Abduode Shoulder Drain

816.01 Concrete Pads - for Shoulder Drain Installation 815.03 Pipe Underdrain and Blind Drain

806.02 Granite Right-of-Way Marker 806.01Concrete Right-of-Way Marker

DIVISIÓN 8 - INCIDENTALS

720.01 Concrete Shoulders 710.01 Concrete Pavement - Station Marking

700.05 Tying Proposed Pavement to Existing 700.04 Concrete Pavement Header Board

YOO.O3 Dowel Assembly

700.02 Expansion Joint Layout - for Rigid Doweled Pavement at Bridges (UD.01 Concrete Pavement Joints - Construction and Contraction Joints

DIVISION 7 - CONCRETE PAVEMENTS AND SHOULDERS

stramevog tlondas - agint2 eldmuR ballMIO.233 654.OIPavement Repairs

610.04 Asphalt Wearing Surface on Approach Slab 60.013 Guide for Paving Shoulders Under Bridges - Method III

610.02 Guide for Paving Shoulders Under Bridges - Method II

60.01 Guide for Paving Shoulders Under Bridges - Method I

DIVISION 6 - ASPHALT BASES AND PAVEMENTS

422.10 Reinforced Bridge Approach Fills

DIVISION 4 - MAJOR STRUCTURES

300.02 Method of Pipe Installation - Method '8'

300.01Method of Pipe Installation - Method 'A'

240.016uide for Berm Ditch Construction

225.08 Earth Berm Median Pier Protection

225.03 Deceleration and Acceleration Lanes

20.003 Method of Clearing - Method III

20.002 Method of Clearing - Method II

DIVISION 2 - EARTHWORK

225.07 Grading for False Cut at Grade Separations

225.06 Method of Grading Sight Distance at Intersections

225.02 Guide for Grading Subgrade - Secondary and Local

225.01Cuide for Grading Subgrade - interstate and Freeway

225.05 Method of Obtaining Superelevation - Divided Highways

225.04 Method of Obtaining Superelevation - Two Lane Pavement

310.10 Driveway Pipe Construction

DIVISION 3 - PIPE CULVERTS

DIVISION 5 - SUBGRADE, BASES AND SHOULDERS

310.05 Cross Pipe End Section - Prefabricated SteelSection for 450mm to 800mm Pipe

30.04 ParallelPipe End Section - Prefabricated SteelSection for 400mm to 600mm Pipe

30.03 Cross Pipe End Section - Precdst Concrete Section for 450mm to 750mm Pipe

30.02 ParallelPipe End Section - Precast Concrete Section for 375mm to 600mm Pipe

300.04 Method of StructuralPlate Pipe and Pipe Arch Installation - Method 'B'

300.03 Method of StructuralPlate Pipe and Pipe Arch Installation - Method 'A'

225.09 Guide for Shoulder and Ditch Transition at Grade Separations

560.02 Method of Shoulder Construction - High Side of Superelevated Curve - Method II 560.01Method of Shoulder Construction - High Side of Superelevated Curve - Method I

840.04 Concrete Catch Basin with Single and Multiple Pipes - 300mm thru 1200mm Pipe 840.03 Frame, Grates and Hood - for Use on Standard Catch Basin

840.02 Concrete Catch Basin - 300mm thru 1350mm Pipe 840.018rick Catch Basin - 300mm thru 1350mm Pipe

840.00 Concrete Base Pad for Drainage Structures 838.80 Precdst Endwalls - 300mm thru 1800mm Pipe 90°Skew 838.75 Notes for Reinforced Brick Endwall- 5td. Dwg.s 838.5| thru 838.70 838.70 Reinforced Brick Endwall - for Double and Triple 1800mm Pipes 90° Skew

838.69 Reinforced Brick Endwall - for Single 1800mm Pipe 90° Skew 838'64 Bejutokced Brick Endwall- for Double and Triple 1650mm Pipes 90°5kew 838.63 Rejutorced Brick Endwall - for Single 1650mm Pipe 90°Skew

838.58 Reinforced Brick Endwall - for Double and Triple 1500mm Pipes 90°5kew 838.57 Reinforced Brick Endwall- for Single 1500mm Pipe 90°Skew 838.52 Reinforced Brick Endwall- for Double and Triple 1350mm/400mm Pipes 90°Skew

838.51 Reinforced Brick Endwall- for Single 1350mm/1400mm Pipe 90° Skew 838.45 Notes for Reinforced Concrete Endwall - 5+d. Dwg.s 838.21 +hru 838.40

838.40 Reinforced Concrete Endwall- for Double and Triple 1800mm Pipes 90°Skew 838'38 Beinforced Concrete Endwall- for Single 1800mm Pipe 90°Skew 838.34 Reinforced Concrete Endwall- for Double and Triple 1650mm Pipes 90°5kew

838.33 Reinforced Concrete Endwall- for Single 1650mm Pipe 90°5kew 838.28 Reinforced Concrete Endwall- for Double and Triple 1500mm Pipes 90°Skew

E1/91/2

ROADWAY DESIGN ENGINEER

838.27 Reinforced Concrete Endwall- for Single 1500mm Pipe 90°Skew 838'SZ Keinforced Concrete Endwall- for Double and Triple 1350mm/400mm Pipes 90°Skew

838.21Reinforced Concrete Endwall- for Single 1350mm/1400mm Pipe 90°5kew 838.20 Brick Endwall for Outfall - 100mm, 150mm or 200mm Pipe

838.18 Brick Endwallfor Single Pipe Culverts - MO16mmx787mm thru M676mmx1295mm Pipe Arch 838.17 Brick Endwall for Sngl & DbiPipe Civrt-1016mmx787mm thru 1676mmx1295mm Arch 90°5kew 838,16 Brick 'L'Endwollfor Single Pipe Culverts - 432mmx330mm thru 1803mmx∥94mm Pipe Arch

838'ld Brick Eugwalltor 2ngl& Dblbibe Civrt-432mmx330mm thru 1803mmx1194mm Arch 30.2Kew

DIVISION 8 - INCIDENTALS (CONTINUED)

hereby are considered a part of these plans: N. C. Department of Transportation – Raleigh, N. C., Dated Janurary 15, 2002 are applicable to this project and by reference

The following Roadway Standards as appear in "Roadway Standard Drawings" Highway Design Branch -

ROADWAY METRIC STANDARD DRAWINGS

838-15 Brick 'L' Endwall for Single Pipe Culverts - 375mm thru 1200mm Pipe

854.01 Double Faced Concrete Barrier - Types I, II, III and IV 853.01Concrete Glare Screen - 455mm to 685mm Height 852,10 Median Construction - with Curb and Gutter 852.06 Method for Placement of Drop Inlets in Concrete Islands 852.05 Median Curb for Catch Basin - for Use with 450mm Curb and Gutter 852.04 Method for Placement of Drop Inlets in Grassed Median - Using 450mm (Urb and Gutter 852.02 Concrete Mountable Median - for Use with Rigid or Flexible Pavement 852,01 Concrete Islands

850.11.Cuide for Berm Drainage Outlet - 600mm and 800mm Pipe 850.10 Guide for Berm Orainage Outlet - 400mm and 450mm Pipe 850.0|Concrete Paved Ditches 848.05 Wheelchair Ramp - Curb Cut tuonnul teent Po.8P8 848.03 Driveway Turnout - Drop Curb Type 848.02 Drivewdy Turnout - Radius Type

846.02 Expressway Gutter Iransition for Drop Inlet

848.01 Concrete Sidewalk 846.01Concrete Curb, Gutter and Curb & Gutter

844.02 Brick Masonry Steps

845.03 Concrete and Brick Retaining Walls - with 0.ể㎜ Sprịcharge

842.02 Concrete and Brick Retaining Walls - with Sloping Surpharge 842.01 Concrete and Brick Retaining Walls - with No Surcharge DIVISION 8 - INCIDENTALS (CONTINUED)

METRICE)

LOK REVIEW RELEASE FOR CONSTRUCTION

SHEET NO.

B-2547CC

PROJECT REFERENCE NO.

857.01Precast Rein. Concrete Barrier-1.0m Single Faced (Beg. Jan. 2003 Let Use Detailin Lieu of Std.)

904.50 Mounting of Type 'D', 'E' and 'F' Signs on 'U' ChannelPosts

40904.40 Milepost and Placement pnithnow ngis bthemenaged Us. PUP 904.20 Secondary Sign Mounting 904.10 Orientation of Ground Mounted Signs 903.40 Median Barrier Sign Support and Anchorage 903.30 Barrier Sign Support Assembly tao9 ngi2 boow 05.208 903.10 Ground Mounted Sign Supports 901.70 Sign Stringers and Support Spacing 901.60 Rivet Spacing for Overlayed Signs 901.50 Arrows and Shields 901.40 VHB Tape Construction - for Type '8' Signs 301.30 VHB Tape Construction - for Type 'A' Signs 901.20 Type 'B' Signs - Welded Stud Construction 901,10 Type 'A' Signs - Welded Stud Construction

816.04 Drainage Ditches with Class 'B' Rip Rap

816.03 Drainage Ditches with Class 'A' Rip Rap

866.05 Clare Screen - Chain Link Fabric/Guardrall Mounted

866.04 Barbed Wire Fence with Wood Posts (2 - 7 Strands)

865.01Cable Guiderail(Beg. October 2002 Let Use Detailin Lieu of Standard)

854.05 Concrete Median Transition Barrier - Location of Overhead Assembly

866.0|Chain Link Fence - I.2m, I.5m and I.8m High Fence

854.04 Concrete Median Barrier - Precast Permanent

824.02 Double Faced Concrete Barrier - Types 'T', 'Ti' and 'T2'

876.02 Guide for Rip Rap at Pipe Outlets

866.03 Woven Wire Fence - with SteelPost

taod boow ntiw - sone aniw mevew 20.388

816.01Rip Rap in Channels

862.03 Structure Anchor Units

862.02 Guardrailinstallation

\$62,01 Guardrall Placement

905.10 Lighting System for Overhead Sign Assemblies

ECKED BA: DEPARTMENT OF TRANSPORTATION :3TAG

*Projects/MCDOT\r-2547\ccvdwyv2547cclBash INDEX' CEN' NOLES' SLDS

| RELEASE FOR CONSTRUCTION | |
|-------------------------------------|---------|
| PROJECT REFERENCE IC. PAGATICC IC. | METRICE |

8-15-2003

INDEX'CEN'NOLES'SLDS

DEPARTMENT OF TRANSPORTATION
TRANSPORTATION

ROADWAY METRIC STANDARD DRAWINGS

hereby are considered a part of these plans: N. C. Department of Transportation – Raleigh, N. C., Dated Janurary 15, 2002 are applicable to this project and by reference The following Roadway Standards as appear in "Roadway Standard Drawings" Highway Design Branch -

(1)Projects/WCDOTV-2547cc/vdwy/v2547cclCpsh

HECKED BA:

.YE NWAЯ

DATE:

:DATE:

1525.06 Precast Concrete Sanitary Sewer Manhole 1525.05 Precdst Concrete and Brick Sanitary Sewer Manhole 1525.04 Precdst Sanitary Sewer Drop Manhole - 1.5m Diameter 1525.03 Precast Sanitary Sewer Drop Manhole - 1.5m Diameter Outside Drop 1525.02 Precdst Sanitary Sewer Drop Manhole - L.2m Diameter Outside Drop 1525.01 Precdst Sanitary Sewer Manholes - 1.2m and 1.5m Diameter

DIVISION 16 - EROSION CONTROL AND ROADSIDE DEVELOPMENT

1636.01Rock Silt Screen $1000\,\mathrm{Mpc}$ gock bibe lulet 2eqiment 1rab 1ype $0.00\,\mathrm{Mpc}$ 1635.01 Rock Pipe Inlet Sediment Irap Type 'A' 1634.02 Temporary Rock Sediment Dam Type 'B' 1634.01 Temporary Rock Sediment Dam Type 'A' 1633.02 Temporary Rock Silt Check Type 'B' 1633,01 Temporary Rock Silt Check Type 'A' 1632.03 Rock Inlet Sediment Irap Type 'C' 1632,02 Rock Inlet Sediment Trap Type 'B' 1632.01Rock Inlet Sediment Trap Type 'A' 1630.05 Temporary Diversion 1630.04 Stilling Basin For Pumped Effluent 1630.03 Temporary Silt Ditch 1630,02 Silt Bdsin Type '8' 1630.01 Riser Basin 1622,01 Guide for Temporary Berms and Slope Drains 1606.01 Special Sediment Control Fence 1605.01 Temporary Silt Fence

DIVISION 17 - SIGNALS AND TRAFFIC MANAGEMENT SYSTEMS

sexod noitonutio.aili MIS.01 Underground Condult 1705.02 SignalHeads - Pedestrian Assemblies 1705.01 Signal Heads - Vehicular Signal Heads

ITSI.016uy Assemblies aelo9 boow 10.0271

1730,01 Fiber-Optic Cable - Spare Cable Storage ITS5.01Inductive Detective Loops

1733.01 Delineator Markers - Marker Installation 1730.02 Fiber-Optic Cable - Conduit Installation

Snoitbbnuol eloglbteM10.5471 səloqibtəMi0.047i

1743.01Pedestrian Pedestal - and Foundation Installation

1751,01 Controllers and Cabinets - Electrical Service Grounding

1752.01 Controllers and Cabinets - Power, Ground and Auxiliary 1751.02 Controllers and Cabinets - Electrical Service Detalls

BOADWAY DESIGN ENGINEER DESCRIBLION OF REVISION RELEASED FOR CONSTRUCTION KEAISIONS



| nai Court, | CROUP of Protessio bielgh, Nor | Þ06Þ | TE. | Aqj Aqj quori noitatroqenar |
|----------------|--------------------------------------|------|-----|--------------------------------------|
| | | | | |

MIS.OI Underpass Lighting IAII,01 Electrical Junction Boxes I410.01Feeder Circuits 1409,01 Electrical Duct MO8.01Light ControlSystem

1401,01 High Mount Standard

DIVISION 14 - LIGHTING

IS64.010bject Markers

1407,01 Electric Service Pole and Lateral 1406.01L1ght Standard Luminaires 1405,015tandard Foundation 1404.01Light Standards 1403.01High Mount Luminaires noitobnuot tauoM ApiHi0,50Pi

1267.03 Flexible Delinector - Interchanges

IS67.02 Flexible Delineator Spacing

1262,01 Guardrail End Delineation

IS50,01Pavement Marker Spacing

1205.12 Pavement Markings - Bridges

Notitolibtani notaenile Delineator installation

1264.02 Placement of Object Markers

1101,01 Work Zone Advance Warning Signs

1101.03 Temporary Road Closures 1101,02 Temporary Lane Closures

1101.06 Warning Signs for Biasting Areas

1101.07 Rolling Road Block Operation (Temporary Road Closure)

1101,11 Traffic Control Design Tables

1110.02 Portable Work Zone Signs - Mounting Height & LateralClearance 1110.015tatlonary Work Zone Slyns - Mounting Height & LateralClearance

III5.01Flashing Arrow Panels

130.07 Drums (Use Special Detail in Lieu of Standard)

1145.01 Barricades - Type I, II, III and Permanent

1165.01 Truck Mounted Impact Attenuator - Delineation 160.01 Temporary Crash Cushion - Reflective End Treatment

1170.01 Portable Concrete Barrier (Beg. October 2002 Let Use Detail

DIAISION 12 - PAVEMENT MARKINGS, MARKERS AND DELINEATION

1205,03 Pavement Markings - Interchanges

1205.04 Pavement Markings - Intersections

1205.06 Pavement Markings - Thru Lane Drops 1205.05 Pavement Markings - Turn Lanes

ISO2.08 Pavement Markings - Symbols and Word Messages

1205,09 Pavement Markings - Painted Islands

I205,11 Pavement Markings - Railroad Crossings ISO5,10 Pavement Markings - SchoolAreas

IS61.02 Guardrall and Barrier Delineator Types

ISBI.01 Guardrail and Barrier Delineator Spacing

IS53.01 Snowplowable Raised Pavement Markers

I205,07 Pavement Markings - Pedestrian Crosswalks

1205.02 Pavement Markings - Divided and Undivided Roadways

ISSI,01Raised Pavement Markers - Permanent and Temporary

ISO2.01Pavement Markings - Line Types and Offsets

in Lieu of Standard)

1101,05 Work Zone Vehicle Accesses

1101.04 Temporary Shoulder Closures

DIVISION 11 - WORK ZONE TRAFFIC CONTROL


- DIVISION 15 UTILITIES

0 S **4**

RALPH WHITEHEAD ASSOCIATES, INC.

P.O. BOX 35624 CHARLOTTE, N.C. 28235

ROADWAY DESIGN ENGINEER, 6/15/13 DESCRIBITION OF REVISION r2547cciD.psh P.O. BOX 35624 CHARLOTTE, N.C. 28235 North Carolina Constructors RALPH WHITEHEAD ASSOCIATES, INC. CONNENTIONAL SYMBOLS Document Control Number: THE LPA GROUP of Worth Corollno, p.o.
LPA
ABOA Protesslondlourt, Suite 201
OSOUPT, Suite 201
OSOUPT, Suite 201 _ :3TAO. HECKED BA: DEPARTMENT OF TRANSPORTATION
TRANSPORTATION SISIO KEAISIONS 76/92/2 P9SIN9 Astiwa CONC MM and End Wall SE 15**0**⊌FN# Signal Lines Cut Into the Pavement R Signal Milepost "Hilliam" Bridge Wing Wall, Head Wall Utility Power Line Connects to Traffic CSX TRANSPORTATION CONC Bridge, Tunnel, or Box Culvert Standard Gauge \otimes Television or Radio Tower MAJOR E RAILROADS Existing Endangered Plant Boundaries Fiber Optic Splice Box VINEYARD SIKUCTURES Vineyard Š Traffic Signal Junction Box Existing Endangered Animal Boundaries 무용무용무 Orchard Ø <<<<Prop Lateral, Tail, Head Ditches Water Tank With Legs Proposed Wetland Boundaries Moods Line \bigcirc Tank; Water, Gas, Oil Existing Wetland Boundaries agbeH Shoreline Fence Line Storm Sewer Manhole Single Shrub 不 (9) Swamp Marsh Sanitary Sewer Manhole Parcel Number Single Tree (123) W Property Number Power Transformer **NECELVLION** Disappearing Stream M23 Property Monument Telephone Manhole \hat{X} esuoH thgiJ WOTA WOLT Property Corner Gas Meter Trail, Footpath Stream or Body of Water Exist. Iron Pin Gas Valve **egbindtoo**7 HXDKOTOGK Э Property Line Symbol Pole with Base Culvert \boxtimes Property Line Power Line Tower ----- 904 ------Prop. Perm. Drainage Easement Line Ferry Reservation Line H-Frame Pole ----- 301-----Prop. Temp. Drainage Easement Line 5000000 Box Culvert or Tunnel City Line elo9 thgiJ Prop. Temp. Construction Easement Line Bridge Water Manhole Jownship Line - - -3- - -Exist. Easement Line Paved Walk County Line Telephone Booth Prop. Control of Access Line Guard Post eniJ etat2 Exist. Control of Access Line Right of Way Symbol M/A BOUNDARIES & PROPERTIES Sewer Clean Out Concrete or Granite) R/w Marker Exist. Water Valve Prop. Right of Way Line with Proposed End of Information Change in Road Surface AziQ etilleta2 R/W marker (Iron Pin & Cap) AUTIA Abandoned According to UVG Record Hard Surface Hydrant 3 U/G Test Hole (S.U.E.*) Prop. Right of Way Line with Proposed Loose Surface Cable TV Pedestal $\overline{}$ Exist. Right of Way Line wMarker Exist. Water Meter TOPOGRAPHY ---- to -----Intrebeq enoriqueT Designated Fiber Optics Cable (5.U.E.*) Existing Right of Way Marker loo9 gnimmiw2 ---- £0 ----- £0 -----Prop. Joint Use Pole Baseline Control Point Recorded Fiber Optics Cable RIGHT OF WAY eniM Ilama -- vI -- - vI-- elog esU tniol .tsix3 Designated Television Cable (5.U.E.*) ô ---- VI ----- VI -----Prop. Telephone Pole Recorded Television Cable • Pavement Removal ußiS ----- JTUS-----Unknown Utility (S.U.E.*) Exist. Telephone Pole Equality Symbol Prop. Cable Guiderail - -31--31- -(*.3.U.2) tiubno anoridale TVU betangised Dam Prop. Power Pole 4 Exist. Cable Guiderail Cemetery -----11-----1t-----Recorded UV Telephone Conduit Exist. Power Pole Prop. Guardrail Park ------Designated Telephone Cable (S.U.E.*) Exist. Pole Exist. Guardrail loodos WCF8 **CLITILIES** Recorded Telephone Cable Curb Cut For Future Wheelchair Ramp Сһитсһ Prop. Wheelchair Ramp - -4- -4- --(*.3.U.2) eniJ rewo9 betangizeQ Paved Ditch Gutter Prop. Barbed Wire Fence Gas Pump Vent or U/G Tank Cap Recorded Power Line GB CB Prop. Chain Link Fence Storm Sewer **Footbridge** Area Outline --0---(*.3.U.2) eniJ soD betangiseQ Prop. Slope Stakes Fill Pipe Culvert Foundations Recorded Gas Line ---5---Prop. Slope Stakes Cut Head & End Wall sgnibliu8 Designated Sanitary Sewer Force Main(S.U.E.*) **WINOK** Edge of Pavement Recorded Sanitary Sewer Force Main BUILDINGS & OTHER CULTURE -----\$\$-----\$S Sanitary Sewer KOVDS & KETVLED ILEWS Designated Water Line (5.U.E.*) CONVENTIONAL SYMBOLS Recorded Water Line *S.U.E = SUBSURFACE UTILITY ENGINEER E00Z-21-8 SXVAIROH 30 NOISIAID RELEASE FOR CONSTRUCTION ANLIOAAD HTAON AO ATATS METRICE B-2547CC

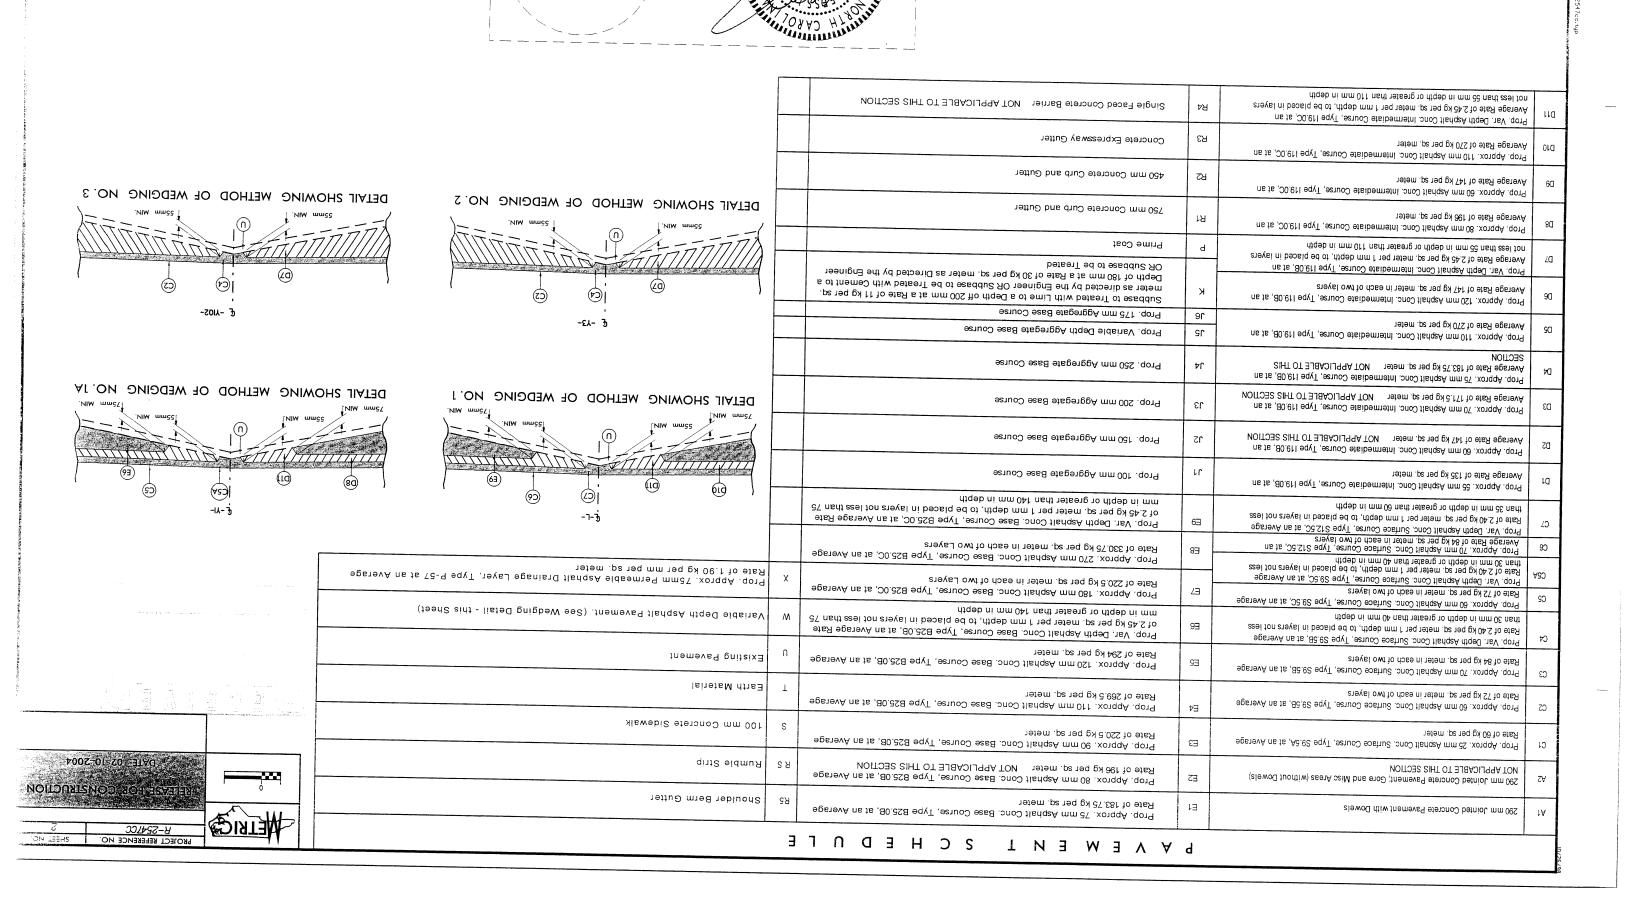

ROADWAY DESIGN ENGINEER

-0-01-SAFEREREE OF SAFEREREE

DESCRIBLION OF REVISION

SEI 665/NCDOT COMMENTS

REVISED TITLE BLOCK

KEAISIONS

RELEASED FOR CONSTRUCTION

ADDED RS SHOULDER BERM GUTTER

STAG : YE LONG

0)

North Carolina Constructors

P.O. BOX 35624 CHARLOTTE, N.C. 28235

COMPONE LING ENGINEERS

THE LPA GROUP OF NOrth Carolina, p.

18-12-03

18-52-03

111-14-03

1254700.TYB

recurrent Control Number

CHECKED BA:

DRAWN BY:

DAIE:


:3TAG


TYPIOAL SECTIONS


SMA19 JAMIR


DEPARTMENT OF TRANSPORTATIONS


MEDARTMENT OF TRANSPORTATION

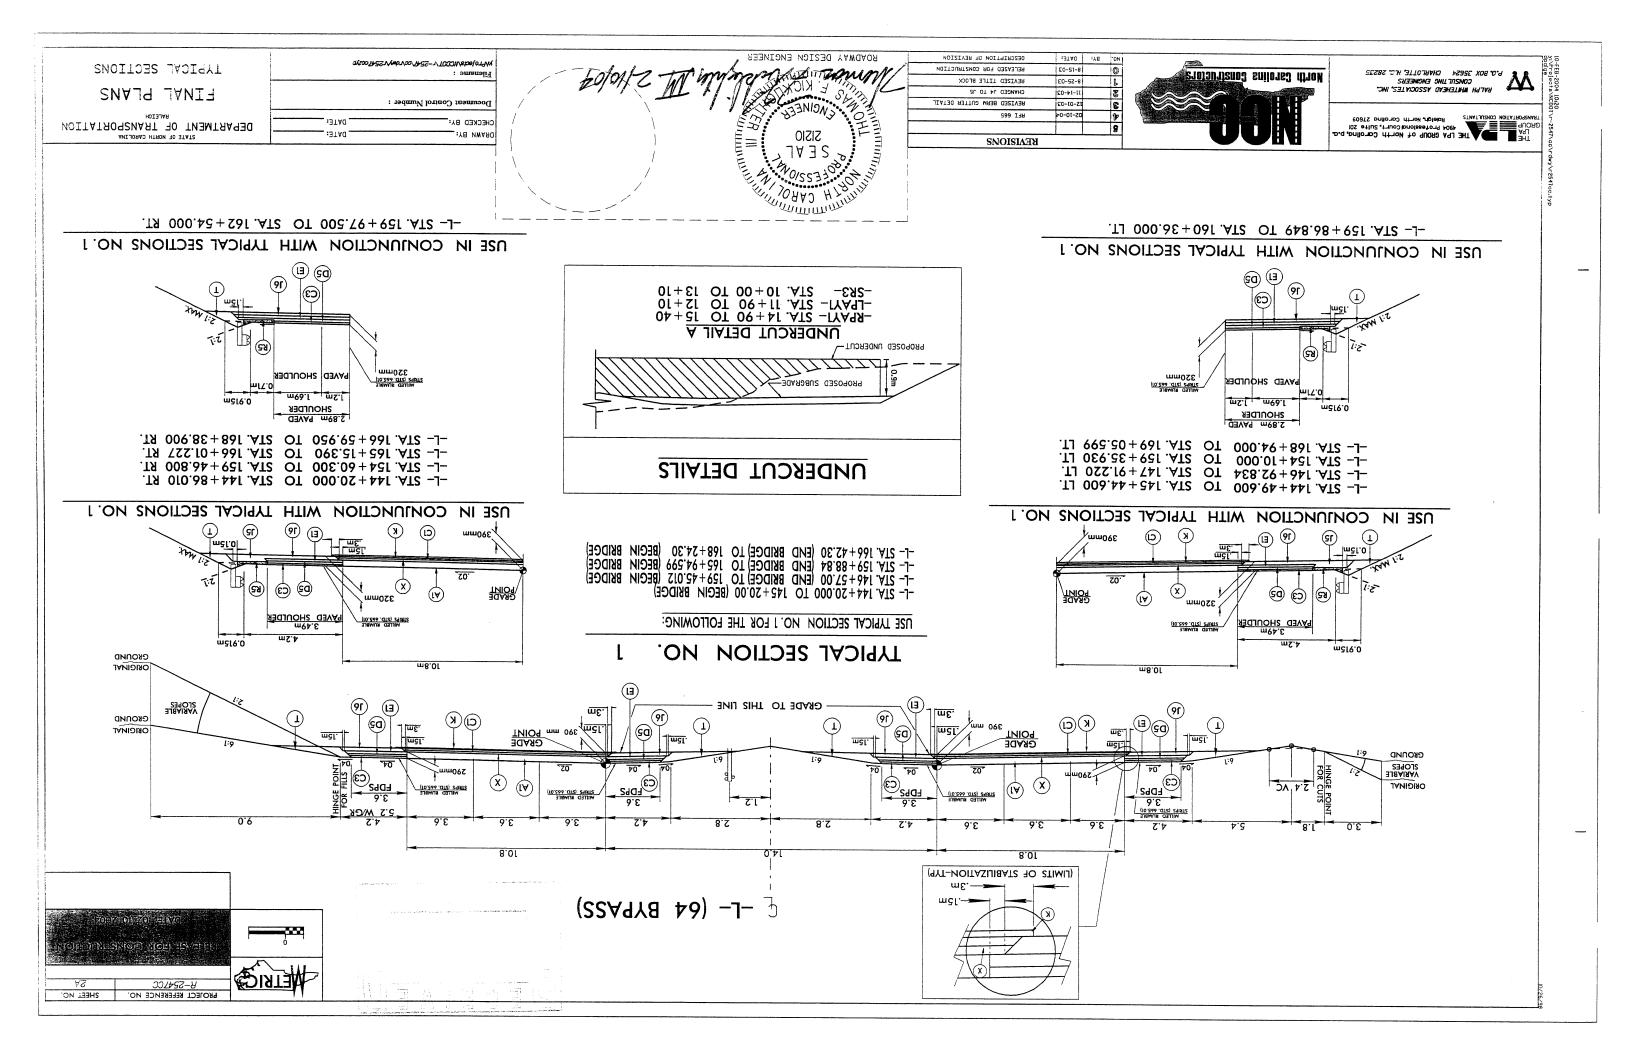


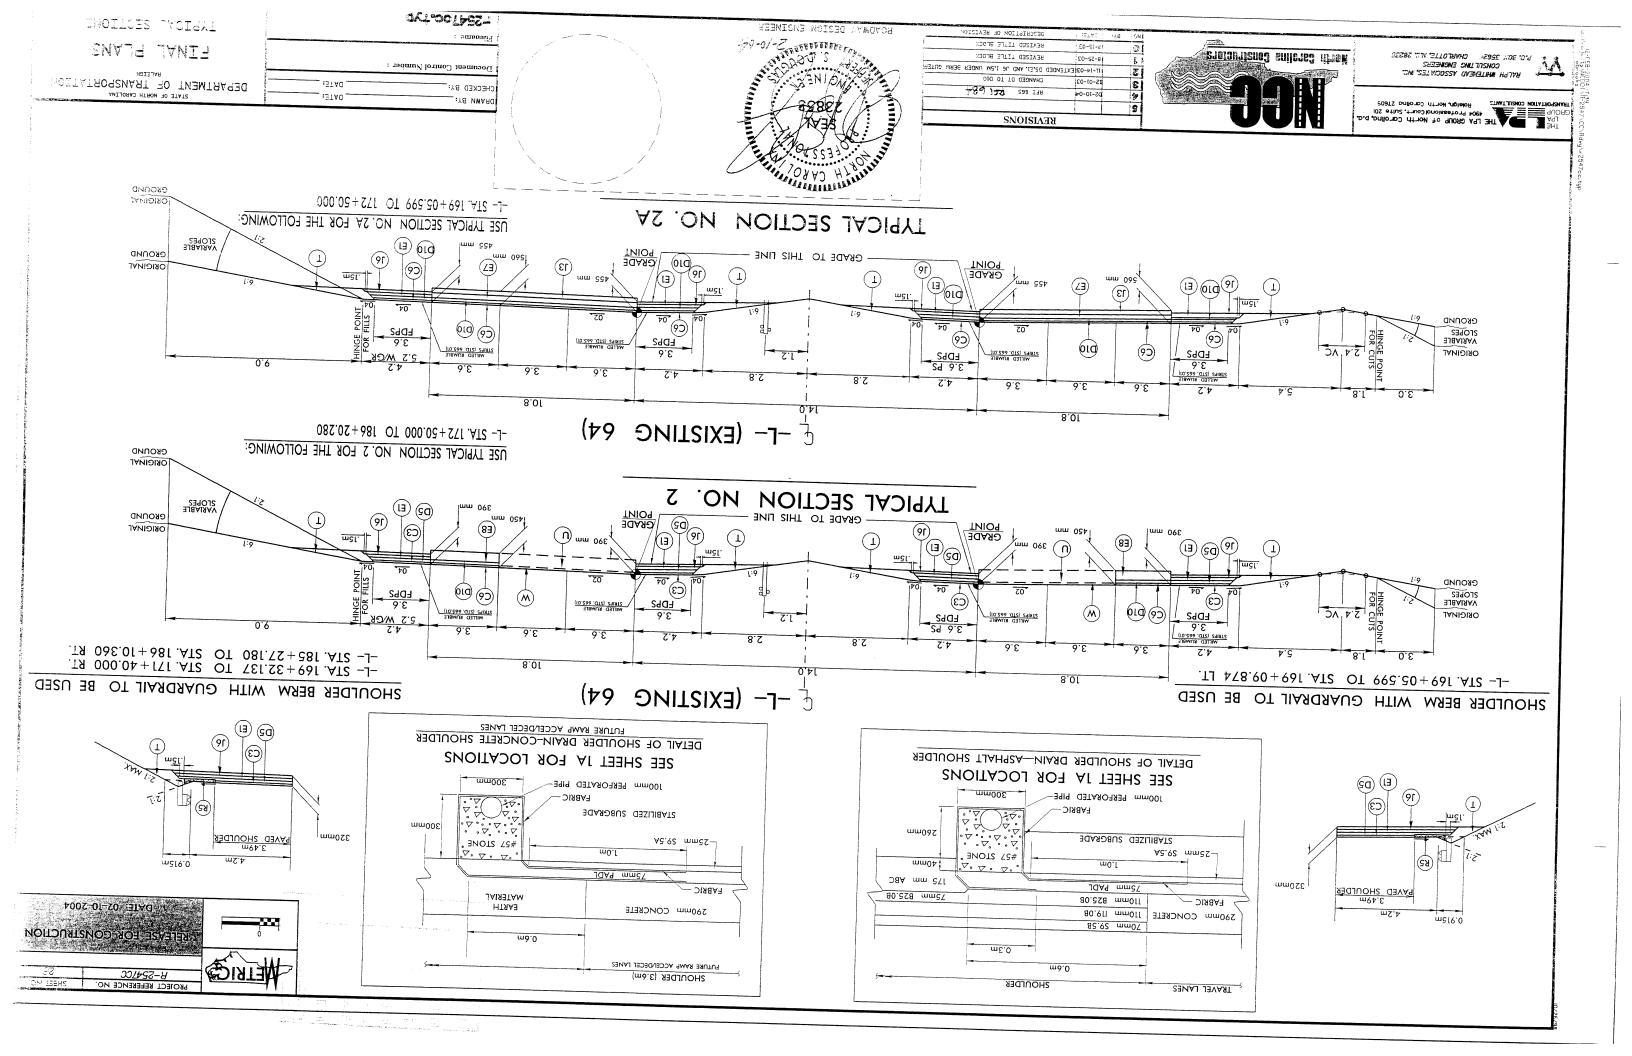


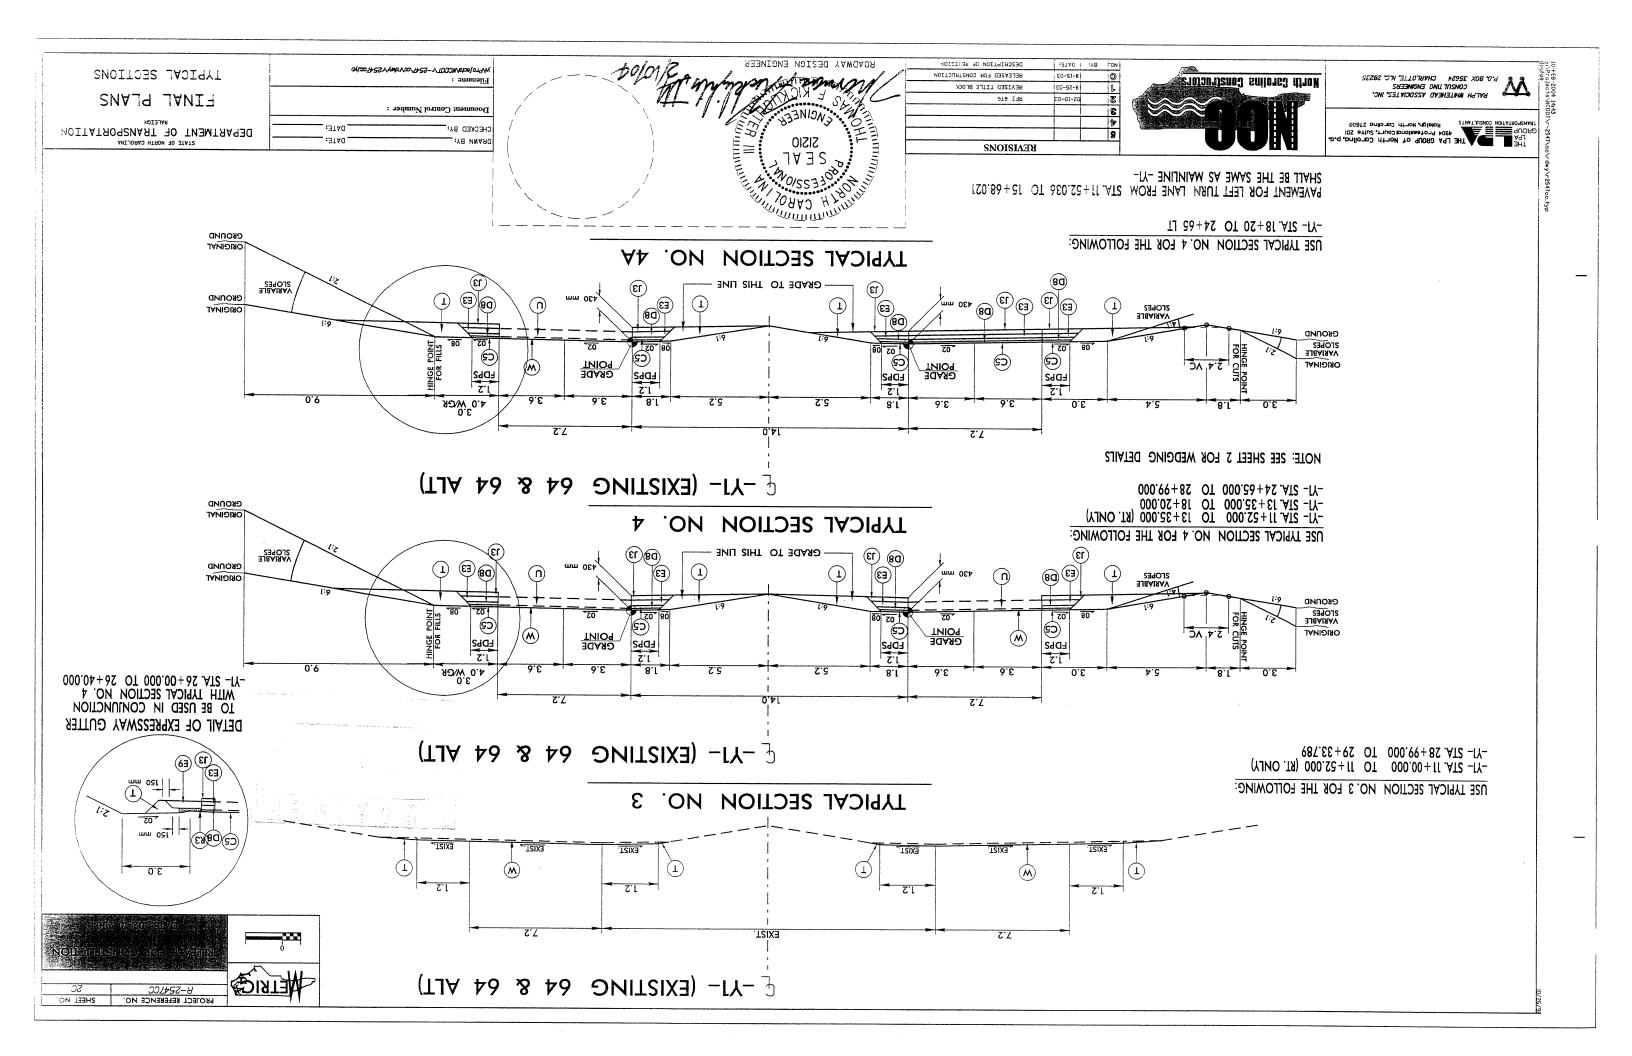


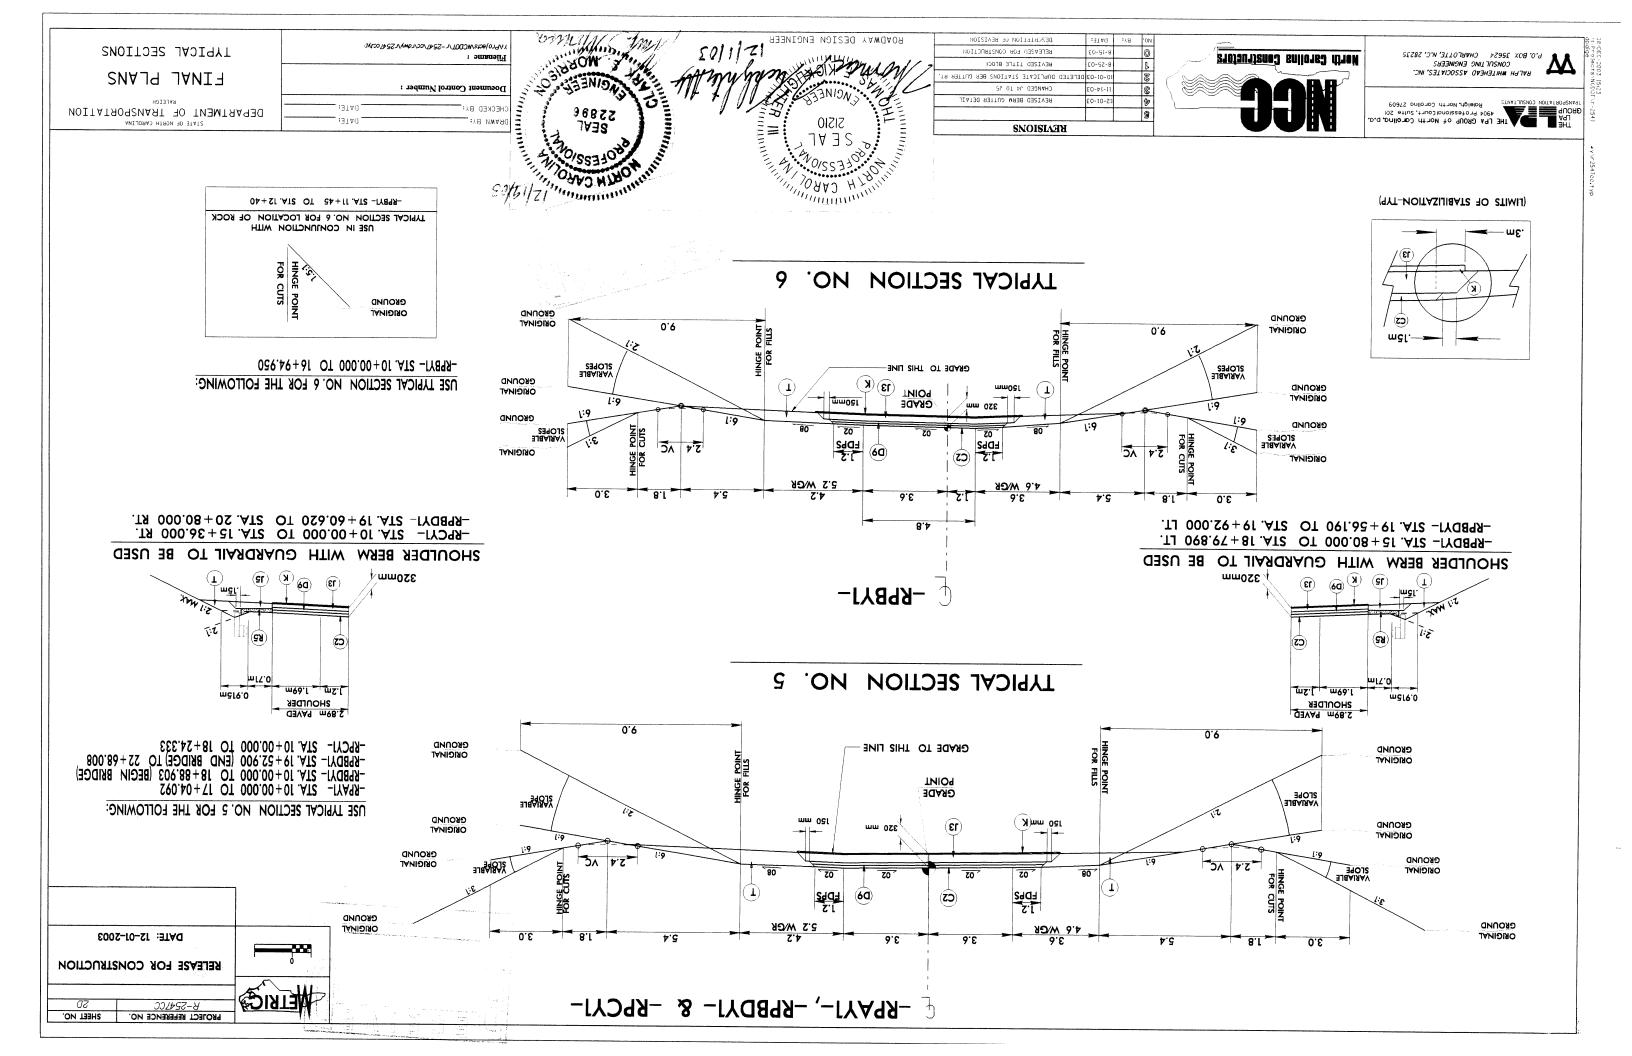


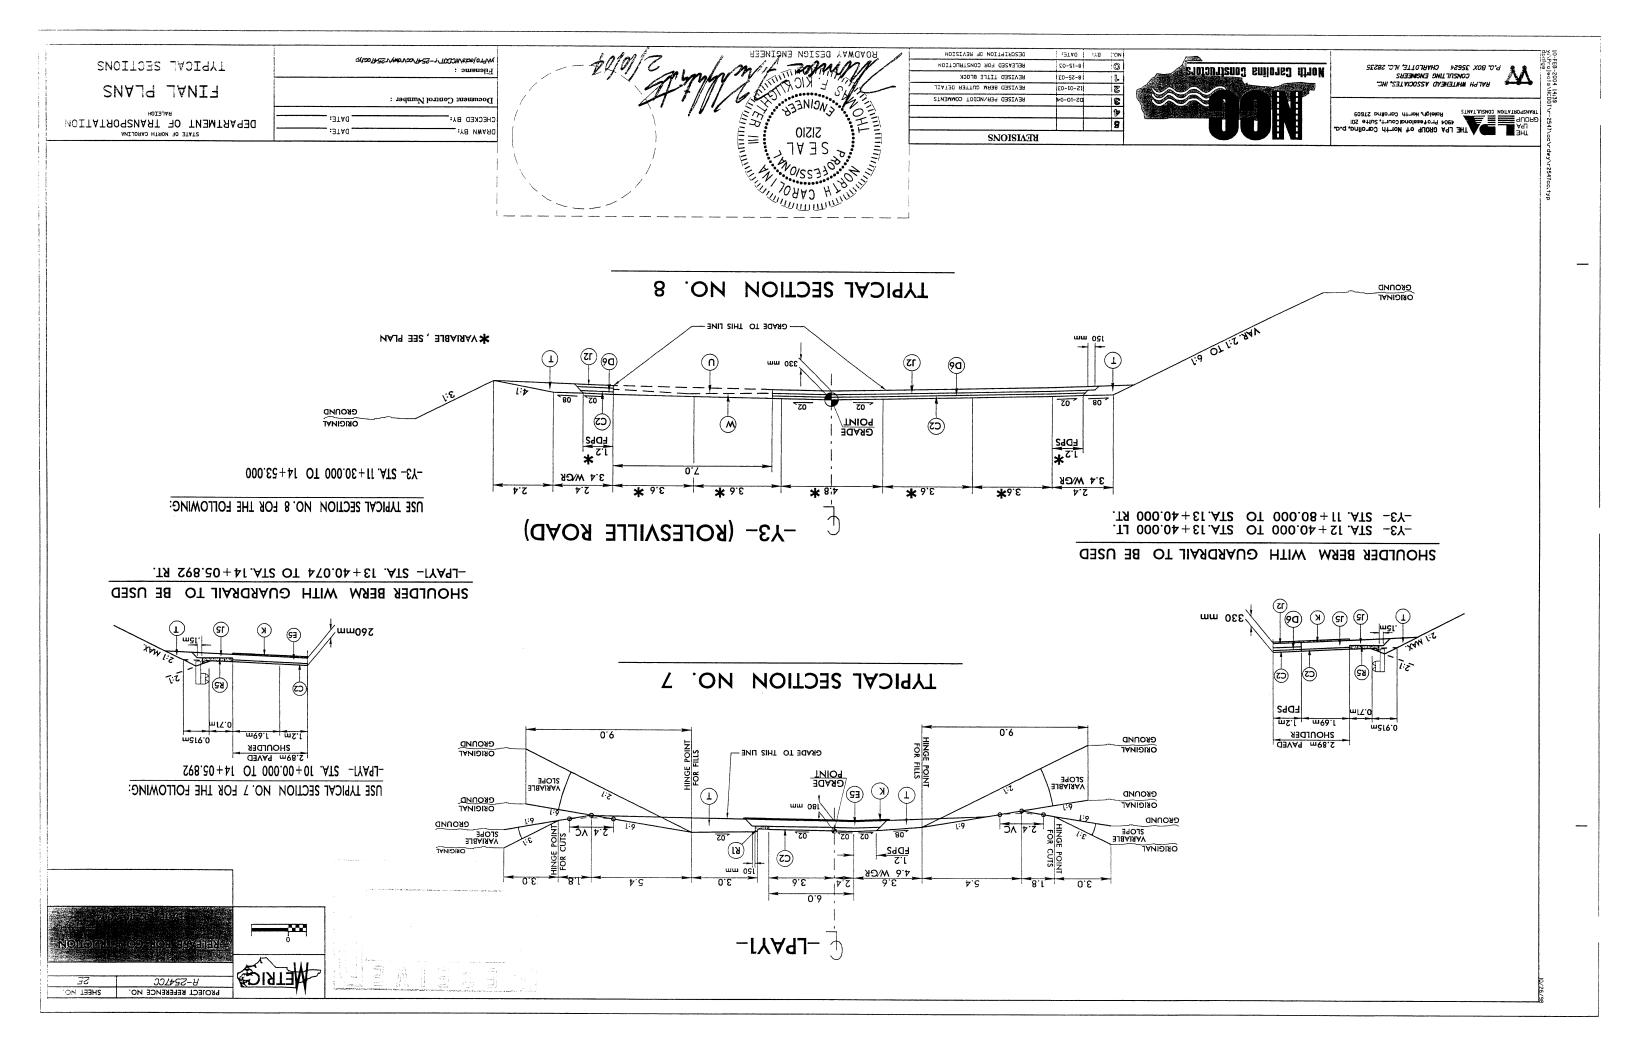


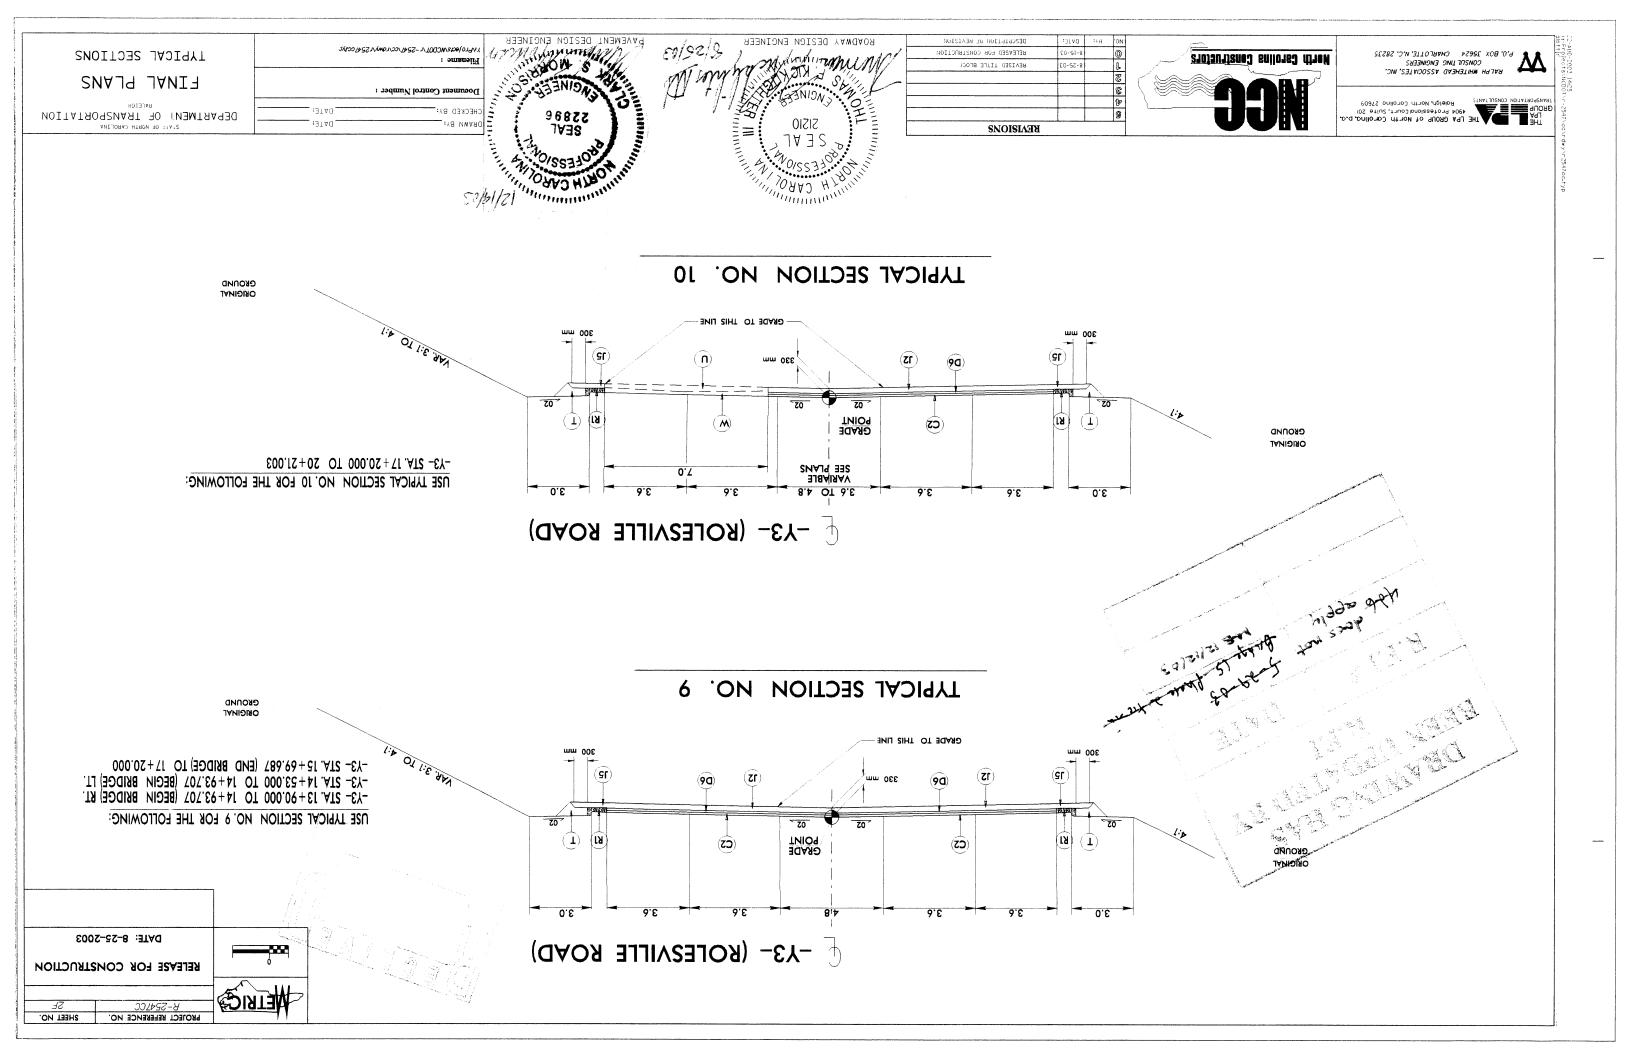


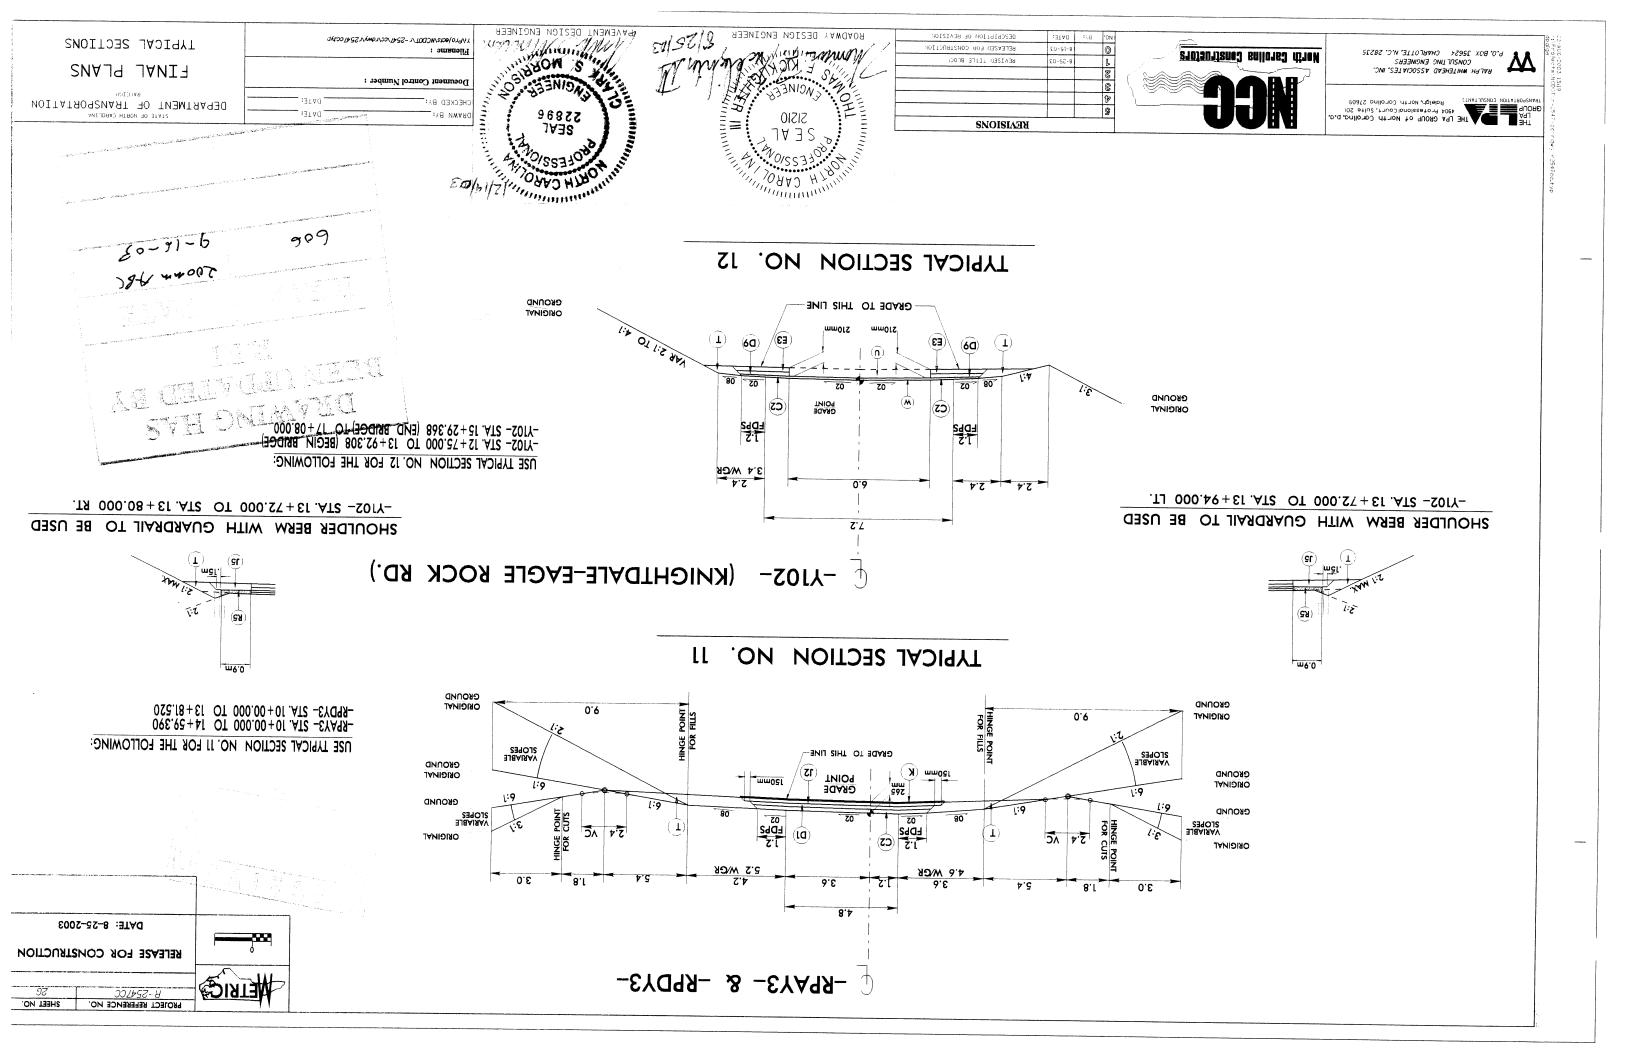

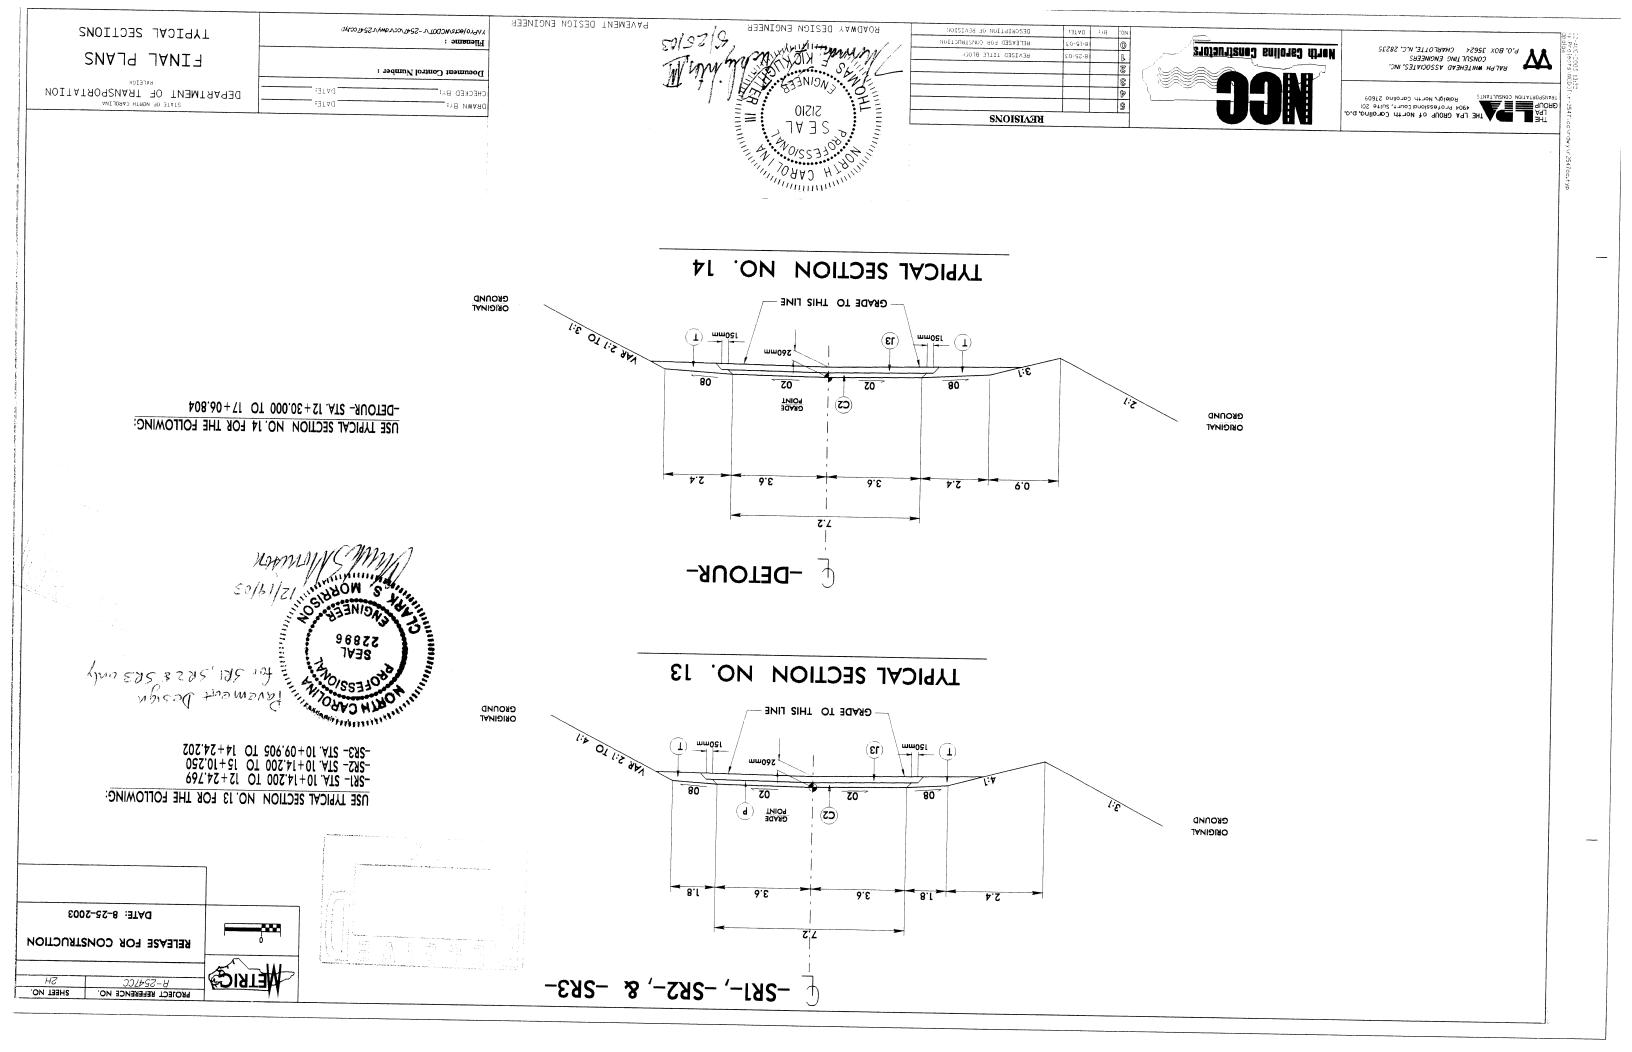

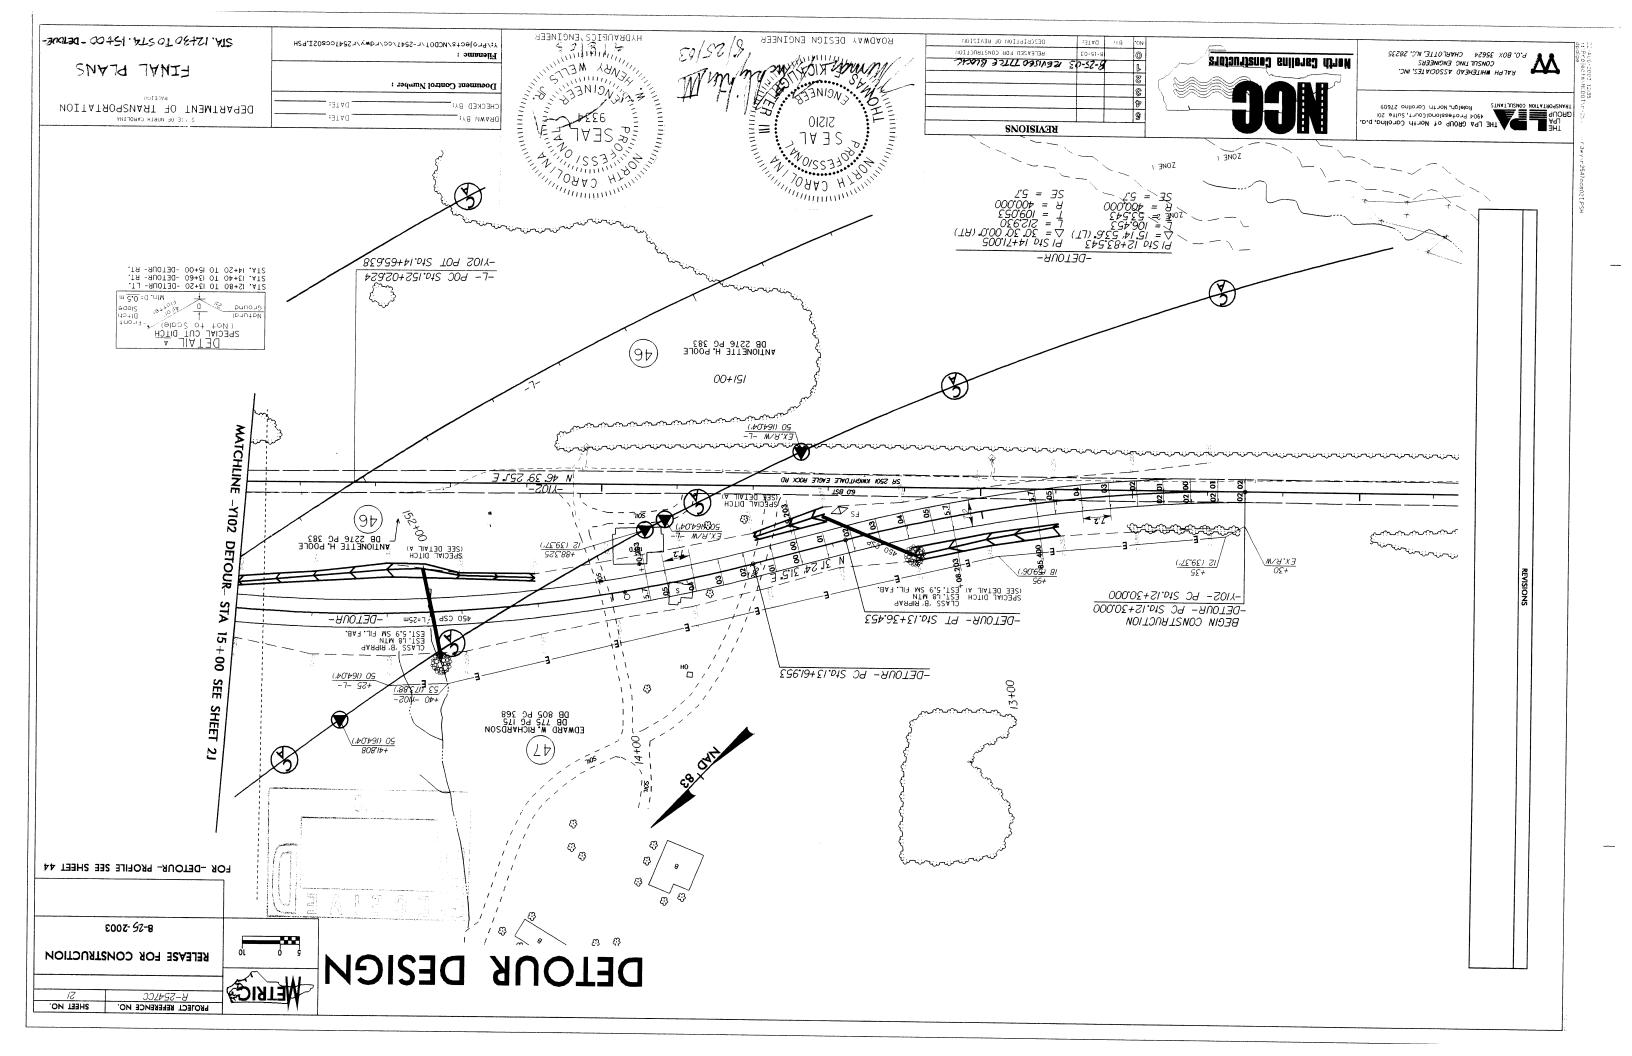


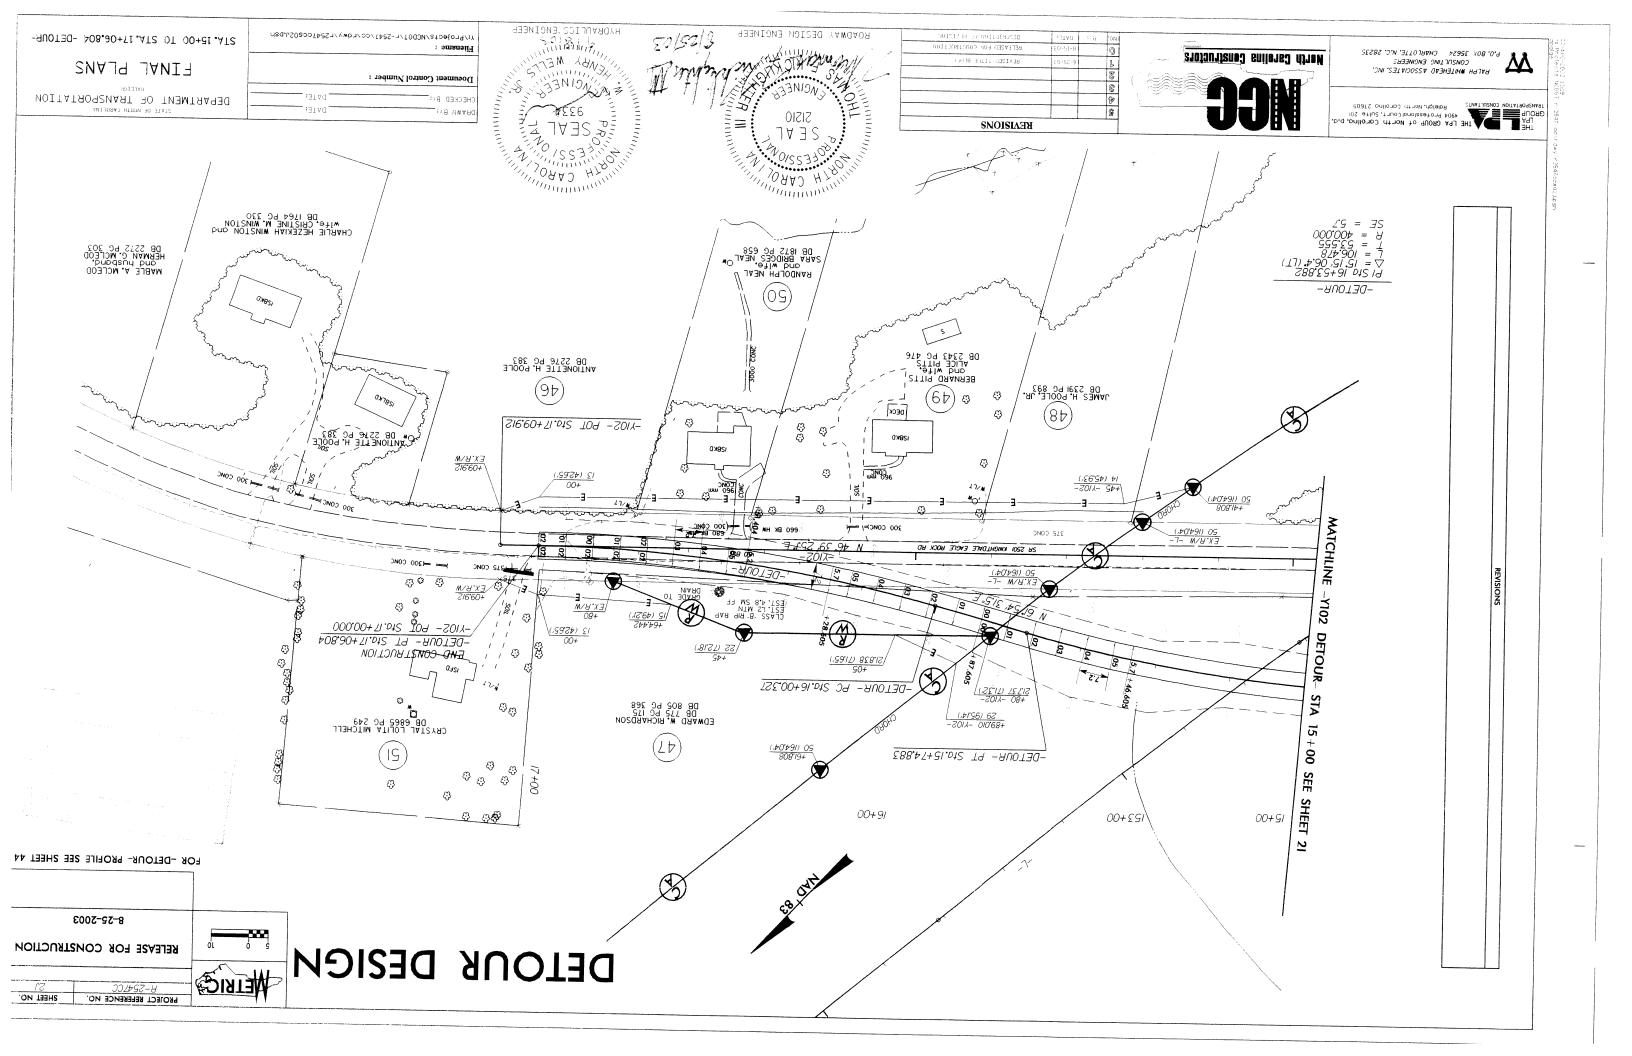


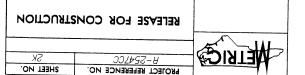



DATE: 8-25-2003

DELVIE SHEEL NATURAL STREAM DESIGN

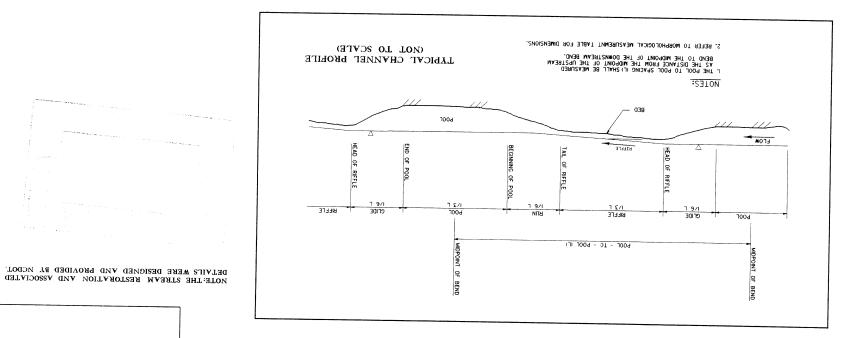

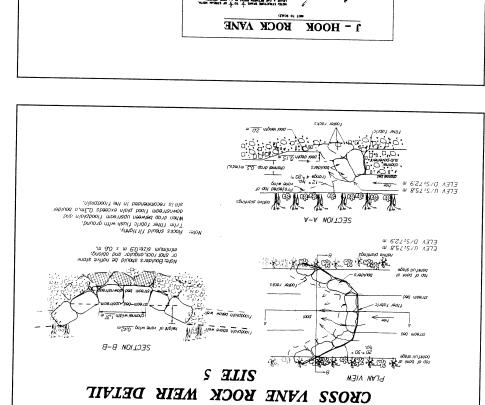

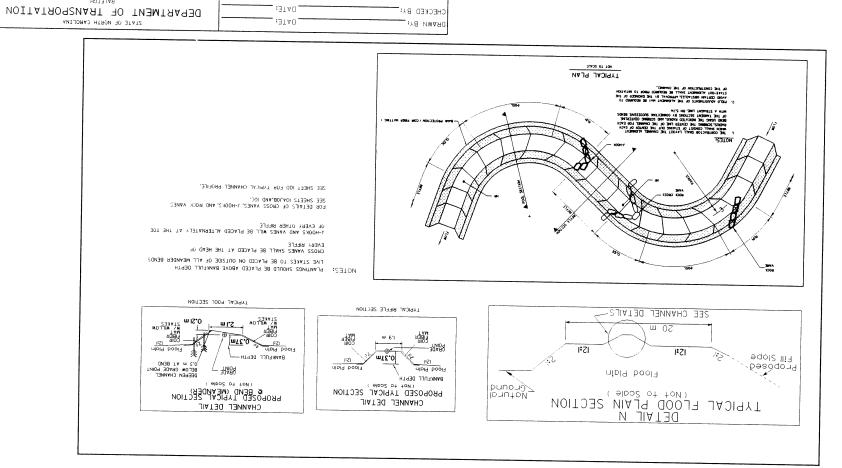

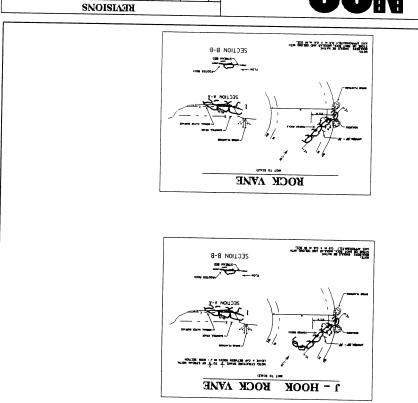

| KEAISIONS | | |
|---------------------------|---------|---|
| | | g |
| | | Û |
| | | 8 |
| | | 8 |
| REVISED TITLE BLOCK | 8-25-03 | 0 |
| RELEASED FOR CONSTRUCTION | 8-15-03 | 0 |

DESCRIBLION OF REVISION



THE LPA GROUP Of North Corolling, p., ROUP OF North Corolling, p., ROUP Professional Court, Suite 201-84054 Professional Court, Suite 201-84054 Professional Consultance 27609

POU BOX 35624 CHARLOTTE, N.C. 28235

FINAL PLANS

NATURAL STREAM DETAIL SHEET

TYPROJECTS WCDOTV-254TVCCVOMYV254TCCSO2K.DSh Document Control Number :

HECKED BX:

:DVIE:

BELEASED FOR CONSTRUCTION

Stotaurismed smileted after

RALPH WHITEHEAD ASSOCIATES, INC. CONSULTING ENGINEERS
P.O. BOX 35624 CHARLOTTE, N.C. 28235

THE LPA CROUP of North Carolina, p.a.
LPA 4904 Professional Court, Suite 201
PROFILE STATES CAROLING 2025


Y:VP(0)OCTSMCDOT/r-2547/cc/vowy/v2547ccs02Lpsh


DEPARTMENT OF TRANSPORTATION

MATURAL STREAM DETAIL SHEET

LINAL PLANS


DESICN ZLKEVM JAAUTAN

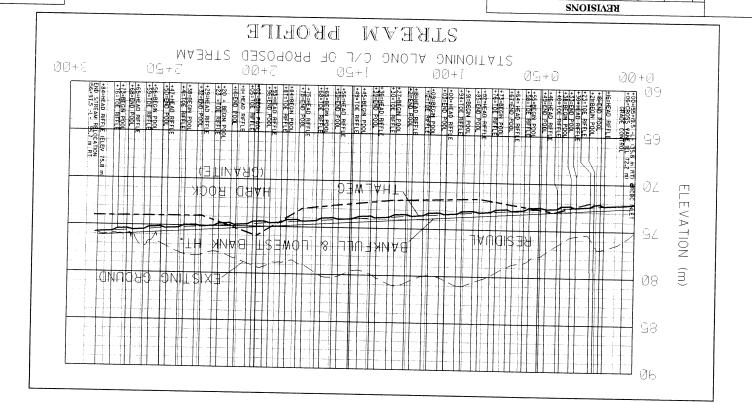


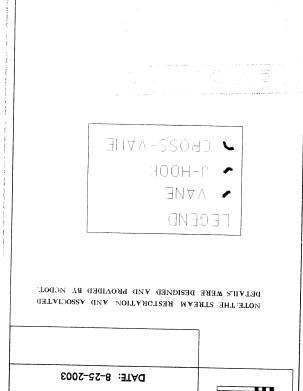



RELEASE FOR CONSTRUCTION


PROJECT REFERENCE NO. SHEET NO.

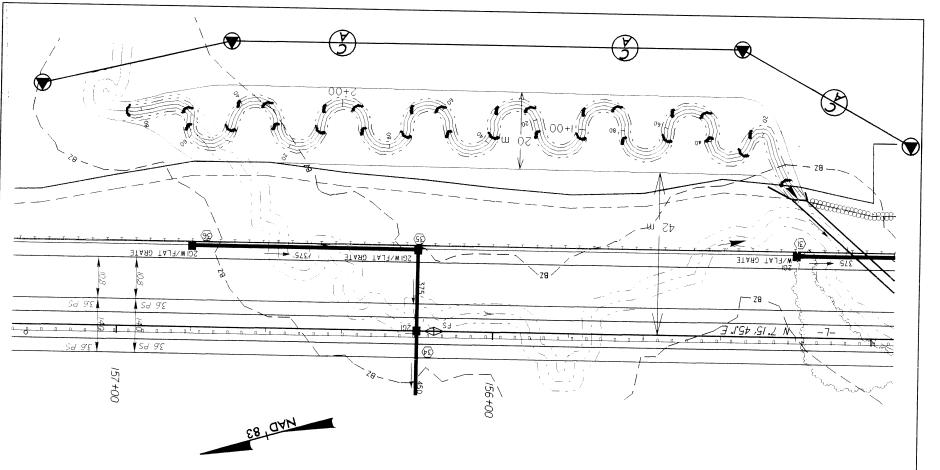

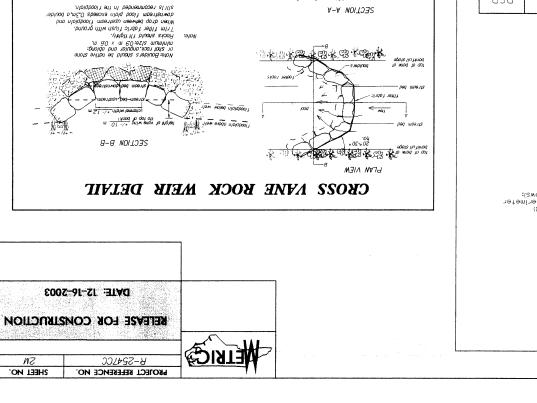

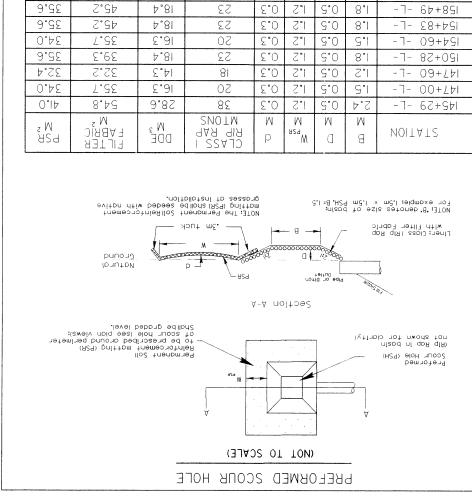

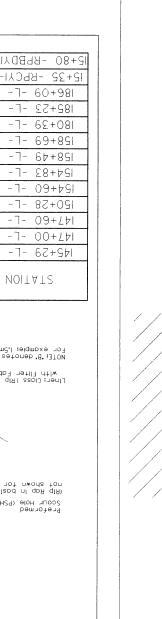

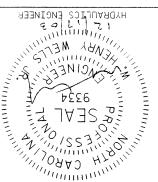

Σ.Σδ

7,85

S.SE

7.25

S.SE

2.24

52,4

0.45

9.25

۱۹,3

۱۹,3

۱9°٤

5.41

b.81

81

81

SO

81

SΖ

| KEAISIONS | | | |
|---------------------------|----------|----|-----|
| | | | 9 |
| | | | P |
| ADDED CROSS VANE DETAIL | 15-16-03 | | 8 |
| REVISED STATIONS FOR PSH | 10-01-03 | | 2 |
| BEATZED 111FE BFOCK | £0-97-8 | | ß |
| MELEASED FOR CONSTRUCTION | 8-19-03 | | 0 |
| DESCRIBITION DE BEAISION | :3FAG | ∵8 | .ои |

| 8 | 'ON | , |
|---|-----|---|
| | 0 | / - |
| | ß | |
| | 2 | |
| | 8 | |
| | 10 | \ |
| | 9 | |
| | | |

.хрш шд.О

Keintorcement Mat-

Permenant Soil

CONCRETE PAVED DITCH LEVEL SPREADER

BUFFER

TRE



min.

CONC. DITCH

LEVEL SPREADER DETAIL

M 9AA 9IA OM.

(NOT TO SCALE)

MATURAL GROUND

| | | | SINVEN | PORTATION CONSI |
|----------|-----------------|------------|--------|-----------------|
| 90915 | orth Carolina | Boleion. N | | 7 = = an |
| ios etiu | sional Court, S | seatony M | 061 | |
| | of North (| 100110 14 | | ₩ ٧٥ |

APPROXIMATE STA, I2+20 -Y3- RT, APPROXIMATE STA, 181+00 -L- RT. APPROXIMATE STA, 158+70 -L- RT,

APPROXIMATE STA, 158+45 -L- LT,

APPROXIMATE STA, 154+80 -L- LT.

APPROXIMATE STA. 150+00 -L- LT & RT.

SECTION-AA

ADER

PLAN VIEW

PIPE OR DITCH-

RALPH WHITEHEAD ASSOCIATES, INC.

P.O. BOX 35624 CHARLOTTE, N.C. 28235

FINAL PLANS

TA M8.84

79 Ma.14

79 MP.05

OFFSET

17+77 -RPBDYI

7+83.5 -RPBDYI

14+73 -RPCYI-

NOITATS

DEPARTMENT OF TRANSPORTATION

PREFORMED SCOUR HOLE

AND LEVEL SPREADER DETAIL

- DATE: -

HOLOJOCIEMCDOLA-SPYLCCAGMYASPYLCCEOSMOBY

TE NWAR

P.O. BOX 35624 CHARLOTTE, N.C. 28235 CONSULTING ENGINEERS RALPH WHITEHEAD ASSOCIATES, INC.

THE LPA GROUP of North Corollno, p.o. 6005ULTANTS ROINGN North Corollno 27609

NOTCH CAFOLINA CONSTRUCTORS

SEE ROADWAY PLANS

| DESCRIPTION OF REVISION | :31 AO | :48 |
|---------------------------|----------|-----|
| RELEASED FOR CONSTRUCTION | 18-12-03 | |
| REVISED TITLE BLOCK | 8-25-03 | |
| | | |
| | | |
| | | |
| | | |

KEAISIONS

HYDRAULICS ENGINEER AN SANISMAN # 14NO 9334 DRAWN BY: REAL SEAL TORAN HYMIN

SEE ROADWAY PLANS

THE COSOSORIAL TO A SOUTH A SO MODIFIED CONCRETE FLUME DETAIL

FINAL PLANS

DATE:


DEPARTMENT OF TRANSPORTATION


- CONSTRUCT MODIFIED CONCRETE FLUME AND SHOULDER BERM GUTTER IN ACCORDANCE WITH THIS DETAIL.
- CONSTRUCT CONCRETE DITCH IN ACCORDANCE WITH STD. DWG. NO. 860.01.
- CONSTRUCT RIP RAP LINED DITCH HALL BE THE TYPE AND LENGTH SPECIFIED BY THE ROADWAY PLANS.
- CONCRETE OR RIP RAP LINED DITCH HALL BE THE TYPE AND LENGTH SPECIFIED BY THE ROADWAY PLANS.
- MODIFICATIONS SHALL BE AS DICTATED BY SITE CONDITIONS AND DIRECTED BY THE ENGINEER. моргиртсн depicted within the drawing. MODFLMDTCH SHEET 1 OF 1 militmeters unless otherwise SHEET 1 OF 1 This drawing is dimensioned in : elon RIP-RAP LINED DITCH METRIC DETAIL DRAWING MODIFIED CONCRETE WITH CONCRETE OR RIP-RA FLOW DIVERSION EXAMPLES DOWN GRADE <u>9∀S</u> METRIC DETAIL DRAWING FOR MODIFIED CONCRETE FLUME WITH CONCRETE OR RIP-RAP DITCH 009 LCOM DIVERSION FLOW 8 -LOM DIVERSION-MATER 1500 FLOW MATER. WOJJ MATER **(A) SECLION B-B** DUTLET FLOW **LLOW DIVERSION** 100 P **MATER** (D) OUTLET 200 DOWNGRADE OR SAG OUTLET DRAWING MATER FLOW A-A MOITDAR SECTION C-C 100mm CONC. PAVED DITCH **ЗНОИГDER ВЕРМ GUTTER** -RAP 1152 100 OH BEGINNING SEE PLANS FOR PLACEMENT 71 009 SUIDAA mm£ DITCH SEE PLANS **FOR** 200 HIDNET ELENGTH 1500 PLAN VIEW APPROACH END IRAILING END MODIFIED CONCRETE FLUME PAY LIMITS - PER EACH BRIDGE APPROACH SLAB VPPROACH SLAB ▼ BRIDGE MODIFIED CONCRETE FLUME PAY LIMITS - PER EACH NOITISMART MO.8 NOITISNAAT mo. & - CONSTRUCTION JOINT CONSTRUCTION JOINT TNEMEVA9 40 OUTER EDGE .NIM M8.7 OUTER EDGE OF PAYEMENT-BRIDGE RAIL TRANSITION TO FLAT FACE OR 200mm X 100mm LIP CURB STATE OF
NORTH CAROLINA
DEPT. OF TRANSPORTATION
DIVISION OF HIGHWAYS
RALEIGH, N.C. DNIVAG TJAHGA. ASPHALT PAVING STATE OF
NORTH CAROLINA
DEPT. OF TRANSPORTATION
DIVISION OF HIGHWAYS
RALEIGH, N.C. DEPRESSION OUTLET OUTLET OUTLET 006 . н шшоов 300mm R. BERM GUTTER BERN GUTTER ලු පු OMEL BARS / 100MEL BARS / 300mm #19 . AAV

DATE: 8-25-2003

RELEASE FOR CONSTRUCTION

PROJECT REFERENCE NO. SHEET NO.

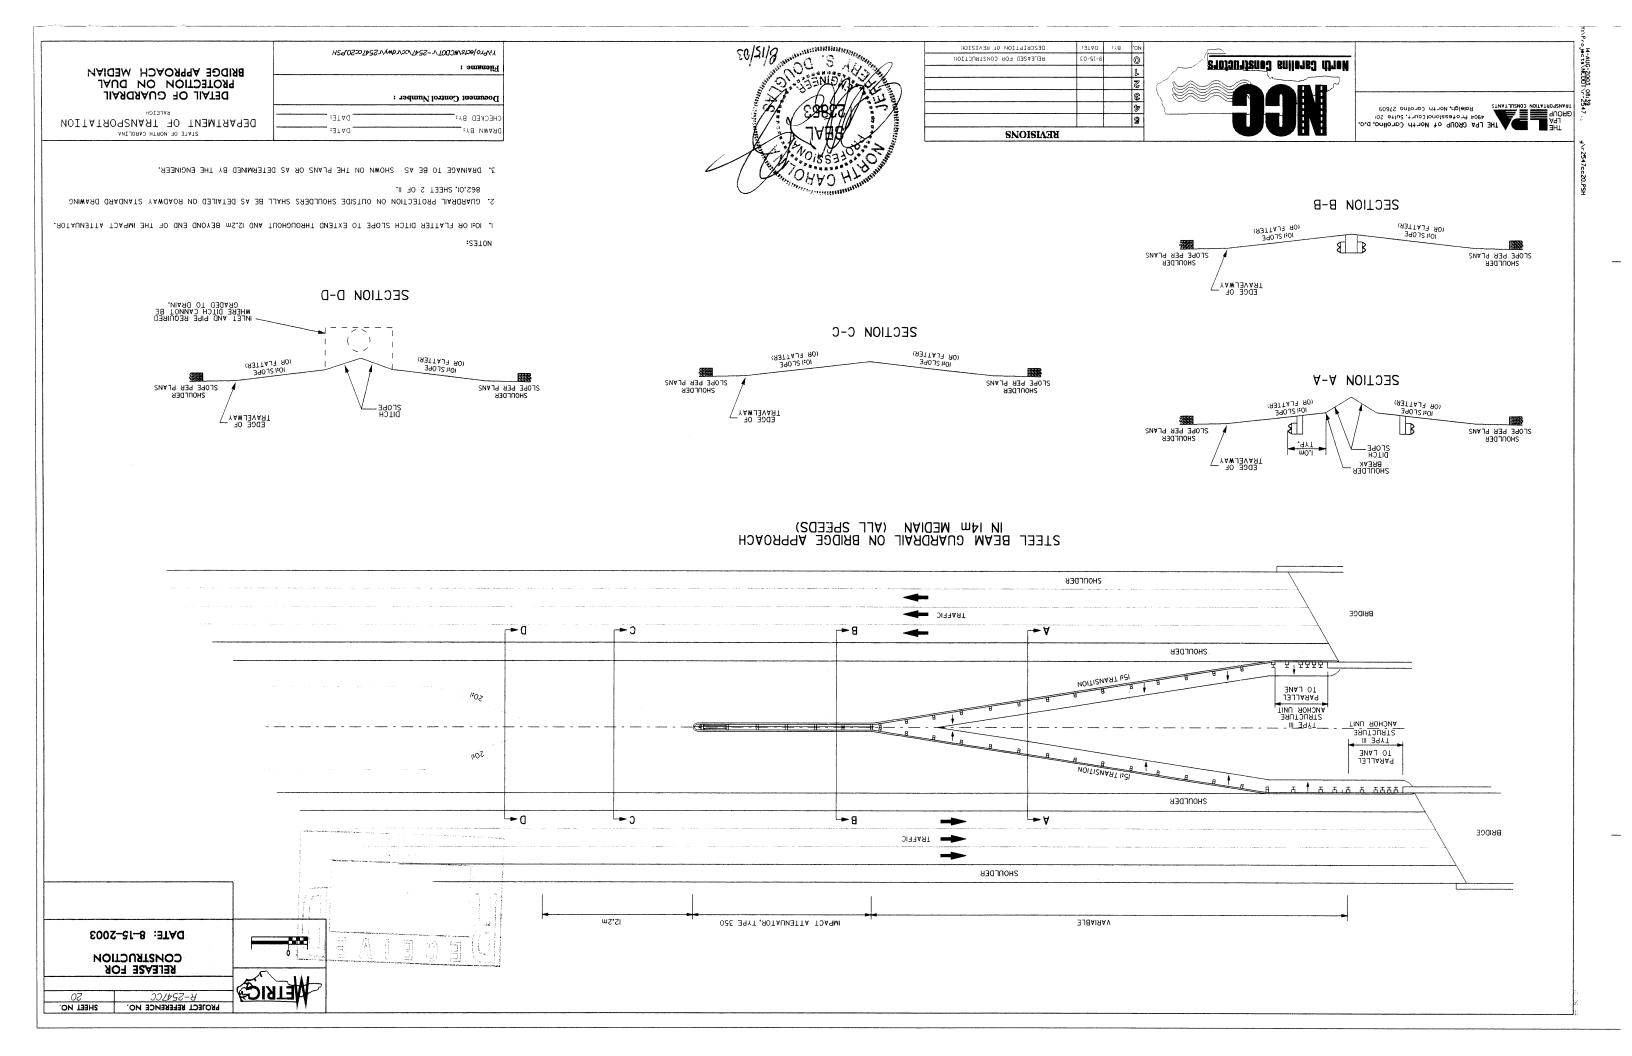

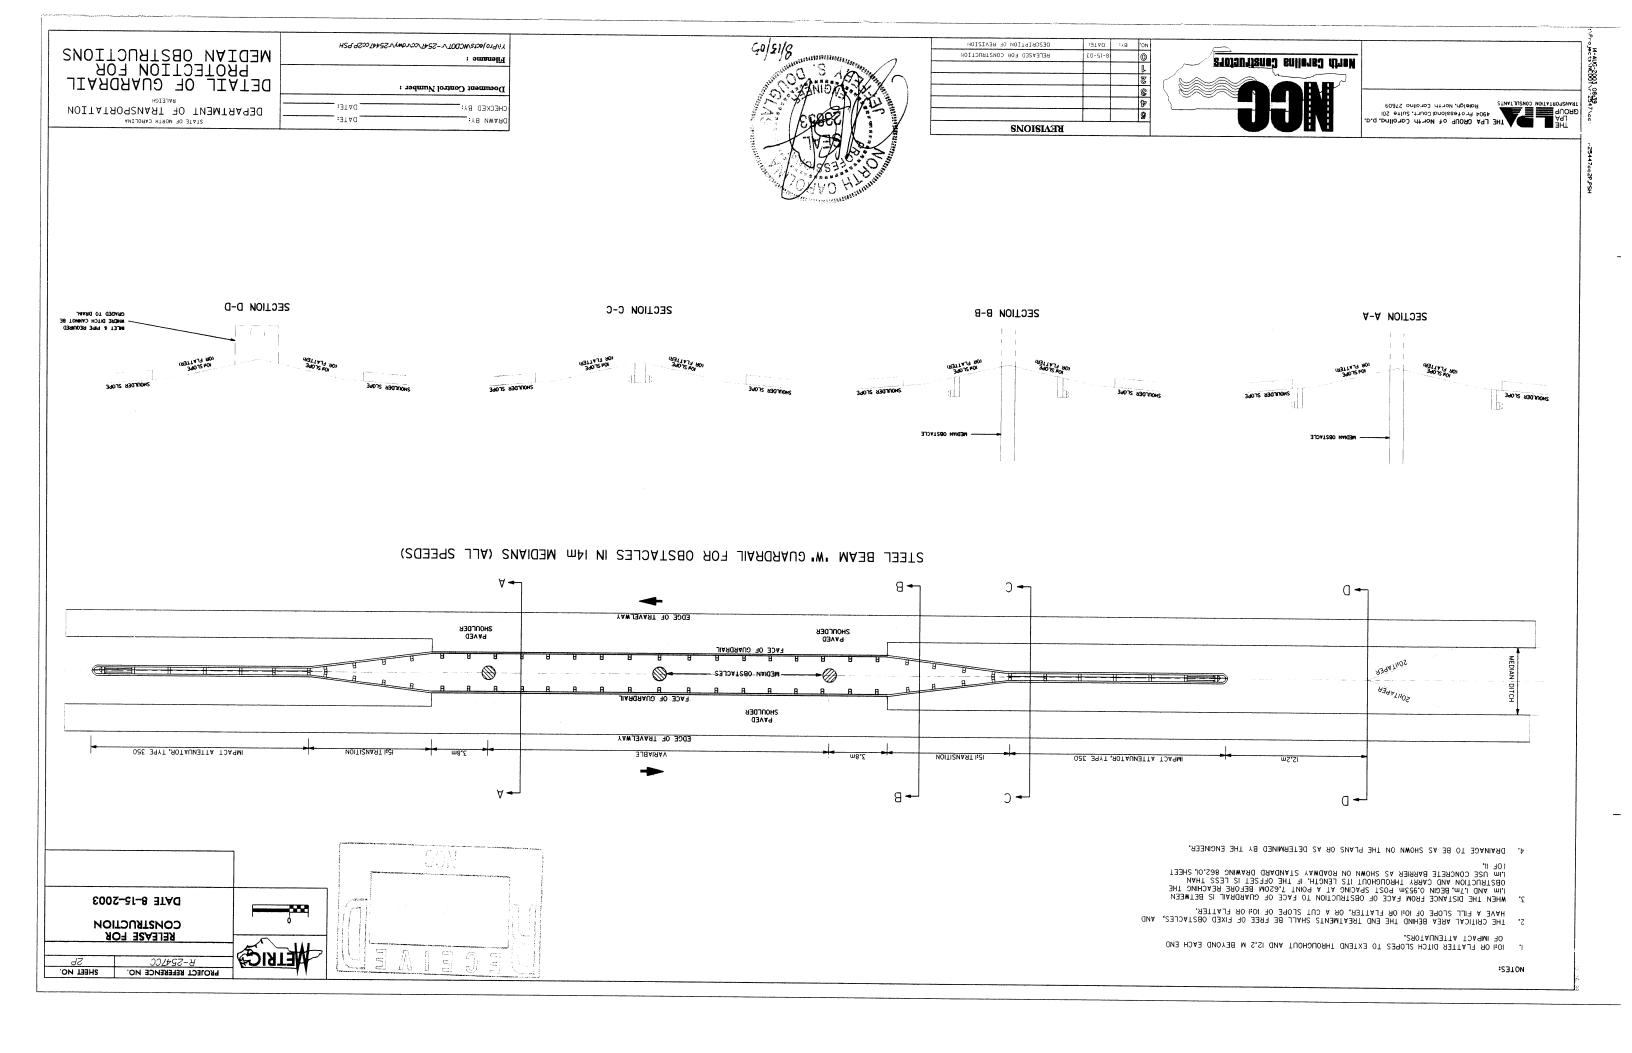

P.O. BOX, 35624 CHARLOTTE, N.C. 28235 RALPH WHITEHEAD ASSOCIATES, INC.

THE THE GROUP Of NOrth Corollno p.o. GROUP Of Worth Corollno 27609

Profits Carelina Constructors

RELEASED FOR CONSTRUCTION HEV. DETAIL "L"ADDED DETAIL & P

KEAISIONS

DESCRIBITION OF REVISION

HYDRAULICE ENGINEER STANDA STANDA PEE6


PEE6

PEEN

AS APIN

> Type of Liner = CLASS HRIPRAP B = 1'S W ш 9'0 = р 'хом Filter Fabric B Min. D = 1.0 m 10 STANDARD BASE DITCH DETAIL 0

FROM STA 12+00 LT -RPDY3- TO STA 177+80 -L- RT.

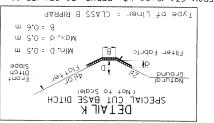

m **č.**0= g.nIM St. Ground STANDARD BASE DITCH
Scale
(Not to Scale)

FROM STA 177+80 TO STA 180+40 -L- RT.

Type of Liner = CL. 'B' RIP-RAP b = 1.5 m


LATERAL BASE DITCH

me.o = ∃


LEL Fabric Max, d = 0.7m

m 8.1 > si B nədW

FROM STA 13+68 TO STA 14+20 -Y3- LT. FROM STA 169+80 TO STA 171+40 -L- RT. FROM STA 13+00 TO STA 13+40 -Y3- RT. FROM STA 166+30 TO STA 166+96 -L- LT.

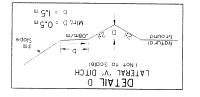

FROM STA 12+80 TO STA 13+20 -RPBY1- LI.
FROM STA 12+80 TO STA 13+20 -RPBY1- LI.
FROM STA 12+00 TO STA 13+20 -RPBY1- LI.
FROM STA 12+00 TO STA 13+30 -Y1- LI.
FROM STA 23+65 TO STA 23+95 -Y1- LI.
FROM STA 13+40 TO STA 13+90 -Y1- RI.
FROM STA 13+40 TO STA 13+60 -BETOUR- RI.
FROM STA 13+40 TO STA 14+20 -SR3- RI.
FROM STA 13+40 TO STA 13+60 -DETOUR- RI.

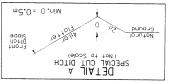

.TJ -YY- 03+82 AT2 0T 0P+72 AT2 MOA9

Y-VPTO JOCHS VINC BOT V - 25 4T VCCVI dwy/1 25 4T CCSO3 DSh


DATE:

DATE:

Document Control Number :

насичине :

DRAWN BY: ___

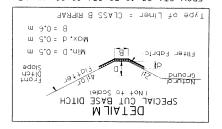

FROM STA 16+77 TO STA 18+59 -RPBYI- RT. FROM STA 10+74 TO STA 11+59 -RPBYI- RT.

SPECIAL CUT BASE DITCH

FROM SIA 11+71 TO SIA 12+20 -RPBY1- RT. FROM SIA 11+71 TO SIA 12+20 -Y3- LT. FROM SIA 20+35 TO SIA 21+00 -RPBDYI- RI. FROM STA 14-80 TO STA 15-80 -RPEDYI- RT. FROM STA 17-80 TO STA 18-40 -RPEDYI- LT. FROM STA 17-80 TO STA 18-65 -RPEDYI- LT. FROM STA 12+80 TO STA 15+40 -RPCY1- LT. FROM STE 166+98 TO STE 167+80 -L- RT. FROM STA 159+70 TO STA 160+60 -L- LT. FROM STA 158+70 TO STA 159+00 -L- RT.


m2.0≈ 0.nIM m3.0≈ 8

m <u>8.1</u> = d m <u>8.0</u> = b .xpM R <u>8.0</u> = B = 9A9919 8 S Min. D = 0.6 m Stredm Aox, d= 0.8 m. Proposed N.G. (NOT TO SCOLE) NOITACLOCATION

> FROM STA 129+90 TO STA 163+20 -L- RT. FROM STA 15+40 TO STA 16+60 -RPCY1- LT. FROM STA 12+18 TO STA 13+00 -Y3- RT. FROM STA 157+60 TO STA 158+70 -L- RT.

FROM STA 180+40 TO STA 180+80 -L- RT.

Type of Liner = CLASS B RIPRAP

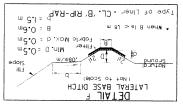

m0.0= 0.01M m2.0= 8 DETAIL E
STANDARD BASE DITCH

FROM STA 166+96 TO STA 167+80 -L- LT.

Type of Liner = CL. 'B' RIP-RAP


LATERAL BASE DITCH

OPTAIL B

ш9.0 ≈ 8

m 8₁ > s! 8 n⊖d₩ •

FROM SIA 12+40 TO SIA 13+40 -L- LI. FROM SIA 184+60 TO SIA 13+40 -Y3- LI. FROM STA 154+83 TO STA 156+80 -L-Type of Liner = CL. 'B' RIP-RAP

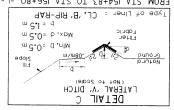

ω **ς•**Ο= ₽ Natural bround DETAIL CC

IXDe of Finer = CF. 'B' RIP-RAP

FROM STA 158+60 TO STA 159+40 -L- LT. FROM STA 154+00 TO STA 155+18 -L- RT.

ETRICE

DILCH DELVITS

DATE: 12-16-2003

RELEASE FOR CONSTRUCTION

DITCH DETAILS

DEPARTMENT OF TRANSPORTATION

STATE OF NORTH CAROLINA

Y-2547CC PROJECT REFERENCE NO. SHEET NO.

RALPH WHITEHEAD ASSOCIATES, INC.
CONSULTING ENGINEERS
P.O. BOX 35624 CHARLOTTE, N.C. 28235

-u-

-u-

-u--U-

-u-

-ZOLX-

-zou-

-20L1-

-X0U-

-1-

-7-

-1-

-7-

-IYA91-

-1-

-7-

-1-

-7-

-7-

-1-

-J-

7

-7-

-7-

-1-

-1-

-1-

-7-

-7-

-1-

-1-

-7-

-1-

708.27+12

20+19.592

840.98+12

737.89+Ef

204.16+51

116.62+81

444.14+81

£70.19+£f

6Z1.85+E1

094.01+881

676'LL+ 98L

776.69 + 881

407.74+871

745.53+771

174+72,000

796'98 + E/L

542.82+98r

1/1:40 + 691

981.20+981

982.02+EF

815.92 + 341

898'87+99L

169.64+991

192,25+361

071.82+291

Z6C.97 + E61

071.82+39I

164 + 28.884

916,10 + 261

SIE. TO + SAT

Z/8'96 + 691

159+92.860

829.19+981

821,19+981

096'94+89L

096.87+82f

154+24.082

8ZE.70+42f

755.21+ 221

/CC'ZI + ZCI

720'98 + L9L

965,96+161

6LG'BZ+LGL

146 + 29.839

GEO'/G+9#1

918.69+971

812,49+641

144+20.000

468.94 + AAI

744 44 834

976'97+771

SEG. STA.

Z96'66+1Z

924.60+12

975.05 + SZ

14+24.345

995.74+ 51

090.08+8f

\$06.65+8F

799.97+£ſ

440.10+4F

186+20.270

186+20.284

272.02+381

821.22+971

181 + 20.000

019,12+271

212.44+671

249'Z7+141

189.X8 + 401

189.28 + 98F

000'08+891

£06'8£+89L

168 + 22.569

ELG'91+891

000'86+/91

967'66+991

186,18+661

165+96.425

07E.70+661

166.60 + 661

166.60 + E&I

162 + 54.000

160+54.010

010.48+061

7E0.03+03F

442.544

E10.13+981

271,72+921

ZE9'9E+69L

299.6E + 261

200.CE + 2CI

ZZ6'6Z + ZGI

Z1/'Z4 + ISI

152 + 17.804

147 + 72.591

74/ +30,992

147+30.992

148+08.126

145+11.339

145 + 20.208

141.64+641

END 214

THE LPA GROUP of North Corollna, p.a

Rerth Carelina Censtructors

295.71

485.71

864.17

886.68

798.68

784.457

198.88

76.SA

012.901

206.836

898.65

880.991

016.91

305.266

214.432

OF&.ET

70.642

84.211

285.971

107.671

172.622

667.89F

9L7'55

989.FOS

992.89

981.871

986.89

986.89

821.782

081.18

SE6.58

606.89

186.66

502.38

623.090

528.304

23.125

272.EI

93.948

23,116

99Z.E1

282.98

142.752

73.657

9ZE.GG

806.511

969.49

008,16

918.09

99.245

THOLASTZ

CURVED SHOP

LT & RT

TH & TJ

RT

11

TA

17

17

LT & RT

LT & RT

17

IT & RT

ΤA

17

KI

17

17

RT

11

RT

17

11

17

IN

11

17

17

ГОСАПОИ

DESCRIBLION OF REVISION :31 A G () () BELEASED FOR CONSTRUCTION 2 8

234-99-12

927.80+12

22 + 60.546

346.42+41

995.71+EI

090.08+81

106.66 + &r

799.67+EI

690'L0+#L

072.02+ 88f

186+20.284

275.05+ 48f

861.56+971

181+20.000

016.12+671

086.15+871

219'Z7+111

189.28 + 961

189.28+961

£06'8£+89L

495.22+891

EI2.61+861

000.86 + 761

9EF.E9+ 881

185,18+261

927.96+991

046.70+ 661

163 + 21.003

669'09 + Z9L

000.46 + Sal

010.48+061

010.46+061

750.03+03F

159+42.544

510.11+951

271.74+921

ZE9'SE+6SL

299.65 + 251

799'CE + 7CI

\$20.68 + ISI

151+92.712

217.29+18

152+17.804

147 + 30.992

147 + 30.992

909.48+ MI

955.11+341

802.02+641

DNUIANT GN3

97+771

THION THANKAW

00+87L

07+ L7L

708.27+12

20479.592

83-0.98+12

727.89 + El

207.18 + SI

119.25+81

477'LF+SL

E70.19+21

6Z1.85+EI

097.01+881

967.45 + 581

776.46 + 881

407.74+871

174+72.000

456.68 + EYI

169+28.243

141.90+961

981,20+981

616.08+881

816.92+ 661

898.87+991

169.54+99

192.25+991

165+28.170

265.97+861

071.82+391

188.82+161

972.26 + 581

E09.98+16F

Z/8'96+69L

159+92.860

879'L6+691

8ZI'16+6CI

096.67+881

096.27+821

280.42+42f

825.70+A2F

152-12.537

/ £C'Z| + ZC|

246'64+291

960'69+101

912.85+121

46 + 29.839

8LZ'76+97L

844.05+441

ZE9.67+17L

282.78+ AAI

1/1.04+641

END PPPROACH

G/+9#1

Z0+/FL

SISIO **KEAISIONS**

OEA.II

OET.IT

15.240

0ÞZ.81

02.21

15.240

015.21

15.240

042.2I

05.240

15.240

04Z.2I

OEA.IT

012.21

15.240

07Z.2I

15.240

045.8f

OFZ.CI

072.2I

077.GI

OEA.II

15.240

15.240

OEF.II

045.2f

15.240

PPPROACH END

J.2VAR.

0.7

A.2/VAR.

A.ZVAR.

2.4

2.4

4.2

2.4

5.2

5.2

Z.č

2.2

Z.č

5.2

5.2

Z.č

S.S

5.2

2.8

5.2

2.4

5.2

Z.2

9.4

9.4

4.2

5.2

.8AV\ S.8

JAY\ S.2

4.0

0.8

0.8

4.8

2.8

Z.8

Z.2

5.2

2.8

S.Z

TATOT SEQUIDORS HTGIW

.AAV

0.6

3.0VAR.

3.0VAR

9.E

9.6

2.4

7.4

2.4

4.2

4.2

4.2

2.4

9.€

3.6

8.1

9.€

Z.A

9.€

4.2

4.2

4.2

3.6 VAR.

4.2

4.2 VAR.

4.6

0.8

0.8

7.6

2.4

8.6

0.4

2.4

8.5

8.6

6.€

4.2

BOADWAY DESIGN ENGINEER E0/51/3. JOHA CAROL WORAD WWW

25.f

S€.ſ

28.f

€.0

€.0

6.0

6.0

6.0

€.0

6.0

6.0

6.0

29°L

6.0

6.0

£.0

6.0

6.0

8.0

€.0

6.0

S&.f

€.0

€.0

6.0

26.1

€.0

€.0

€.0

6.0

€.0

6.0

€.0

6.0

€.0

1.22

05.240

15.240

012.2f

OFZ.CI

OPZ.EI

15.240

15.240

012.2f

0**≯**£.&f

11.430

OFZ.CI

064.11

TRAILING

FINAL PLANS coument Control Number: DATE: _

DEPARTMENT OF TRANSPORTATION DATE: STATE OF MORTH CAROLINA

CUARDRAIL SUMMARY

guardrail.sum

Hilename:

HECKED BA:

L

ι

L

L

ī

ι

350 350

III 34XL

7

5.0 €.0 €.0

HADBADLICS ENCINEER

LIFE STOLE HIT STOLE FILL SLOPE END WID BEGIN BISDOE END YND BEGIN BKIDGE END YND BECIN BINDCE

BECIN BKIDGE BIDGE HER (WEDIYN) YND OAERHEYD SIGN END BRIDGE FILL SLOPE BRIDGE HER (MEDIAN)AND OVERHEAD SIGN OVERHEAD SIGN

HILL SLOPE

FILL SLOPE

BRIDGE HER (WEDIYN) AND OVERHEAD SIGN END BINDOE

END BINDOE END BINDOE END BRIDGE

END WND BEGIN BKIDGE END YND BEGIN BINDCE END WAD BEGIN BRIDGE

END WID BEGIN BRIDGE BEGIN BRIDGE BECIN BRIDCE (WEDIVN) BECIN BRIDGE

WEDING SIGN WEDING SIGN OH SIGN "B"STA.162+54 END BRIDGE (WEDIVN)

BEGIN BRIDGE (WEDIVA) END BRIDGEVEIT STOLE LIE TO -RPBYI-BECIN BRIDGE (WEDIVN)

BECHA BRIDGE (WEDIVA) BECH BRIDGE BECH BRIDGE END BRIDGE (WEDIVN)

END BRIDGE (WEDIVA) BARNER @ BRIDGE IND BRIDGE (WEDIVN) ECIN BIDGE (WEDIYN)

BARRIER @ BRIDGE OH SIGN "A"TA7+40 KT END BRIDGE (WEDIVIA)

BECIN BRIDCE (WEDIVN) BEGIN BRIDGE BECHA BRIDGE ECIN BRIDGE (WEDIVN)

ECIN BIDGE (WEDIVN) HIL SLOPE

SINGLE FACED PRECAST CONCRETE BARRIER STD. 857.01

EV C NC TY-8 34YT 025-M (-TA IMPACT ATTENUATOR ORE 350

GUARDRAIL SUMMARY

G = GATING IMPACT ATTENUATOR TYPE 350

W = TOTAL WIDTH OF FLARE FROM BEGINNING OF TAPER TO END OF GUARDRAIL. EINE FENCH - DISTANCE FROM LAST SECTION OF PARALLEL CUARDRAIL TO END OF CUARDRAIL. TOTAL SHOULDER WIDTH - DISTANCE FROM EDGE OF TRAVEL LANE TO SHOULDER BREAK POINT. "N" - DISTANCE FROM EDGE OF LANE TO FACE OF GUARDRAIL

> :3TAQ CHECKED BA: DATE: 4-26-03 COMPUTED BY:

I-TAD GOM -IX

PROJECT REFERENCE NO.

SEWYSKZ

8-15-2003

RELEASE FOR CONSTRUCTION

| CUARDIL SUMMARY | | ш | us,lip | ane: | l | леек | 2 ENCIN | DRAULIC | λΗ | £01 | 1/91 1/91 | NOINEER | SICH EN | DESTRUCTION OF SHARES | 08 // / | OF REVISION CONSTRUCTION IONS FOR -RPBDY1- | | ΣΟ-10-01 ΕΟ-31-8 :3TAQ :ΥΘ | ON O | 210Jau | Tienaj er | nilelb) d | .o. | EHEAD ASSOCIATES, IN JLTING EWGINEERS GCHARLOTTE, N.C. 2 | F.O. BOX 355224 COUSL P.O. BOX 35524 | М |
|---|---|------------------------------------|--|--|------------|----------|----------|----------|-------------|-----------------|---------------|--------------|--------------|-----------------------|---|--|--|--|--|--------------|--|-----------------------------------|------------------------------------|--|--|---------------------------------|
| DEPARTMENT OF TRANSPORTATION RALEIGH RALEIGH PLANS | :3TAQ | per : | draw Numb | ED BY: | | | | | | ///* | <i>t</i> /-// | | 6 133 | NIONS | OT | | | | \$ \$\\ \partial \text{\$\partial}\$\$ | | | | Folina, p.a. 16 201 1609 | GROUP of North Car ProfessionalCourt, Sui- aleigh, North Carolina S | A 4 3HT 14004 3 PM 2TMATJURNO. | AGJ AGDOHD AUORETRONSMART |
| STATE OF HORTH CAROLINA | :3T A O | | | :78 | NWAAQ | | | | | | | | 0 |) Z Z | HI WILLIAM | | KEAISIONS | | | | | 784 | | | | ■ ■ 3HT |
| | | | | | ! | | | | | | | | 1/1/0/ | A S E P | A 1 | 078.8101- 752.8101- | 306,ſ | ₩-320 C¥I-1 | | (TIMUMIB.E @ | © (2004 UNITS | 188.6387 18.6387 | JATOT YAZ | | | |
| | | | | ŞL | 8 | b | b | -1 0 | 72 | E+ | TATOT | | | HIIII. | : | 245.245- 246.24 24.11- | 208.1 @ 8.240 209.1 @ 8 | III 377T GRAU-350 I-TA | снок рерислома | NA T | \$0 7 .58 | 818.7898 115.2888 728.8101- | SUBTOTAL SUBTOTAL DEDUCTIONS | | | |
| | | | | | <u> </u> | | | | 1 | <u> </u> | | | | | | 277.Art- | 861.8 @ 41 | TYPE B-77 | | | | | | | | |
| | | | | | | | | | | | | | | | | | | | | . | | | | Market 1 1 1 1 1 1 1 1 1 1 1 1 1 1 1 1 1 1 1 | | |
| | | | | | | | | | | | | | | | | | | a area and an area area area. | | | | | | | | |
| | | | | | | | | | | | | | | | | | | | | | | | | | *** | |
| | | | | | | | | | | 1 | | | | | | | | *************************************** | | | | | | | | |
| | | | | | | | | | | | | | | | | | | | | | | | | ###################################### | L | |
| | | - | | - | 1 | | | | + - | | | 21 Maria | | | | - Company of the Comp | | manufacture of the second control of the sec | | <u> </u> | ļ | | | | | |
| | | | | | | | | | | | | | | | | | | | | | | | - | 1 | <u></u> | |
| | | | | | | | - | | | | | | | | | | | | | | | | | | | |
| | | - | | | | | | | | | | | | | | and the second s | | | | 1 | | | | | <u> </u> | |
| | | | | - | | | | | | | | | | | | | | | | | | | | | | |
| | | | | | | | | | | | | | | | | | | | | | | | | | | |
| | | | | | - | | | | | | - | | | | | | | | | | | | Manager and a second | | [| |
| | | · · · · · · | | | | | | | | | | | | | | | | | | | With the same of t | | | | <u></u> | |
| | | | | | | | | | _ | | | | | | | | | | | <u> </u> | | | | | <u></u> | |
| | | | | | | | | | _ | | | | | | | | | | | | | | | | | |
| | | | - | | | | | | | | | | | | | | and delicement through the transfer to the state of the s | and the second control of the second control | | | | | | | <u></u> | |
| | END BIG | | | + | | | | | l | 1 | | | | | | 364∀ | l'Z | E79'98+8L | 000.05+81 | | | 329.643 | LT RT | £46.643 | 000.09+81 | -MG899- |
| NDEPEIT STOFE | BEGIN B | | | | | | ι | | - | l i | | <u> </u> | | | | 3tAY StAY | 1.2 | 074.19+&f &f6.97+&f | 789.98+8f | | | 887.12 313.455 | 18 | 074.19+&f &f6.97+8f | 788.98+2r 000.24+2r | |
| .E. OCEFILL SLOPE | HIT STOL | 1 | - | - | - | | l L | | | ı | | | | | | 34AV | 2.1 | 742.63+61_6YQ99_ 707.69+41 | 991.80+91 049.79+41 | | 908.ET | 797.82 | n n | 7A5.63+61-6YOYA- 707.69+A1 | 991,80+81 049,78+41 | -£Y- |
| KIDGS-HIT 2FOLE | BECIN B | | | | | | | | | ı | | | | | 000111 | 3044 | 1.2 | 691'90+91 | 778.07+&f | - | | 34.292 | RT LT | 691'50+91 | 778.07+&1 | -£X- |
| | LIFE STON | | - | | | | | | i i | | | 28.1 28.1 | | | 0E4.11 | A.2.A.R. | .3.AV.8.F | 416'87+71 299'16+71 | 166.42+41 | | | 788.81 478.88 | 7A | 299'l6+7l | 14+24.991 | EYA-U- |
| | 1111 2004 1111 2004 | | | | | | | | | | | | | | | .8AVA.8 .8AVS.A | A.S. SAVA.E. | 057.70+Af 7fq.ea+Af_eyan_ | 000.07 + Ef 027.70 + Af | 1 | ₽£2.0E | 0 2 7.7£ | LT -Y3-(RT)-RYAY3-(RT) | 027.70 + MT T19.EM + MT-EYA99- | 000.07 + Ef 027.70 + Af | -£X- |
| 3 | LIFE STOP | | | | ļ | | ı | - | | ļ | | | | | | JANA.E | 3.2 | 000.07 + £ſ | 610,26+81 | ļ | 076'11 | | īı | 000.07+81 | 610.5à + E1 | -€⊁- |
| | LIFE STON | | | | 1 | | L | | ı | . | - | 28. ſ | | | 064.11 | 3AV0.E 3AV0.E | 1.6 | 910.01+EI 028.31+EI | 848.948 13+40.019 | | 907.0f | ואסיווו | n n | 910,01.+ EI 058.61.+ EI | 12 + 28.948 13 + 40.019 | -£⊁- |
| · · · · · · · · · · · · · · · · · · · | EIFF 2FOL | | | | | | l . | | + , | | | 26. 1 | | | 0£4.11 | .8AV&.E .8AVQ.E | A.E A.E | 649,86+61 870,18+61 | 689.84+ff | <u> </u> | 814,81 | ₱86'98L | 18 RT | 649.38+81 870.18+81 | 989.84+11 649.88+61 | -£X- |
| 3 | EIFF SFOE | | | | | | | | į. | | €.0 | | | 042.81 | | 2.8 | 2.4 | 697.99+£ſ | 962.E7+0f | <u> </u> | <u> </u> | 339'499 | 73 | 897.99+£1 | 96Z.E7+0f | -MA99- |
| | 1015 11111 1015 11111 | + | | + | | | | | ī | | £.0 E.0 | | | 01.2.21 01.2.21 | *************************************** | 3.6 | 9.6 | 947.98+81 | 070.80 + Sf 000.00 + Of | - | | 434.255 | TJ 78 | 025.95+81 | 070.80 + SI 000.00 + OI | |
| E (WEDIVA) | EIFE STOR | | 1 | 1 | z | | | | L | | | 6.0 | | | 15.240 | 8'7 | 2.4 | 096'76+91 | 812.97 + 21 | | | \$65.25 \$67.8f* | 17 & RT 11 | 058.64+61 059.44+61 | 899.91+E2 812.97+21 | -M- |
| | HO18 11H | | i | | z | | | | | | €.0 | S&.r | | | | J.2WAR. | .RAV0.è | 109.60+62 | 22 + 76.446 | | | 208.71 | TR 8 TJ | 103.E0 + EZ | 22 + 76.446 | |
| REMARKS | PRECAST CONCRETE BARRIER STD. 857.01 | | E 350 OBE 350 | HTA | 177-8 34YT | LL | | - WOD CA | UAND 085 | III 34AL | TRAILING | | 199A 3 | TRAILING | PPROACH END | JATOT REGLIUOHS HTGIW | DIST. FROM E.O.L. | TRAILING | APPROACH END | POUBLE | CURVED | THOIASTZ | ГОСАПОИ | END ETA. | BEG. STA. | |
| | MOLE FACED | HS | TOARM | WI | 1 | 29 | ANCHOI | | | | | | | ENGTH | J BRAIT | | "Nu | TVIO | THASSAW | <u></u> | LENGTH | | L | | | |
| 500Z-10-01 | ************************************** | e programme anno 1960 - 1 Lance | and a state of the | e destruit to | | | | | 2 | KY | MA | | 75 | | INS. | HED | 'N9 | | | | | | | | | |
| 2000 10 01 | ;;;;;;;;;;;;;;;;;;;;;;;;;;;;;;;;;;;;;; | , c. 2 740 | | | | | | | | | | | | | | | | | | | | | | | UMBTTA TDA9MI & | G = GATING |
| RELEASE FOR CONSTRUCTION | | A'th | | | | | | | | | | | | | | | | | | | F GUARDRAIL. | | | OW LAST SECTION OF | | |

PROJECT REFERENCE NO. 3/

"" - DISTANCE FROM EDGE OF LANE TO GROEN OF TARRELE GUARDRAIL OF FLARE FROM EDGE OF TRAVELE GUARDRAIL TO END OF GUARDRAIL.

" - TOTAL WIDTH OF FLARE FROM LAST SECTION OF PARALLEL GUARDRAIL TO END OF GUARDRAIL.

"" - TOTAL WIDTH OF FLARE FROM BEGINNING OF TARREL TO END OF GUARDRAIL.

:3TAG CHECKED BA:

DATE: 4-26-03 COMPUTED BY:

HADBANLICS ENGINEER 0 8-12-03 guardrail, sum **BOADWAY** DESIGN ENGINEER DESCRIPTION OF REVISION 20151/3 RALPH WHITEHEAD ASSOCIATES, INC.
CONSULTING ENGINEERS
P.O. BOX 35624 CHARLOTTE, N.C. 28235 RELEASED FOR CONSTRUCTION COLDERAIL SUMMARY North Carelina Constructors FINAL PLANS Document Control Nurrber: THE LPA GROUP of North Corollino, p.o. BRONE OF Worth Corollino, P.o. BRONEPORTATION CONSULTANTS ROMEDOR TATION OF THE COROLLO ST809 DEPARTMENT OF TRANSPORTATION

RALEICH

RALEICH _:3TAU_ CHECKED BX: _ :3T A U _ -:Y8 NWARO KEAISIONS 850.6852 **TATOT** LESS END UNITS: (15 @ 7.6m) = 114.000m TOTAL ANCHOR UNITS: (17 @ 7.6m) = 129.200m STINU QNE ST 00.≱11 SS31 Z MID-SPAN UNITS Z١ 880.00\Z SUBTOTAL 568.648 EE8.40+881 000.09+971 708.8EE 998.69+871 940.88+871 0EE.88E 195.08+671 162.29 + 961 170,902 965.61+361 794.70+£81 136.651 701.79+181 977'09+09L 181.668 106.68+881 152 + 47,420 424.419 695.98+121 02f.&£+7&f £81.82 144+27.653 144+02.500 ANCHORS LENGTH END STA. BEG. STA. 8-15-2003 RELEASE FOR CONSTRUCTION


PROJECT REFERENCE NO. 3J.


CHECKED BA: DATE: 4-28-03 COMPUTED BY:


-1-


→

· ------

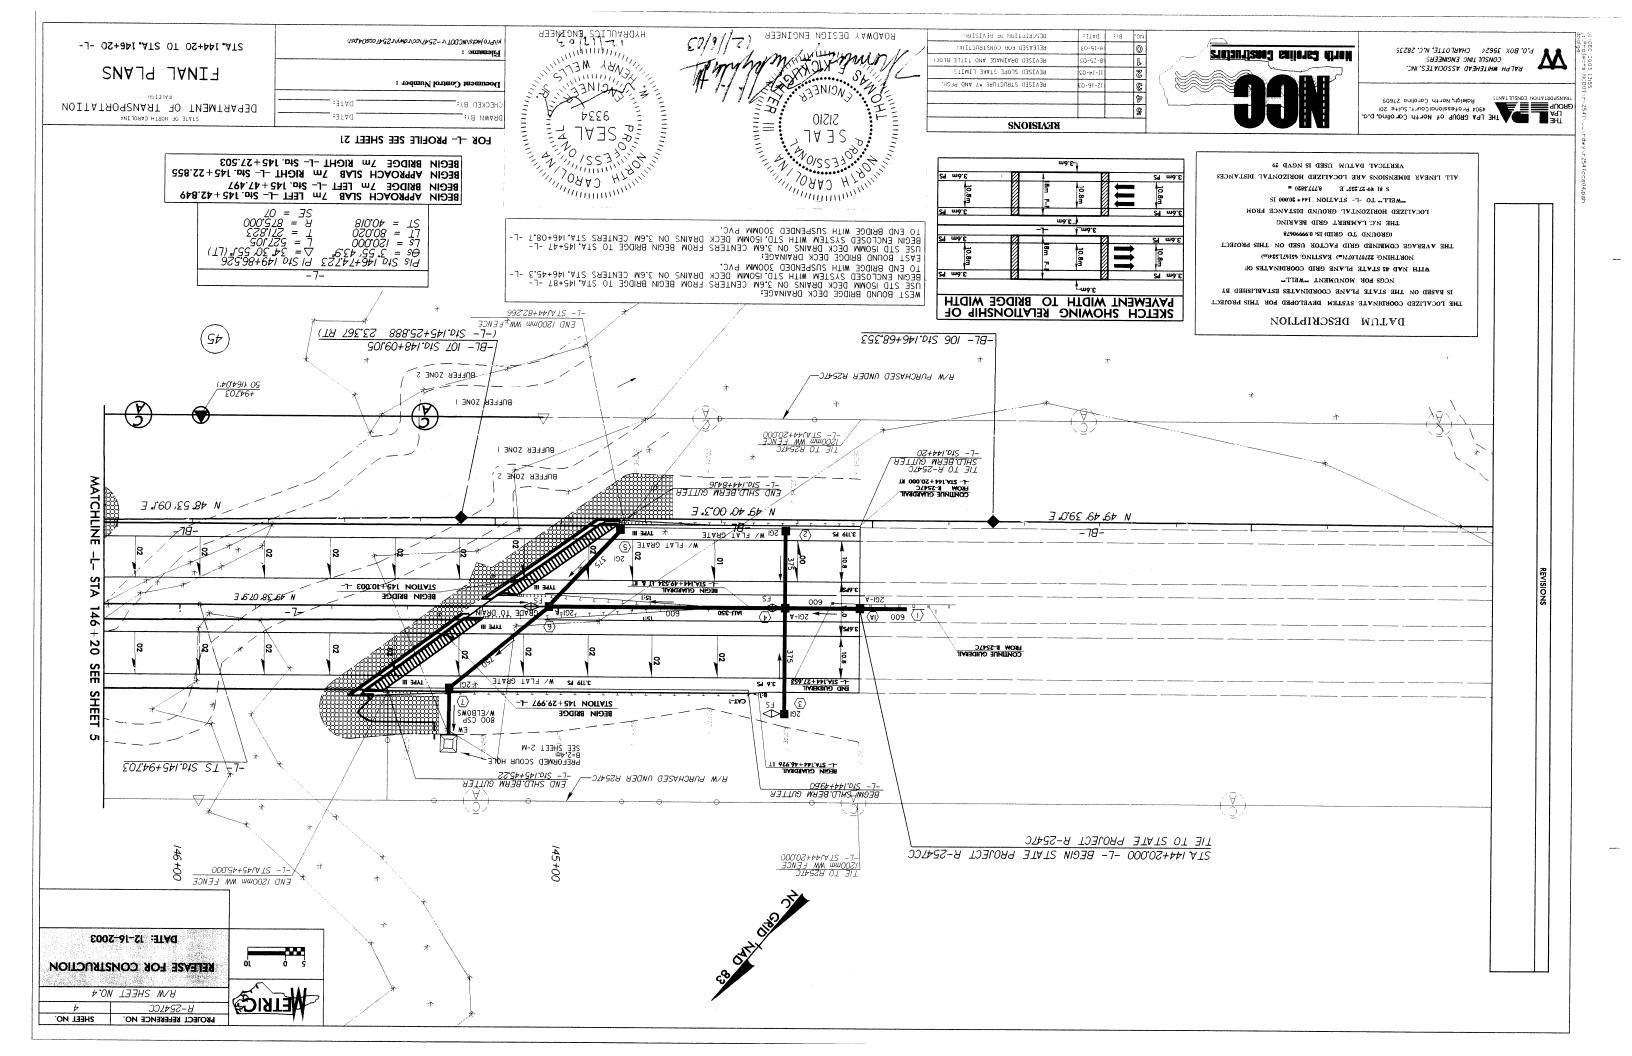

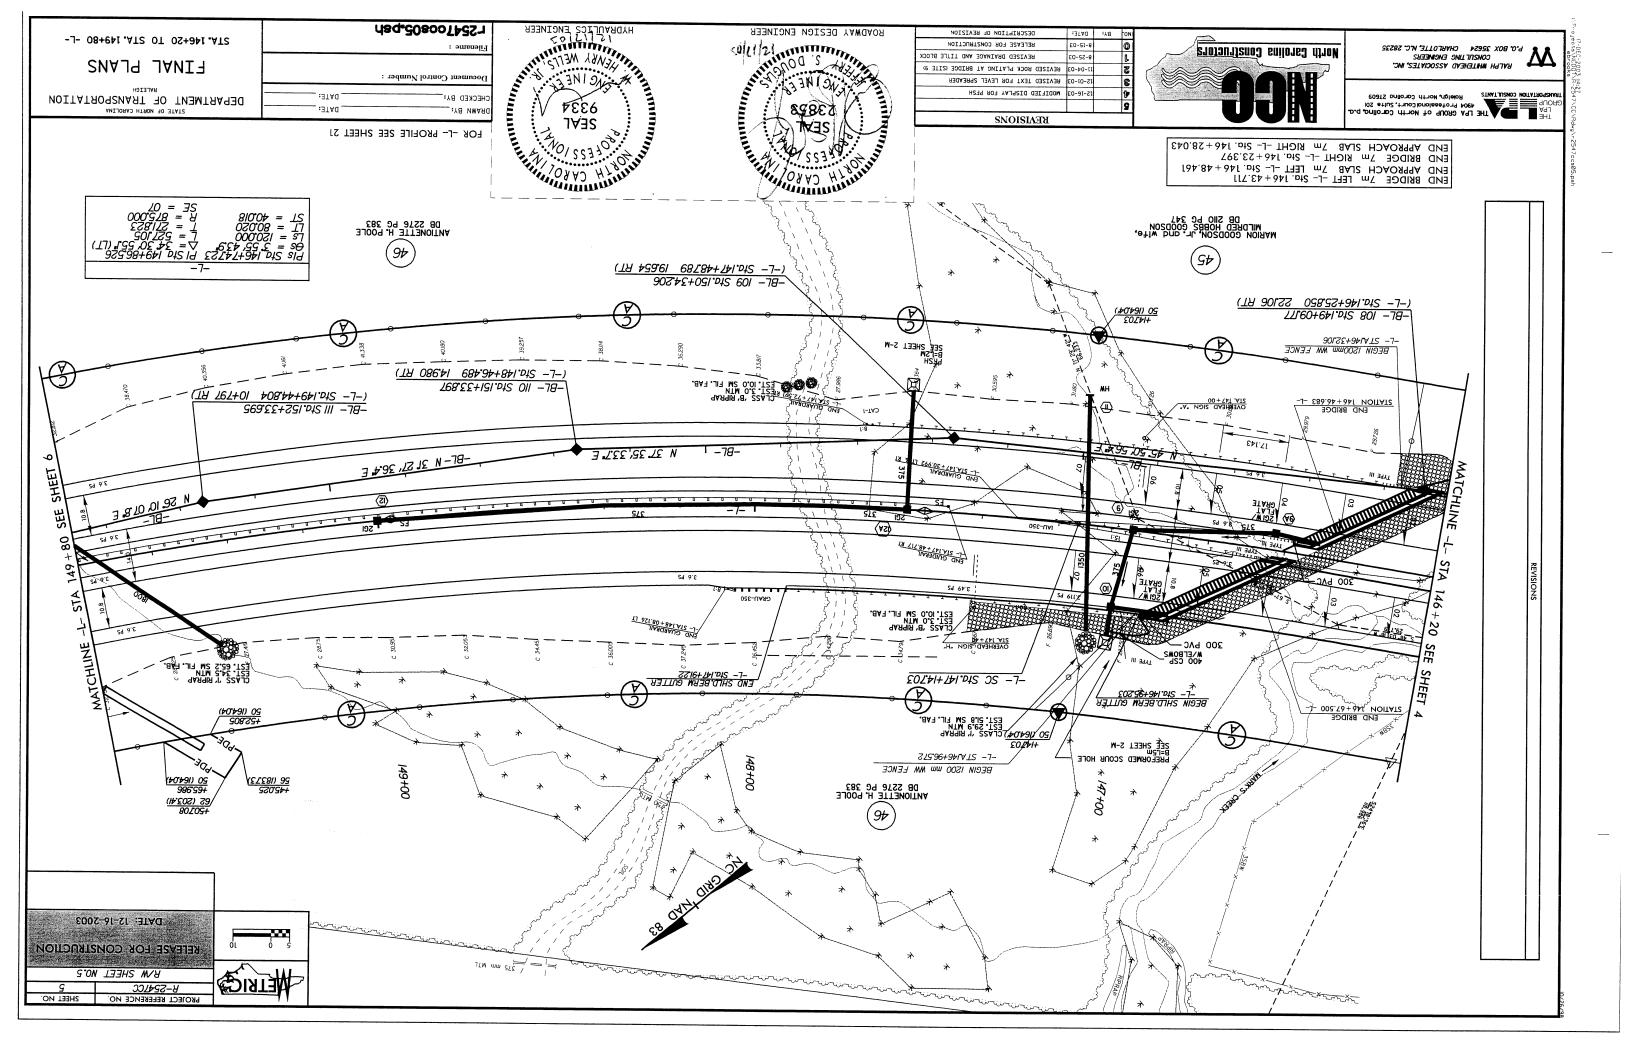

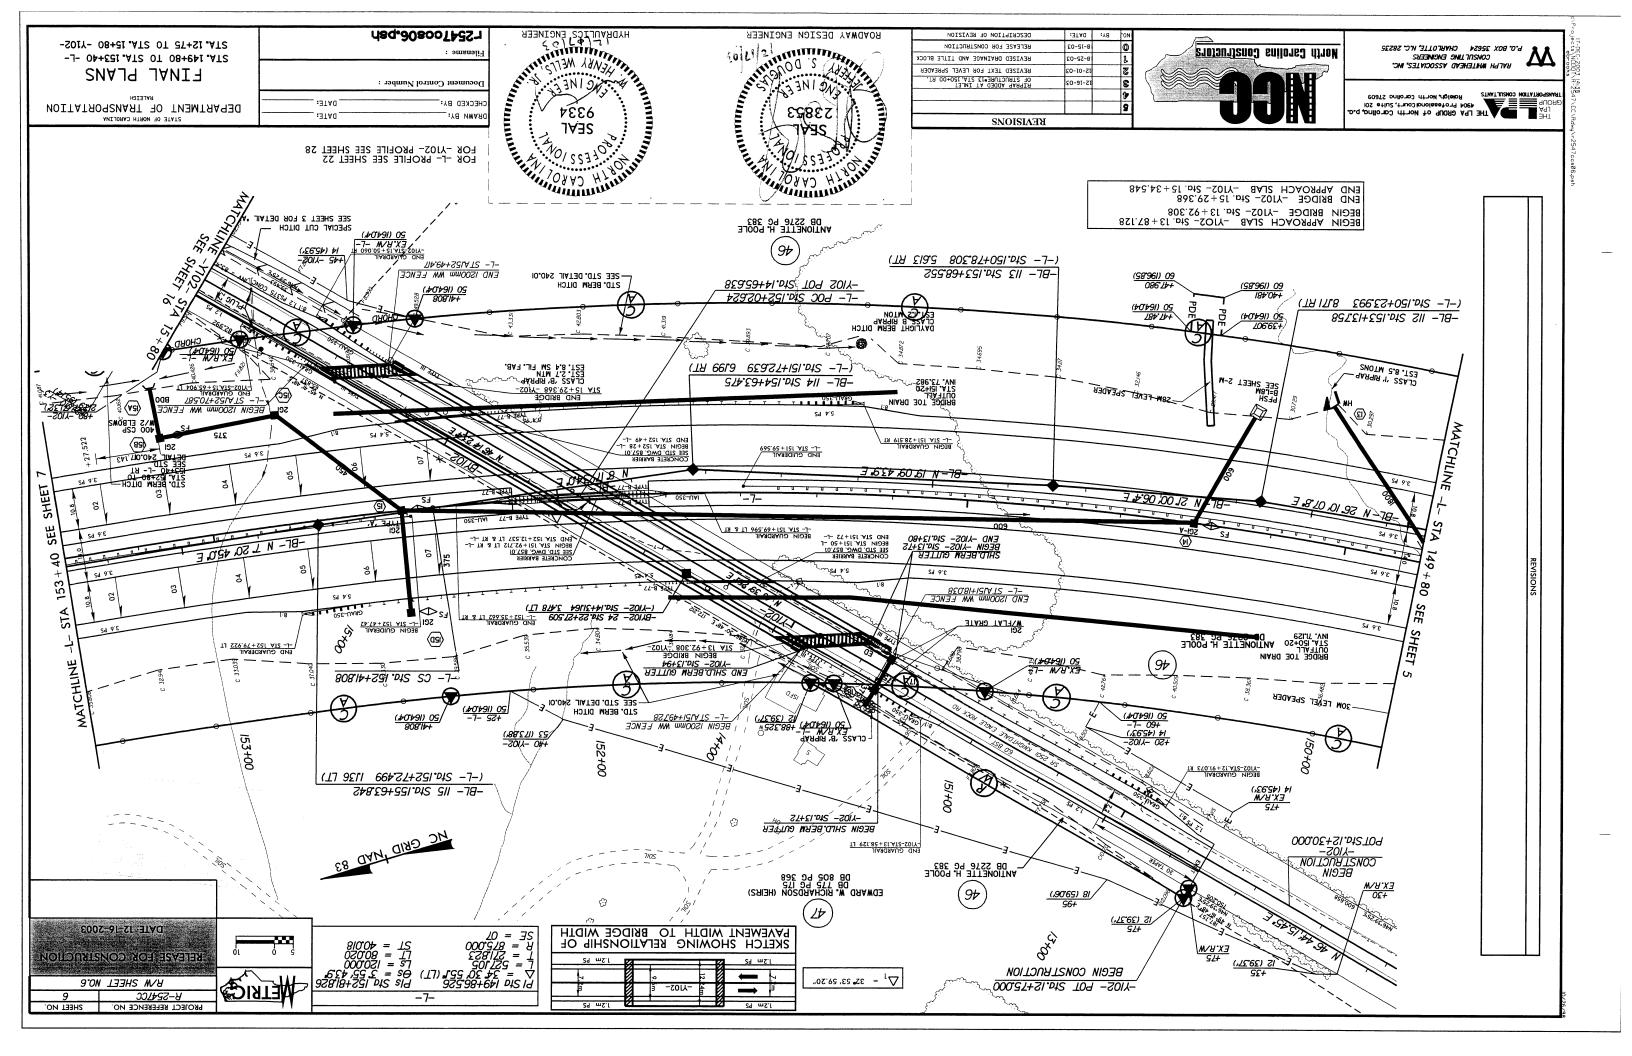

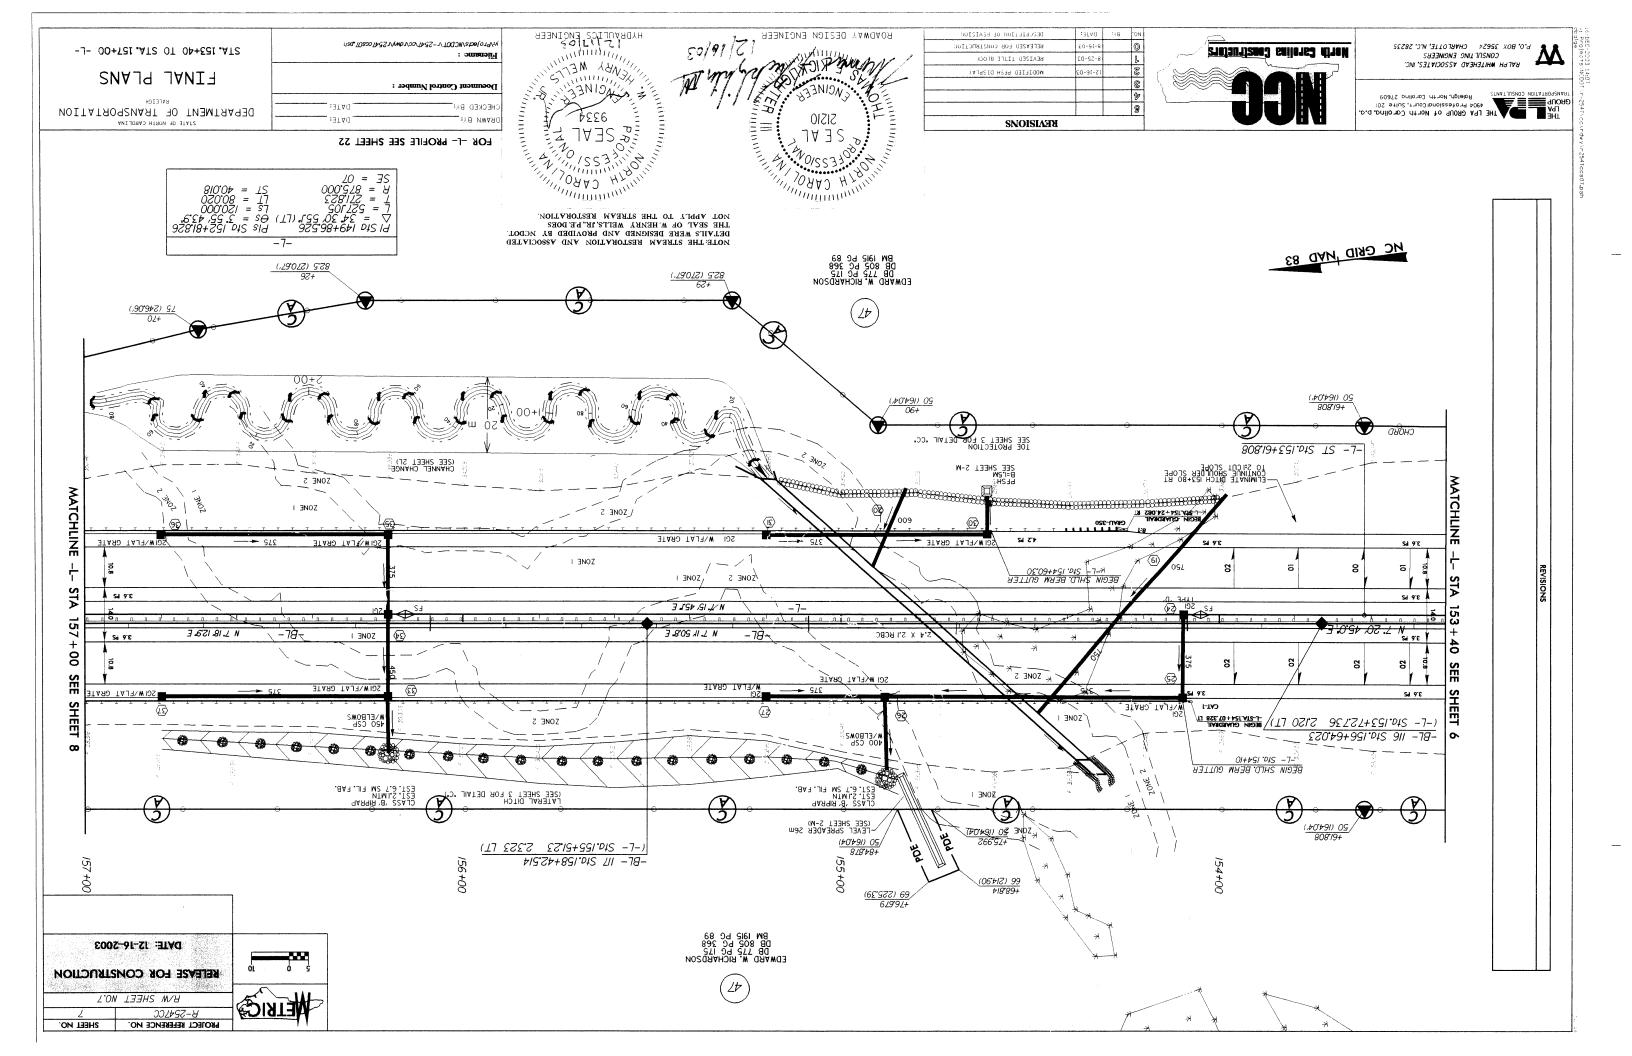

| DE2CBlb1 | :3TAO | : (8 | .0N | |
|----------|----------|------|-----|---|
| BELEASED | 8-15-03 | | 0 | |
| BENIZED. | 8-25-03 | | ß | |
| MODIFIED | 15-16-03 | | 2 | 0 |
| | | | 8 | |
| | | | 箩 | |
| | | | g | |
| | | | _ | |

| KEAISIONS | | | |
|---------------------------|----------|-----|-----|
| | | | g |
| | | | r |
| | | | 83 |
| MODIEIED BESH DISBEWA | 15-16-03 | | 2 |
| BENIZED LITLE BLOCK | 8-25-03 | | ß |
| RELEASED FOR CONSTRUCTION | 8-12-03 | | 0 |
| DESCRIBLION OF REVISION | :3TAG | :48 | .0N |

| DESCRIBLION OF REVISION | :3TAO | :78 | ,0N |
|---------------------------|----------|-----|-----|
| RELEASED FOR CONSTRUCTION | 8-15-03 | | 0 |
| BENIZED LITLE BLOCK | £0-5Z-8 | | B |
| MODIEIED BESH DISBERY | 15-16-03 | | 8 |
| | | | 3 |
| | | | r |
| | | | g |
| | | | |


| :3TAG | :78 | .0N |
|----------|--------------------|----------------------|
| 8-15-03 | | 0 |
| 8-25-03 | | ß |
| 15-16-03 | | 8 |
| | | 3 |
| | | 箩 |
| | | g |
| | 8-52-03 8-52-03 | £0-\$1-8 £0-\$Z-8 |

HYDRAULICS ENGINEER ROADWAY DESIGN ENGINEER y:Projects/NCDOT/r-2547/cc/rdwy/r2547ccsO7_mg/cu/n_det)psh DATE: .YB WWA9C

NOTE-THE STREAM RESTORATION.
THE SEAL OF WHENNY WELLS, TE, DOES
NOTE-THE STREAM RESTORATION.
NOTE-THE STREAM RESTORATION.

NAD 83

erith Caralina Constructors

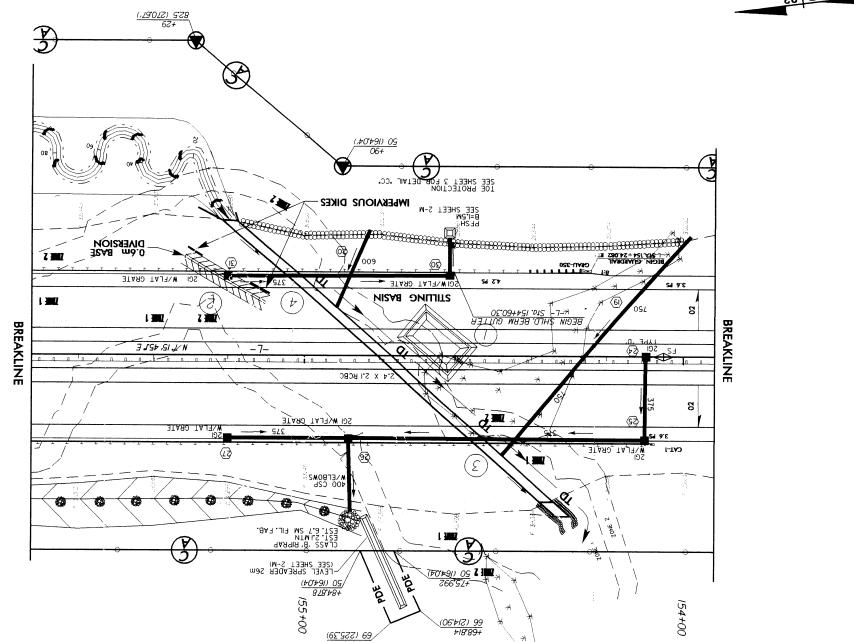

- 4. REMOVE EROSION CONTROL DEVICES AFTER FILL SLOPES
 - 3. CONSTRUCT CULVERT AND PLACE RIP-RAP.
 - AND IMPERVIOUS DIKES.
 - 2. CONSTRUCT TEMPORARY DIVERSION CHANNELS
- J. INSTALL STILLING BASIN (YOLUME: 64 CUBIC METERS).

CONSTRUCTION SEQUENCE:


DATE: 12-16-2003 KELEASE FOR CONSTRUCTION B-2547CC

PROJECT REFERENCE NO. SHEET NO.

CONSTRUCTION SEQUENCE

FINAL PLANS

DEPARTMENT OF TRANSPORTATION

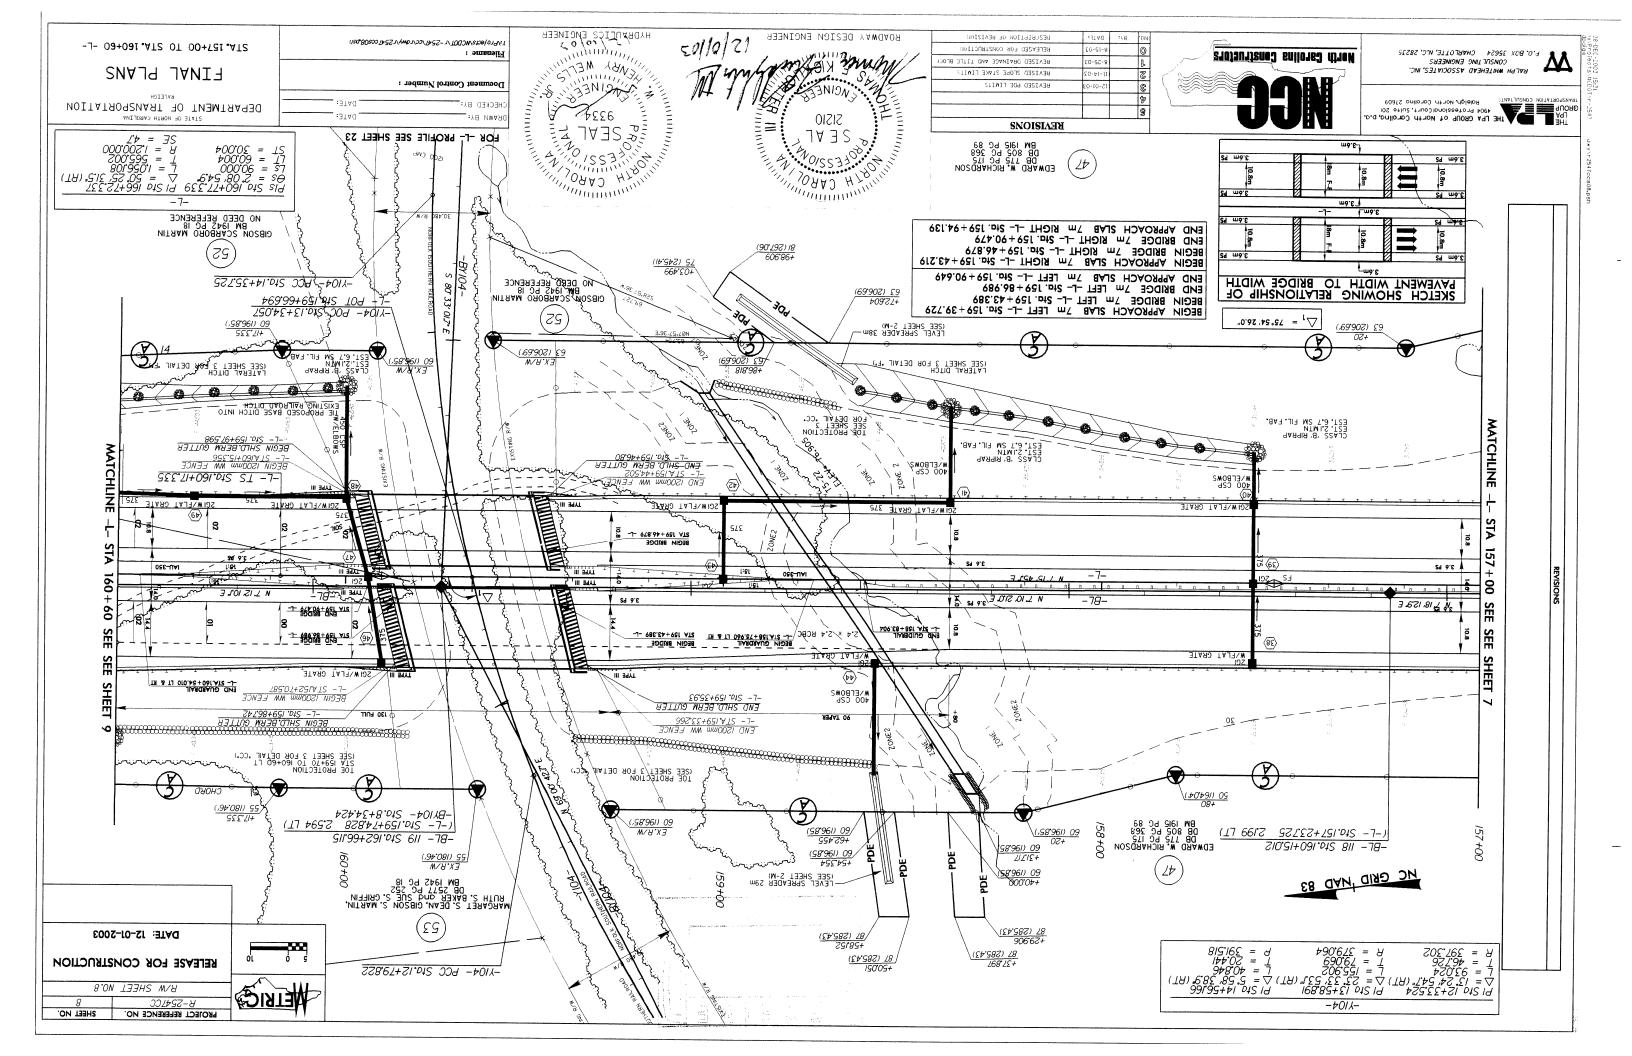



E8 'QAN

| KEAISIONS | | | | |
|---------------------------|----------|-----|-----|--|
| | | | g | |
| | | | Ø | |
| | | | 8 | |
| REVISED PDE LIMITS | 15-16-03 | | 2 | |
| REVISED TITLE BLOCK | 8-25-03 | | L | |
| RELEASED FOR CONSTRUCTION | 6-15-03 | | 0 | |
| DESCRIBLION OF REVISION | :3TAO | :18 | .ои | |
| | | | | |

| DESCRIBLION OF REVISION | :3TAO | :18 | 101 |
|---------------------------|----------|-----|-----|
| RELEASED FOR CONSTRUCTION | 8-12-03 | | 0 |
| REVISED TITLE BLOCK | 8-25-03 | | B |
| REVISED PDE LIMITS | 15-16-03 | | 3 |
| | | | 8 |
| | | | 6 |
| | | | g |
| | | | |

| ROADWAY DESIGN ENGINEER ' | |
|---------------------------|-----|



| Н3 | Filename: * yyvolojeasuucootv-2547ocvabyv2547ccs08_majcuh_deilpish |
|----------|---|
| 11 | Document Control Number : |
| WITHING, | CHECKED BX: DATE: |
| | LOR -L- PROFILE SEE SEE SHEET 23 |

CONSTRUCTION SEQUENCE FINAL PLANS

DEPARTMENT OF TRANSPORTATION


STATE OF NORTH CAROLINA


| 50 = 3S 000'00Z'I = 8 |
|--------------------------|
| -7- |

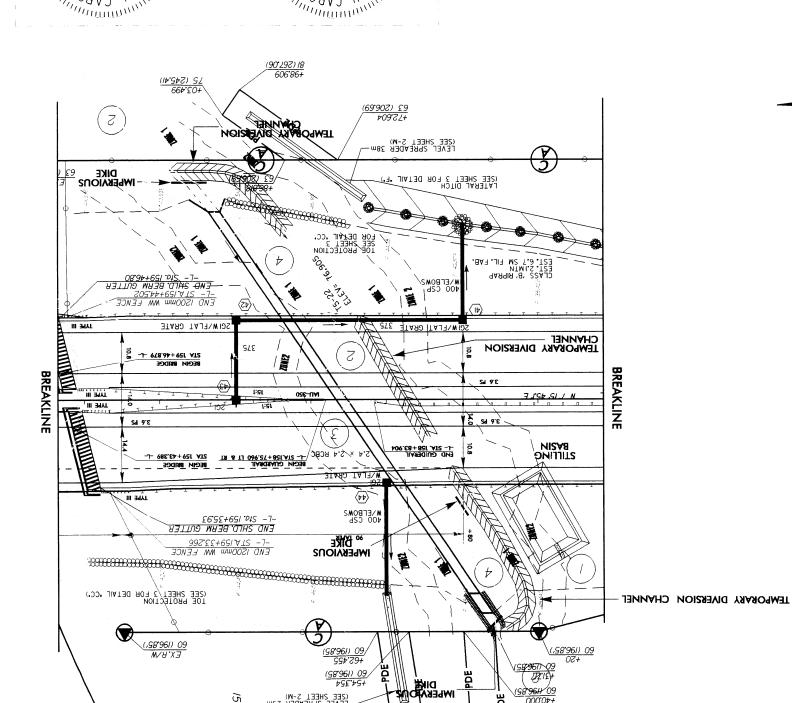


- CHANNEL BANKS ARE STABILIZED. 4. REMOVE EROSION CONTROL DEVICES AFTER SLOPES AND
 - 3. CONSTRUCT CULVERT AND PLACE RIP-RAP.
 - AND IMPERVIOUS DIKES. 2. CONSTRUCT TEMPORARY DIVERSION CHANNELS
 - 1. INSTALL STILLING BASIN (YOLUME: 64 CUBIC METERS).
 - CONSTRUCTION SEQUENCE:

DATE: 12-16-2003 RELEASE FOR CONSTRUCTION BOJECT REFERENCE NO. 8 (DET)
ROJECT REFERENCE NO.

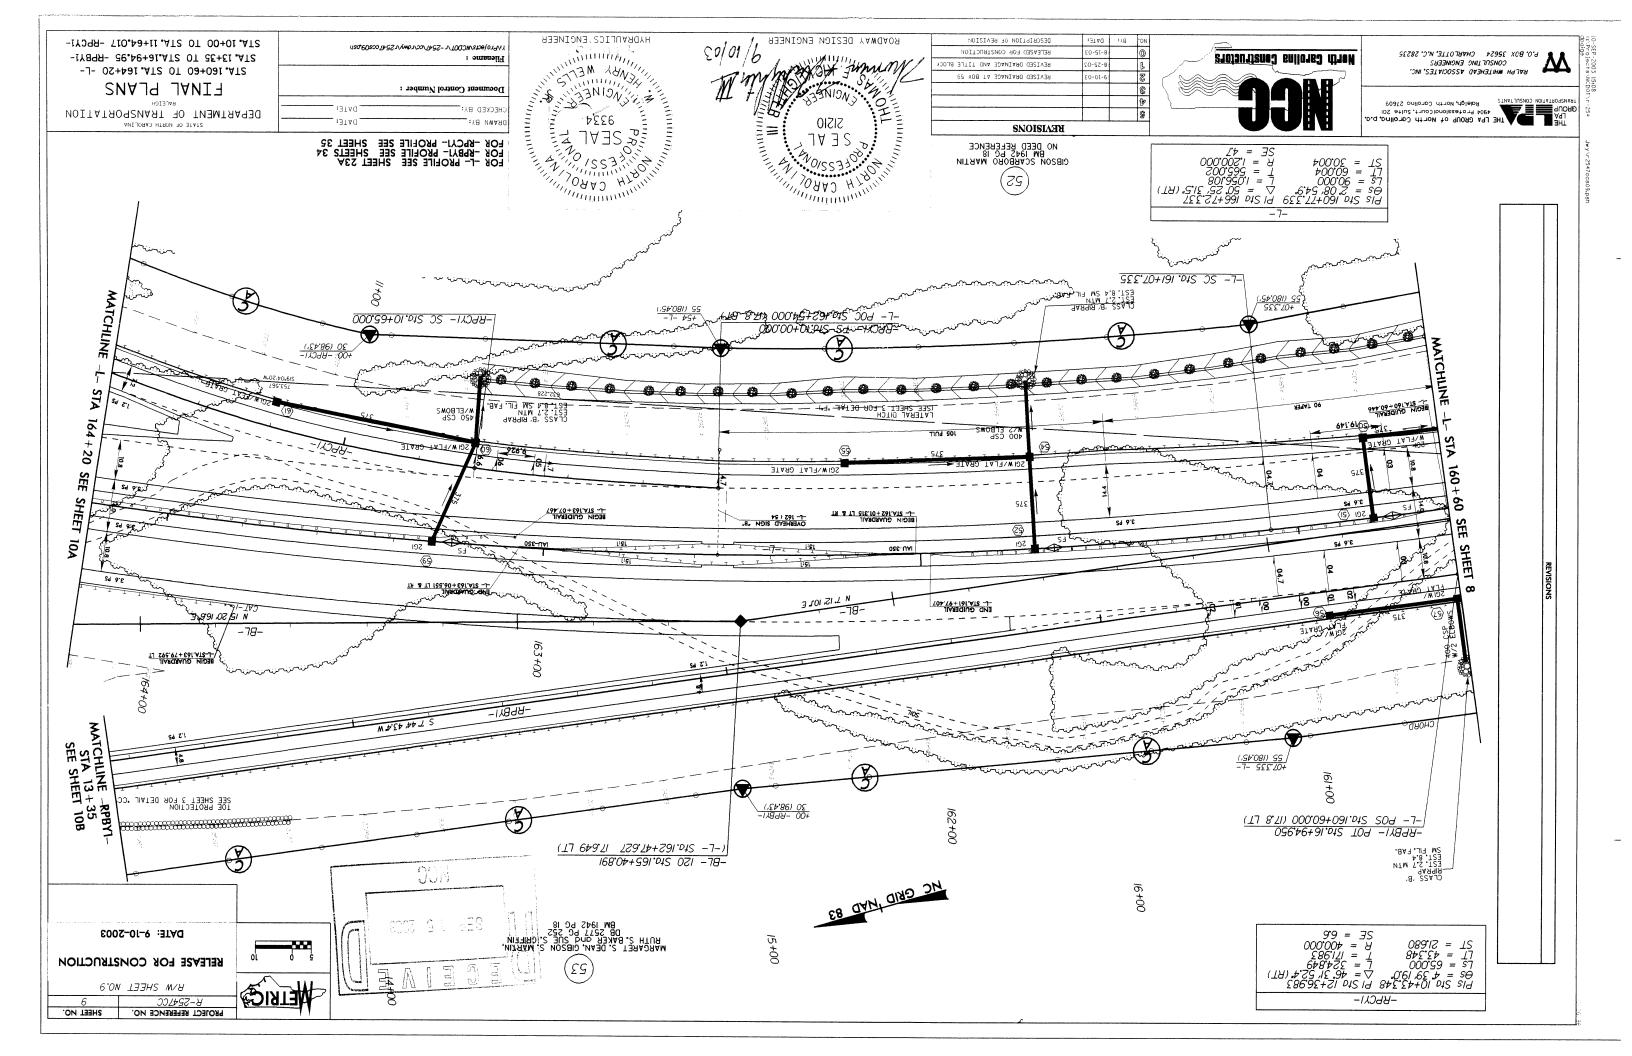

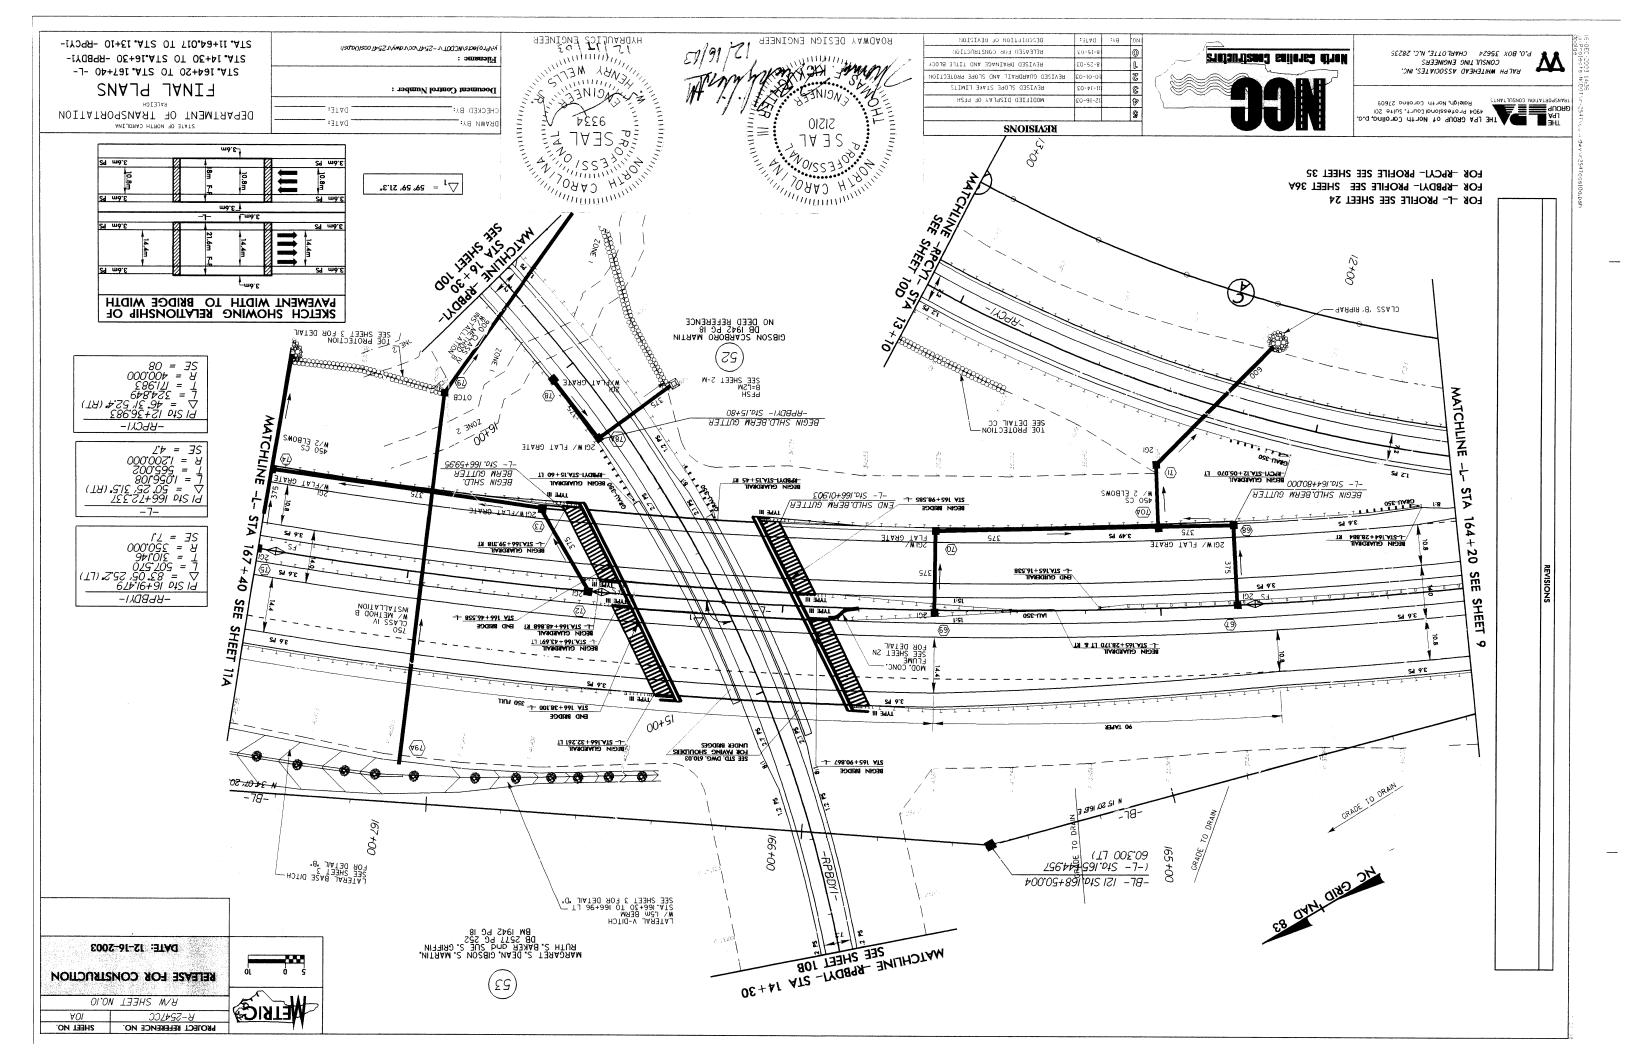

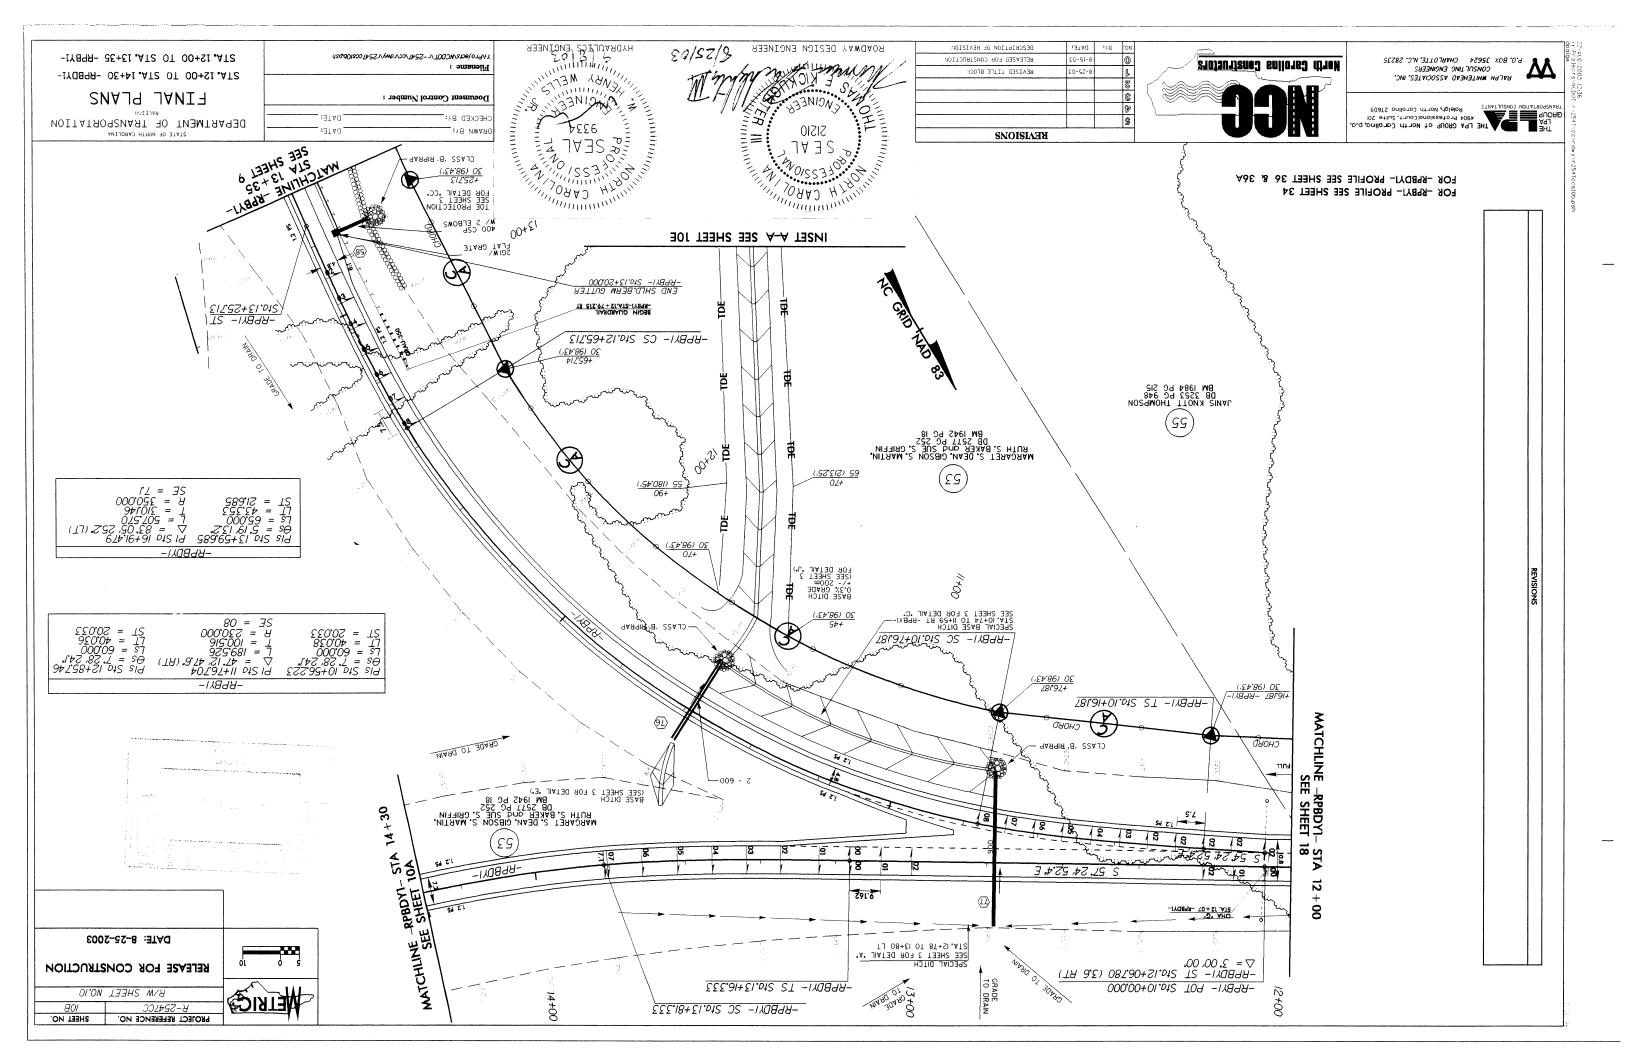

HYDRAULICS ENGINEER 50/91/21 ROADWAY DESIGN ENGINEER DESCRIBLION OF REVISION HO. BY: DATE: V:VPTO JOCKS/NCDOTV -2547/cc/vdwy/v2547/ccs10cpsh -IY- SEO. PO+71. ATS OT 00+81 . ATS RELEASED FOR CONSTRUCTION -iY- 00+0S .AT2 0T 00+Ti .AT2 WELLER STANDARD REVISED TITLE BLOCK 8-52-03 2 FINAL PLANS ment Control Number: DATE: HECKED BA DEPARTMENT OF TRANSPORTATION D826 DATE: -DRAWN BY: KEAISIONS CARO WYORAS HY WORAD BY (53) DO0:04+61.012 TO9 -1Y--BY1- 103 Std.14+08.865 -BY2- Std.5+00.000 -BY1- 103 Std.14+08.865 MATCHLINE COLLAR & B 200mm_STEEL_____ **STA** 375 CONC 600 CONC// SI ZI___ -/X- 3.535 ZO 88 S 8 CONVERT (82) CB TO JB⊗ (E3) Sal Z.I SEE EXIST CB SHEET EXTEND 600 M.ESS 20.88 N SPECIAL BITCH - ASP 18 42 2 88 05 223 E VS V -28S-+50 -YI- +74.403 -YI 6£3.36+31.bt2 T9 -1YA9A-(11:29) 5711 -ZUS- +6+ SOB (67.59') EX.R/W -RPAYI-(,Z6'0<u>9</u>1) 9b -11- 5b8'0b+ 138 (4485) SPECIAL DITCH SEE SHEET 3 FOR DETAIL 'A' -ZUS- 56+ -RPAYI- PC Sta.16+03.238 END CONZLENCLION -285- DOL 219 12+10589 DATE: 12-16-2003 JOE THOMAS KNOTT JR. DB ISI6 PG 544 -000

KNOTT FARM LIMITED PARTNERSHIP DB 5946 PC 949 BM 1984 PC 215

99

0 9

WETRICE!

KETEVZE FOR CONSTRUCTION

B'M SHEET NO.10

PROJECT REFERENCE NO. SHEET NO.

MORTH Carolina Constructors

MATCHLINE

ᅻ

STA

17

8

SEE

SHEET

18

14+00

(29

RALPH WHITEHEAD ASSOCIATES, INC.
CONSULTING ENGINEERS
P.O. BOX 35624 CHARLOTTE, N.C. 28235

THE LPA GROUP Of Worth Corolling p.g. 178 GROUP Protessional Court, Suite 201 178 MS Protessional Court, Suite 201 178 MS Protessional Court, Suite 201 178 MS Protessional Corolling 27609

FOR -8N2- PROFILE SEE SHEET 39 & 30 FOR -7N2- PROFILE SEE SHEET 42

